

# IUB RESEARCH LAB RENOVATIONS

CLIENT PROJECT NO. - 20240397

## INDIANA UNIVERSITY BLOOMINGTON

BL072 CHEMISTRY 800 E KIRKWOOD AVE, BLOOMINGTON, IN 47405 BL027 SWAIN WEST 729 E 3RD ST, BLOOMINGTON, IN 47405 BL070 SIMON HALL 212 S HAWTHORNE DR, BLOOMINGTON, IN 47405

#### SHEET INDEX

M702 AIRSIDE RELATED DETAILS

<i>∕</i> 3\			$\wedge$		
7	01-ARCHI	TECTURAL	<u>/1</u>	05 - FIRI	E PROTECTION
ŶF	A000	GENERAL NOTES AND SYMBOLS		FP001	FIRE PROTECTION SYMBOLS, ABBREVIATIONS AND GENERAL NOTES
Z	A002			FP100	FIRE PROTECTION DEMOLITION PLAN
		INTERIOR PARTITION SCHEDULE & DETAILS		FP101	FIRE PROTECTION DEMOLITION PLAN
	A100A	BL027 SWAIN - COMPOSITE OVERALL PLAN - SUB-BASEMENT LEVEL		FP102	FIRE PROTECTION DEMOLITION PLAN
	A100B	BL027 SWAIN - COMPOSITE OVERALL PLAN - BASEMENT LEVEL		FP120	FIRE PROTECTION PLAN
	A101	BL072 CHEMISTRY - COMPOSITE PLAN - LEVEL 1		FP120	FIRE PROTECTION PLAN
^		BL072 CHEMISTRY - COMPOSITE OVERALL PLAN - LEVEL 2		FP121	FIRE PROTECTION PLAN
\ <u>\</u>				FP122	FIRE PROTECTION PLAN
5 /	\	BL070 SIMON - ARCHITECTURAL/DIMENSION PLAN - LEVEL 2		FP123	FIRE PROTECTION PLAN
	A104	BL070 SIMON - ARCHITECTURAL/DIMENSION PLAN - LEVEL 4		FP200	SUB-BASEMENT PLANS SW S19-S21 AREA
	01-ARCHI	TECTURAL DEMOLITION		FP201	BASEMENT PLAN SW 014
	AD100	BL027 SWAIN - DEMOLITION PLAN - BASEMENT/SUB-BASEMENT LEVEL		FP700	FIRE PROTECTION DETAILS
	AD101A	BL072 CHEMISTRY - DEMOLITION PLAN - LEVEL 1	^	11700	THE THOTES HOW BETTHES
	-		<u>/3</u>	06 - PLU	IMRING
		BL072 CHEMISTRY - DEMOLITION PLAN - LEVEL 1	2	P001	PLUMBING SYMBOLS, ABBREVIATIONS AND GENERAL NOTES
	AD102	BL072 CHEMISTRY - DEMOLITION PLAN - LEVEL 2		P100	PLUMBING DEMOLITION PLANS
	AD120	BL027 SWAIN - DEMOLITION RCP - BASEMENT/SUB-BASEMENT LEVEL		P101	PLUMBING DEMOLITION PLANS
	AD121A	BL072 CHEMISTRY - DEMOLITION RCP - LEVEL 1		P102	PLUMBING DEMOLITION PLANS
1	AD121B	BL072 CHEMISTRY - DEMOLITION RCP - LEVEL 1	^	P200	BASEMENT PLAN SW 011
			3	P201	BASEMENT PLAN SW 011 BASEMENT PLAN SW 014
1		BL072 CHEMISTRY - DEMOLITION RCP - LEVEL 2		P200'	SUB-BASEMENT PLANS SW S19-S21 AREA
7	02-ARCHI	TECTURAL	1	$\sim$	PLUMBING FLOOR PLAN -LEVEL 4
	A110	BL027 SWAIN - ARCHITECTURAL/DIMENSION PLAN - BASEMENT/SUB-BASEMENT LEVEL	3	P204	
	A111A	BL072 CHEMISTRY - ARCHITECTURAL/DIMENSION PLAN - LEVEL 1		P209 }	CHEMISTRY OVERALL FLOOR PLAN - LEVEL 1
	A111B	BL072 CHEMISTRY - ARCHITECTURAL/DIMENSION PLAN - LEVEL 1	<u>/3</u> ——(	P210	PLUMBING PLAN -CH 103/105 AREA
	A112	BL072 CHEMISTRY - ARCHITECTURAL/DIMENSION PLAN - LEVEL 2		P211 }	PLUMBING PLAN - CH 102-104 AREA PLUMBING PLAN -CH A251/A252 AREA
_				P212 }	
	A130	BL027 SWAIN - REFLECTED CEILING PLAN - BASEMENT/SUB-BASEMENT LEVEL		P213	PLUMBING PLANS - CH A140 AREA
٨	A131A	BL072 CHEMISTRY - REFLECTED CEILING PLAN - LEVEL 1	^	P400	PLUMBING RISER DIAGRAMS
<u> </u>	A131B	BL072 CHEMISTRY - REFLECTED CEILING PLAN - LEVEL 1	<u> </u>	P401	PLUMBING RISER DIAGRAM
	A132	BL072 CHEMISTRY - REFLECTED CEILING PLAN - LEVEL 2	\ \ \ \ \ \ \ \ \ \ \ \ \ \ \ \ \ \ \	P402	WATER RISER DIAGRAM
7	$\sim$	OPENING SCHEDULES, OPENING DETAILS & ELEVATIONS	^1	P403 }	PLUMBING RISER DIAGRAM
<u>ر</u> ر		·	<u>/3</u> \	P404	PLUMBING RISER DIAGRAM
7		FURNISHINGS	(	P405	PLUMBING RISER DIAGRAM
سر	LF000.Y	LAB GENERAL NOTES AND FIXTURE SCHEDULES		P406	PLUMBING RISER DIAGRAM
_{{}}	LF001.Y	LAB CASEWORK MENU	<u>/3</u>	P500	PLUMBING DETAILS
•	LF401	BL027 SWAIN - ENLARGED LAB FURNISHING PLAN/ELEVATION - BASEMENT/SUB-BASEMENT LE	EVEL	{P501}	PLUMBING DETAILS
7	$\sim\sim\sim$	BL072 CHEMISTRY - ENLARGED LAB FURNISHING PLAN - LEVEL 1	2		
{	}		1	07 515	COTDIONI
-{	)	BL072 CHEMISTRY - ENLARGED LAB FURNISHING PLAN - LEVEL 1			CTRICAL
X	LF412 }	BL072 CHEMISTRY - ENLARGED LAB FURNISHING PLAN - LEVEL 2		E001	ELECTRICAL SYMBOLS, ABBREVIATIONS AND GENERAL NOTES
}	LF601 <	BL072 CHEMISTRY - LAB INTERIOR ELEVATIONS		E100	SWAIN SUB BASEMENT AND BASEMENT ELECTRICAL PLANS
{	LF602 3	BL072 CHEMISTRY - LAB INTERIOR ELEVATIONS	$\wedge$	E110	CHEMISTRY FIRST FLOOR ELECTRICAL PLANS
	LFD01.X	LAB DETAILS - GENERAL	2	E120	CHEMISTRY SECOND FLOOR ELECTRICAL PLANS
	I FD02 X	LAB DETAILS - FIXED CASEWORK		E130	SIMON HALL ELECTRICAL PLANS
1				E140	SWAIN FOURTH LEVEL COMPOSITE PLAN
		LAB DETAILS - CEILING SERVICE PANELS AND MOBILE CASEWORK		E300	SWAIN SUB-BASEMENT ELECTRICAL PLANS -LAB S21
(		LAB DETAILS - MISCELLANOUS	^	E301	SWAIN BASEMENT ELECTRICAL PLANS -LABS 011 & 014
$-\langle$		LAB VACUUM ZONES PLAN	2	E310	CHEMISTRY FIRST FLOOR ELECTRICAL PLANS -103/105 LABS & OFFICES
	04 - MECH	HANICAI		E311	CHEMISTRY FIRST FLOOR ELECTRICAL PLANS -102/104 LABS
	OT WEST			E312	CHEMISTRY FIRST FLOOR ELECTRICAL PLANS -A140 LABS AND OFFICES
	M001	HVAC SYMBOLS, ABBREVIATIONS AND GENERAL NOTES		E313	CHEMISTRY FIRST FLOOR ELECTRICAL PLANS -A162 OFFICES
		HVAC CONTROL SCHEMATICS		E320	CHEMISTRY SECOND FLOOR ELECTRICAL PLANS -A252 LAB, A251 OFFICE
		HVAC CONTROL SCHEMATICS		E600	ELECTRICAL SCHEDULES
		HVAC CONTROL SCHEMATICS		E601	SWAIN PANEL SCHEDULES
	_	SUB-BASEMENT PLANS SW S19-S21 AREA		E602	CHEMISTRY PANEL SCHEDULES -FIRST FLOOR
		SUB-BASEMENT PLANS SW S19-S21 AREA		E603	CHEMISTRY PANEL SCHEDULES -FIRST FLOOR
		BASEMENT PLANS SW 011		E604	CHEMISTRY PANEL SCHEDULES -SECOND FLOOR
7		BASEMENT PLANS SW 014			
		MECHANICAL PLAN - CH 103/105 AREA			
//		MECHANICAL PLANS - CH 103/105 AREA MECHANICAL PLANS - CH102/104 AREA			
		MECHANICAL PLANS - CH 102/104 AREA MECHANICAL PLAN -CX A162 AREA			
7/		MECHANICAL PLANS -CH A140 AREA			
		MECHANICAL PLANS -CH A140 AREA MECHANICAL PLAN -CX A251/A252 AREA			
		ATTIC / 4TH FLOOR MECHANICAL PLANS SW			
		MECHANICAL PLAN SI 494 AREA			
\		HVAC SCHEDULES HVAC SCHEDULES			
A.	IVICALI	11873473411117411143			




MARK DATE DESCRIPTION

BIDDING SET JANUARY 9, 2025

**COVER SHEET** 

BSALS PROJECT NO.

G00

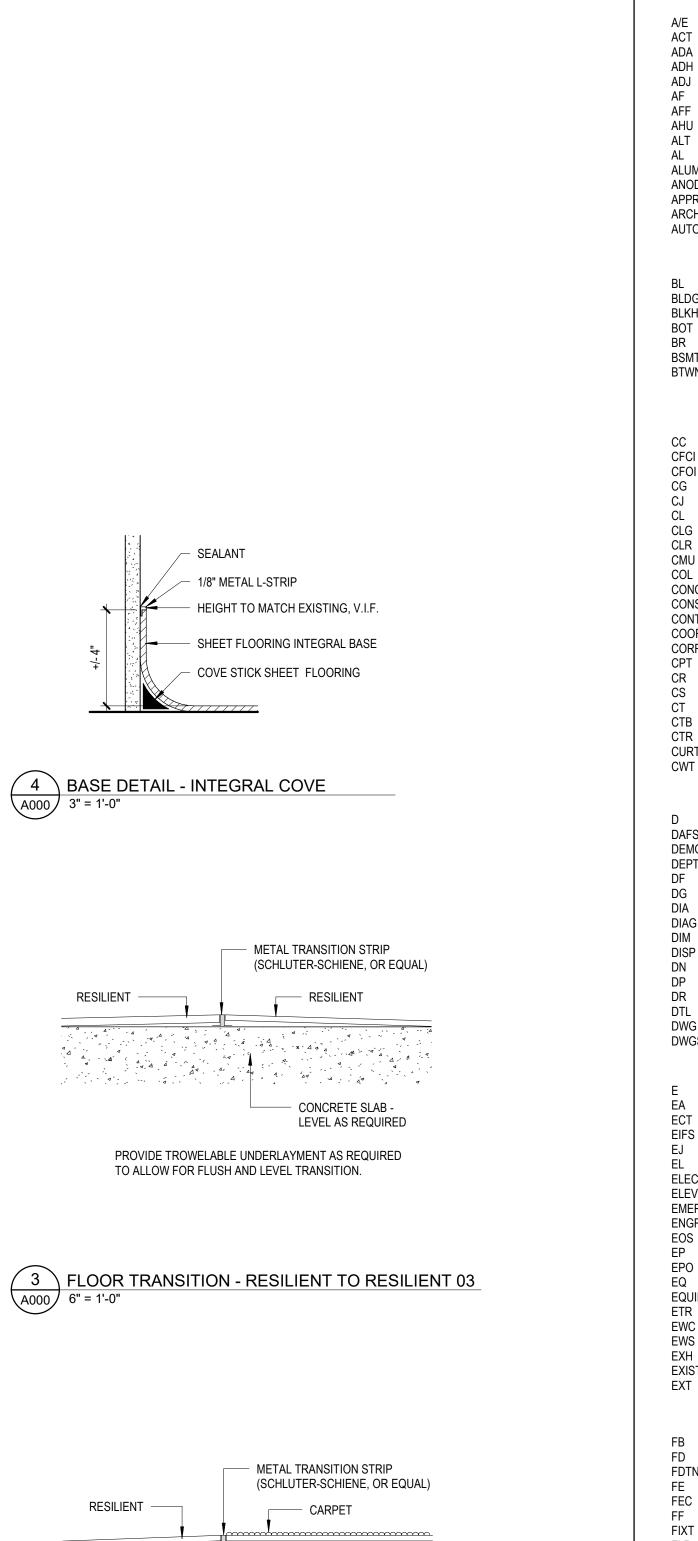

SEALANT

4 BASE DETAIL - INTEGRAL COVE
3" = 1'-0"

RESILIENT -

RESILIENT

AS REQUIRED

CONCRETE -

CONCRETE SLAB - LEVEL AS REQUIRED ----

1/8" METAL L-STRIP

HEIGHT TO MATCH EXISTING, V.I.F

SHEET FLOORING INTEGRAL BASE

COVE STICK SHEET FLOORING

METAL TRANSITION STRIP

RESILIENT

CONCRETE SLAB -

METAL TRANSITION STRIP

RESILIENT REDUCER STRIP (TARKET OR EQUAL), COLOR TBD

(SCHLUTER-SCHIENE, OR EQUAL)

PROVIDE TROWELABLE UNDERLAYMENT AS REQUIRED

TO ALLOW FOR FLUSH AND LEVEL TRANSITION.

PROVIDE TROWELABLE UNDERLAYMENT AS REQUIRED TO ALLOW FOR FLUSH AND LEVEL TRANSITION.

2 FLOOR TRANSITION - RESILIENT TO CARPET 02


A000 6" = 1'-0"


1 FLOOR TRANSITION - CONCRETE TO RESILIENT 01
6" = 1'-0"

CONCRETE SLAB - LEVEL ———

LEVEL AS REQUIRED

(SCHLUTER-SCHIENE, OR EQUAL)

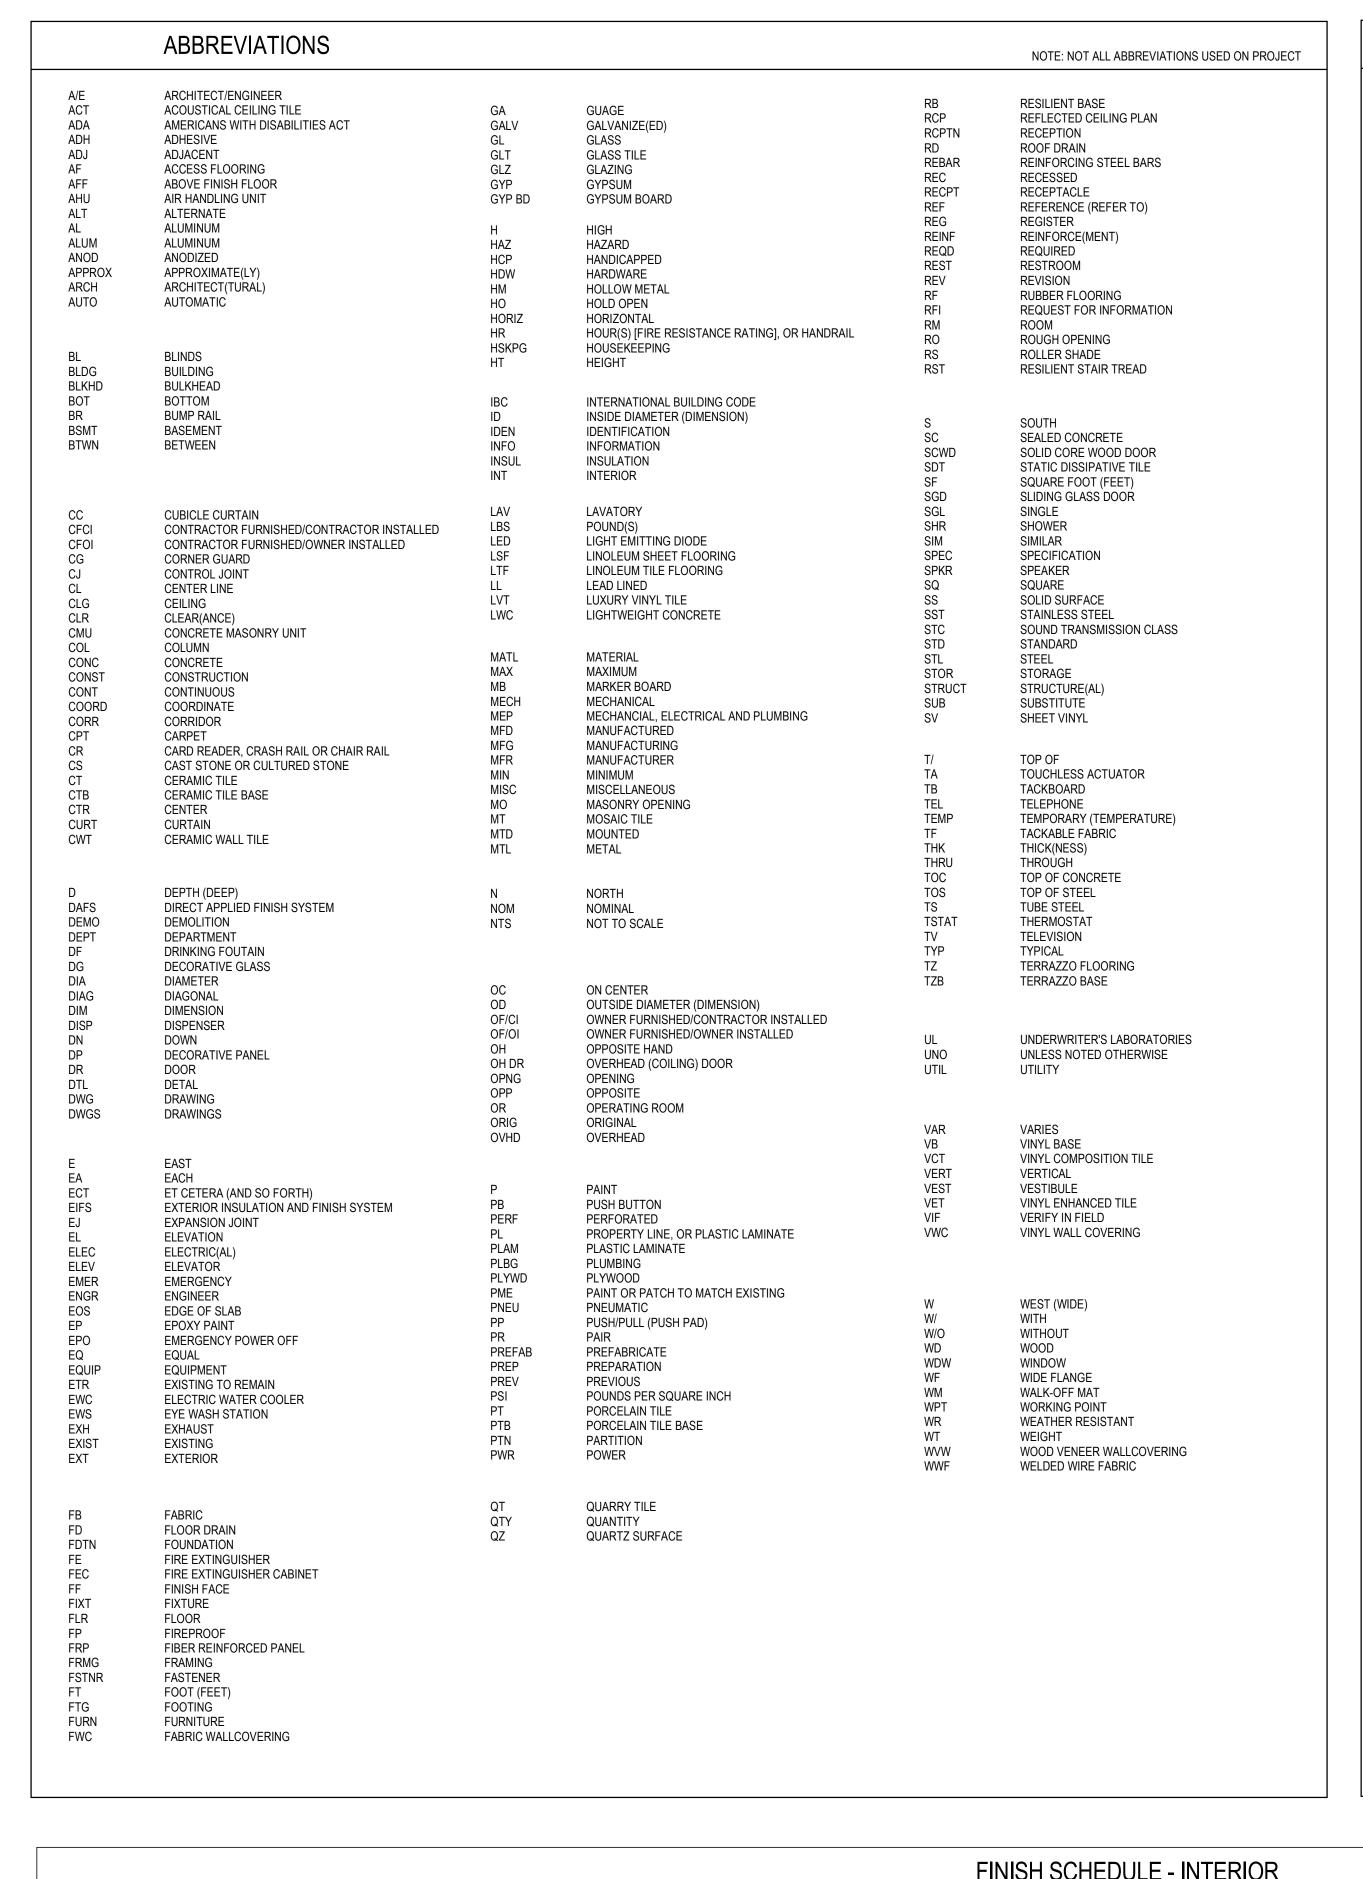

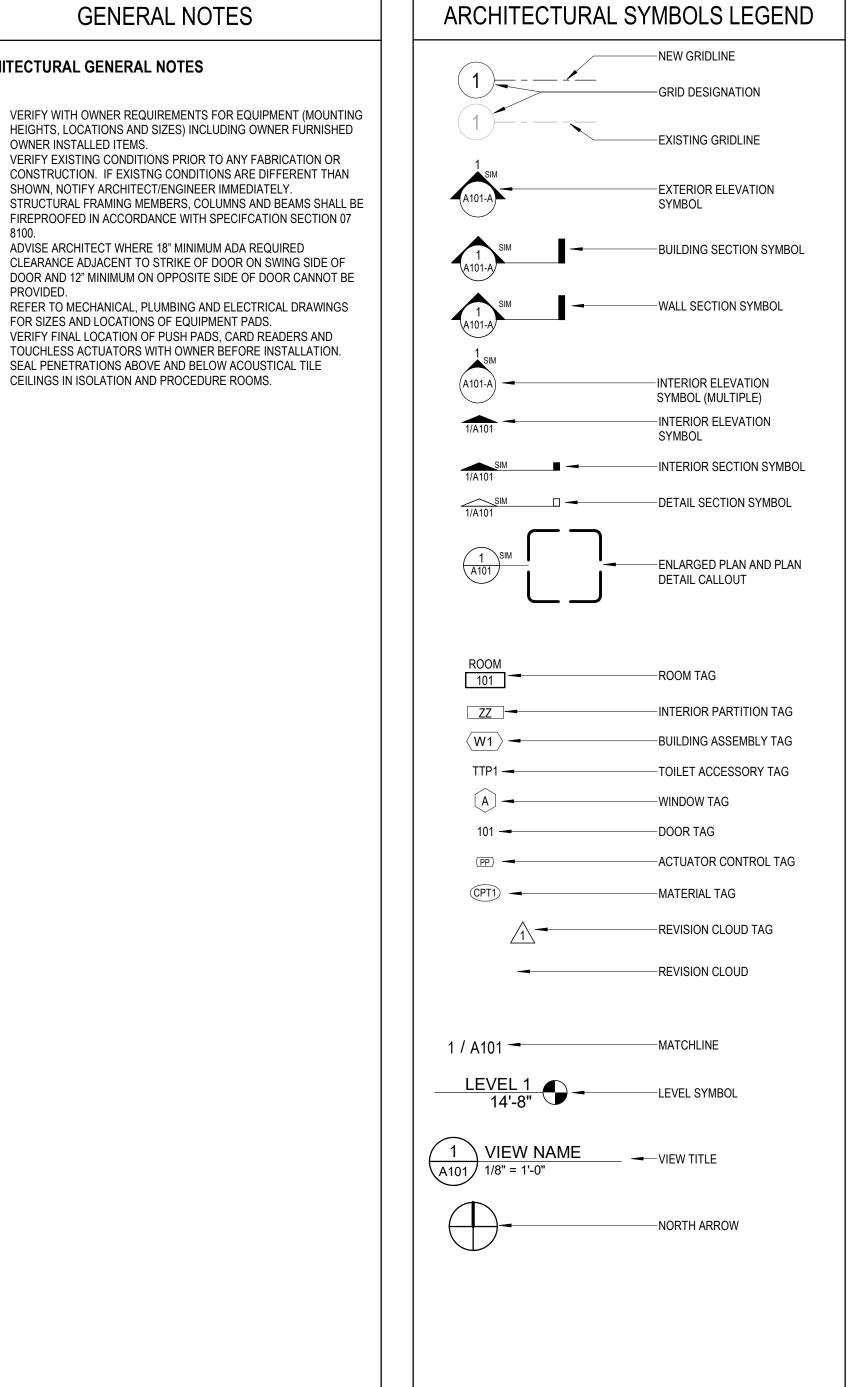

**GENERAL NOTES** 

SHOWN, NOTIFY ARCHITECT/ENGINEER IMMEDIATELY.

ADVISE ARCHITECT WHERE 18" MINIMUM ADA REQUIRED

VERIFY FINAL LOCATION OF PUSH PADS, CARD READERS AND

SEAL PENETRATIONS ABOVE AND BELOW ACOUSTICAL TILE

FOR SIZES AND LOCATIONS OF EQUIPMENT PADS.

CEILINGS IN ISOLATION AND PROCEDURE ROOMS.

ARCHITECTURAL GENERAL NOTES

OWNER INSTALLED ITEMS.



## **IUB** RESEARCH **RENOVATIONS**

BL072 CHEMISTRY 800 E KIRKWOOD AVE, BLOOMINGTON, IN 47405 BL027 SWAIN WEST 729 E 3RD ST. BLOOMINGTON, IN 47405 BL070 SIMON HALL 212 S HAWTHORNE DR, BLOOMINGTON, IN 47405


CLIENT PROJECT NO. - 20240397

**BIDDING SET** JANUARY 9, 2025

01/29/25 ADDENDUM 3 01/27/25 ADDENDUM 2

DESCRIPTION

MARK DATE

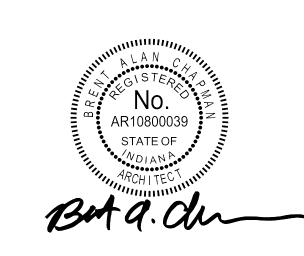

GENERAL NOTES AND SYMBOLS

DATE BSALS PROJECT NO.

FINISH SCHEDULE - INTERIOR								
								_
SPECIFICATION SEC	CTION MARK	DESCRIPTION	MANUFACTURER	STYLE/MODEL	COLOR	SIZE	COMMENTS	CONTACT
CONCRETE FLOOR FINISH								
	SC1	CONCRETE FLOOR FINISH, HIGH GLOSS CLEAR SEALER						
PAINTS AND COATINGS			-	<u> </u>		<u>'</u>		
09 9000	P1	PAINT	SHERWIN WILLIAMS	SW 7042	SHOJI WHITE			KAREN GALVIN: KAREN.E.GALVIN@SHERWIN.COM
09 9000	P2	PAINT	SHERWIN WILLIAMS	SW 7005	PURE WHITE			KAREN GALVIN:
mm	$\sim\sim$		~~~~~~~~~~~~~~~~~~~~~~~~~~~~~~~~~~~~~~	~~~~~~~~~~~~~~~~~~~~~~~~~~~~~~~~~~~~~~	· · · · · · · · · · · · · · · · · · ·	~~~~~~~~~~~~~~~~~~~~~~~~~~~~~~~~~~~~~~	~~~~~~~~~~~~~~~~~~~~~~~~~~~~~~~~~~~~~~	MAREN E GALVIN OSHEBWIN GOV
<b>{</b>  09 9000	P3	PAINT	BENJAMIN MOORE	HC-176	ANNAPOLIS GRAY		OR SHERWIN WILLIAMS TO MATCH	
	PA	PAINT	O. LETATION TO THE STATE OF THE	SW 7010	7440141111000			KAREN.E.GALVIN@SHERWIN.COM
09 9000	P5	PAINT	SHERWIN WILLIAMS	SW 7675	SEALSKIN			KAREN GALVIN:
099000	P6 AAAAAAAAAAAAAAAAAAAAAAAAAAAAAAAAAAAA	PAÍNT	MATCH ADJACENT WALL FINISH	MATCH ADJACENT WALL FINISH	MATCH ADJACENT WALL FINISH			KAREN E.GALVIN @SHERWIN COM  KAREN GALVIN @SHERWIN COM  LARED E.GALVIN @SHERWIN COM
RESILIENT BASE								
09 6500	RB1	RESILIENT BASE	ROPPE	THERMOSET RUBBER COVE BASE	129 DOLPHIN	4"H		JOE TUFFNER: 630.947.6654
09 6500	RB2	RESILIENT BASE	TARKETT	THERMOSET RUBBER COVE BASE	63 BURNT UMBER	4"H		DOUG EDWARDS@TARKETT.COM
( 09 6500	RB3	RESILIENT BASE	MARLEY	FLEXCO FLEXTONES	03 CHARCOAL	4"H		
~ AAUAAA AAA AAA AAA								
	<u> </u>	<del>, , , , , , , , , , , , , , , , , , , </del>		IZLIDA	FENNEL ARoSKU34			
09 6500	LVT1	LUXURY VINYL TILE	MANNINGTON	KUKA	A LANGE AROUNDS	<del> </del>		
	LVT1	LUXURY VINYL TILE RUBBER SHEET FLOORING	MANNINGTON NORA SYSTEMS	11 6506 1 1 1 1 1 1 1 1 1 1 1 1 1 1 1 1 1 1 1	CASAMERE	3.0MM THICK, 48 WIDE SHEET		ROB GROM: ROB. GROM@NORA.COM
9 6500	LVT1 RF1	RUBBER SHEET FLOORING  VINYL SHEET FLOORING	MANNINGTON NORA SYSTEMS TARKETT	IQ OPTIMA	CASHMERE 205 SOFT WARM WHITE	3.0MM THICK, 48 WIDE SHEET  2.0MM THICK, 2M WIDE SHEET		ROB GROM: ROB.GROM@NORA.COM  DOUG EDWARDS:  DOUG EDWARDS@TARKETT.COM
09 6500	LVT1 RF1 RF2	RÜBBER SHEET FLOORING	NORA SYSTEMS	6506	CASHMERE  205 SOFT WARM WHITE  FEILD: 0131 OPAL	·	MIMIC EXISTING PATTERN	
09 6500 09 6500 09 6500 09 6500	RF2	VINYL SHEET FLOORING  VINYL SHEET FLOORING  VINYL SHEET FLOORING	TARKETT  GÉRFLOR	IQ OPTIMA  MIPOLAM ELEGANCE 290	CASHMERE  205 SOFT WARM WHITE  FEILD: 0131 OPAL  ACCENT: 0151 ANTHRAGITE	2.0MM THICK, 2M WIDE SHEET		DOUG EDWARDS: DOUG EDWARDS@TARKETT.COM
09 6500 09 6500 09 6500 09 6500 09 6500	RF2 RF3 SDT1	VINYL SHEET FLOORING  VINYL SHEET FLOORING  VINYL SHEET FLOORING  STATIC DISSIPATIVE TILE	TARKETT  TARKETT  TARKETT	IQ OPTIMA  MIPOLAM ELEGANCE 290  IQ GRANIT SD	CASHMERE  205 SOFT WARM WHITE  FEILD: 0131 OPAL  ACCENT: 0151 ANTHRAGINE  0395 LIGHT GREY	2.0MM THICK, 2M WIDE SHEET  24" X 24"		DOUG EDWARDS: DOUG EDWARDS@TARKETT.COM  DOUG EDWARDS: DOUG EDWARDS: DOUG.EDWARDS@TARKETT.COM
09 6500 09 6500 09 6500 09 6500 09 6500 09 6500	RF2	VINYL SHEET FLOORING  VINYL SHEET FLOORING  VINYL SHEET FLOORING	TARKETT  GÉRFLOR	IQ OPTIMA  MIPOLAM ELEGANCE 290	CASHMERE  205 SOFT WARM WHITE  FEILD: 0131 OPAL  ACCENT: 0151 ANTHRAGITE	2.0MM THICK, 2M WIDE SHEET		DOUG EDWARDS: DOUG EDWARDS@TARKETT.COM  DOUG EDWARDS:
09 6500 09 6500 09 6500 09 6500 09 6500 09 6500 TILE CARPETING	RF2 RF3 SDT1 VCT1	VINYL SHEET FLOORING  VINYL SHEET FLOORING  VINYL SHEET FLOORING  STATIC DISSIPATIVE TILE  VINYL COMPOSITION TILE	TARKETT  TARKETT  TARKETT	IQ OPTIMA  MIPOLAM ELEGANCE 290  IQ GRANIT SD  VCT II	CASHMERE  205 SOFT WARM WHITE  FEILD: 0131 OPAL  ACCENT: 0151 ANTHRAGITE  0395 LIGHT GREY  326 DUNES CB	2.0MM THICK, 2M WIDE SHEET  24" X 24"  12" X 12"	MIMIC EXISTING PATTERN	DOUG EDWARDS: DOUG EDWARDS@TARKETT.COM  DOUG EDWARDS: DOUG.EDWARDS@TARKETT.COM  DOUG EDWARDS: DOUG.EDWARDS: DOUG.EDWARDS@TARKETT.COM
09 6500 09 6500 09 6500 09 6500 09 6500 09 6500 TILE CARPETING 09 6813	RF2 RF3 SDT1	VINYL SHEET FLOORING  VINYL SHEET FLOORING  VINYL SHEET FLOORING  STATIC DISSIPATIVE TILE	TARKETT  TARKETT  TARKETT	IQ OPTIMA  MIPOLAM ELEGANCE 290  IQ GRANIT SD	CASHMERE  205 SOFT WARM WHITE  FEILD: 0131 OPAL  ACCENT: 0151 ANTHRAGITE  0395 LIGHT GREY  326 DUNES CB	2.0MM THICK, 2M WIDE SHEET  24" X 24"		DOUG EDWARDS@TARKETT.COM  DOUG EDWARDS: DOUG.EDWARDS@TARKETT.COM  DOUG EDWARDS:
09 6500 09 6500 09 6500 09 6500 09 6500 TILE CARPETING	RF2 RF3 SDT1 VCT1	VINYL SHEET FLOORING  VINYL SHEET FLOORING  VINYL SHEET FLOORING  STATIC DISSIPATIVE TILE  VINYL COMPOSITION TILE	TARKETT  TARKETT  TARKETT	IQ OPTIMA  MIPOLAM ELEGANCE 290  IQ GRANIT SD  VCT II	CASHMERE  205 SOFT WARM WHITE  FEILD: 0131 OPAL  ACCENT: 0151 ANTHRAGITE  0395 LIGHT GREY  326 DUNES CB	2.0MM THICK, 2M WIDE SHEET  24" X 24"  12" X 12"	MIMIC EXISTING PATTERN	DOUG EDWARDS: DOUG EDWARDS@TARKETT.COM  DOUG EDWARDS: DOUG.EDWARDS: DOUG.EDWARDS: DOUG.EDWARDS: DOUG.EDWARDS: DOUG.EDWARDS: DOUG.EDWARDS:

**GRID SYSTEM** 

ACT-1 ACOUSTICAL TILE CEILING SYSTEM ARMSTRONG WORLD INDUSTRIES CIRRUS TEGULAR 556 2 X 2 WHITE ARMSTRONG PRELUDE 15/16" 2 X 2

SUSPENSION SYSTEM

SIZE

COLOR

**CEILING SCHEDULE** 

MODEL# SIZE COLOR


CEILING TYPE


STYLE NAME

BASIS OF DESIGN MANUFACTURER

MARK

DESCRIPTION

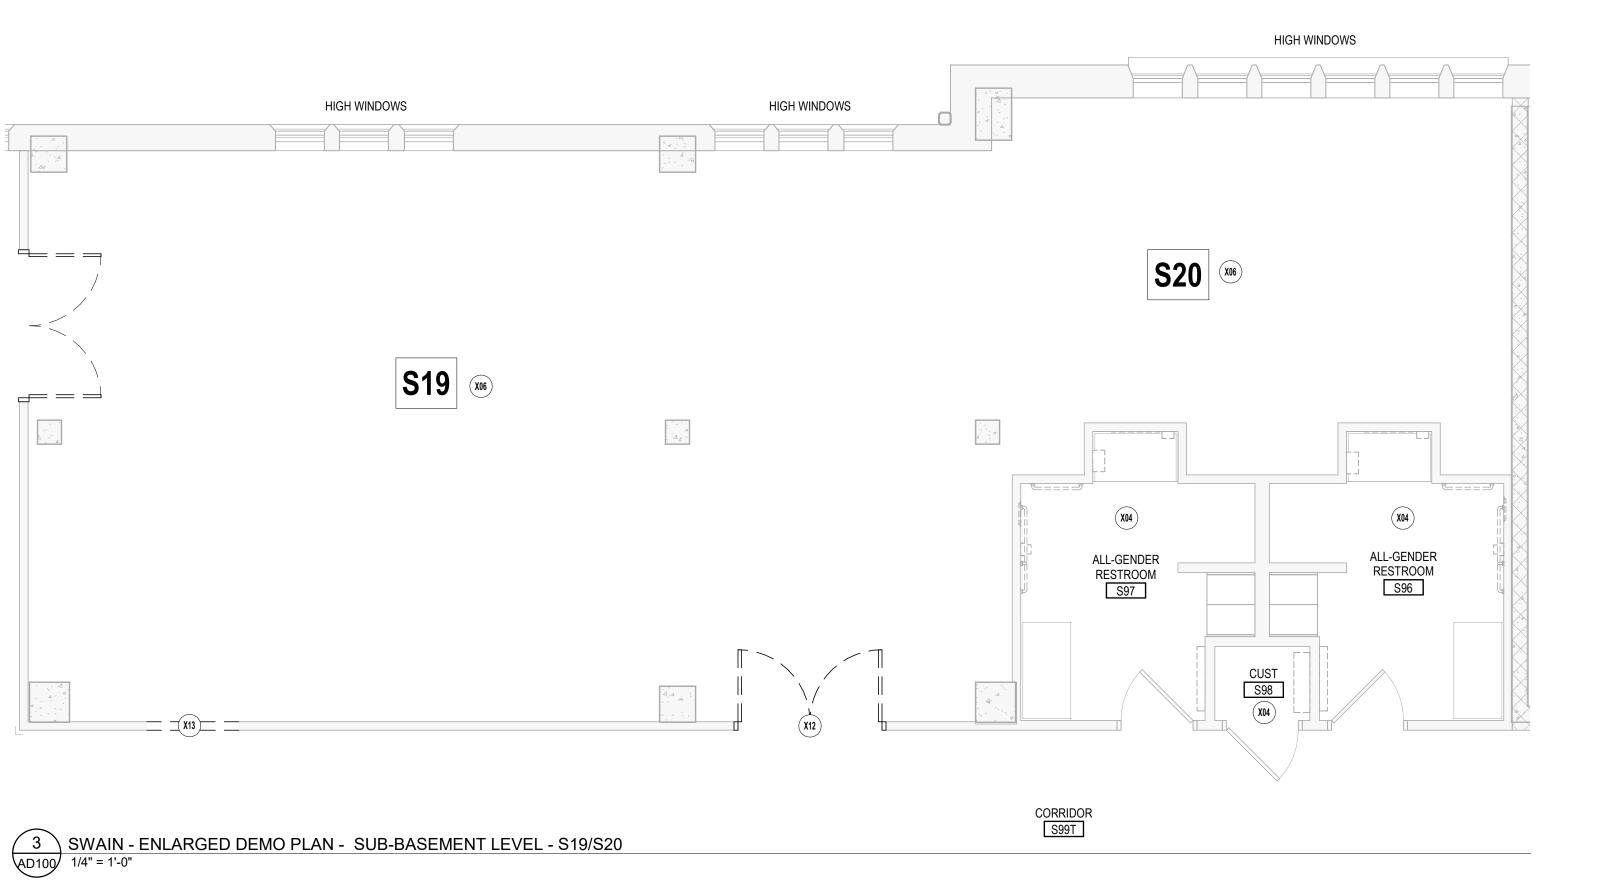

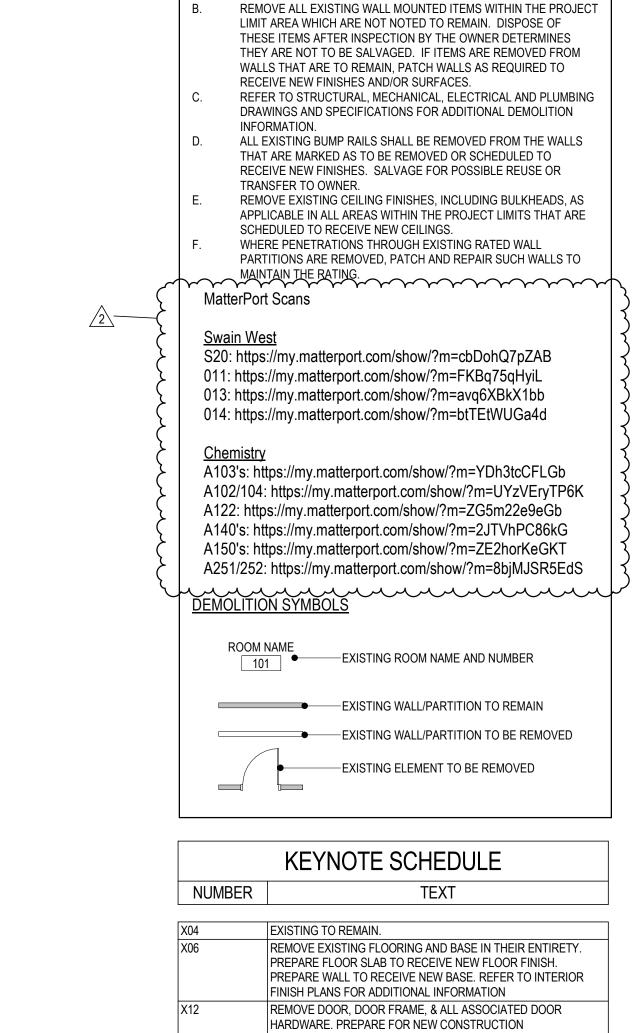

PORTION OF EXISTING WALL TO BE REMOVED TO RECEIVE NEW OPENING, SEE ARCHITECTURAL PLANS. PREPARE OPENING TO RECEIVE NEW DOOR, FRAME, AND HARDWARE. COORDINATE

DIMENSIONS OF OPENING WITH DOOR SCHEDULE.

DEMOLITION PLAN LEGEND

A. ALL ITEMS SHOWN IN A BOLD DASHED LINE AND NOT OTHERWISE CALLED OUT, INDICATE EXISTING ITEMS OR WALLS TO BE DEMOLISHED. REMOVE SUCH ITEMS TOTALLY AND COMPLETELY.

**DEMOLITION NOTES** 



BSA LifeStructures

9365 Counselors Row, Suite 300

Indianapolis, IN 46240-1478

ph 317.819.7878 fx 317.819.7288

**BL072 CHEMISTRY** 800 E KIRKWOOD AVE, BLOOMINGTON, IN 47405 BL027 SWAIN HALL 729 E 3RD ST, BLOOMINGTON, IN 47405 **BL070 SIMON HALL** 212 S HAWTHORNE DR, BLOOMINGTON, IN 47405


**RENOVATIONS** 

CLIENT PROJECT NO. - 20240397

**BIDDING SET** JANUARY 9, 2025




DESCRIPTION 01/29/25 ADDENDUM 3

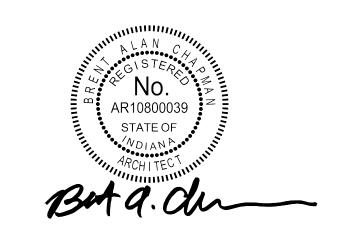


BL027 SWAIN -**DEMOLITION PLAN -**BASEMENT/SUB-BASEMENT LEVEL


BSALS PROJECT NO.

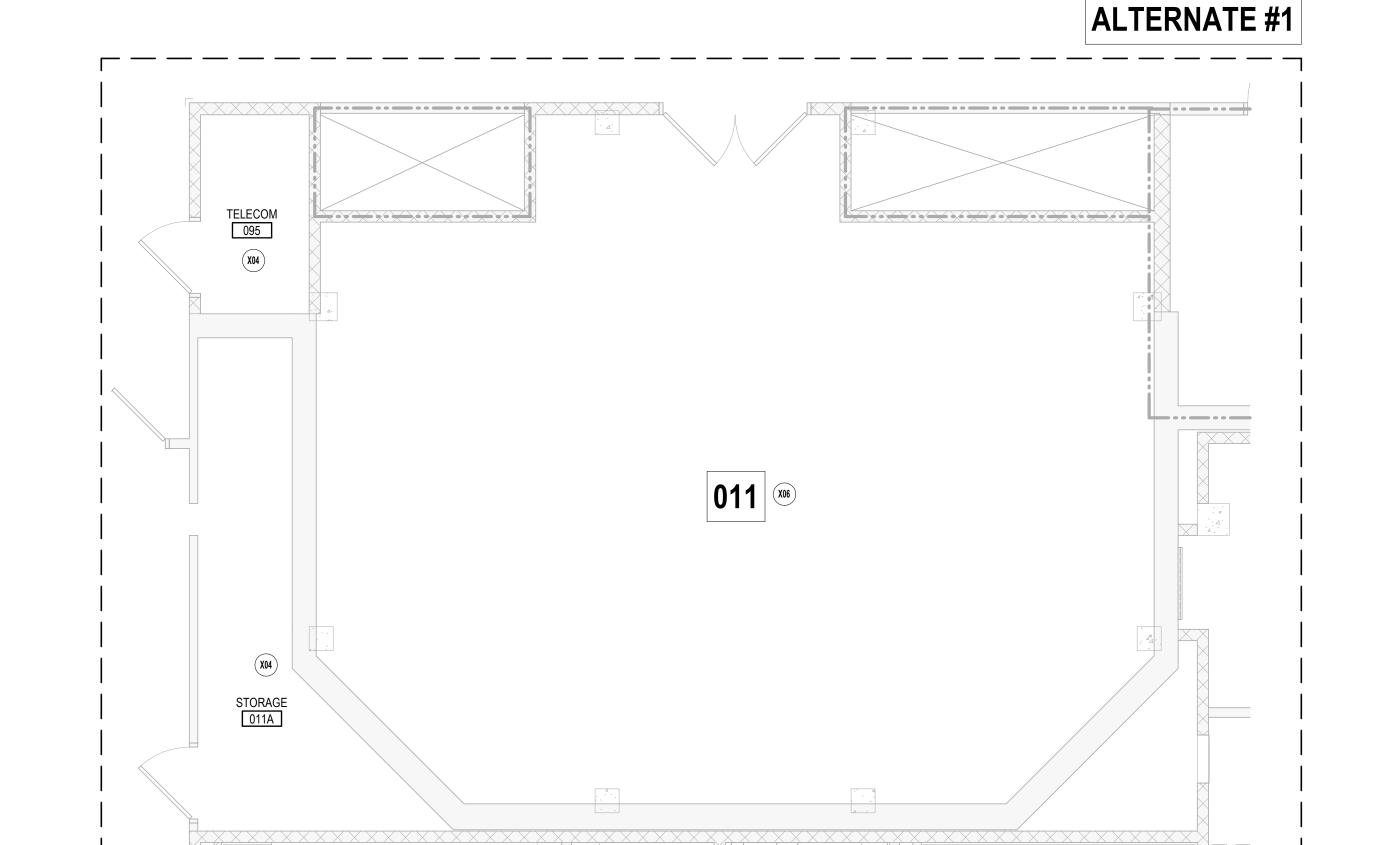


SWAIN - ENLARGED DEMO PLAN - BASEMENT LEVEL - 011

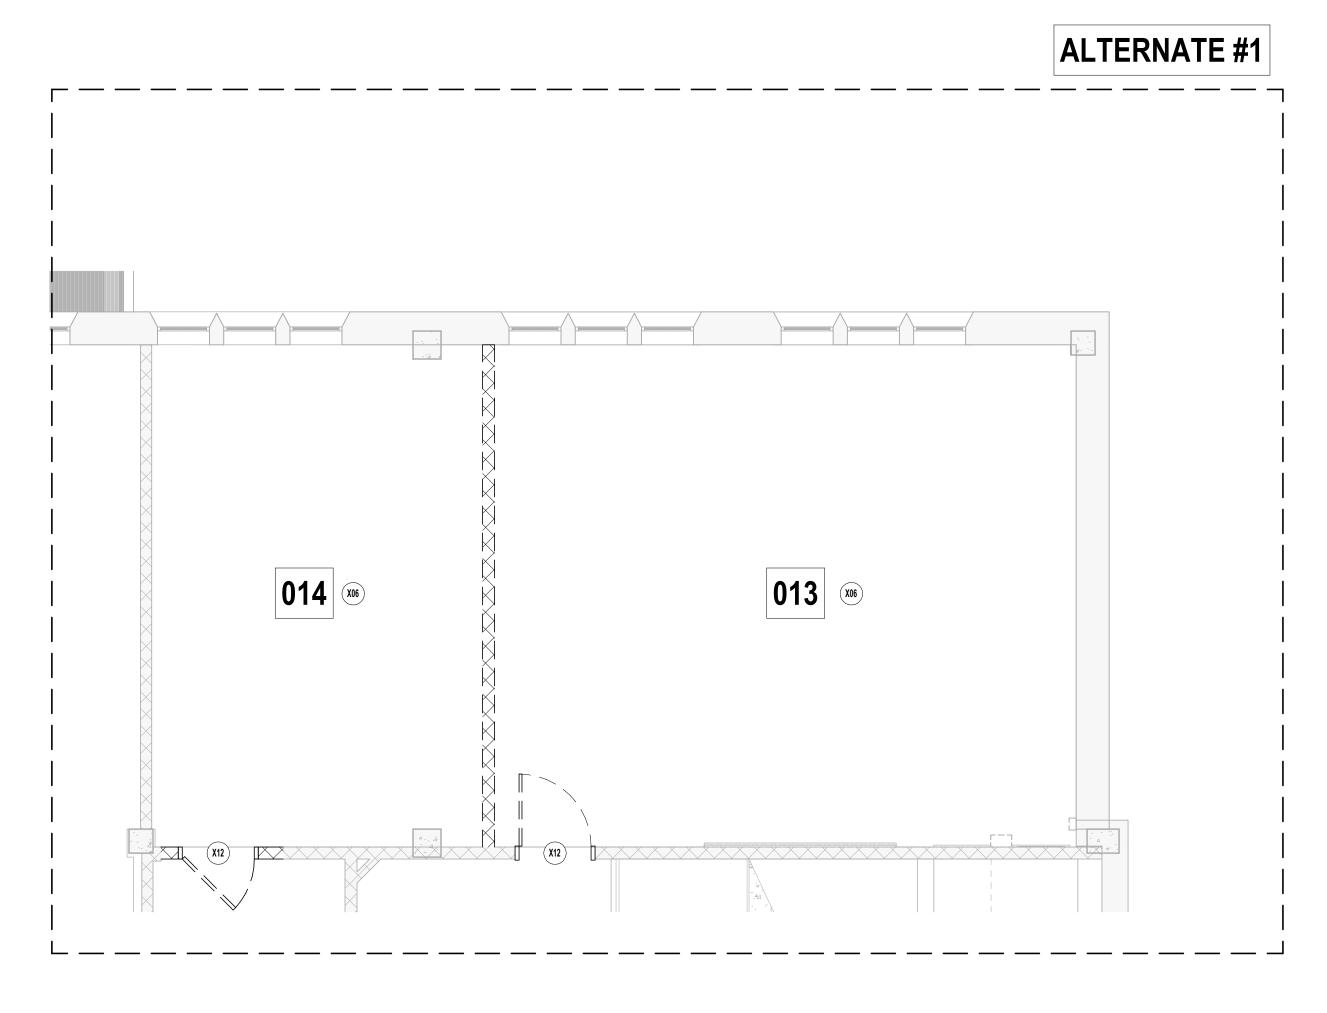

1 SWAIN - ENLARGED DEMO PLAN - BASEMENT LEVEL - 013/014 AD100 1/4" = 1'-0"

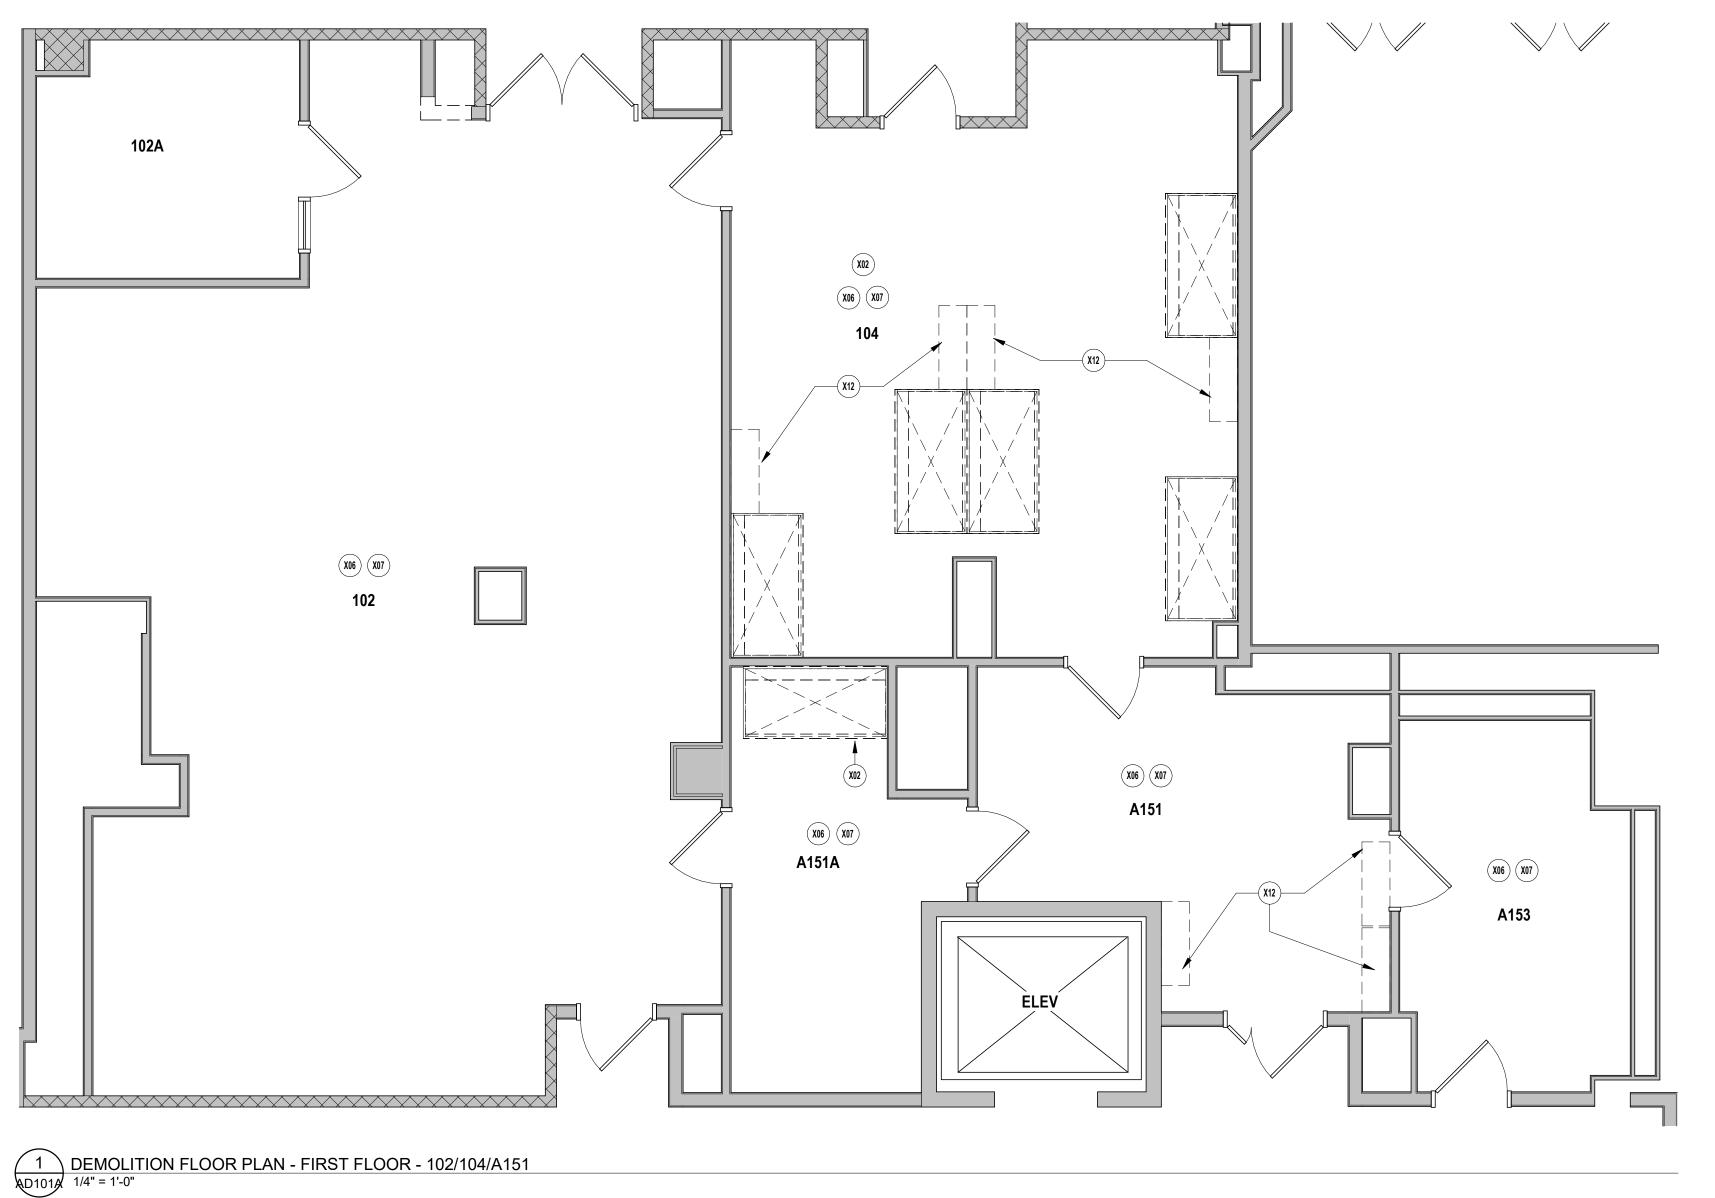

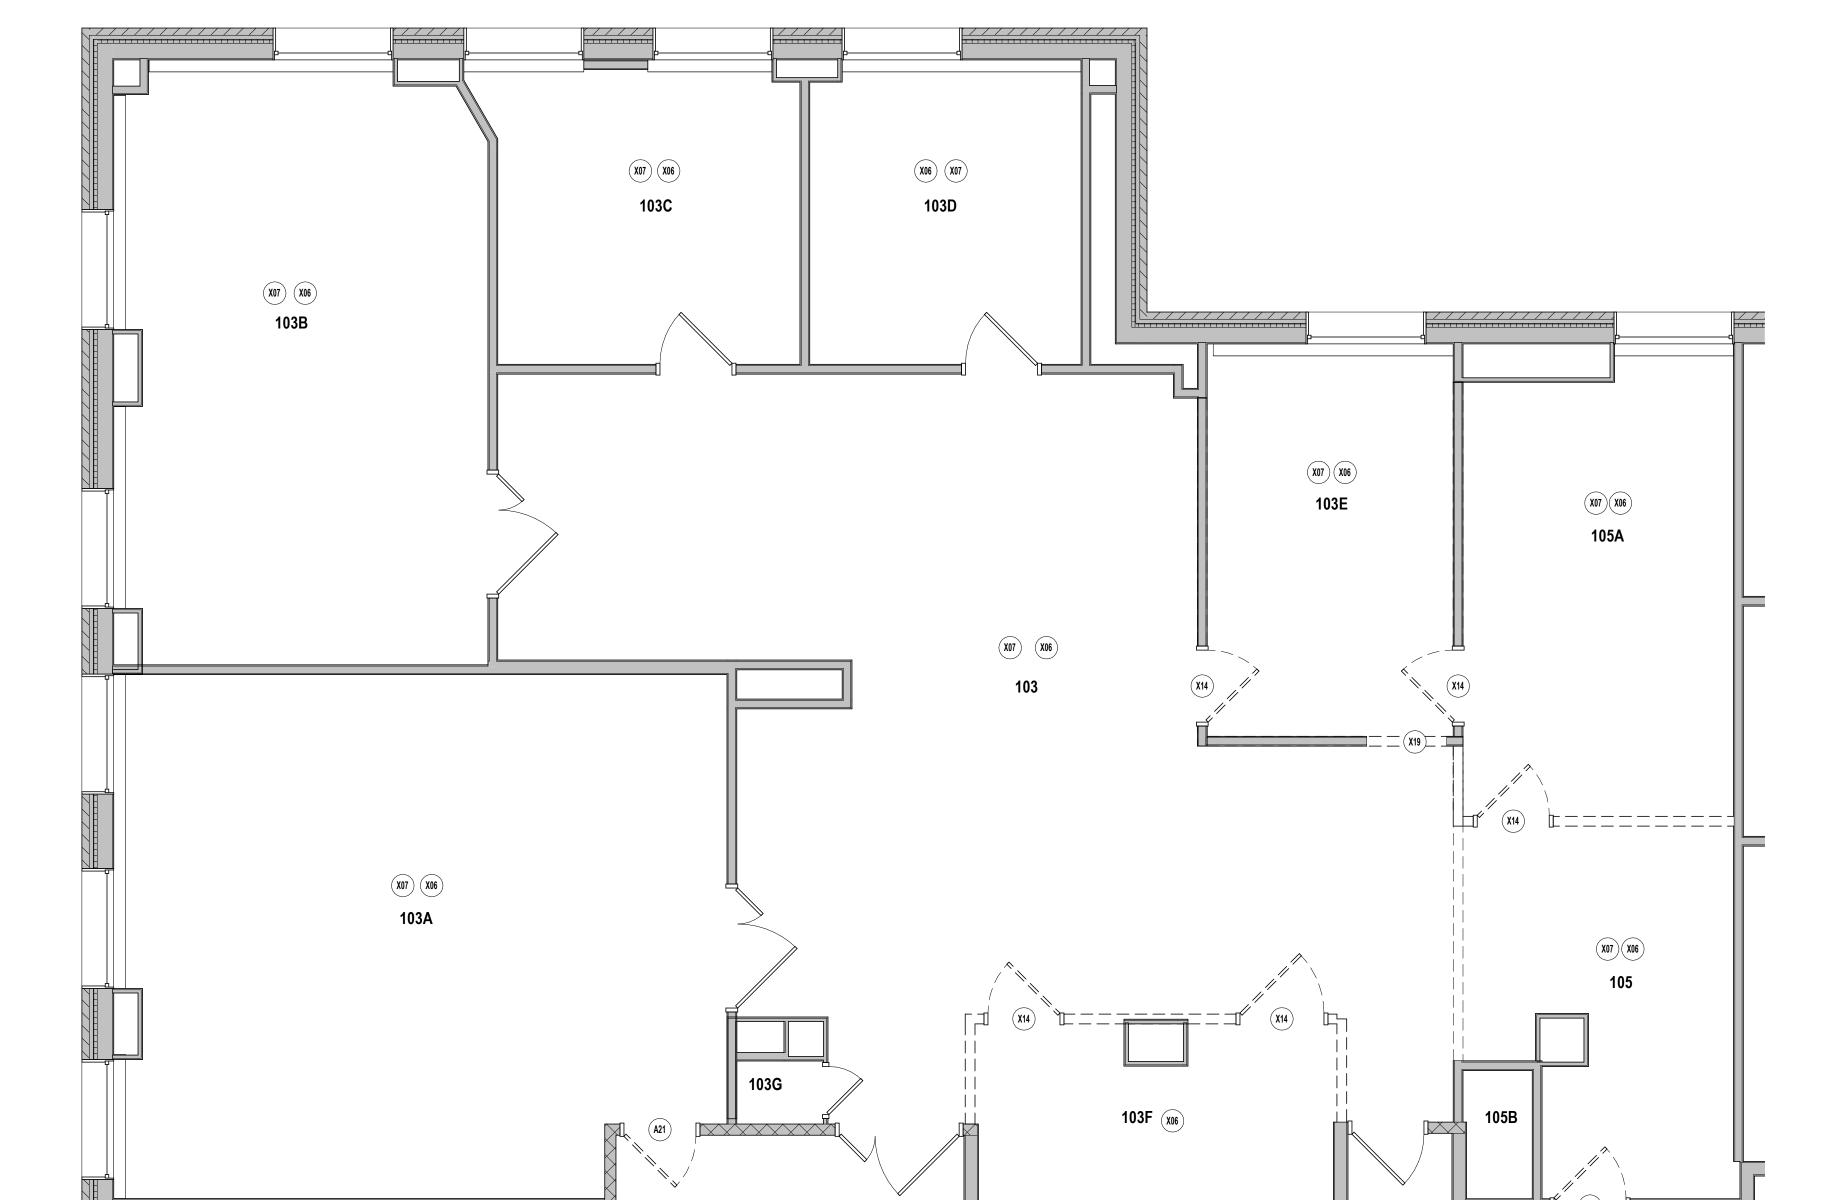

DEMOLITION FLOOR PLAN - FIRST FLOOR - 103/105

#### DEMOLITION PLAN LEGEND

#### **DEMOLITION NOTES**

- CALLED OUT, INDICATE EXISTING ITEMS OR WALLS TO BE DEMOLISHED. REMOVE SUCH ITEMS TOTALLY AND COMPLETELY. REMOVE ALL EXISTING WALL MOUNTED ITEMS WITHIN THE PROJECT LIMIT AREA WHICH ARE NOT NOTED TO REMAIN. DISPOSE OF THESE ITEMS AFTER INSPECTION BY THE OWNER DETERMINES
- THEY ARE NOT TO BE SALVAGED. IF ITEMS ARE REMOVED FROM WALLS THAT ARE TO REMAIN, PATCH WALLS AS REQUIRED TO RECEIVE NEW FINISHES AND/OR SURFACES. REFER TO MECHANICAL, ELECTRICAL AND PLUMBING DRAWINGS AND SPECIFICATIONS FOR ADDITIONAL DEMOLITION INFORMATION. ALL EXISTING BUMP RAILS SHALL BE REMOVED FROM THE WALLS
- TRANSFER TO OWNER. REMOVE EXISTING CEILING FINISHES, INCLUDING BULKHEADS, AS APPLICABLE IN ALL AREAS WITHIN THE PROJECT LIMITS THAT ARE
- SCHEDULED TO RECEIVE NEW CEILINGS. WHERE PENETRATIONS THROUGH EXISTING RATED WALL PARTITIONS ARE REMOVED, PATCH AND REPAIR SUCH WALLS TO MAINTAIN THE RATING

S20: https://my.matterport.com/show/?m=cbDohQ7pZAB 011: https://my.matterport.com/show/?m=FKBq75qHyiL 013: https://my.matterport.com/show/?m=avq6XBkX1bb 014: https://my.matterport.com/show/?m=btTEtWUGa4d

#### **Chemistry**

A103's: https://my.matterport.com/show/?m=YDh3tcCFLGb A102/104: https://my.matterport.com/show/?m=UYzVEryTP6K A122: https://my.matterport.com/show/?m=ZG5m22e9eGb A140's: https://my.matterport.com/show/?m=2JTVhPC86kG A150's: https://my.matterport.com/show/?m=ZE2horKeGKT

promonent

EXISTING WALL/PARTITION TO REMAIN  $\square = \square$  Existing Wall/Partition to be removed EXISTING ELEMENT TO BE REMOVED

#### KEYNOTE SCHEDULE

NUMBER REPAIR EXISTING DOOR LEVER. REMOVE EXISTING FUME HOOD AND ASSOCIATED CASEWORK BELOW. PREPARE LOCATION FOR NEW CONSTRUCTION. REMOVE EXISTING FLOORING AND BASE IN THEIR ENTIRETY. PREPARE FLOOR SLAB TO RECEIVE NEW FLOOR FINISH. PREPARE WALL TO RECEIVE NEW BASE. REFER TO INTERIOR FINISH PLANS FOR ADDITIONAL INFORMATION. REMOVE EXISTING CASEWORK, FIXTURES, EQUIPMENT, FURNISHINGS IN THEIR ENTIRETY AND PREPARE SURFACES FOR NEW CASEWORK/FINISHES.. REMOVE EXISTING VENTILATED CABINET AND ASSOCIATED DUCTWORK IN ITS ENTIRETY.

REMOVE DOOR, DOOR FRAME, & ALL ASSOCIATED DOOR HARDWARE. PREPARE SURFACES FOR NEW CONSTRUCTION. BL072 CHEMISTRY PORTION OF EXISTING WALL TO BE REMOVED TO RECEIVE NEW OPENING, SEE ARCHITECTURAL PLANS. PREPARE OPENING TO 800 E KIRKWOOD AVE, BLOOMINGTON, IN 47405 RECEIVE NEW DOOR, FRAME, AND HARDWARE. COORDINATE BL027 SWAIN WEST DIMENSIONS OF OPENING WITH DOOR SCHEDULE. 729 E 3RD ST, BLOOMINGTON, IN 47405 BL070 SIMON HALL 212 S HAWTHORNE DR, BLOOMINGTON, IN 47405

CLIENT PROJECT NO. - 20240397

**BIDDING SET JANUARY 9, 2025** 


MARK DATE DESCRIPTION 3 01/29/25 ADDENDUM 3



BL072 CHEMISTRY -**DEMOLITION PLAN - LEVEL** 


DATE
BSALS PROJECT NO.

AD101A

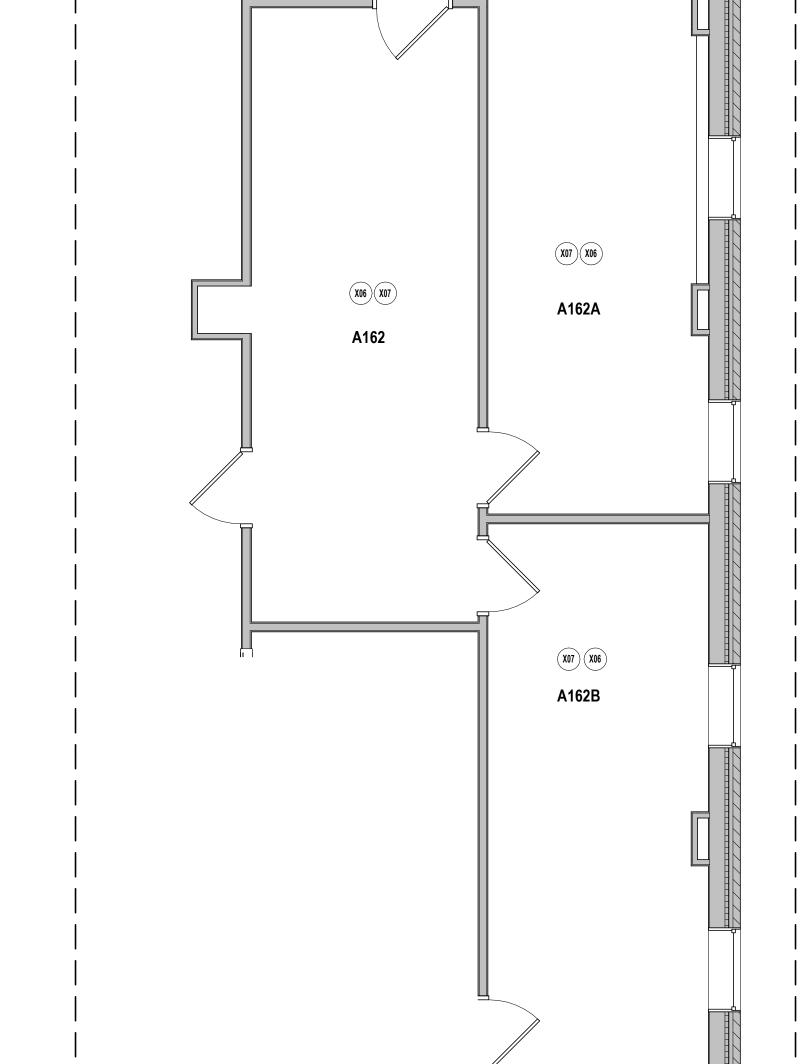

3 DEMOLITION FLOOR PLAN - FIRST FLOOR - 162 SUITE

**ALTERNATE #3** 

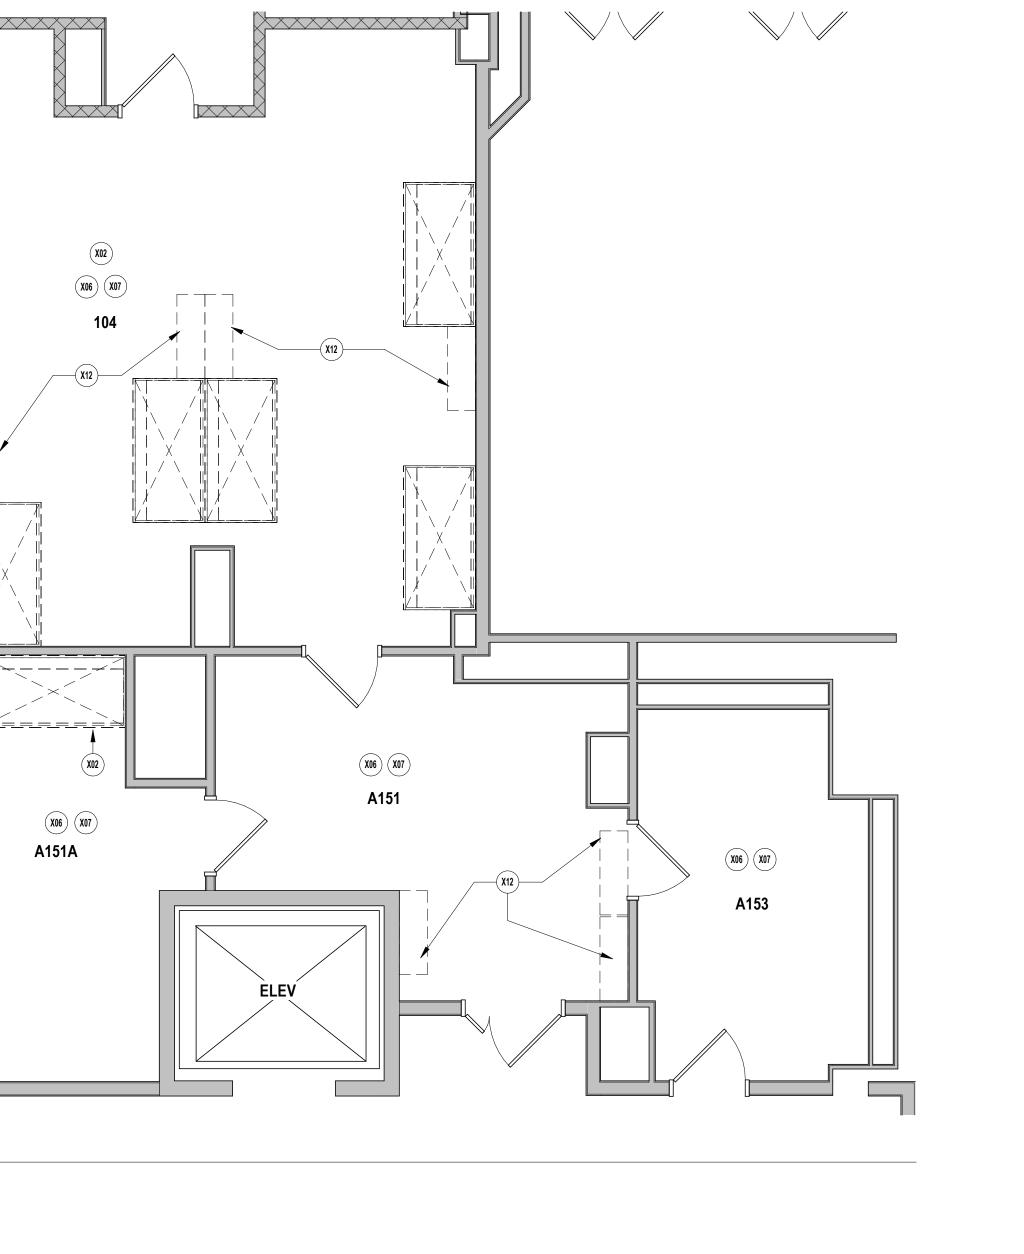

ALL ITEMS SHOWN IN A BOLD DASHED LINE AND NOT OTHERWISE

THAT ARE MARKED AS TO BE REMOVED OR SCHEDULED TO RECEIVE NEW FINISHES. SALVAGE FOR POSSIBLE REUSE OR

MatterPort Scans

Swain West

A251/252: https://my.matterport.com/show/?m=8bjMJSR5EdS

ROOM NAME \_\_\_\_\_EXISTING ROOM NAME AND NUMBER

**IUB** RESEARCH LAB

**RENOVATIONS** 

BSA LifeStructures

9365 Counselors Row, Suite 300

Indianapolis, IN 46240-1478

ph 317.819.7878 fx 317.819.7288

#### DEMOLITION PLAN LEGEND **DEMOLITION NOTES** ALL ITEMS SHOWN IN A BOLD DASHED LINE AND NOT OTHERWISE CALLED OUT, INDICATE EXISTING ITEMS OR WALLS TO BE DEMOLISHED. REMOVE SUCH ITEMS TOTALLY AND COMPLETELY. REMOVE ALL EXISTING WALL MOUNTED ITEMS WITHIN THE PROJECT LIMIT AREA WHICH ARE NOT NOTED TO REMAIN. DISPOSE OF THESE ITEMS AFTER INSPECTION BY THE OWNER DETERMINES THEY ARE NOT TO BE SALVAGED. IF ITEMS ARE REMOVED FROM WALLS THAT ARE TO REMAIN, PATCH WALLS AS REQUIRED TO RECEIVE NEW FINISHES AND/OR SURFACES. REFER TO MECHANICAL, ELECTRICAL AND PLUMBING DRAWINGS AND SPECIFICATIONS FOR ADDITIONAL DEMOLITION INFORMATION. ALL EXISTING BUMP RAILS SHALL BE REMOVED FROM THE WALLS THAT ARE MARKED AS TO BE REMOVED OR SCHEDULED TO RECEIVE NEW FINISHES. SALVAGE FOR POSSIBLE REUSE OR TRANSFER TO OWNER. REMOVE EXISTING CEILING FINISHES, INCLUDING BULKHEADS, AS APPLICABLE IN ALL AREAS WITHIN THE PROJECT LIMITS THAT ARE SCHEDULED TO RECEIVE NEW CEILINGS. WHERE PENETRATIONS THROUGH EXISTING RATED WALL PARTITIONS ARE REMOVED, PATCH AND REPAIR SUCH WALLS TO MADUTADUTHE RATING TO THE RATING THE RATING TO THE RATING TO THE RATING TO THE RATING TO THE RATING THE RATING TO MatterPort Scans Swain West S20: https://my.matterport.com/show/?m=cbDohQ7pZAB 011: https://my.matterport.com/show/?m=FKBq75qHyiL 013: https://my.matterport.com/show/?m=avq6XBkX1bb 014: https://my.matterport.com/show/?m=btTEtWUGa4d <u>Chemistry</u> A103's: https://my.matterport.com/show/?m=YDh3tcCFLGb A102/104: https://my.matterport.com/show/?m=UYzVEryTP6K A122: https://my.matterport.com/show/?m=ZG5m22e9eGb A140's: https://my.matterport.com/show/?m=2JTVhPC86kG A150's: https://my.matterport.com/show/?m=ZE2horKeGKT A251/252: https://my.matterport.com/show/?m=8bjMJSR5EdS Juliun will the second terms of the second ter ROOM NAME \_\_\_\_\_EXISTING ROOM NAME AND NUMBER EXISTING WALL/PARTITION TO REMAIN $\square = \square$ Existing Wall/Partition to be removed EXISTING ELEMENT TO BE REMOVED

#### **IUB** KEYNOTE SCHEDULE NUMBER REMOVE EXISTING FUME HOOD AND ASSOCIATED CASEWORK BELOW. PREPARE LOCATION FOR NEW CONSTRUCTION. EXISTING TO REMAIN. LAB REMOVE EXISTING FLOORING AND BASE IN THEIR ENTIRETY. PREPARE FLOOR SLAB TO RECEIVE NEW FLOOR FINISH. PREPARE WALL TO RECEIVE NEW BASE. REFER TO INTERIOR **RENOVATIONS** FINISH PLANS FOR ADDITIONAL INFORMATION. REMOVE EXISTING CASEWORK, FIXTURES, EQUIPMENT, FURNISHINGS IN THEIR ENTIRETY AND PREPARE SURFACES FOR NEW CASEWORK/FINISHES.. REMOVE DOOR, DOOR FRAME, & ALL ASSOCIATED DOOR HARDWARE. PREPARE SURFACES FOR NEW CONSTRUCTION. REMOVE EXISTING FIN TUBE ENCLOSURE. REMOVE EXISTING WINDOW SILL IN ITS ENTIRETY. PREPARE TO RECEIVE NEW FINISHES.

PORTION OF EXISTING WALL TO BE REMOVED TO RECEIVE NEW

OPENING, SEE ARCHITECTURAL PLANS. PREPARE OPENING TO RECEIVE NEW DOOR, FRAME, AND HARDWARE. COORDINATE

DIMENSIONS OF OPENING WITH DOOR SCHEDULE.

# RESEARCH

BSA LifeStructures

9365 Counselors Row, Suite 300

Indianapolis, IN 46240-1478

ph 317.819.7878 fx 317.819.7288

BL072 CHEMISTRY 800 E KIRKWOOD AVE, BLOOMINGTON, IN 47405 BL027 SWAIN WEST 729 E 3RD ST, BLOOMINGTON, IN 47405 BL070 SIMON HALL 212 S HAWTHORNE DR, BLOOMINGTON, IN 47405

CLIENT PROJECT NO. - 20240397


**BIDDING SET** JANUARY 9, 2025


MARK DATE DESCRIPTION 3 01/29/25 ADDENDUM 3



BL072 CHEMISTRY -DEMOLITION PLAN - LEVEL

DATE
BSALS PROJECT NO.

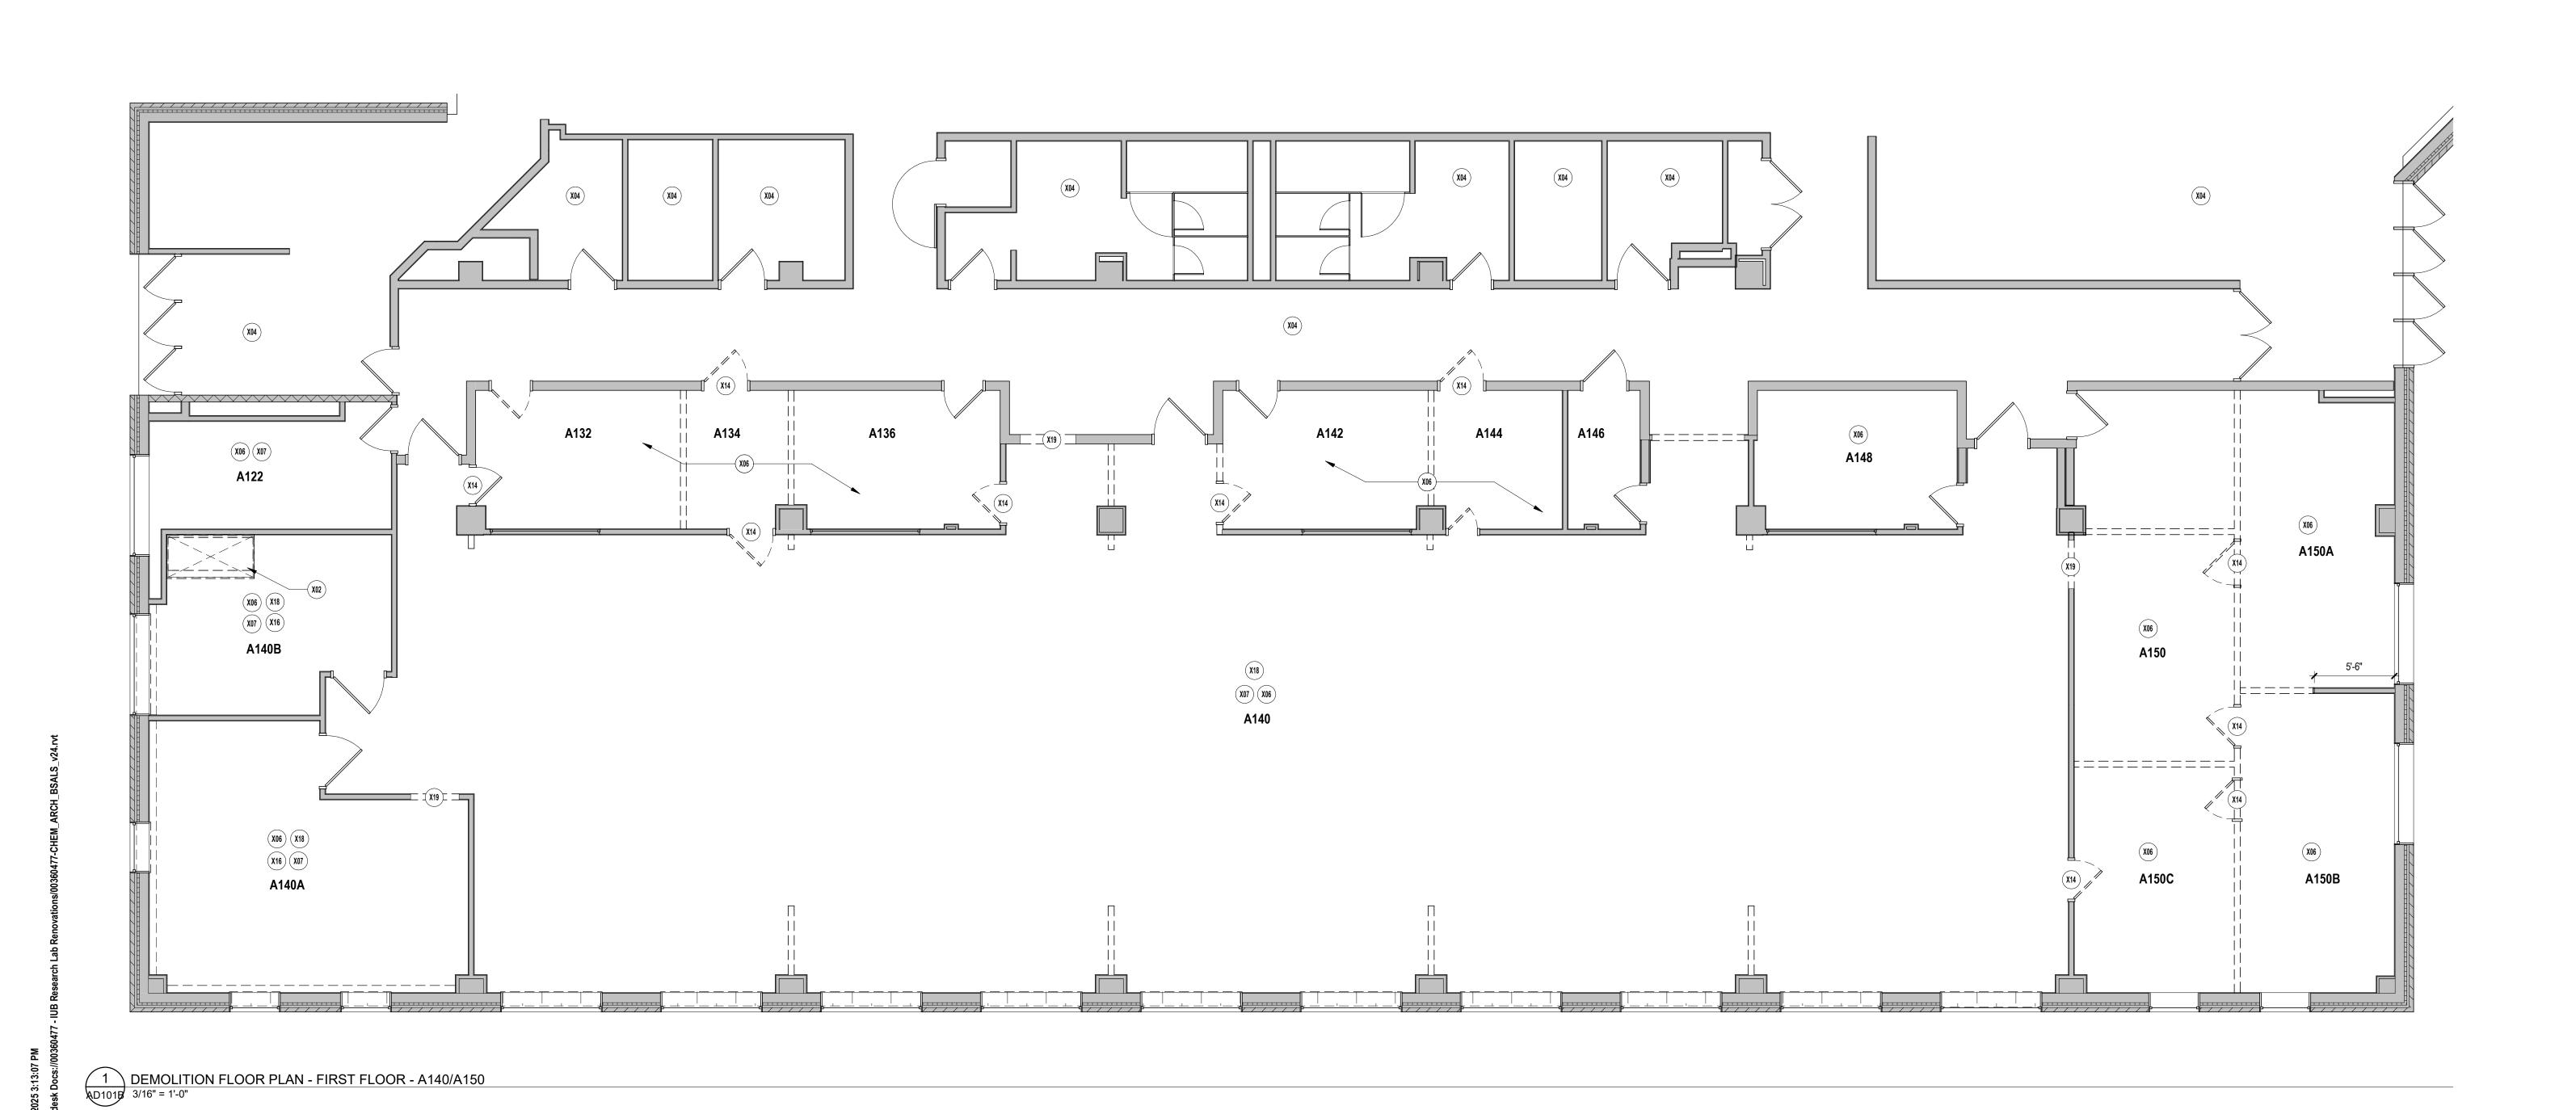

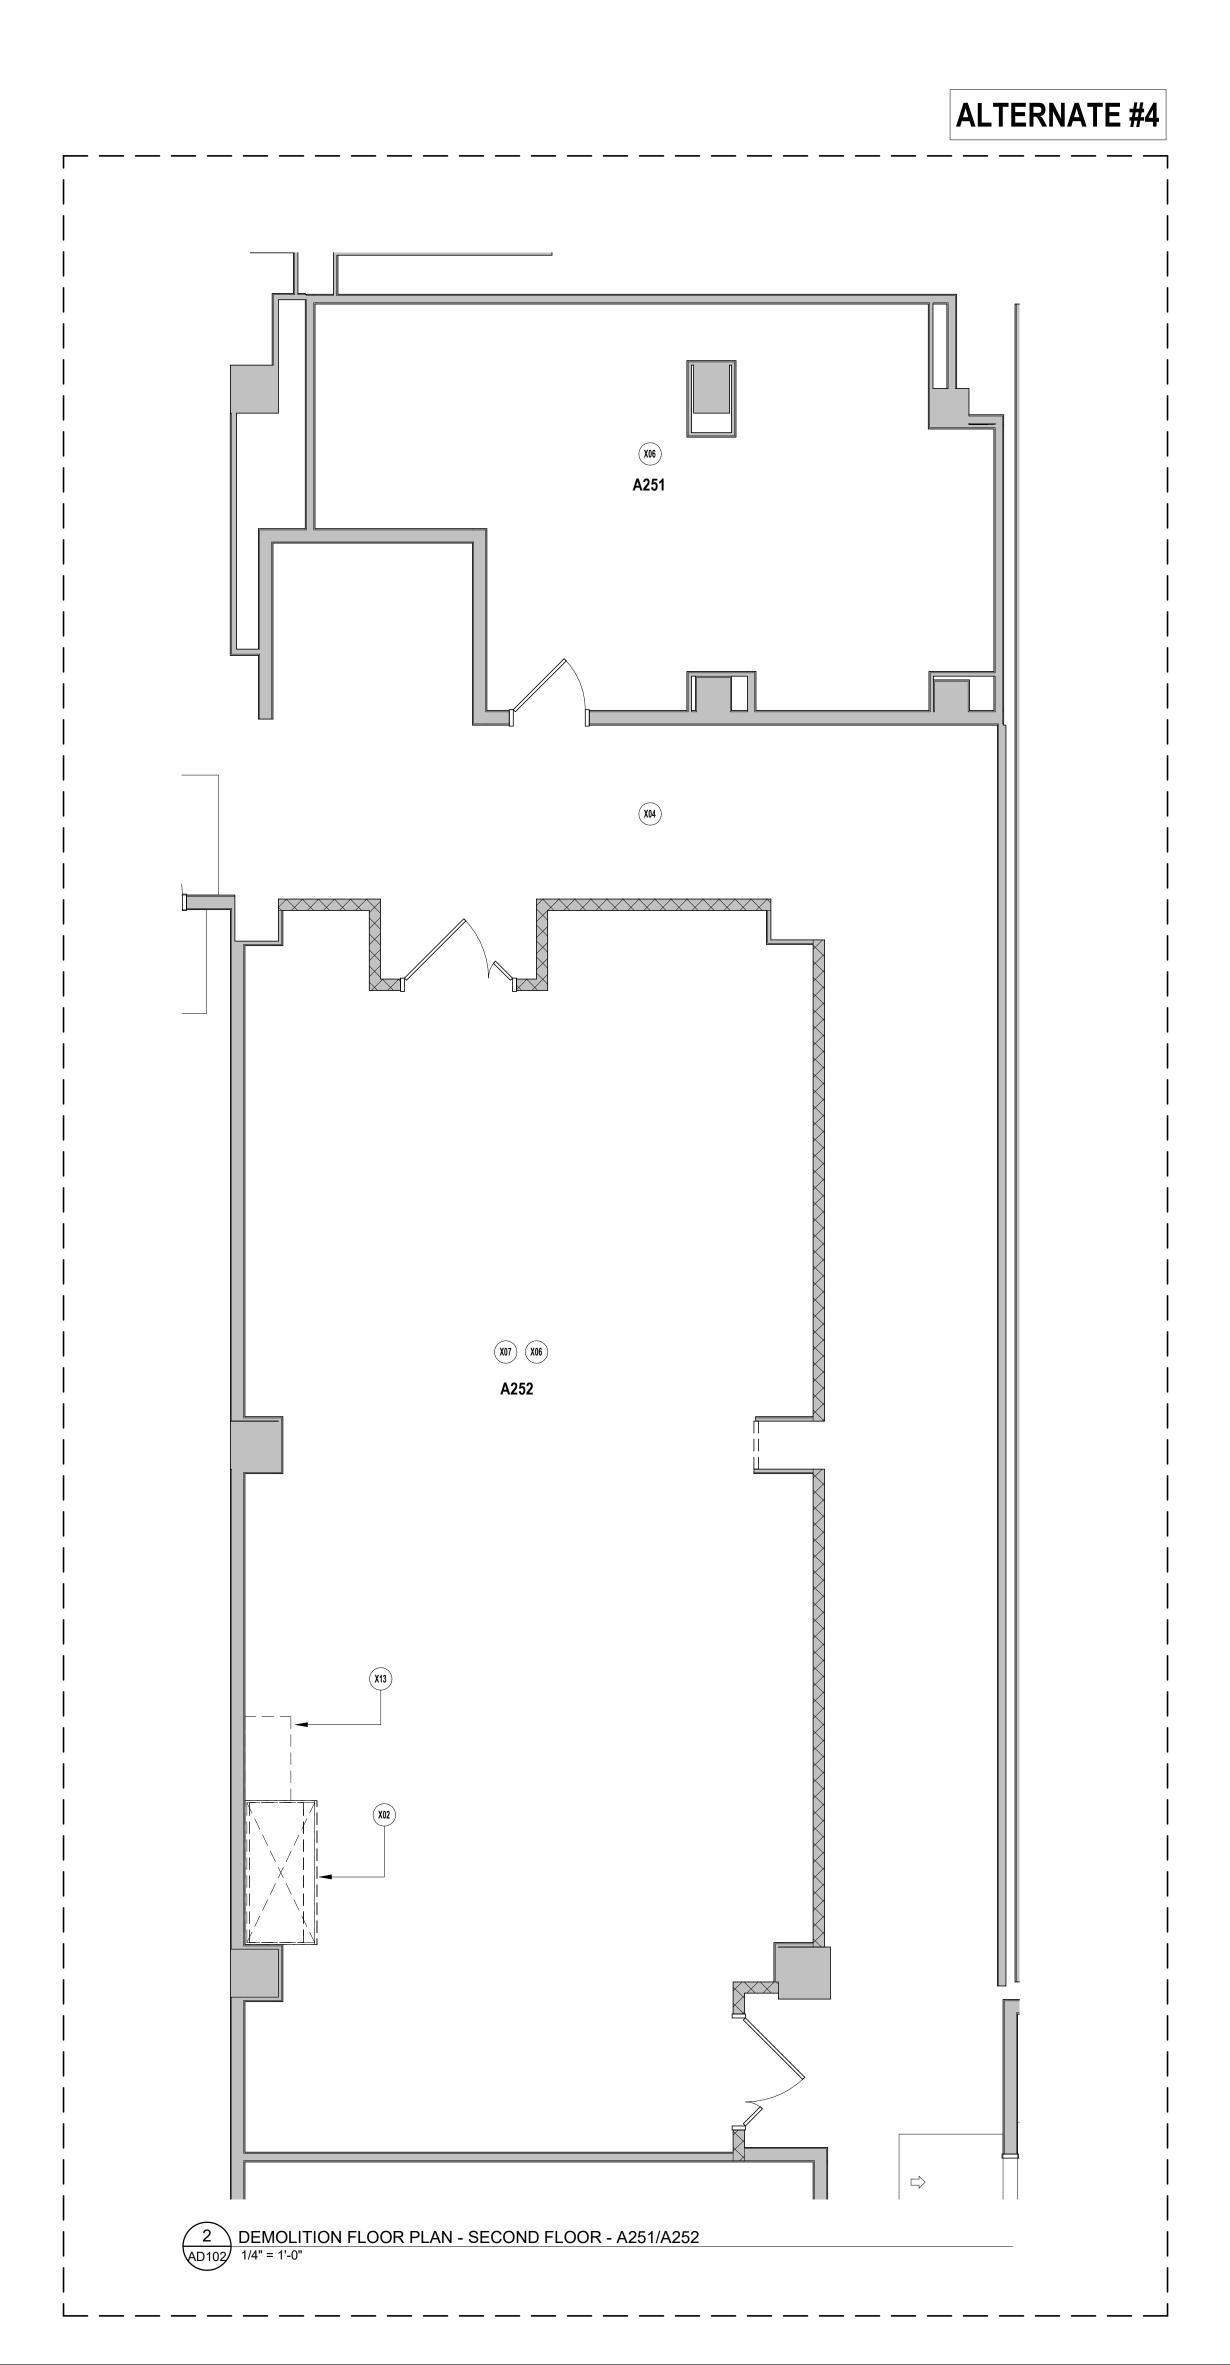

DEMOLITION PLAN LEGEND

#### **DEMOLITION NOTES**

- ALL ITEMS SHOWN IN A BOLD DASHED LINE AND NOT OTHERWISE CALLED OUT, INDICATE EXISTING ITEMS OR WALLS TO BE DEMOLISHED. REMOVE SUCH ITEMS TOTALLY AND COMPLETELY. REMOVE ALL EXISTING WALL MOUNTED ITEMS WITHIN THE PROJECT LIMIT AREA WHICH ARE NOT NOTED TO REMAIN. DISPOSE OF THESE ITEMS AFTER INSPECTION BY THE OWNER DETERMINES THEY ARE NOT TO BE SALVAGED. IF ITEMS ARE REMOVED FROM WALLS THAT ARE TO REMAIN, PATCH WALLS AS REQUIRED TO
- RECEIVE NEW FINISHES AND/OR SURFACES. REFER TO MECHANICAL, ELECTRICAL AND PLUMBING DRAWINGS AND SPECIFICATIONS FOR ADDITIONAL DEMOLITION INFORMATION. ALL EXISTING BUMP RAILS SHALL BE REMOVED FROM THE WALLS THAT ARE MARKED AS TO BE REMOVED OR SCHEDULED TO RECEIVE NEW FINISHES. SALVAGE FOR POSSIBLE REUSE OR
- TRANSFER TO OWNER. REMOVE EXISTING CEILING FINISHES, INCLUDING BULKHEADS, AS APPLICABLE IN ALL AREAS WITHIN THE PROJECT LIMITS THAT ARE
- SCHEDULED TO RECEIVE NEW CEILINGS. WHERE PENETRATIONS THROUGH EXISTING RATED WALL PARTITIONS ARE REMOVED, PATCH AND REPAIR SUCH WALLS TO MAINTAIN THE RATING

#### MatterPort Scans

<u>Swain West</u> S20: https://my.matterport.com/show/?m=cbDohQ7pZAB 011: https://my.matterport.com/show/?m=FKBq75qHyiL 013: https://my.matterport.com/show/?m=avq6XBkX1bb 014: https://my.matterport.com/show/?m=btTEtWUGa4d

#### **Chemistry**

A103's: https://my.matterport.com/show/?m=YDh3tcCFLGb A102/104: https://my.matterport.com/show/?m=UYzVEryTP6K A122: https://my.matterport.com/show/?m=ZG5m22e9eGb A140's: https://my.matterport.com/show/?m=2JTVhPC86kG A150's: https://my.matterport.com/show/?m=ZE2horKeGKT A251/252: https://my.matterport.com/show/?m=8bjMJSR5EdS

ROOM NAME

101

EXISTING ROOM NAME AND NUMBER

EXISTING WALL/PARTITION TO REMAIN  $\square = \square$  Existing Wall/Partition to be removed EXISTING ELEMENT TO BE REMOVED

KEYNOTE SCHEDULE			
NUMBER	TEXT		
X02	REMOVE EXISTING FUME HOOD AND ASSOCIATED CASEWORK BELOW. PREPARE LOCATION FOR NEW CONSTRUCTION.		
X04	EXISTING TO REMAIN.		
X06	REMOVE EXISTING FLOORING AND BASE IN THEIR ENTIRETY. PREPARE FLOOR SLAB TO RECEIVE NEW FLOOR FINISH. PREPARE WALL TO RECEIVE NEW BASE. REFER TO INTERIOR FINISH PLANS FOR ADDITIONAL INFORMATION.		
X07	REMOVE EXISTING CASEWORK, FIXTURES, EQUIPMENT, FURNISHINGS IN THEIR ENTIRETY AND PREPARE SURFACES FOR NEW CASEWORK/FINISHES		
X13	REMOVE EXISTING FULL HEIGHT CHEMICAL STORAGE CABINET AND ASSOCIATED DUCTWORK IN ITS ENTIRETY.		



BSA LifeStructures

9365 Counselors Row, Suite 300

Indianapolis, IN 46240-1478 ph 317.819.7878 fx 317.819.7288

**BL072 CHEMISTRY** 800 E KIRKWOOD AVE, BLOOMINGTON, IN 47405 BL027 SWAIN WEST 729 E 3RD ST, BLOOMINGTON, IN 47405 BL070 SIMON HALL 212 S HAWTHORNE DR, BLOOMINGTON, IN 47405

CLIENT PROJECT NO. - 20240397


**BIDDING SET** JANUARY 9, 2025


MARK DATE DESCRIPTION 3 01/29/25 ADDENDUM 3





BL072 CHEMISTRY -DEMOLITION PLAN - LEVEL


DATE
BSALS PROJECT NO.

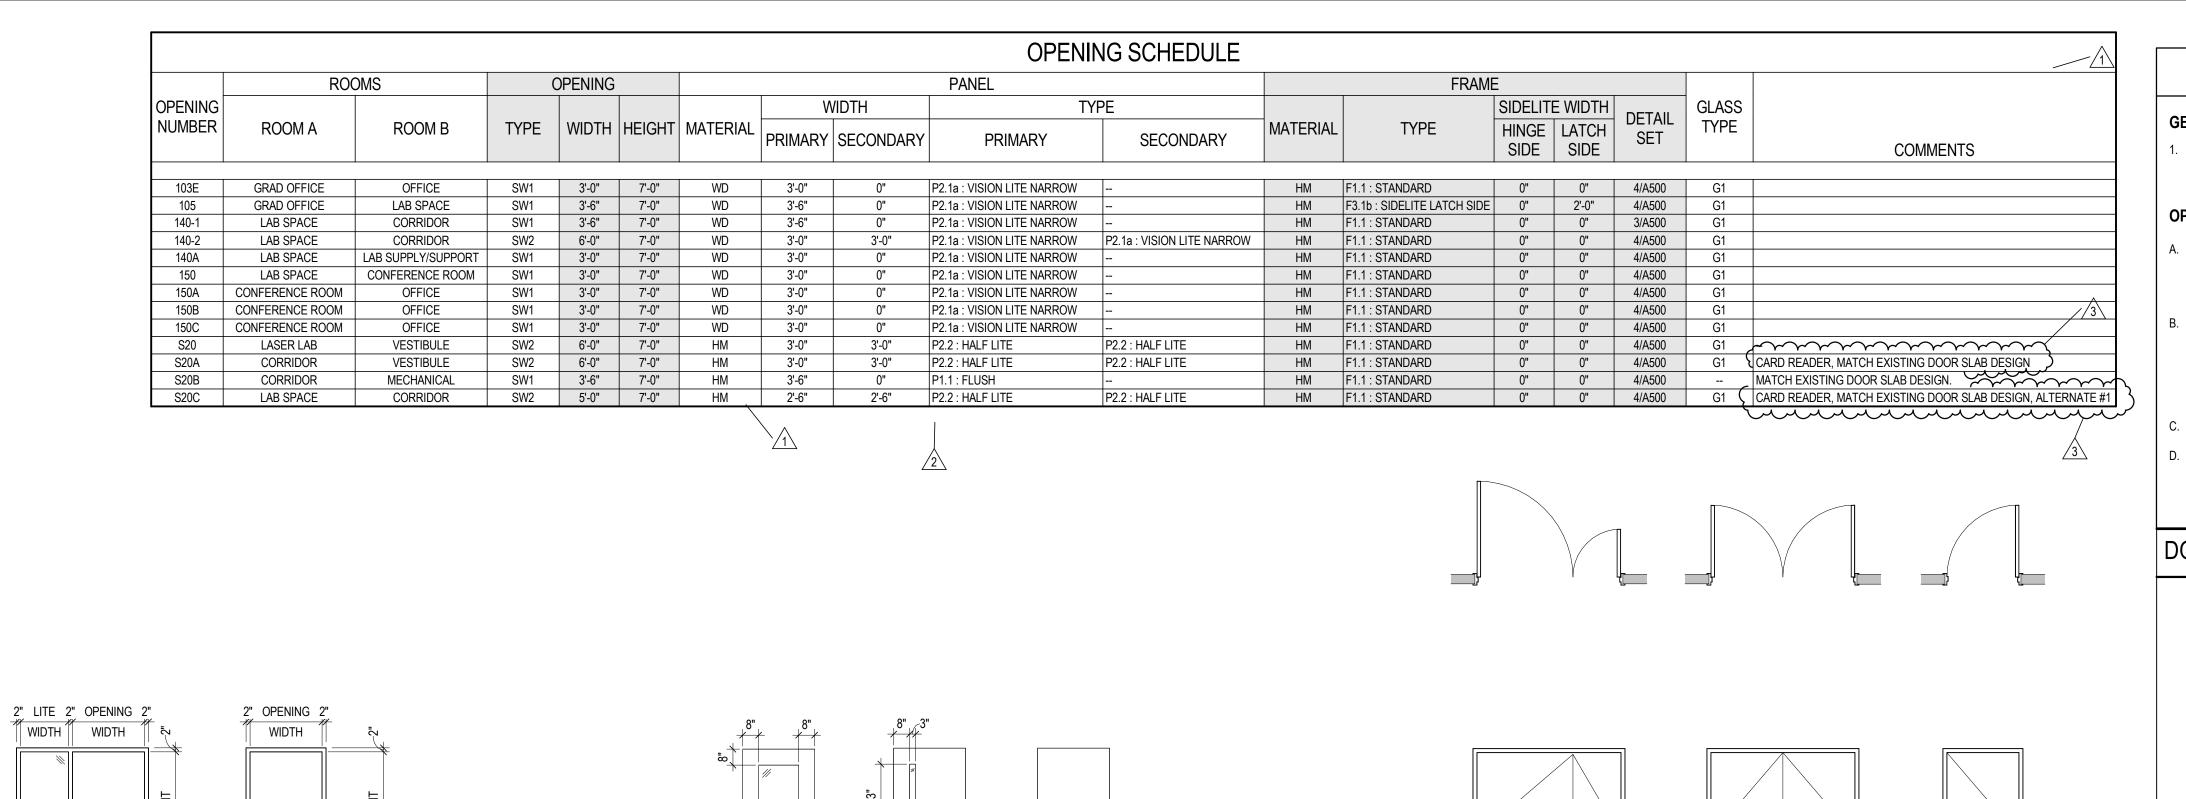

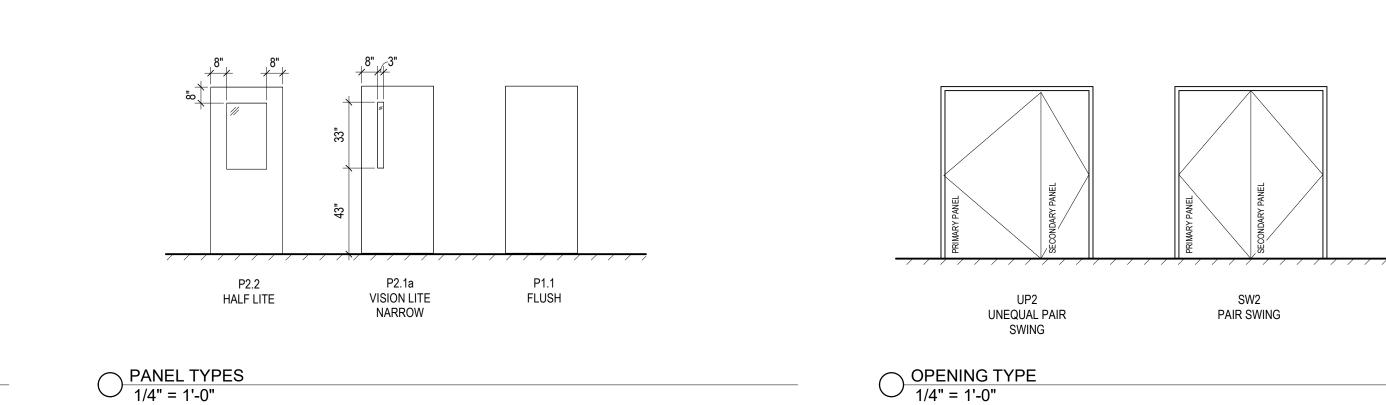

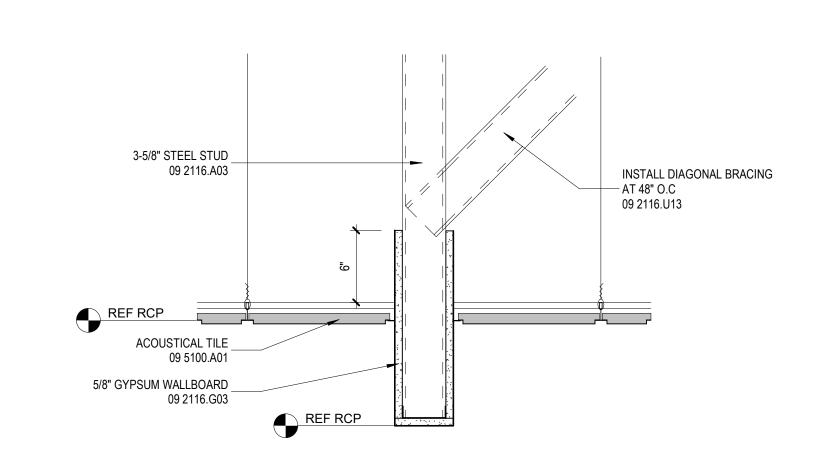

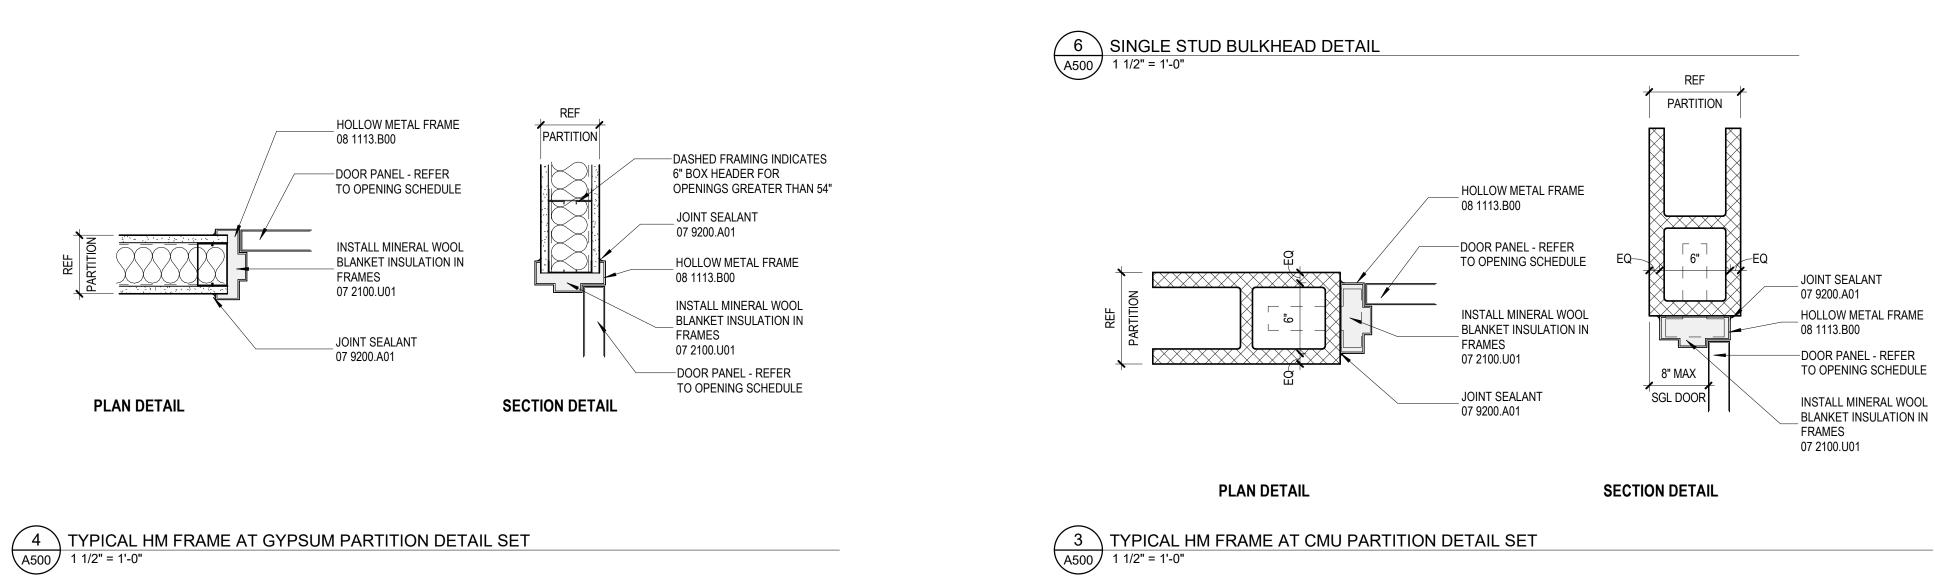

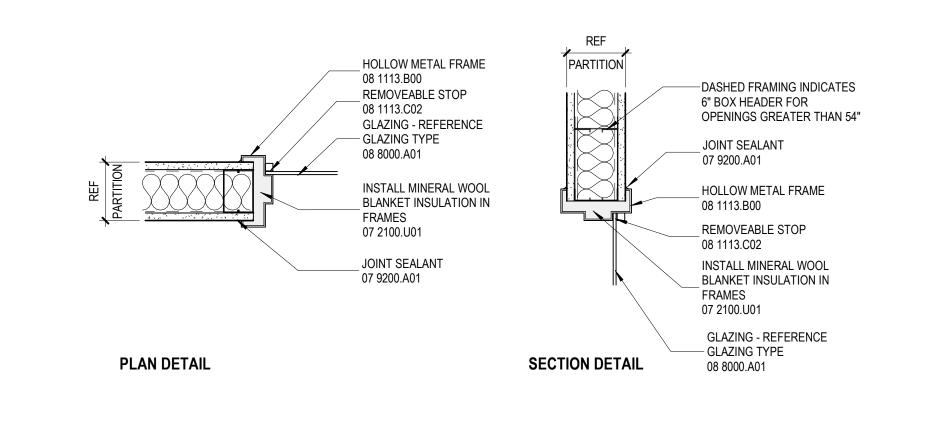

PANEL TYPES
1/4" = 1'-0"




SINGLE SIDELITE


FRAME TYPES


1/4" = 1'-0"

STANDARD

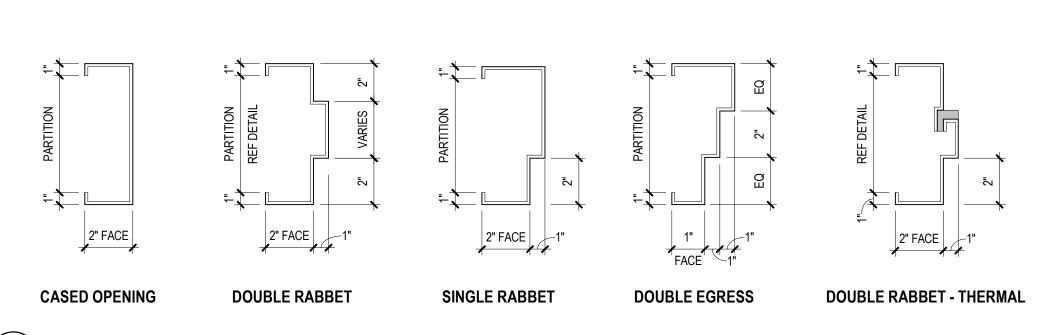



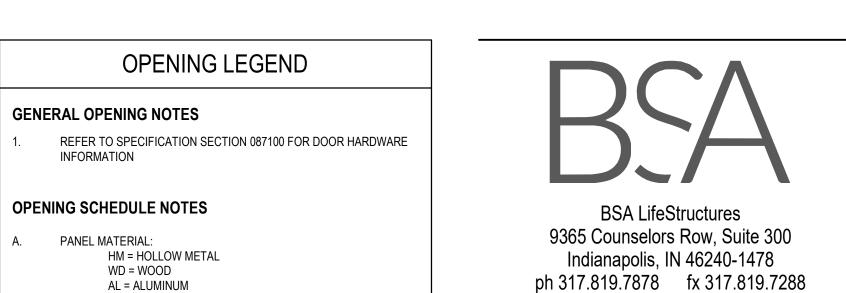

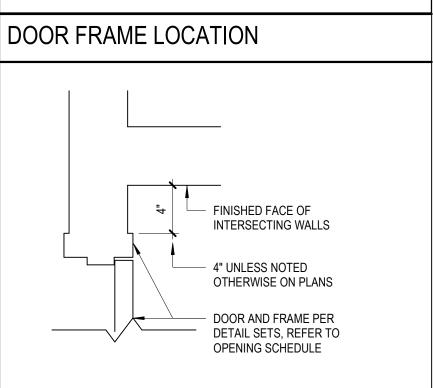

FG = FIBERGLASS

AG = ALL GLASS

UNLESS NOTED OTHERWISE

HM = HOLLOW METAL

SF = ALUMINUM STOREFRONT

CW = ALUMINUM CURTAIN WALL

SSF = SPECIALTY STOREFRONT FSF = FIRE-RATED STOREFRONT

HOLLOW METAL FRAMES TO BE 2" WIDE x 5 7/8" DEEP FRAMES,

FRAME TYPES ARE SHOWN AS SEEN FROM THE PUBLIC APPROACH

FRAME MATERIAL:

SIDE OF FRAME

SINGLE SWING

## **IUB** RESEARCH LAB **RENOVATIONS**

BL072 CHEMISTRY 800 E KIRKWOOD AVE, BLOOMINGTON, IN 47405 **BL027 SWAIN WEST** 729 E 3RD ST, BLOOMINGTON, IN 47405 BL070 SIMON HALL 212 S HAWTHORNE DR, BLOOMINGTON, IN 47405

CLIENT PROJECT NO. - 20240397


**BIDDING SET** JANUARY 9, 2025

MARK	DATE	DESCRIPTION
3	01/29/25	ADDENDUM 3
2	01/27/25	ADDENDUM 2
1	01/17/25	ADDENDUM 1



OPENING SCHEDULES, OPENING DETAILS & **ELEVATIONS** 

DATE BSALS PROJECT NO. 00360477

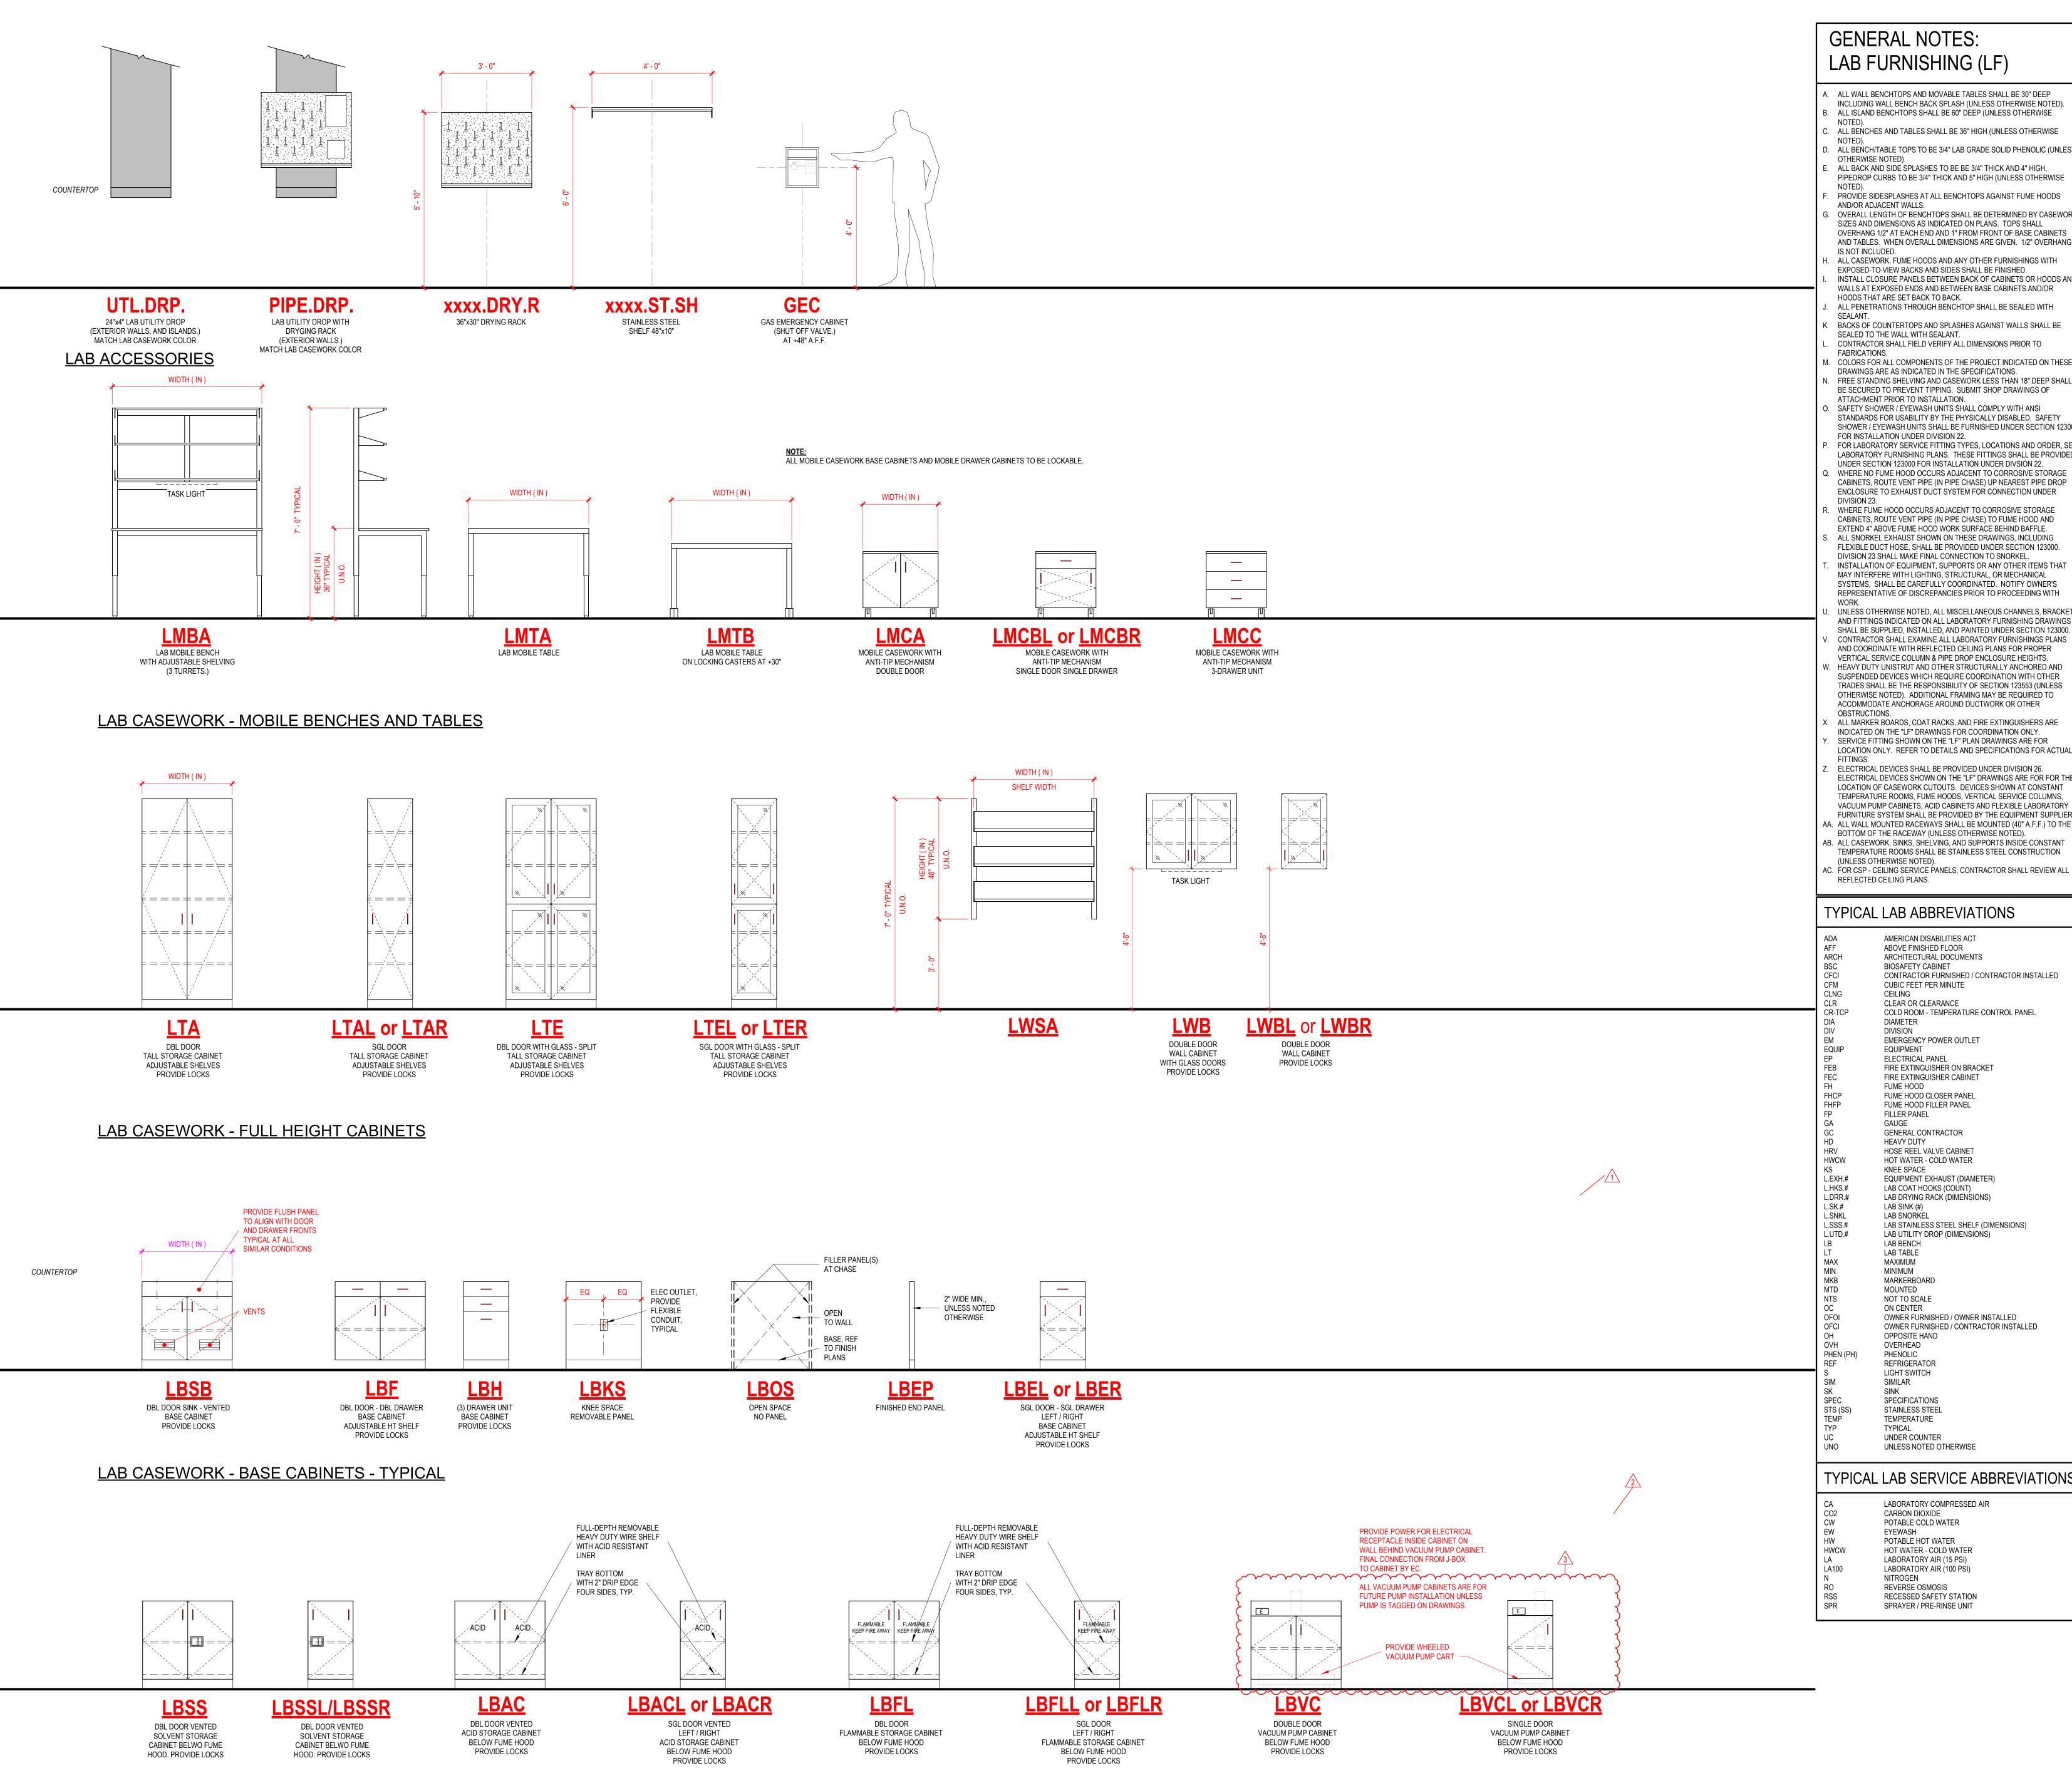

#### **GENERAL NOTES:** LAB FURNISHING (LF)

- ALL WALL BENCHTOPS AND MOVABLE TABLES SHALL BE 30" DEEP INCLUDING WALL BENCH BACK SPLASH (UNLESS OTHERWISE NOTED). ALL ISLAND BENCHTOPS SHALL BE 60" DEEP (UNLESS OTHERWISE
- ALL BENCHES AND TABLES SHALL BE 36" HIGH (UNLESS OTHERWISE ALL BENCH/TABLE TOPS TO BE 3/4" LAB GRADE SOLID PHENOLIC (UNLESS
- OTHERWISE NOTED). ALL BACK AND SIDE SPLASHES TO BE BE 3/4" THICK AND 4" HIGH, PIPEDROP CURBS TO BE 3/4" THICK AND 5" HIGH (UNLESS OTHERWISE
- PROVIDE SIDESPLASHES AT ALL BENCHTOPS AGAINST FUME HOODS AND/OR ADJACENT WALLS. OVERALL LENGTH OF BENCHTOPS SHALL BE DETERMINED BY CASEWORK SIZES AND DIMENSIONS AS INDICATED ON PLANS. TOPS SHALL OVERHANG 1/2" AT EACH END AND 1" FROM FRONT OF BASE CABINETS
- AND TABLES. WHEN OVERALL DIMENSIONS ARE GIVEN. 1/2" OVERHANG IS NOT INCLUDED. ALL CASEWORK, FUME HOODS AND ANY OTHER FURNISHINGS WITH EXPOSED-TO-VIEW BACKS AND SIDES SHALL BE FINISHED.
- INSTALL CLOSURE PANELS BETWEEN BACK OF CABINETS OR HOODS AND WALLS AT EXPOSED ENDS AND BETWEEN BASE CABINETS AND/OR HOODS THAT ARE SET BACK TO BACK.
- BACKS OF COUNTERTOPS AND SPLASHES AGAINST WALLS SHALL BE SEALED TO THE WALL WITH SEALANT.
- CONTRACTOR SHALL FIELD VERIFY ALL DIMENSIONS PRIOR TO FABRICATIONS. M. COLORS FOR ALL COMPONENTS OF THE PROJECT INDICATED ON THESE
- DRAWINGS ARE AS INDICATED IN THE SPECIFICATIONS. FREE STANDING SHELVING AND CASEWORK LESS THAN 18" DEEP SHALL BE SECURED TO PREVENT TIPPING. SUBMIT SHOP DRAWINGS OF ATTACHMENT PRIOR TO INSTALLATION.
- STANDARDS FOR USABILITY BY THE PHYSICALLY DISABLED. SAFETY SHOWER / EYEWASH UNITS SHALL BE FURNISHED UNDER SECTION 123000 FOR INSTALLATION UNDER DIVISION 22. FOR LABORATORY SERVICE FITTING TYPES, LOCATIONS AND ORDER, SEE
- LABORATORY FURNISHING PLANS. THESE FITTINGS SHALL BE PROVIDED UNDER SECTION 123000 FOR INSTALLATION UNDER DIVSION 22. WHERE NO FUME HOOD OCCURS ADJACENT TO CORROSIVE STORAGE CABINETS, ROUTE VENT PIPE (IN PIPE CHASE) UP NEAREST PIPE DROP
- ENCLOSURE TO EXHAUST DUCT SYSTEM FOR CONNECTION UNDER WHERE FUME HOOD OCCURS ADJACENT TO CORROSIVE STORAGE
- CABINETS, ROUTE VENT PIPE (IN PIPE CHASE) TO FUME HOOD AND EXTEND 4" ABOVE FUME HOOD WORK SURFACE BEHIND BAFFLE. ALL SNORKEL EXHAUST SHOWN ON THESE DRAWINGS, INCLUDING
- FLEXIBLE DUCT HOSE, SHALL BE PROVIDED UNDER SECTION 123000. DIVISION 23 SHALL MAKE FINAL CONNECTION TO SNORKEL. INSTALLATION OF EQUIPMENT, SUPPORTS OR ANY OTHER ITEMS THAT MAY INTERFERE WITH LIGHTING, STRUCTURAL, OR MECHANICAL SYSTEMS, SHALL BE CAREFULLY COORDINATED. NOTIFY OWNER'S REPRESENTATIVE OF DISCREPANCIES PRIOR TO PROCEEDING WITH
- UNLESS OTHERWISE NOTED, ALL MISCELLANEOUS CHANNELS, BRACKETS AND FITTINGS INDICATED ON ALL LABORATORY FURNISHING DRAWINGS SHALL BE SUPPLIED, INSTALLED, AND PAINTED UNDER SECTION 123000. CONTRACTOR SHALL EXAMINE ALL LABORATORY FURNISHINGS PLANS AND COORDINATE WITH REFLECTED CEILING PLANS FOR PROPER VERTICAL SERVICE COLUMN & PIPE DROP ENCLOSURE HEIGHTS.
- HEAVY DUTY UNISTRUT AND OTHER STRUCTURALLY ANCHORED AND SUSPENDED DEVICES WHICH REQUIRE COORDINATION WITH OTHER TRADES SHALL BE THE RESPONSIBILITY OF SECTION 123553 (UNLESS OTHERWISE NOTED). ADDITIONAL FRAMING MAY BE REQUIRED TO ACCOMMODATE ANCHORAGE AROUND DUCTWORK OR OTHER OBSTRUCTIONS.
- ALL MARKER BOARDS, COAT RACKS, AND FIRE EXTINGUISHERS ARE INDICATED ON THE "LF" DRAWINGS FOR COORDINATION ONLY. SERVICE FITTING SHOWN ON THE "LF" PLAN DRAWINGS ARE FOR LOCATION ONLY. REFER TO DETAILS AND SPECIFICATIONS FOR ACTUAL
- ELECTRICAL DEVICES SHALL BE PROVIDED UNDER DIVISION 26. ELECTRICAL DEVICES SHOWN ON THE "LF" DRAWINGS ARE FOR FOR THE LOCATION OF CASEWORK CUTOUTS. DEVICES SHOWN AT CONSTANT TEMPERATURE ROOMS, FUME HOODS, VERTICAL SERVICE COLUMNS, VACUUM PUMP CABINETS, ACID CABINETS AND FLEXIBLE LABORATORY
- FURNITURE SYSTEM SHALL BE PROVIDED BY THE EQUIPMENT SUPPLIER AA. ALL WALL MOUNTED RACEWAYS SHALL BE MOUNTED (40" A.F.F.) TO THE BOTTOM OF THE RACEWAY (UNLESS OTHERWISE NOTED).
- AB. ALL CASEWORK, SINKS, SHELVING, AND SUPPORTS INSIDE CONSTANT TEMPERATURE ROOMS SHALL BE STAINLESS STEEL CONSTRUCTION

### TYPICAL LAB ABBREVIATIONS

ARCHITECTURAL DOCUMENTS BIOSAFETY CABINET CONTRACTOR FURNISHED / CONTRACTOR INSTALLED CUBIC FEET PER MINUTE CEILING CLEAR OR CLEARANCE COLD ROOM - TEMPERATURE CONTROL PANEL DIAMETER DIVISION EMERGENCY POWER OUTLET EQUIPMENT ELECTRICAL PANEL FIRE EXTINGUISHER ON BRACKET FIRE EXTINGUISHER CABINET FUME HOOD FUME HOOD CLOSER PANEL FUME HOOD FILLER PANEL FILLER PANEL GENERAL CONTRACTOR HEAVY DUTY HOSE REEL VALVE CABINET HOT WATER - COLD WATER KNEE SPACE **EQUIPMENT EXHAUST (DIAMETER)** LAB COAT HOOKS (COUNT) LAB DRYING RACK (DIMENSIONS) LAB SINK (#) LAB SNORKEL LAB STAINLESS STEEL SHELF (DIMENSIONS) LAB UTILITY DROP (DIMENSIONS) LAB BENCH LAB TABLE MAXIMUM MINIMUM MARKERBOARD MOUNTED NOT TO SCALE ON CENTER OWNER FURNISHED / OWNER INSTALLED OWNER FURNISHED / CONTRACTOR INSTALLED OPPOSITE HAND OVERHEAD PHENOLIC REFRIGERATOR LIGHT SWITCH SIMILAR SPECIFICATIONS

#### TYPICAL LAB SERVICE ABBREVIATIONS

CA CO2 CW EW HW HWCW LA LA100 N	LABORATORY COMPRESSED AIR CARBON DIOXIDE POTABLE COLD WATER EYEWASH POTABLE HOT WATER HOT WATER - COLD WATER LABORATORY AIR (15 PSI) LABORATORY AIR (100 PSI) NITROGEN REVERSE OSMOSIS	
N RO RSS	NITROGEN REVERSE OSMOSIS RECESSED SAFETY STATION	
SPR	SPRAYER / PRE-RINSE UNIT	

BSA LifeStructures 9365 Counselors Row, Suite 300 Indianapolis, IN 46240-1478 ph 317.819.7878 fx 317.819.7288


## **IUB** RESEARCH LAB RENOVATIONS

**BL072 CHEMISTRY** 800 E KIRKWOOD AVE, BLOOMINGTON, IN 47405 **BL027 SWAIN WEST** 729 E 3RD ST, BLOOMINGTON, IN 47405 BL070 SIMON HALL 212 S HAWTHORNE DR, BLOOMINGTON, IN 47405

CLIENT PROJECT NO. - 20240397

**BIDDING SET** JANUARY 9, 2025


DESCRIPTION MARK DATE 01/29/25 ADDENDUM 3 01/27/25 ADDENDUM 2 01/17/25 ADDENDUM 1

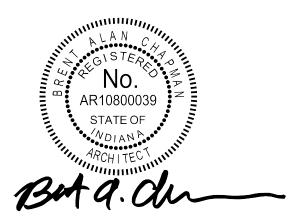



LAB CASEWORK MENU

DATE BSALS PROJECT NO.

00360477

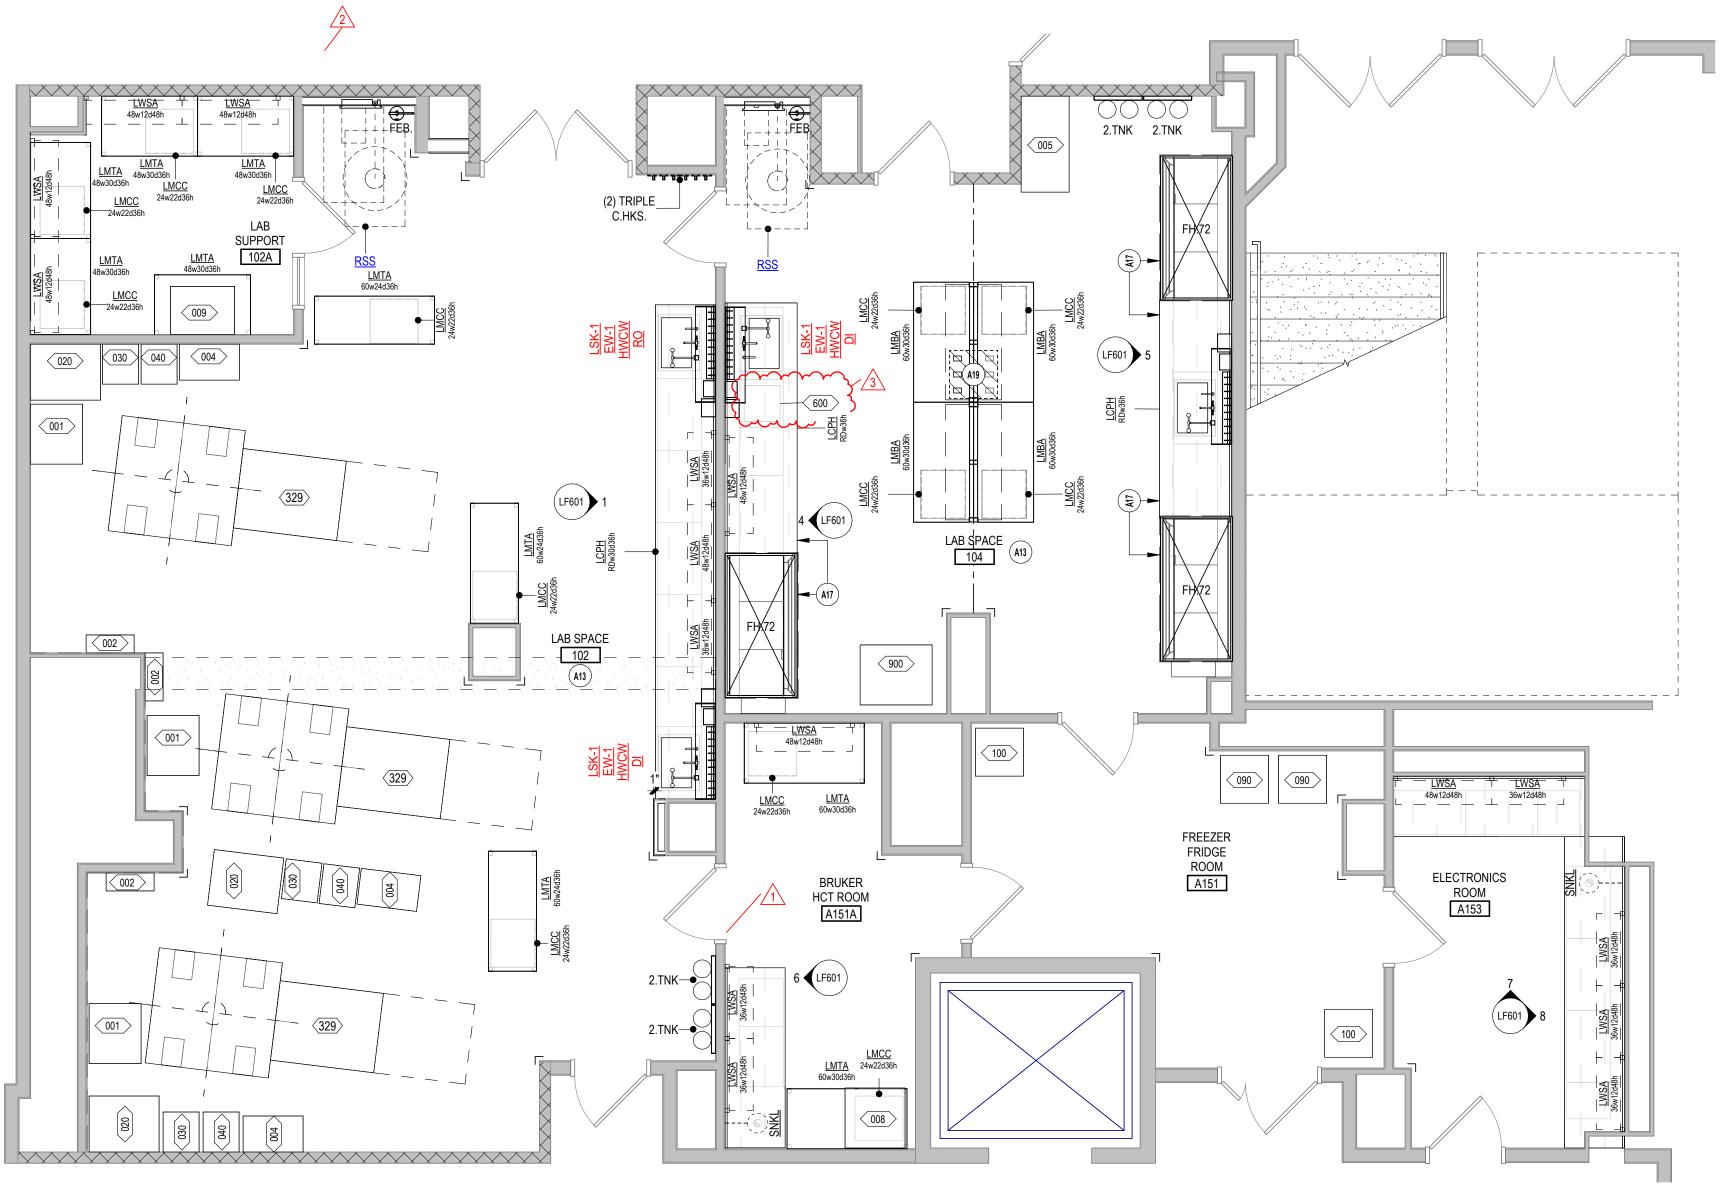

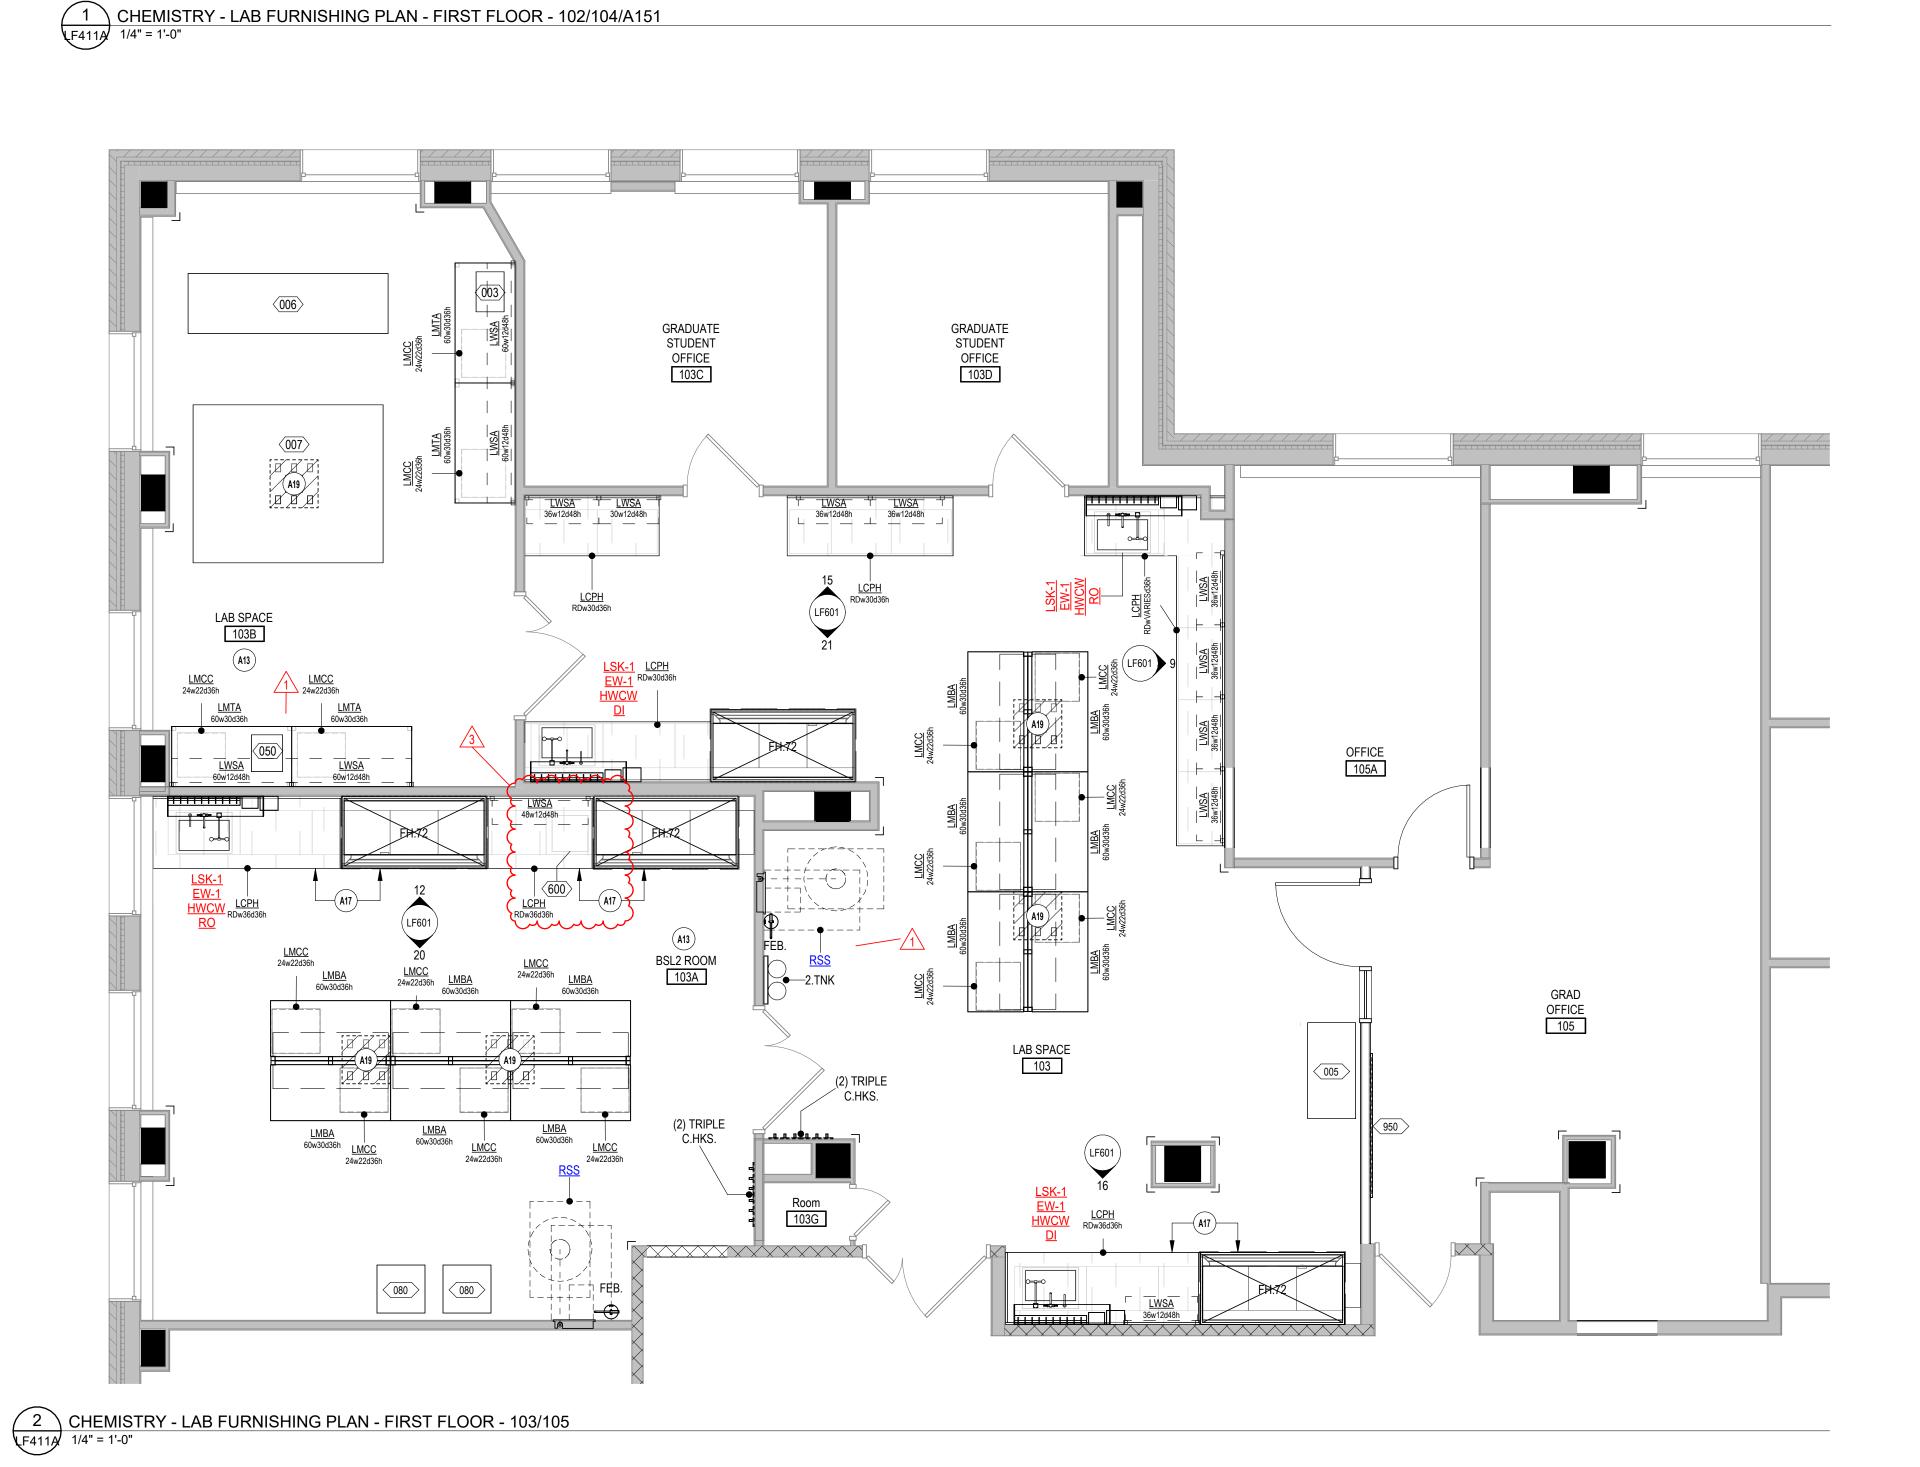

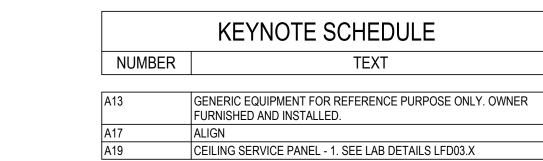

(00)	EQUIPMENT SCHEDULE		
#	NAME	SCOPE	COMMENTS
001	POWER CONDITIONER	0.F.O.I	
002	HELIUM RECOVERY MANIFOLD	C.F.C.I	
003	NANOACUITY UHPLC	0.F.O.I	
004	HEAT EXCHANGER	0.F.O.I	
005	FLAMMABLES CABINET	0.F.O.I	
006	AGILENT 6500	0.F.O.I	
007	TIMSTOFF	0.F.O.I	
008	BRUKER HCT	0.F.O.I	
009	SCIEX 6500	0.F.O.I	
020	CONTROL CONSOLE	0.F.O.I	
030	MAGNET MONITOR	0.F.O.I	
040	CRYOREFRIGERATOR	0.F.O.I	
050	AGILENT 1290	0.F.O.I	
080	-80 FZR	0.F.O.I	
090	-20 FZR	0.F.O.I	
100	FRIDGE FZR	0.F.O.I	
329	BRUKER SOLARIX SERIES ~~~	0.F.O.I ~	~~~
600	LOCAL VACUUM NETWORK PUMP	C.F.C.I	}
900	GENERIC EQUIPMENT	0.F.O.I 📞	
950	MARKERBOARD 48X72	0.F.O.I	

LAB FURNISHINGS SCHEDULE					
NUMBER	NAME	DESCRIPTION	REMARKS		
L.2.TNK	2.TNK	GAS CYLINDER TANK			
L.C.HKS	(2) TRIPLE C.HKS.	COAT HOOKS			
L.DRY.R 3630	3630.DRY.R.	PEG BOARD DRYING RACK			
L.FEB	FEB.	FIRE EXTINGUISHER			
L.FH.72	FH.72	FUME HOOD FH.72			
L.PTD	PTD	PAPER TOWEL DISPENSER			
L.SD	SD	SOAP DISPENSER			
L.SSS4810	SSS4810	STAINLESS STEEL SHELF			



## IUB RESEARCH LAB RENOVATIONS

BL072 CHEMISTRY
800 E KIRKWOOD AVE, BLOOMINGTON, IN 47405
BL027 SWAIN WEST
729 E 3RD ST, BLOOMINGTON, IN 47405
BL070 SIMON HALL
212 S HAWTHORNE DR, BLOOMINGTON, IN 47405

CLIENT PROJECT NO. - 20240397

BIDDING SET JANUARY 9, 2025

MARK	DATE	DESCRIPTION
3	01/29/25	ADDENDUM 3
2	01/27/25	ADDENDUM 2
1	01/17/25	ADDENDUM 1




BL072 CHEMISTRY -ENLARGED LAB FURNISHING PLAN - LEVEL

DATE
BSALS PROJECT NO.

00360477

\_\_\_\_

	KEYNOTE SCHEDULE
NUMBER	TEXT
A13	GENERIC EQUIPMENT FOR REFERENCE PURPOSE ONLY. OWN FURNISHED AND INSTALLED.
A17	ALIGN
A19	CEILING SERVICE PANEL - 1. SEE LAB DETAILS LFD03.X
A20	CEILING SERVICE PANEL - 2 SEE LAB DETAILS LED03 X

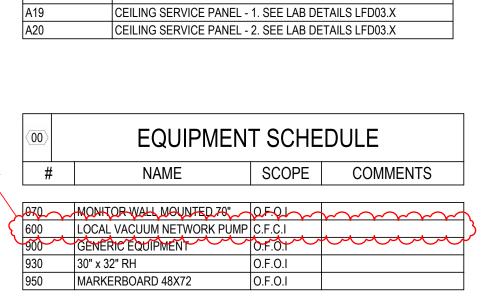

LAB FURNISHINGS SCHEDULE				
NUMBER	NAME	DESCRIPTION	REMARKS	
L.2.TNK	2.TNK	GAS CYLINDER TANK		
L.C.HKS	(2) TRIPLE C.HKS.	COAT HOOKS		
L.DRY.R 3630	3630.DRY.R.	PEG BOARD DRYING RACK		
L.FEB	FEB.	FIRE EXTINGUISHER		
L.FH.72	FH.72	FUME HOOD FH.72		
L.PTD	PTD	PAPER TOWEL DISPENSER		
L.SD	SD	SOAP DISPENSER		
L.SSS4810	SSS4810	STAINLESS STEEL SHELF		




## IUB RESEARCH LAB RENOVATIONS

BL072 CHEMISTRY
800 E KIRKWOOD AVE, BLOOMINGTON, IN 47405
BL027 SWAIN WEST
729 E 3RD ST, BLOOMINGTON, IN 47405
BL070 SIMON HALL
212 S HAWTHORNE DR, BLOOMINGTON, IN 47405

CLIENT PROJECT NO. - 20240397

BIDDING SET JANUARY 9, 2025

4RK	DATE	DESCRIPTION
3	01/29/25	ADDENDUM 3
1	01/17/25	ADDENDUM 1

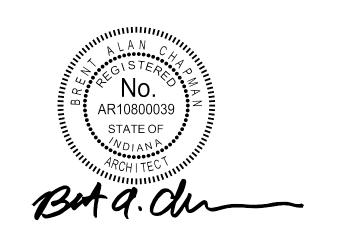

BL072 CHEMISTRY -ENLARGED LAB FURNISHING PLAN - LEVEL

DATE
BSALS PROJECT NO.

00360

LF411B



KEYNOTE SCHEDULE NUMBER TEXT CEILING SERVICE PANEL - 1. SEE LAB DETAILS LFD03.X

LAB FURNISHINGS SCHEDULE				
NUMBER	NAME	DESCRIPTION	REMAR	
L.2.TNK	2.TNK	GAS CYLINDER TANK		
L.C.HKS	(2) TRIPLE C.HKS.	COAT HOOKS		
L.DRY.R 3630	3630.DRY.R.	PEG BOARD DRYING RACK		
L.FEB	FEB.	FIRE EXTINGUISHER		
L.FH.72	FH.72	FUME HOOD FH.72		
L.PTD	PTD	PAPER TOWEL DISPENSER		
L.SD	SD	SOAP DISPENSER		
L.SSS4810	SSS4810	STAINLESS STEEL SHELF		



 $\cdots$ EQUIPMENT SCHEDULE COMMENTS 600 LOCAL VACUUM NETWORK PUMP | C.F.C.I

## **IUB** RESEARCH LAB **RENOVATIONS**

**BL072 CHEMISTRY** 800 E KIRKWOOD AVE, BLOOMINGTON, IN 47405 BL027 SWAIN WEST 729 E 3RD ST, BLOOMINGTON, IN 47405 BL070 SIMON HALL 212 S HAWTHORNE DR, BLOOMINGTON, IN 47405

CLIENT PROJECT NO. - 20240397

**BIDDING SET JANUARY 9, 2025** 


MARK	DATE	DESCRIPTION
3	01/29/25	ADDENDUM 3
1	01/17/25	ADDENDUM 1



BL072 CHEMISTRY -**ENLARGED LAB** FURNISHING PLAN - LEVEL

DATE BSALS PROJECT NO.

LF412

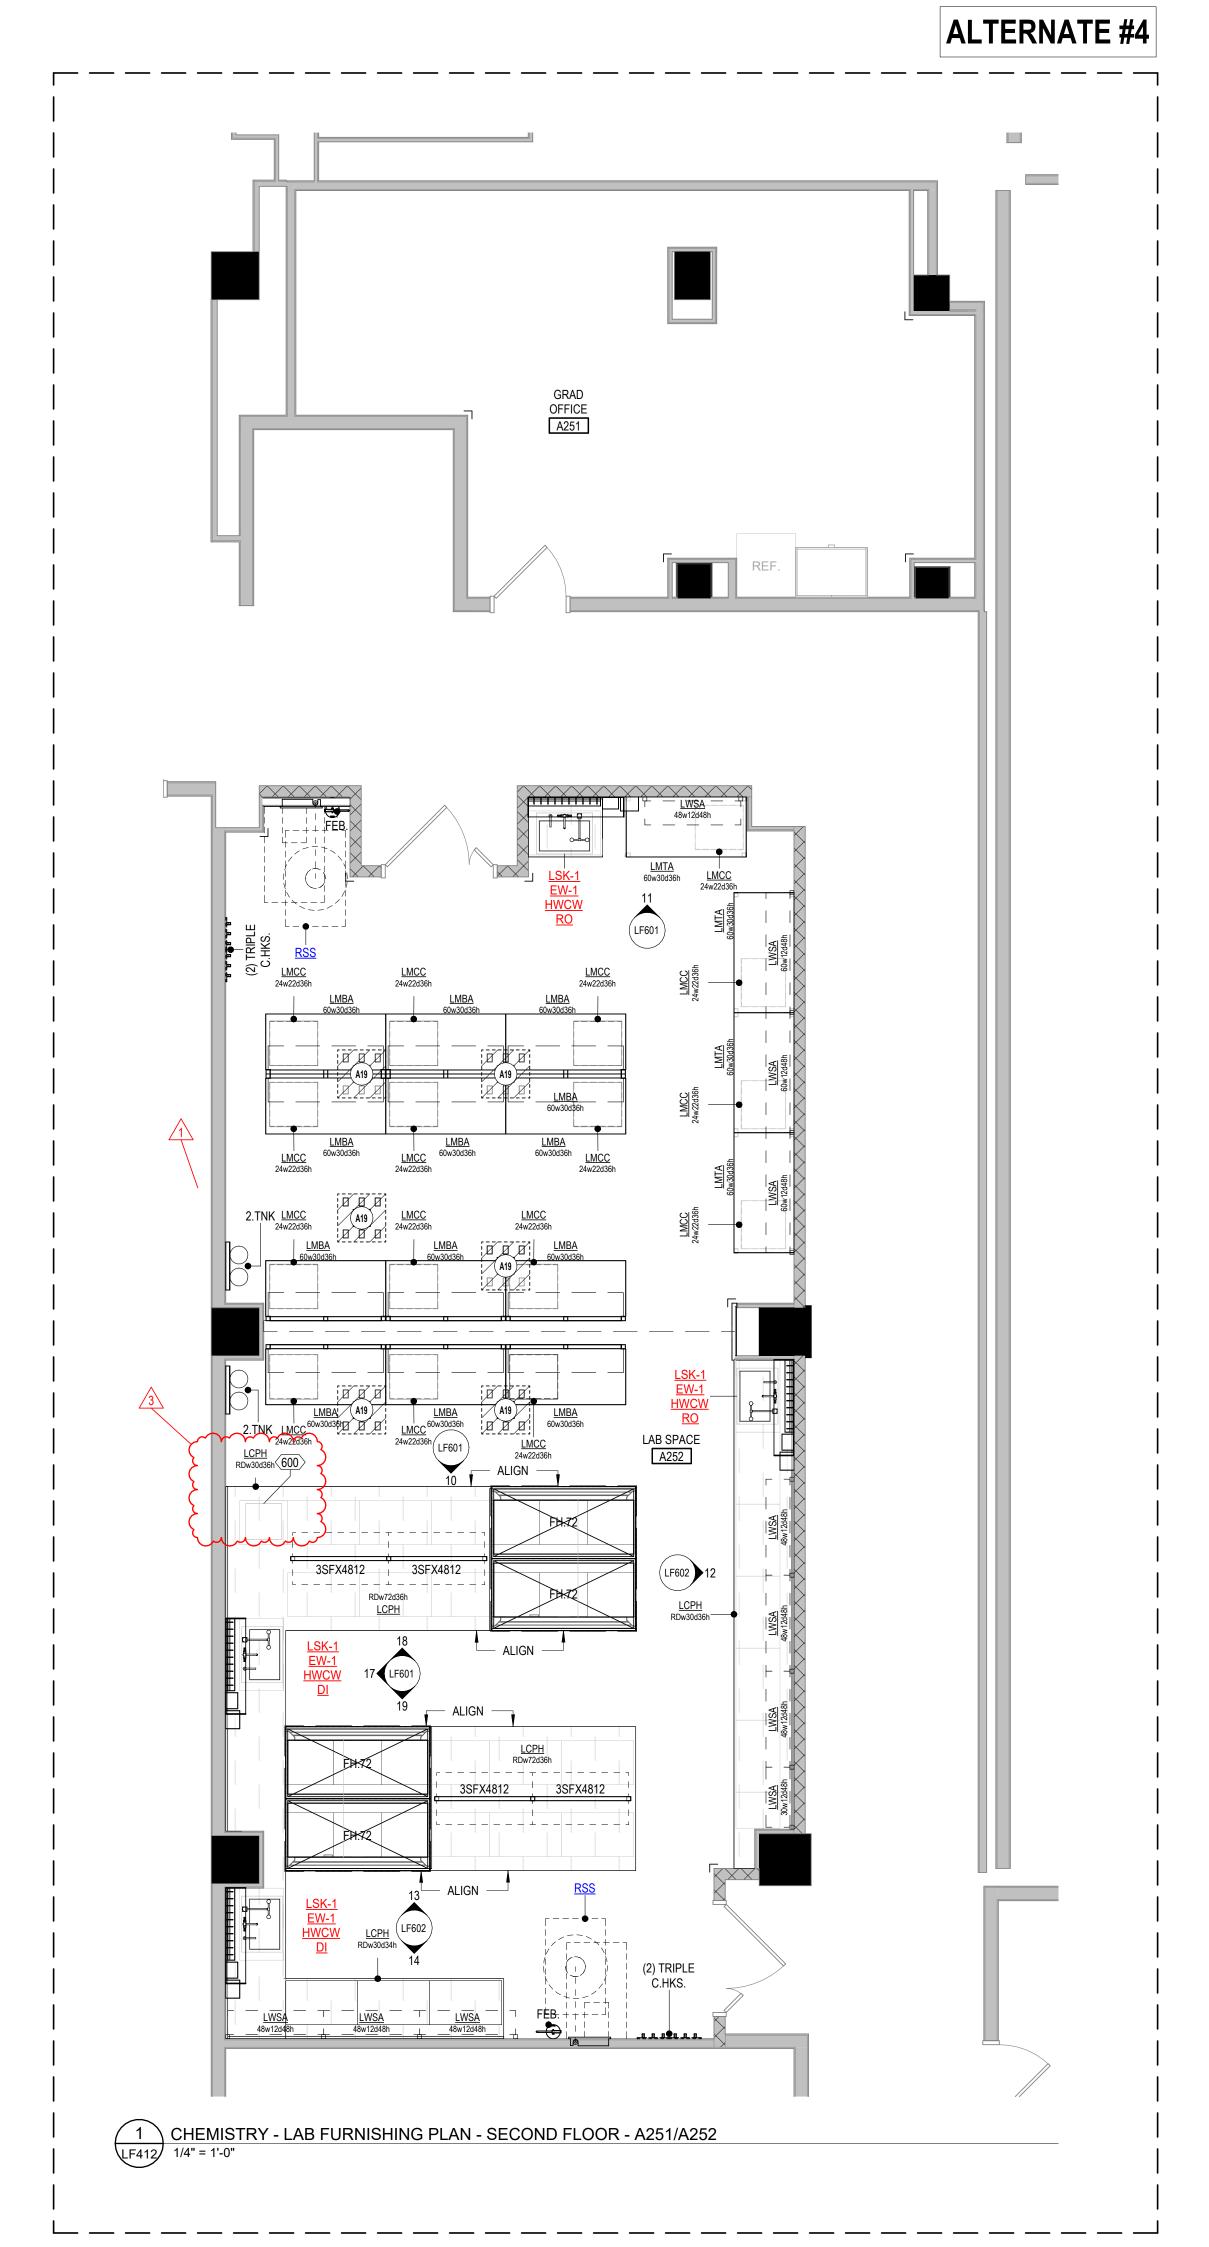



4 LAB INTERIOR ELEVATIONS
1/4" = 1'-0"

1'-8"

1 LAB INTERIOR ELEVATIONS
1/4" = 1'-0"

#### INTERIOR ELEVATION LEGEND

#### INTERIOR ELEVATION NOTES

- REFER TO FLOOR PLANS AND THE EQUIPMENT SCHEDULE FOR EQUIPMENT. COORDINATE CONNECTIONS. REFER TO MECHANICAL,
- ELECTRICAL AND PLUMBING DRAWINGS FOR ADDITIONAL INFORMATION. ALL DIMENSIONS ARE TAKEN TO THE FACE OF FINISHED MATERIAL,
- UNLESS NOTED OTHERWISE REFER TO PLUMBING DRAWINGS FOR LAVATORIES AND SINK TYPES.
- REFER TO ARCHITECTURAL AND/OR INTERIOR DRAWINGS FOR SOLID SURFACE SINK TYPES.

#### **CASEWORK NOTES**

- FIELD VERIFY ALL DIMENSIONS PRIOR TO FABRICATION OF
- CONSTRUCT GYPSUM BOARD BULKHEADS ABOVE UPPER CABINETRY TO BE 1" DEEPER AND LONGER THAN CABINETRY
- BELOW, UNLESS NOTED OTHERWISE COORDINATE ALL WALL DEVICES TO AVOID CONFLICT WITH CASEWORK AND COUNTERTOPS.
- COORDINATE SUPPORT BRACKET LOCATIONS WITH UNDER COUNTER EQUIPMENT INDICATED ELSEWHERE IN CONTRACT DOCUMENTS.
- ALL CASEWORK SHALL BE FINISHED IN PLASTIC LAMINATE, UNLESS NOTED OTHERWISE
- PROVIDE 1" MINIMUM FILLER PANELS AT ALL LOCATIONS WHERE CABINETRY ABUTS A WALL.
- PROVIDE A 4" HIGH INTEGRAL BACK SPLASH ON ALL COUNTERS WITH RECESSED SINKS. INSTALL SIDE/END SPLASHES WHERE THESE COUNTERS ABUT A WALL.
- PROVIDE ADJUSTABLE SHELVING WITHIN ALL WALL AND BASE CABINETRY AS SHOWN BY DASHED LINE.
- BOTTOM OF UPPER CABINETS TO BE FINISHED TO MATCH VERTICAL
- ALL BASE CABINETS SHALL BE 24" DEEP UNLESS NOTED OTHERWISE. PROVIDE 12" CLEAR INTERIOR DIMENSION ON ALL UPPER WALL
- CABINETS, UNLESS NOTED OTHERWISE. ALL CABINET/CASEWORK PULLS TO BE TYPE \_\_\_, UNLESS NOTED

#### **CASEWORK DESIGN SERIES TAG**

CDS DESIGNATION WIDTH 36 (302M) 24 DEPTH

EXTRA SHELF

HEIGHT

MODIFICATION DESCRIPTION

#### INTERIOR ELEVATION SYMBOLS

MATERIAL TAG, REFERENCE FINISH SCHEDULES

**EQUIPMENT SCHEDULE** 

0.F.O.I 0.F.O.I

SCOPE COMMENTS

## **IUB** RESEARCH LAB **RENOVATIONS**

BSA LifeStructures

9365 Counselors Row, Suite 300

Indianapolis, IN 46240-1478


ph 317.819.7878 fx 317.819.7288

**BL072 CHEMISTRY** 800 E KIRKWOOD AVE, BLOOMINGTON, IN 47405 BL027 SWAIN WEST 729 E 3RD ST, BLOOMINGTON, IN 47405 BL070 SIMON HALL 212 S HAWTHORNE DR, BLOOMINGTON, IN 47405

CLIENT PROJECT NO. - 20240397

**BIDDING SET** JANUARY 9, 2025

MARK	DATE	DESCRIPTION
3	01/29/25	ADDENDUM 3
2	01/27/25	ADDENDUM 2
1	01/17/25	ADDENDUM 1

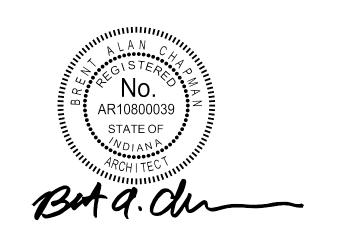

BL072 CHEMISTRY - LAB INTERIOR ELEVATIONS

BSALS PROJECT NO.

LF601



#### INTERIOR ELEVATION LEGEND

#### INTERIOR ELEVATION NOTES

- A. REFER TO FLOOR PLANS AND THE EQUIPMENT SCHEDULE FOR EQUIPMENT. COORDINATE CONNECTIONS. REFER TO MECHANICAL,
  - ELECTRICAL AND PLUMBING DRAWINGS FOR ADDITIONAL INFORMATION.
    ALL DIMENSIONS ARE TAKEN TO THE FACE OF FINISHED MATERIAL,
  - UNLESS NOTED OTHERWISE
    C. REFER TO PLUMBING DRAWINGS FOR LAVATORIES AND SINK TYPES.
    D. REFER TO ARCHITECTURAL AND/OR INTERIOR DRAWINGS FOR SOLID SURFACE SINK TYPES.

#### CASEWORK NOTES

- FIELD VERIFY ALL DIMENSIONS PRIOR TO FABRICATION OF
- 3. CONSTRUCT GYPSUM BOARD BULKHEADS ABOVE UPPER CABINETRY TO BE 1" DEEPER AND LONGER THAN CABINETRY
- BELOW, UNLESS NOTED OTHERWISE
  COORDINATE ALL WALL DEVICES TO AVOID CONFLICT WITH
  CASEWORK AND COUNTERTOPS.
- COORDINATE SUPPORT BRACKET LOCATIONS WITH UNDER COUNTER EQUIPMENT INDICATED ELSEWHERE IN CONTRACT DOCUMENTS.
- ALL CASEWORK SHALL BE FINISHED IN PLASTIC LAMINATE, UNLESS NOTED OTHERWISE
- NOTED OTHERWISE PROVIDE 1" MINIMUM FILLER PANELS AT ALL LOCATIONS WHERE
- CABINETRY ABUTS A WALL.
  PROVIDE A 4" HIGH INTEGRAL BACK SPLASH ON ALL COUNTERS WITH RECESSED SINKS. INSTALL SIDE/END SPLASHES WHERE
- THESE COUNTERS ABUT A WALL.
  PROVIDE ADJUSTABLE SHELVING WITHIN ALL WALL AND BASE CABINETRY AS SHOWN BY DASHED LINE.
- CABINETRY AS SHOWN BY DASHED LINE.
  BOTTOM OF UPPER CABINETS TO BE FINISHED TO MATCH VERTICAL

PROVIDE 12" CLEAR INTERIOR DIMENSION ON ALL UPPER WALL

- J. ALL BASE CABINETS SHALL BE 24" DEEP UNLESS NOTED OTHERWISE.
- CABINETS, UNLESS NOTED OTHERWISE.

  ALL CABINET/CASEWORK PULLS TO BE TYPE \_\_\_\_, UNLESS NOTED

#### CASEWORK DESIGN SERIES TAG

INTERIOR ELEVATION SYMBOLS

CDS DESIGNATION
WIDTH 36 (302M) 24 DEPTH
EXTRA SHELF
HEIGHT

### MODIFICATION DESCRIPTION

MATERIAL TAG, REFERENCE FINISH SCHEDULES

## IUB RESEARCH LAB RENOVATIONS

BSA LifeStructures

9365 Counselors Row, Suite 300

Indianapolis, IN 46240-1478

ph 317.819.7878 fx 317.819.7288

BL072 CHEMISTRY

800 E KIRKWOOD AVE, BLOOMINGTON, IN 47405

BL027 SWAIN WEST

729 E 3RD ST, BLOOMINGTON, IN 47405

BL070 SIMON HALL

212 S HAWTHORNE DR, BLOOMINGTON, IN 47405

EQUIPMENT SCHEDULE

CLIENT PROJECT NO. - 20240397


# NAME SCOPE COMMENTS

600 LOCAL VACUUM NETWORK PUMP C.F.C.I
900 GENERIC EQUIPMENT O.F.O.I
930 30" x 32" RH O.F.O.I
950 MARKERBOARD 48X72 O.F.O.I

BIDDING SET

JANUARY 9, 2025

MARK	DATE	DESCRIPTION
3	01/29/25	ADDENDUM 3
1	01/17/25	ADDENDUM 1

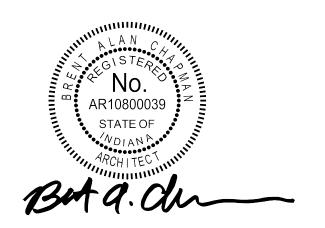


BL072 CHEMISTRY - LAB INTERIOR ELEVATIONS

DATE
BSALS PROJECT NO.

LF602

© BSA LifeStructur




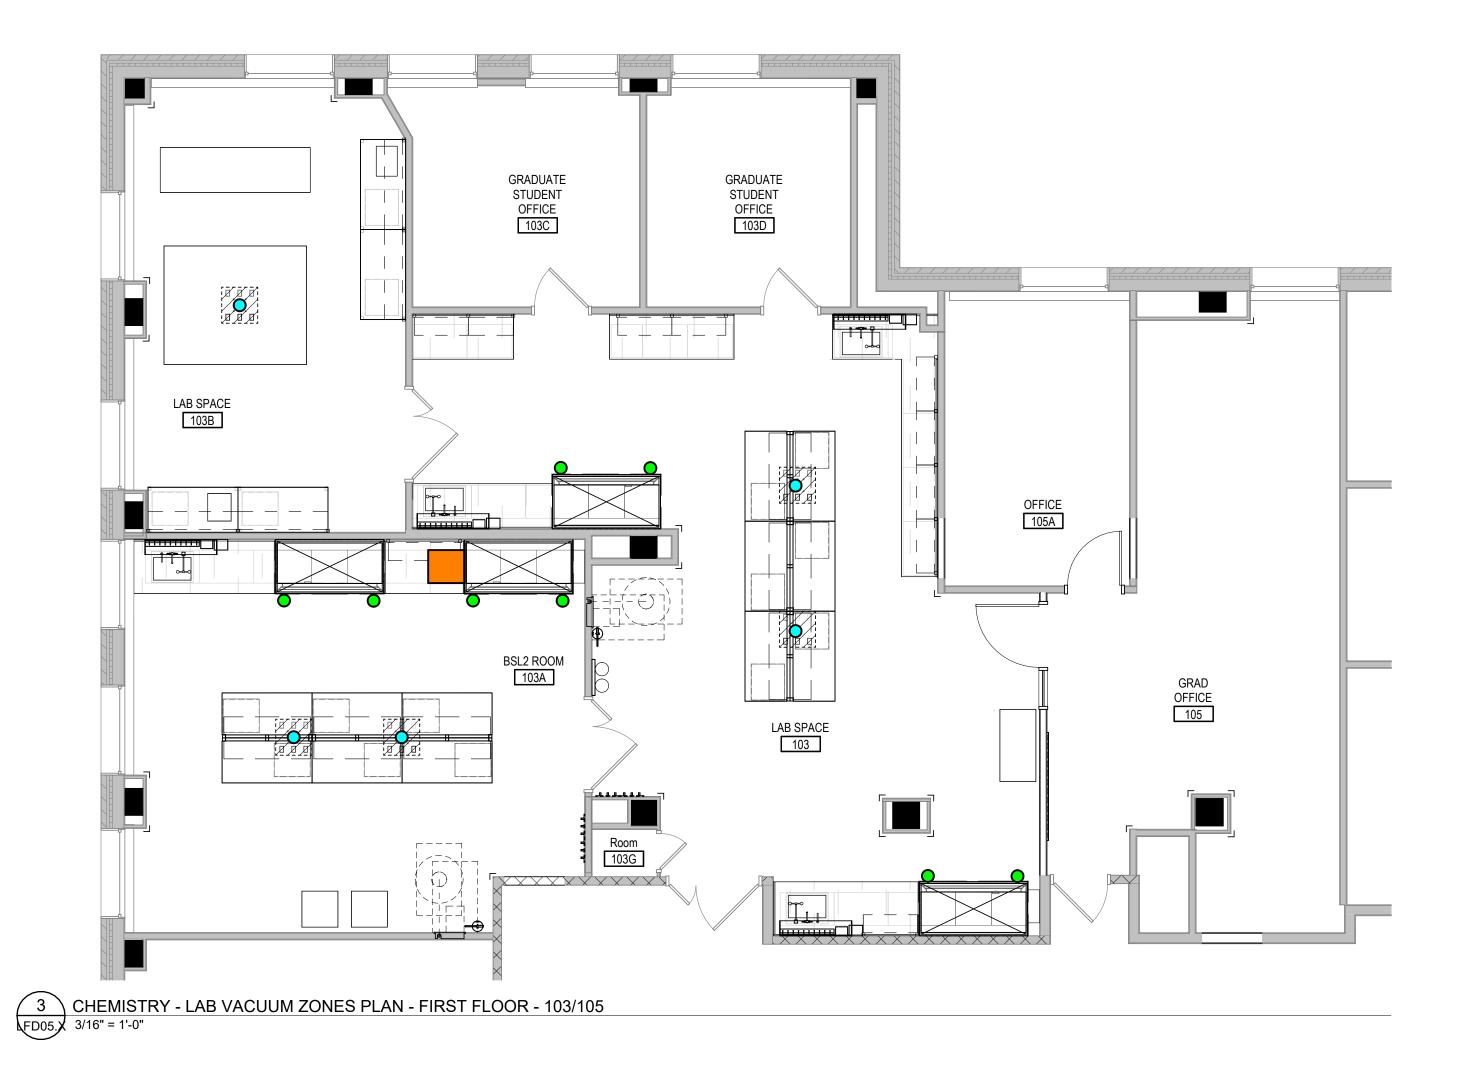



VACUUM FIXTURE ON FUME HOOD

VACUUM FIXTURE ON CEILING SERVICE PANEL

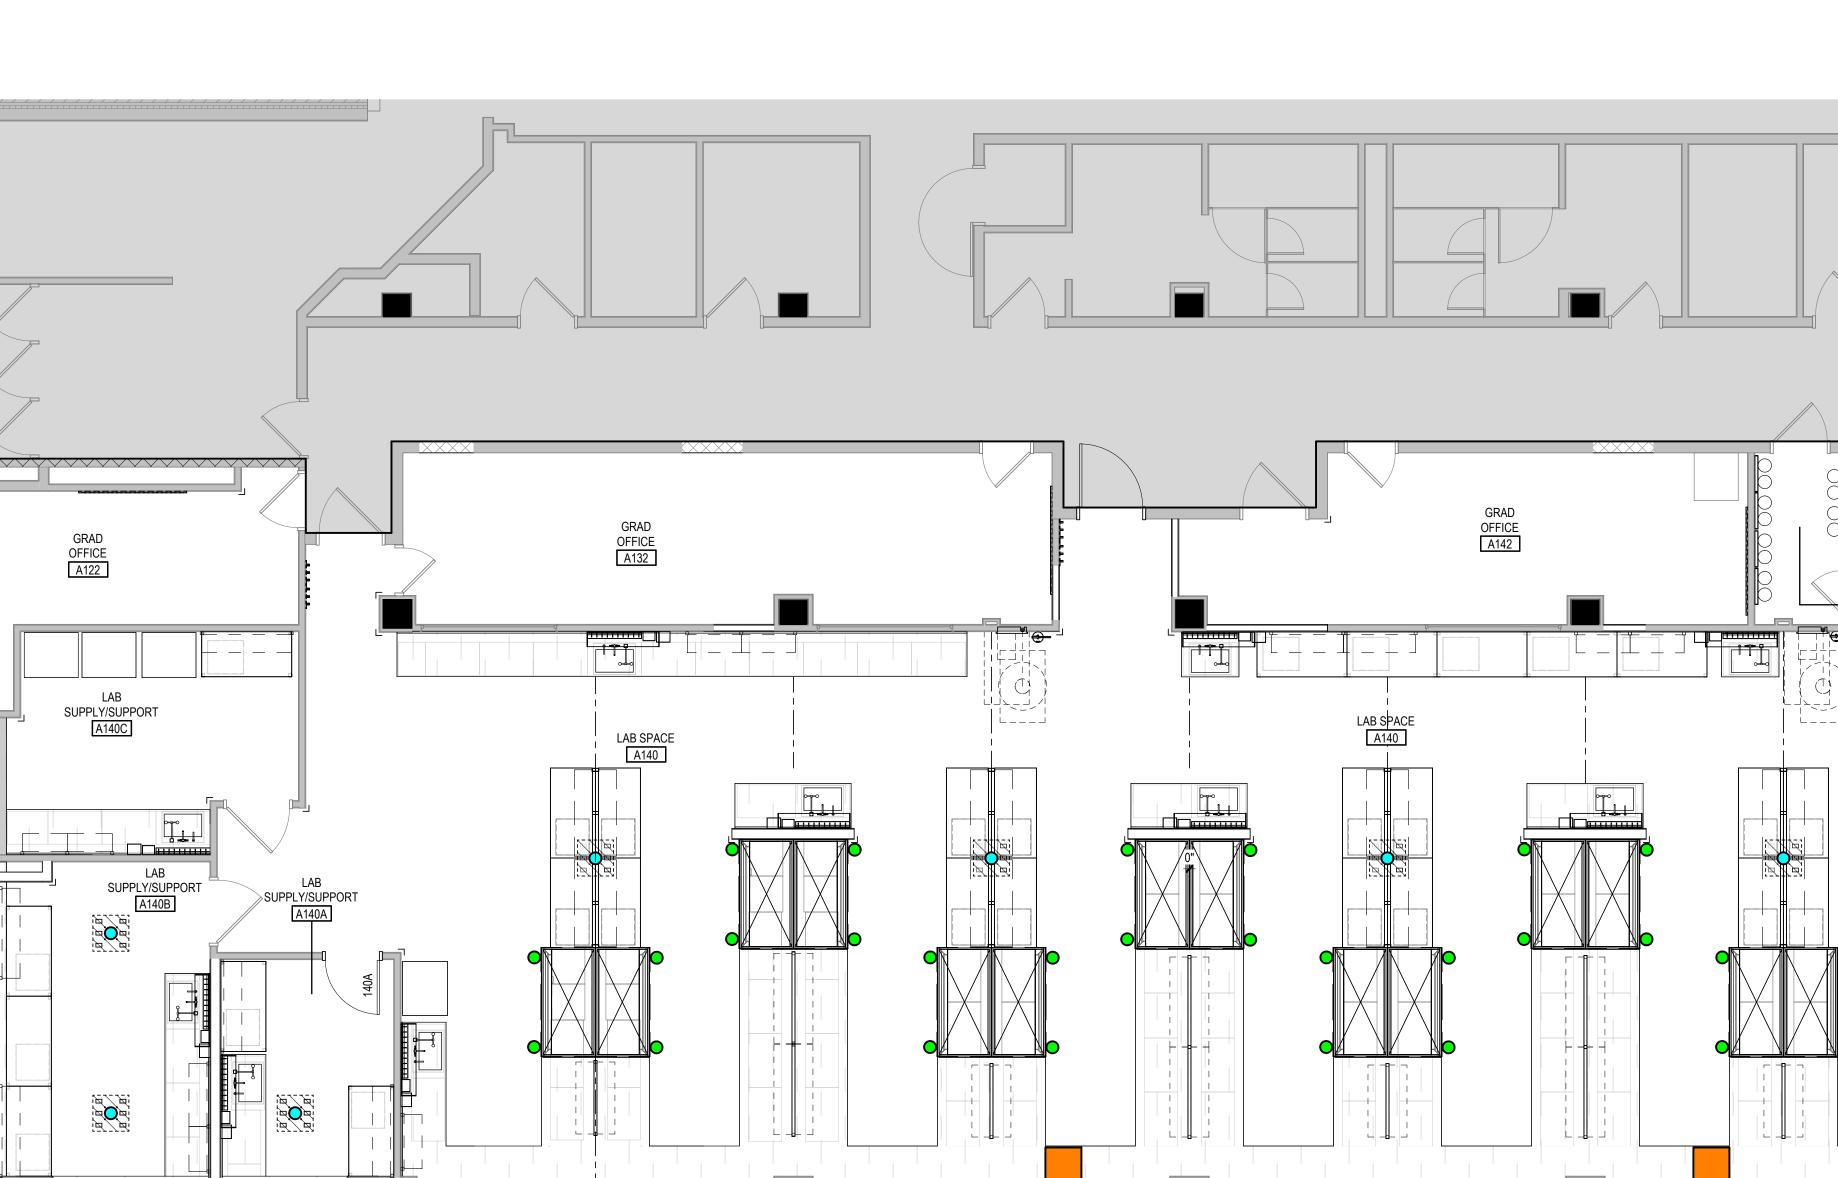



## IUB RESEARCH LAB RENOVATIONS

BL072 CHEMISTRY
800 E KIRKWOOD AVE, BLOOMINGTON, IN 47405
BL027 SWAIN WEST
729 E 3RD ST, BLOOMINGTON, IN 47405
BL070 SIMON HALL
212 S HAWTHORNE DR, BLOOMINGTON, IN 47405

CLIENT PROJECT NO. - 20240397

BIDDING SET JANUARY 9, 2025

 MARK
 DATE
 DESCRIPTION


 3
 01/29/25
 ADDENDUM 3

 2
 01/27/25
 ADDENDUM 2

 1
 01/17/25
 ADDENDUM 1



LAB VACUUM ZONES PLAN

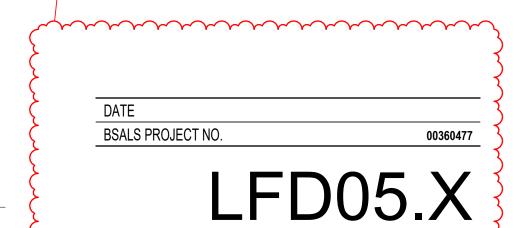


/29/2025 10:30:37 AM uitodesk Dore://00360477 - IIIR Research I ah Renovation

2 CHEMISTRY - LAB VACUUM ZONES PLAN - SECOND FLOOR - A251/A252 FD05.X 3/16" = 1'-0"

GRAD OFFICE A251

1 CHEMISTRY - LAB VACUUM ZONES PLAN - FIRST FLOOR - A140/A150 3/16" = 1'-0"

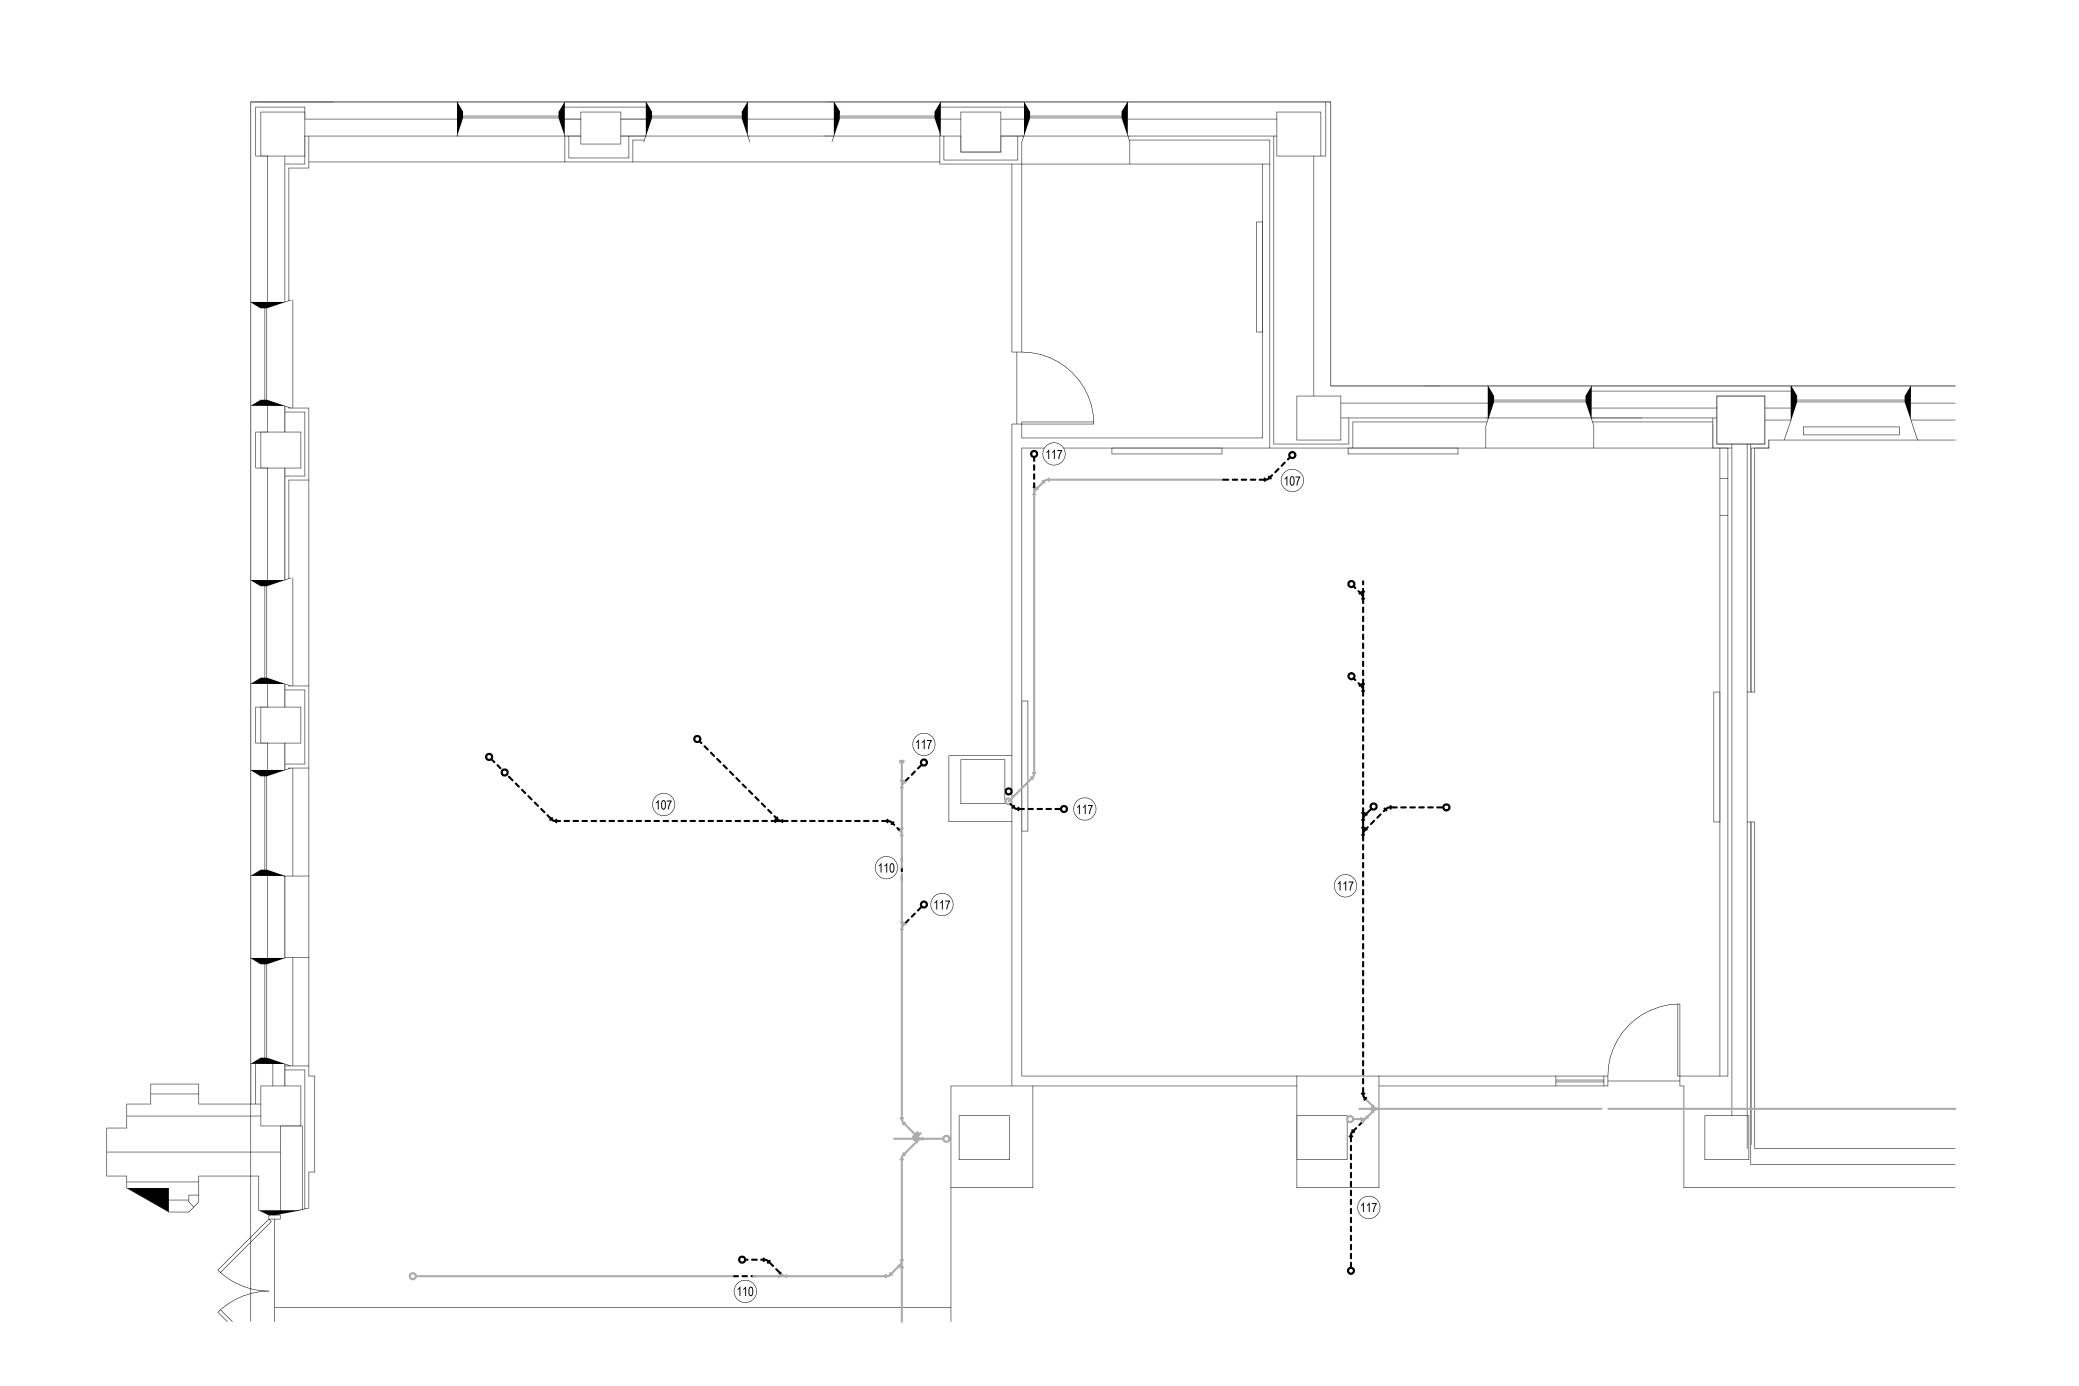

**PLAN NOTES** 

100 REMOVE EXISTING FLOOR DRAIN AND ALL ASSOCIATED SANITARY PIPING BACK TO MAIN AND CAP. PATCH INFILL TO MATCH EXISTING CONCRETE. 101 REMOVE EXISTING SINK AND ALL ASSOCIATED TRIM BACK TO MAIN. PREPARE PIPE FOR

NEW CONNECTION. 102 REMOVE EXISTING LAB GAS PIPING BACK TO MANIFOLD AND ALL ASSOCIATED TRIM ON BRAKET. REMOVE EXISTING COLD WATER PIPING BACK TO MAIN AND CAP.

103 REMOVE EXISTING LAB GAS BOX CONNECTION AND ALL ASSOCIATED PIPING BACK TO MAIN AND CAP.

104 REMOVE EXISTING LAB GAS MANIFOLD AND ALL ASSOCIATED PIPING TO EXISTING GAS BRACKETS AND TRIM.

107 REMOVE EXISTING SPECIAL WASTE PIPE AND FITTINGS AND PREPARE EXISTING PIPE FOR

FUTURE CONNECTION. 110 REMOVE SEGMENT OF PIPE AND PREPARE PIPE FOR FUTURE CONNECTION. 113 REMOVE EXISTING SPECIAL WASTE ABOVE/BELOW FLOOR, LAB GASSES, WATER AND VENT PIPING FROM FUME HOOD BACK TO MAIN AND CAP.

117 REMOVE EXISTING SPECIAL WASTE PIPE BACK TO MAIN AND CAP. 119 REMOVE EXISTING SPECIAL WASTE PIPING, FITTINGS, AND HANGERS COMPLETE.

BSA LifeStructures 9365 Counselors Row, Suite 300 Indianapolis, IN 46240-1478 ph 317.819.7878 fx 317.819.7288

## **IUB** RESEARCH LAB **RENOVATIONS**

BL072 CHEMISTRY 800 E KIRKWOOD AVE, BLOOMINGTON, IN 47405 BL027 SWAIN WEST 729 E 3RD ST, BLOOMINGTON, IN 47405 BL070 SIMON HALL 212 S HAWTHORNE DR, BLOOMINGTON, IN 47405

CLIENT PROJECT NO. - 20240397

**BIDDING SET** JANUARY 9, 2025

DESCRIPTION 3 01/29/25 ADDENDUM 3
2 01/27/25 ADDENDUM 2
1 01/17/25 ADDENDUM 1



BL072 CHEMISTRY -PLUMBING DEMOLITION **PLANS** 


DATE
BSALS PROJECT NO.

P100

JAN 1, 201?

2 PLUMBING DEMOLITION PLAN - A140 AREA
3/16" = 1'-0"

1 PLUMBING DEMOLITION PLAN - LEVEL OG

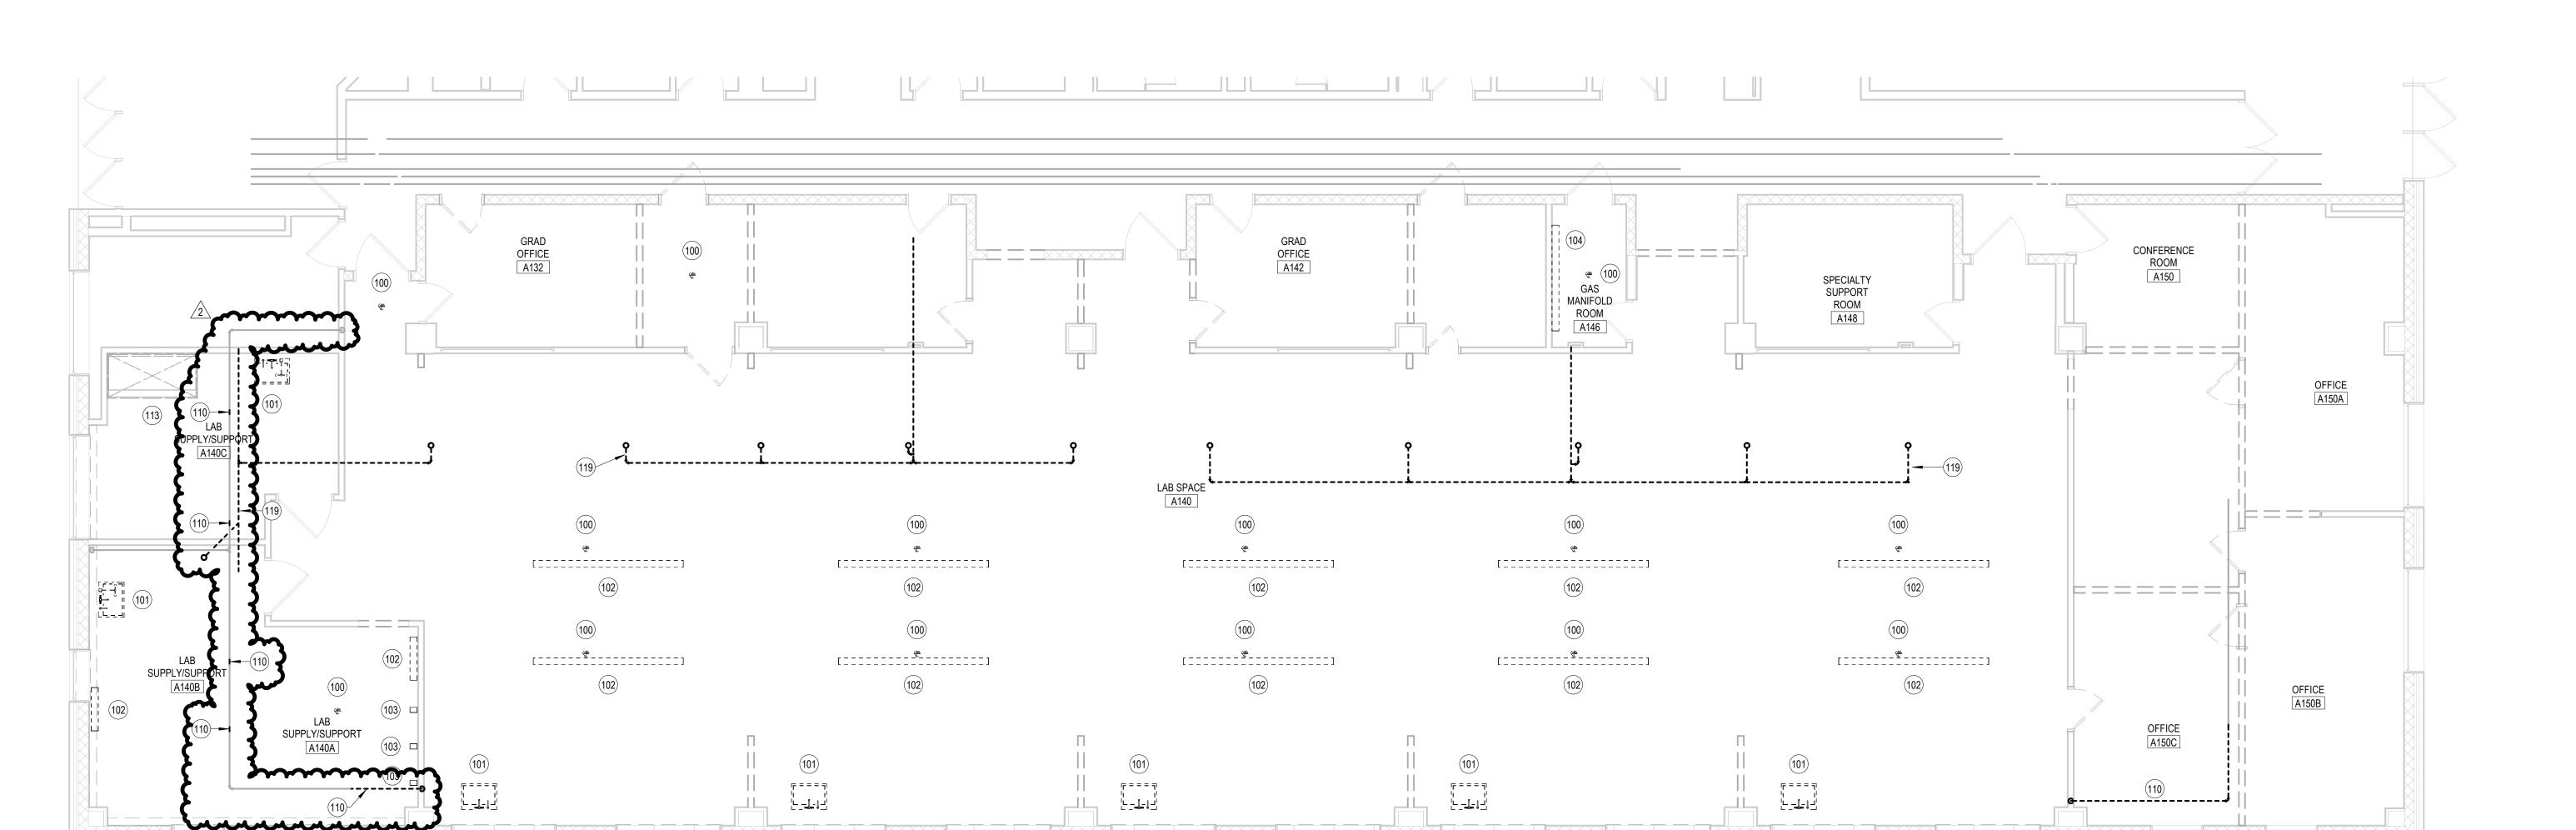

107 REMOVE EXISTING SPECIAL WASTE PIPE AND FITTINGS AND PREPARE EXISTING PIPE FO 108 REMOVE EXISTING LAB AIR, COLD WATER AND NITROGEN BACK TO MAIN AND CAP.


109 REMOVE COLD WATER AND LAB AIR PIPING BACK TO MAIN AND CAP. 110 REMOVE SEGMENT OF PIPE AND PREPARE PIPE FOR FUTURE CONNECTION.

111 REMOVE ALL COLD WATER, HOT WATER, LAB AIR AND NITROGEN BACK TO MAIN VALVES AND PREPARE PIPE FOR FUTURE CONNECTION. 112 REMOVE ALL EXISTING SPECIAL WASTE AND VENT ALONG WITH ALL ASSOCIATED TRIM


BACK TO MAIN AND PREPARE PIPE FOR NEW CONNECTION. 113 REMOVE EXISTING SPECIAL WASTE ABOVE/BELOW FLOOR, LAB GASSES, WATER AND VENT PIPING FROM FUME HOOD BACK TO MAIN AND CAP.


114 REMOVE EXISTING SPECIAL WASTE ABOVE/BELOW FLOOR, VENT, LAB GASSES AND WATER PIPING FROM FUME HOOD BACK TO MAIN AND CAP.


190 REMOVE EXISTING OPERIAL WASTE DIRING, EITTINGS, AND HANGERS ROMBLETE

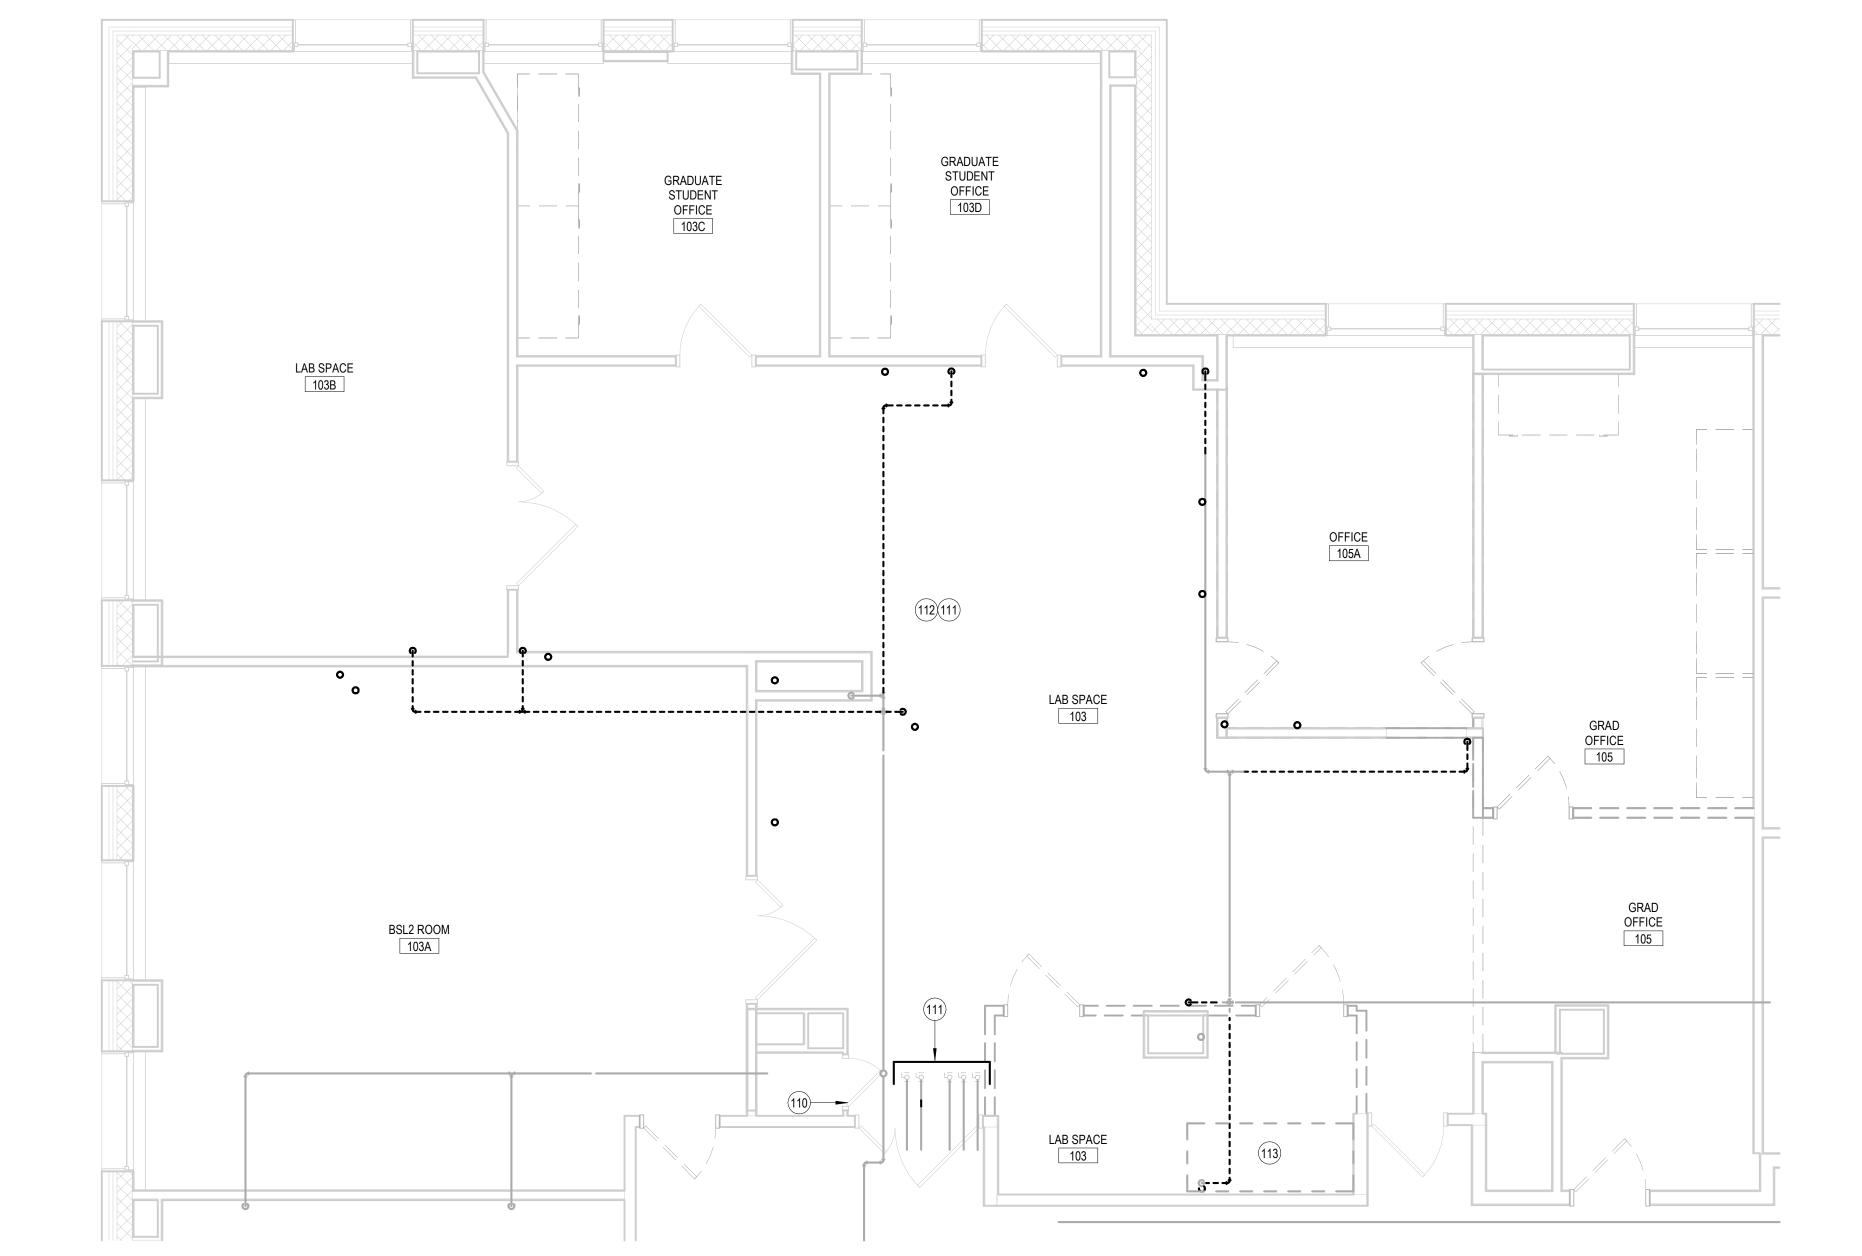

3 PLUMBING DEMOLITION PLAN - 103/105 AREA
1/4" = 1'-0"

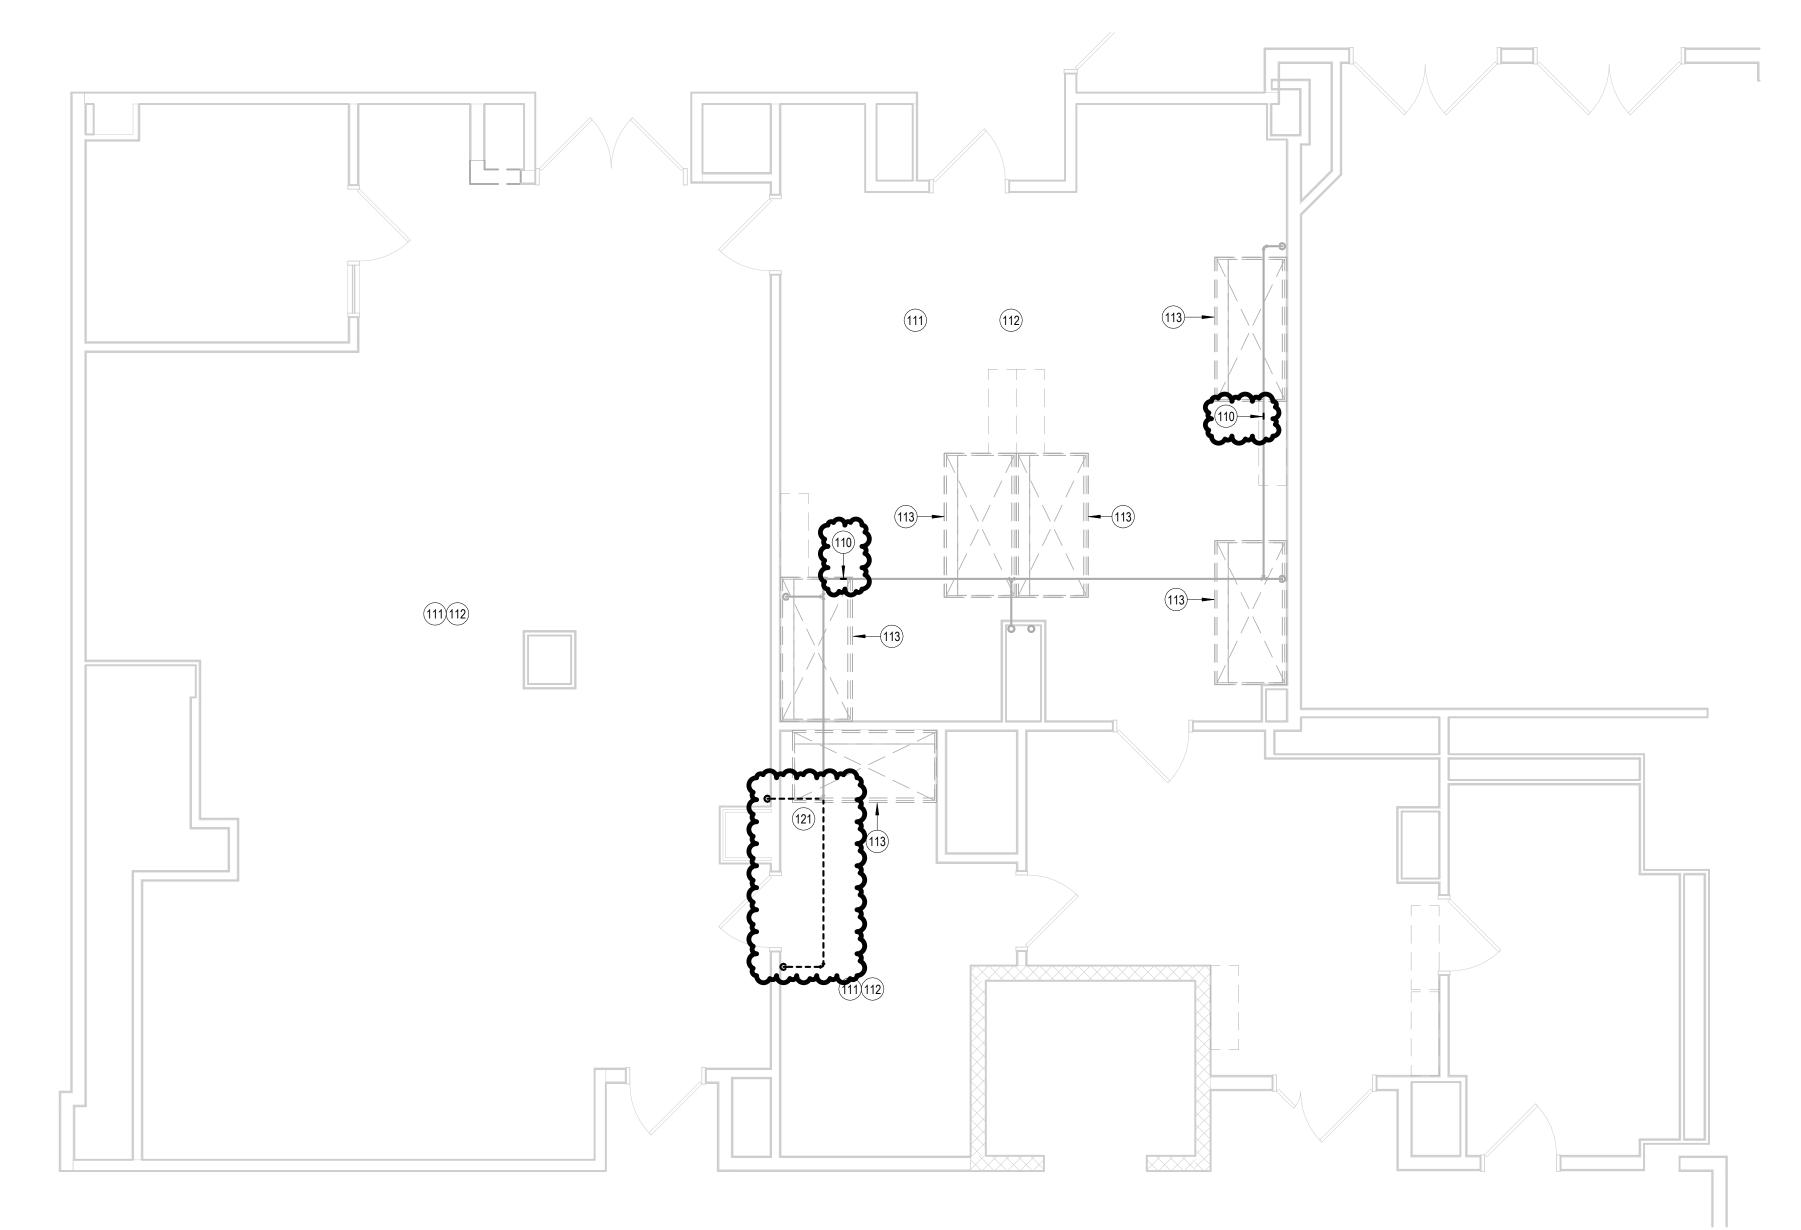

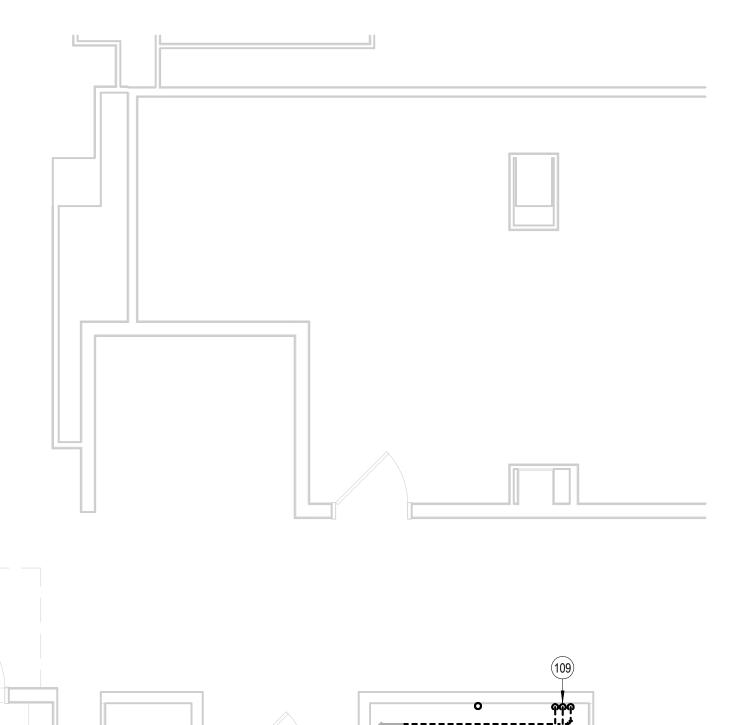

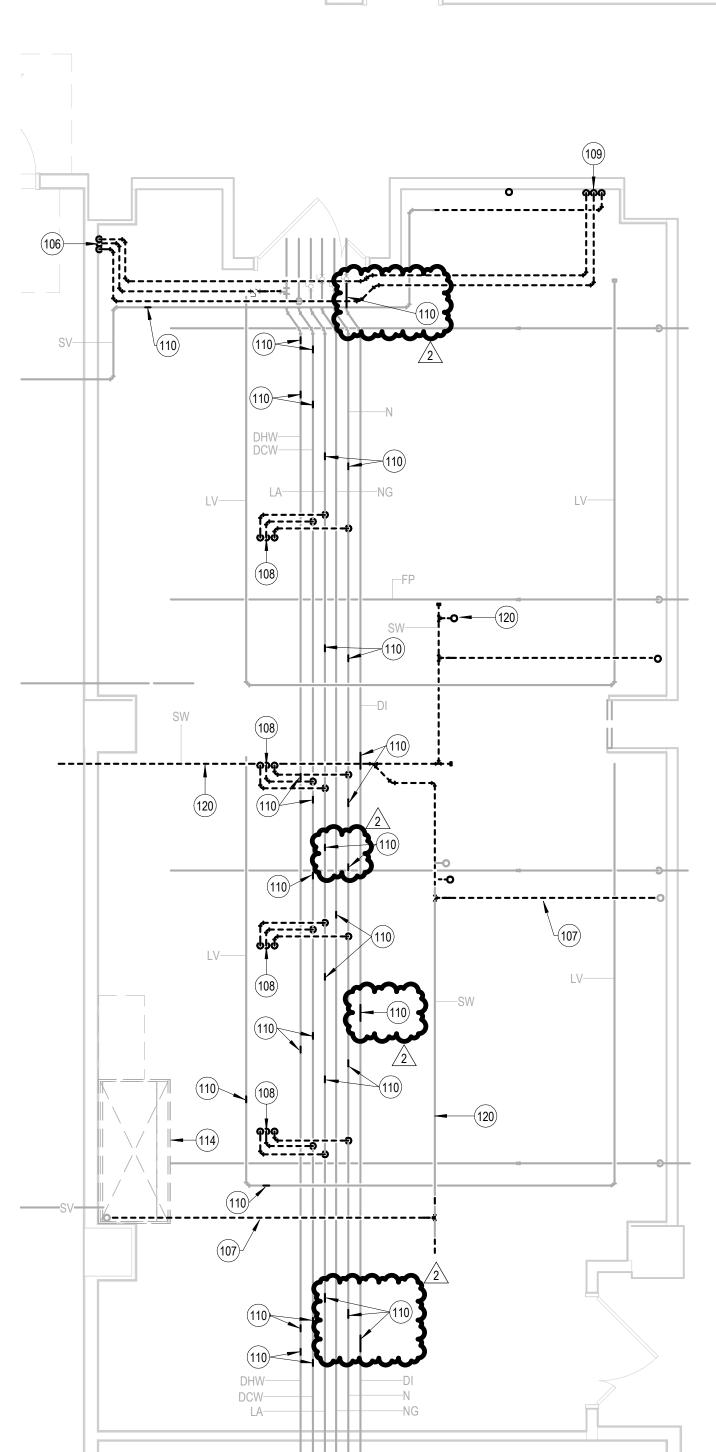

2 PLUMBING DEMOLITION PLAN - A251 / A252 AREA
1/4" = 1'-0"



BSA LifeStructures

9365 Counselors Row, Suite 300

Indianapolis, IN 46240-1478 ph 317.819.7878 fx 317.819.7288

BL072 CHEMISTRY 800 E KIRKWOOD AVE, BLOOMINGTON, IN 47405 BL027 SWAIN WEST 729 E 3RD ST, BLOOMINGTON, IN 47405 BL070 SIMON HALL 212 S HAWTHORNE DR, BLOOMINGTON, IN 47405

CLIENT PROJECT NO. - 20240397

**BIDDING SET** JANUARY 9, 2025

DESCRIPTION 3 01/29/25 ADDENDUM 3
2 01/27/25 ADDENDUM 2
1 01/17/25 ADDENDUM 1




BL072 CHEMISTRY -PLUMBING DEMOLITION **PLANS** 


DATE
BSALS PROJECT NO.

JAN 1, 201?

P101

1 PLUMBING DEMOLITION PLAN - 102/104 AREA 1/4" = 1'-0"

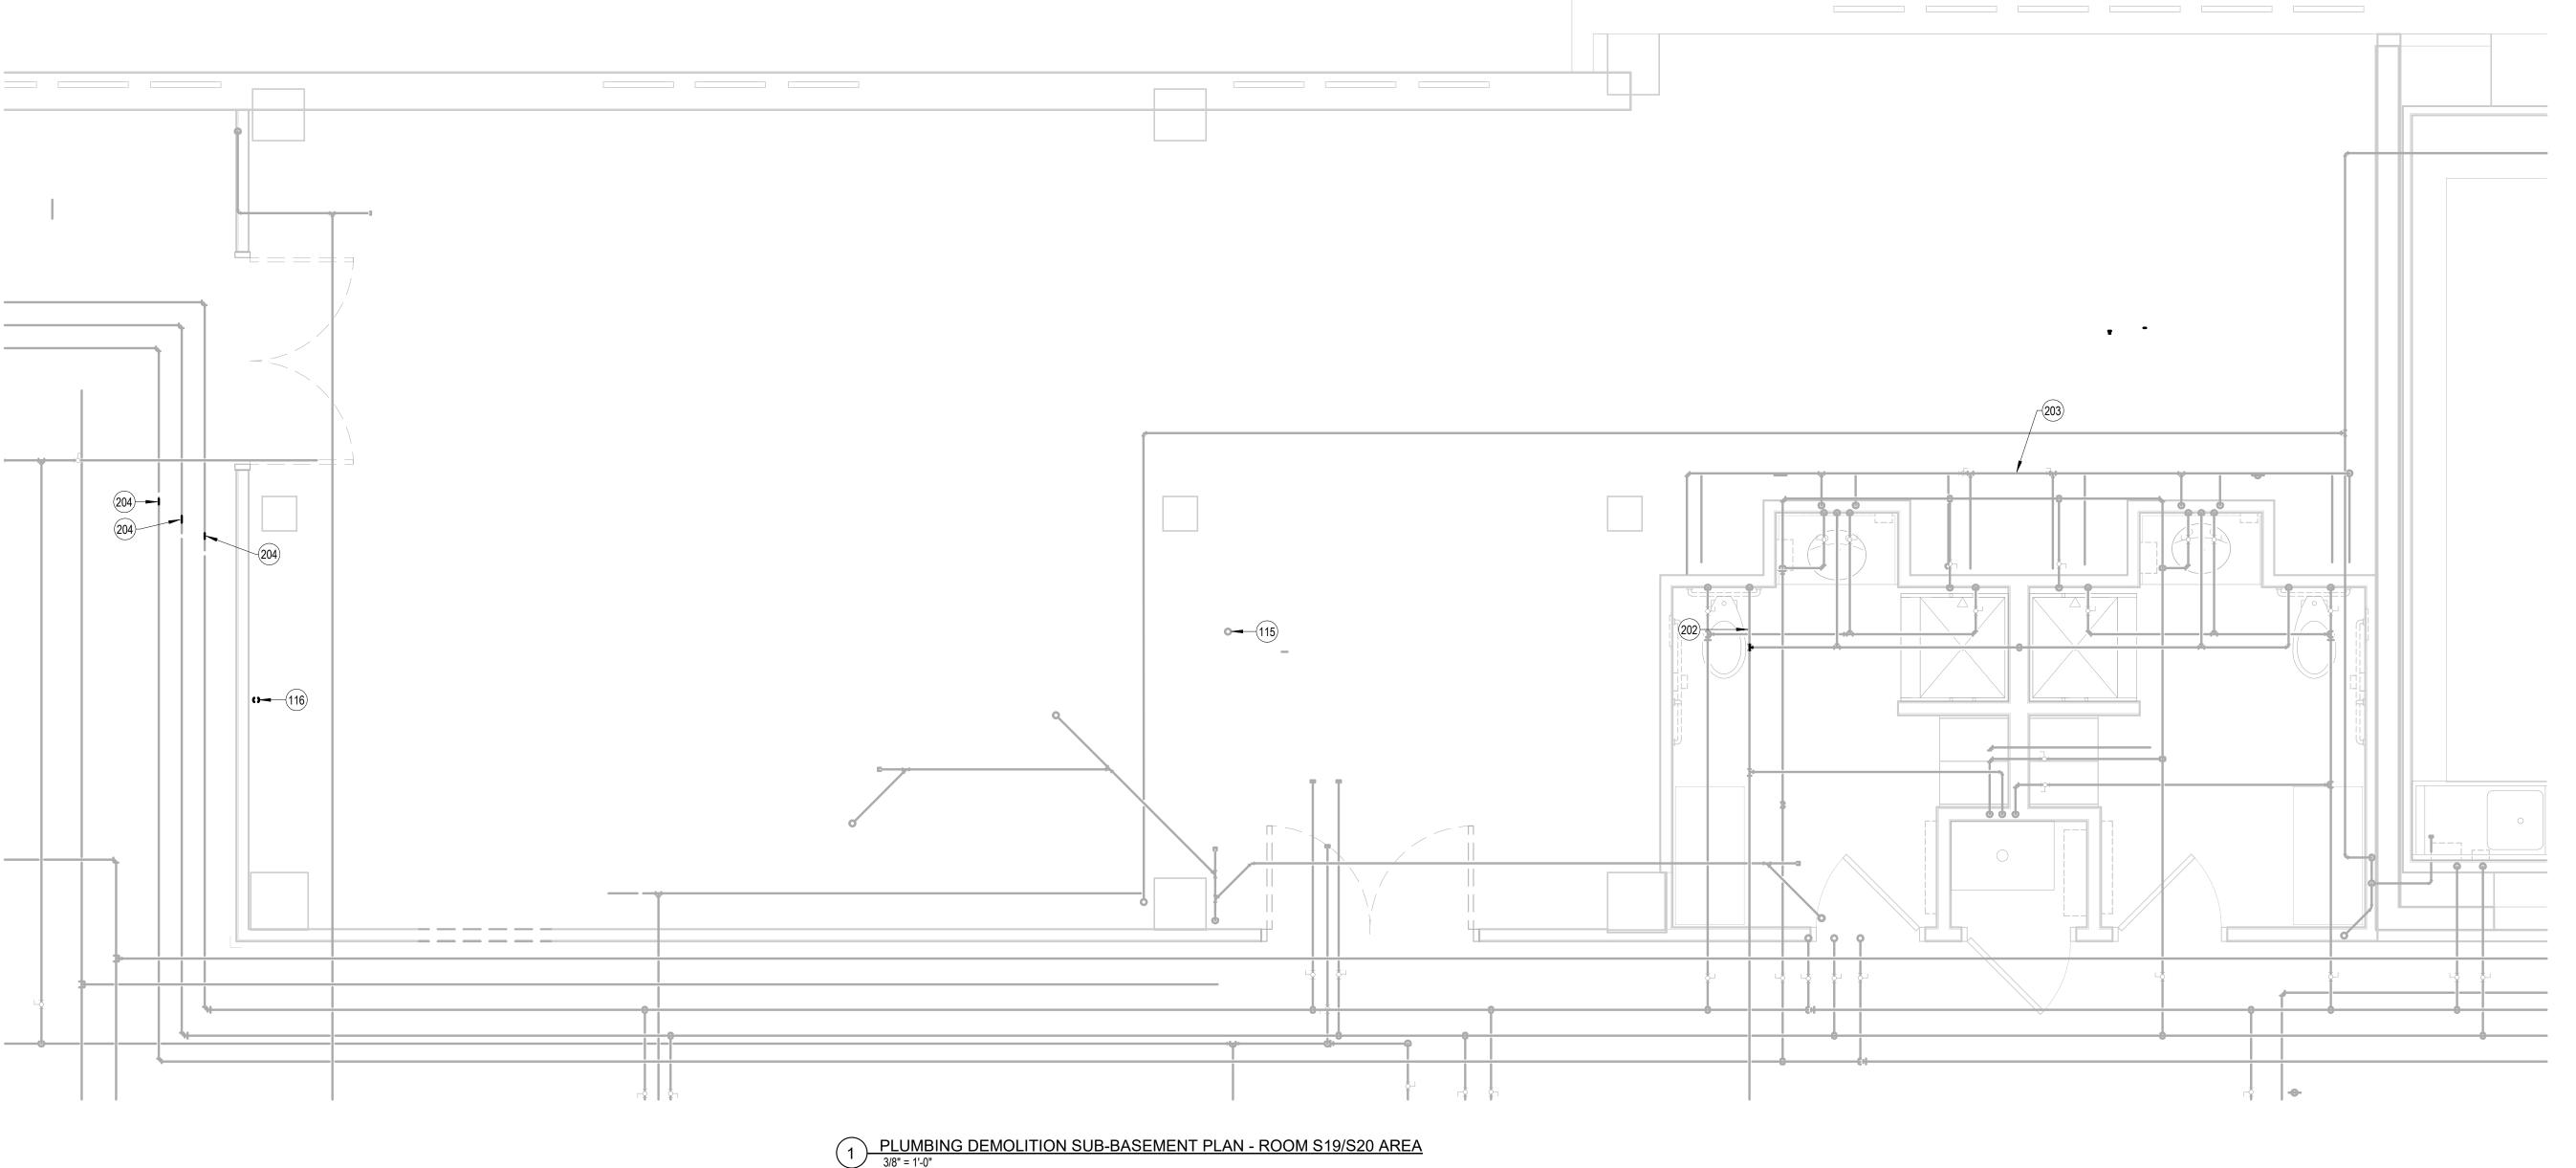

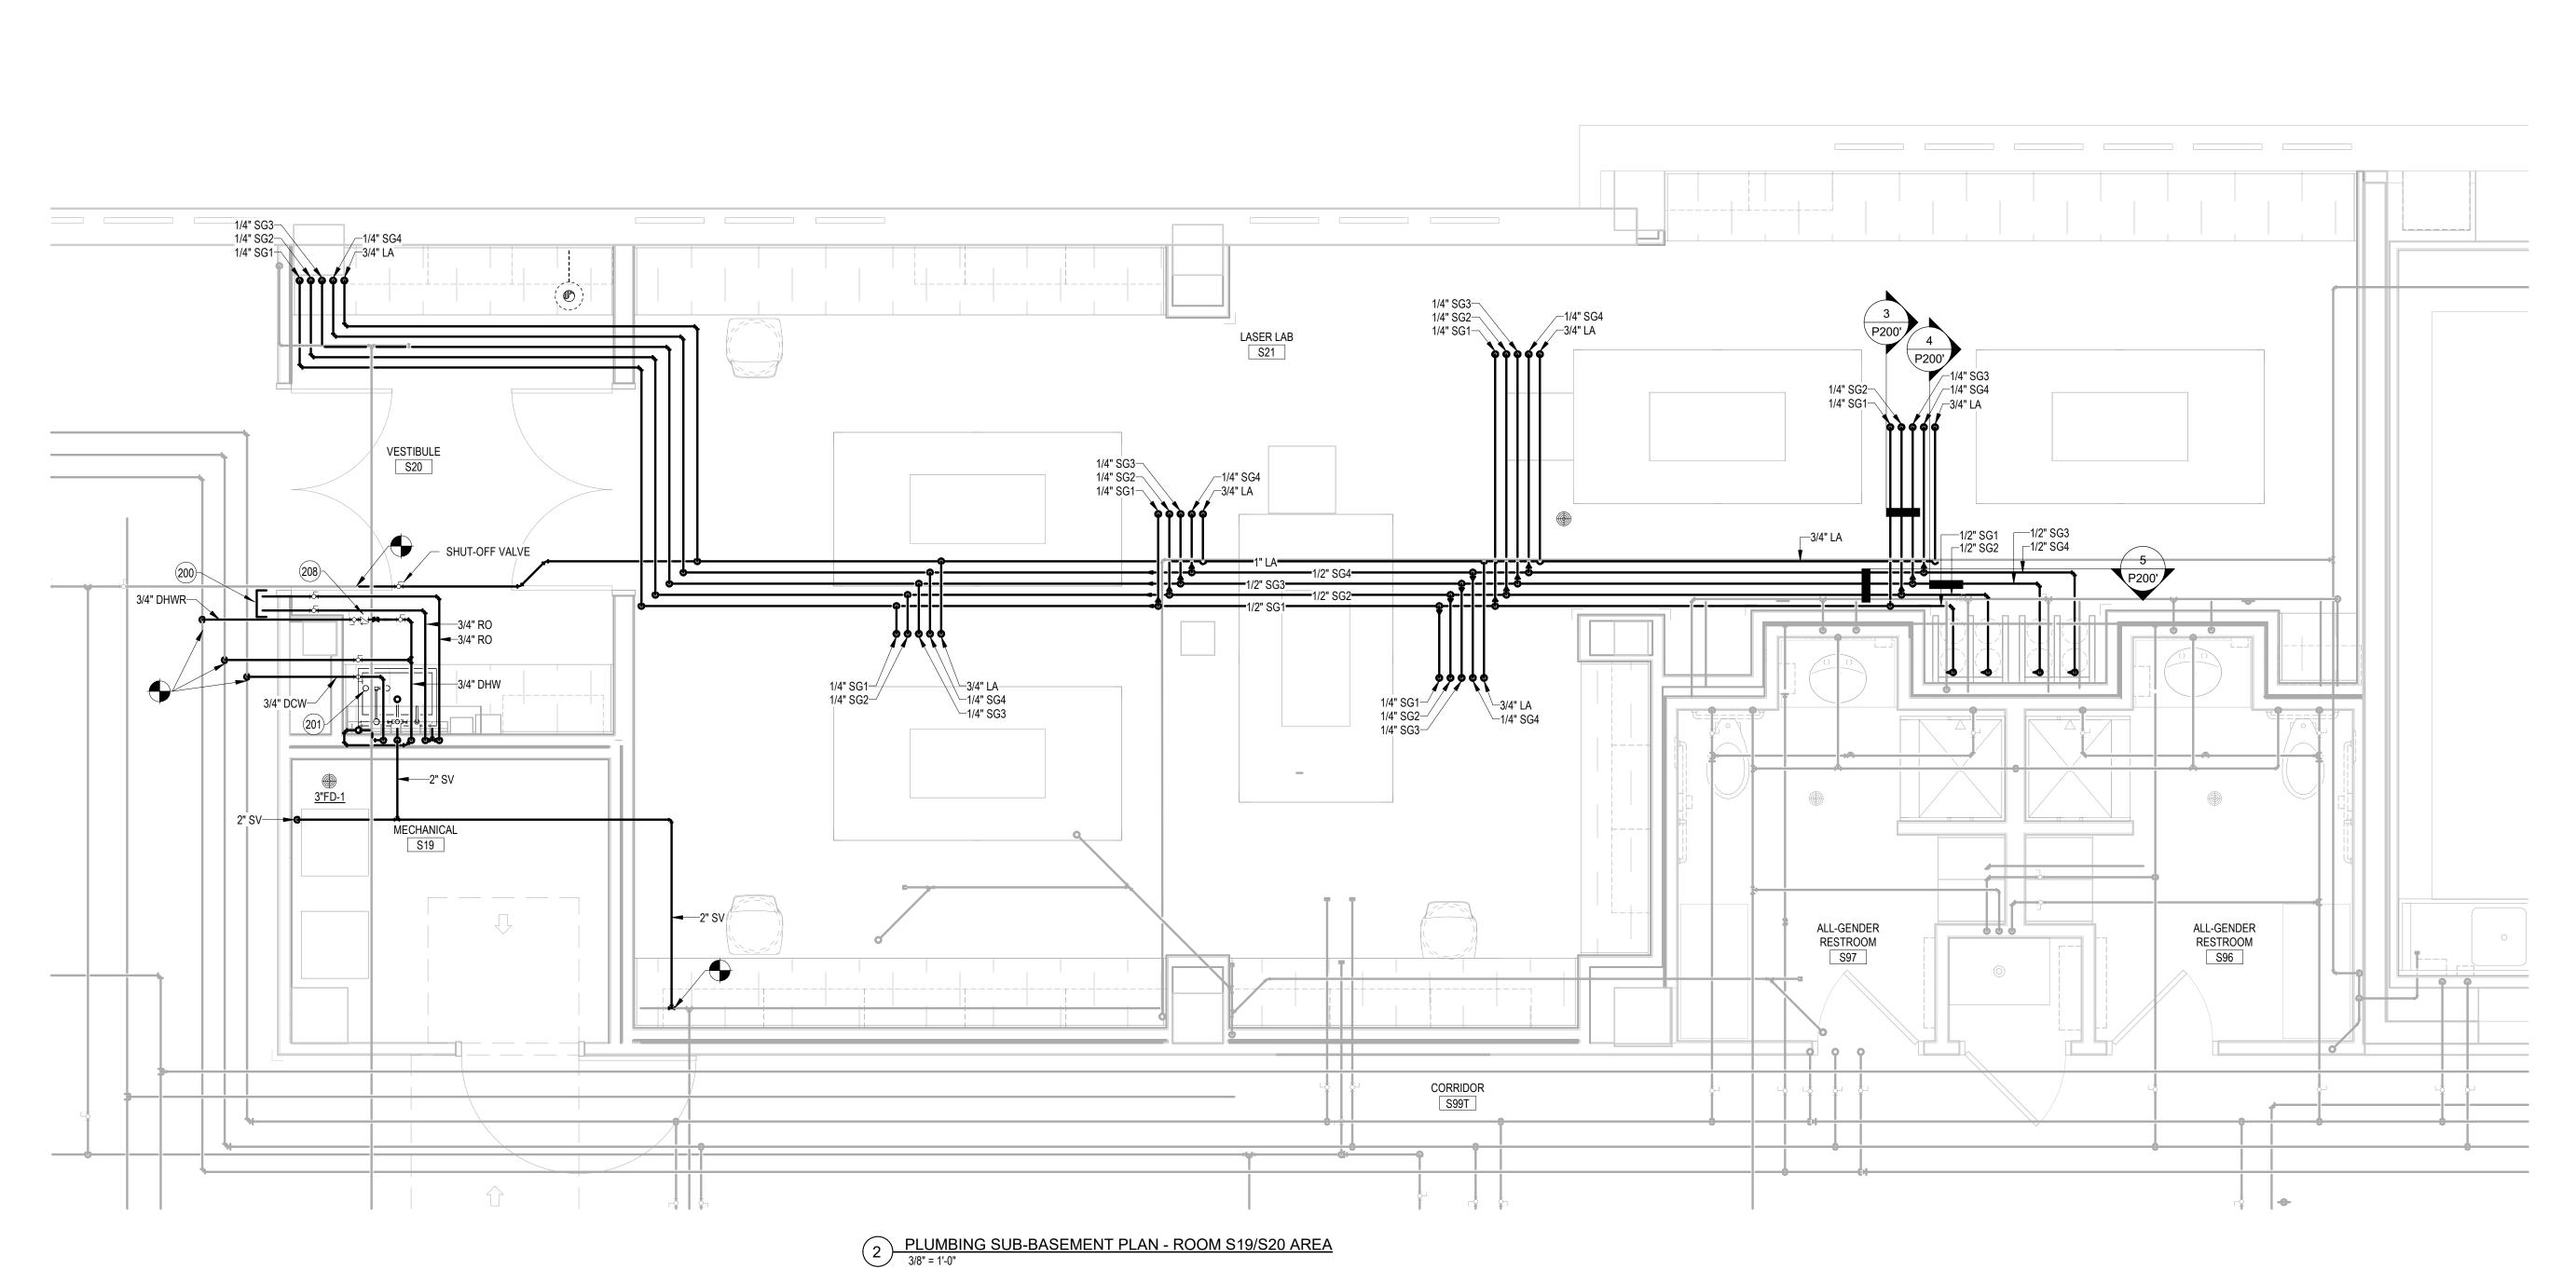



208 PROVIDE CIRCUT SETTER ASSEMBLY AND SET AT 1.0 GPM.

115 REMOVE EXISTING STUB UP BELOW SLAB AND CAP. PATCH CONCRETE TO MATCH EXISTING CONCRETE.


116 REMOVE EXISTING STUB UP BELOW FLOOR AND PREPARE PIPE FOR FUTURE CONNECTION. PATCH CONCRETE TO MATCH EXISTING CONCRETE.

200 CONNECT NEW 3/4" RO WATER LOOP TO EXISTING RO SYSTEM. 201 PROVIDE NEW THERMO MIXING VALVE UNDER SINK TO EMERGENCY EYE WASH. SET THEMO MIXING VALVE AT 72 DEGREE AT 3 GPM.

202 REMOVE EXISTING VENT TEE AND PREPARE PIPE FOR FUTURE CONNECTION. 203 RAISE EXISTING HOT/COLD WATER PIPING AS NEEDED TO AVOID NEW CEILING.


204 REMOVE SECTION OF EXISTING PIPING AND PREPARE PIPE FOR FUTURE CONNECTION.



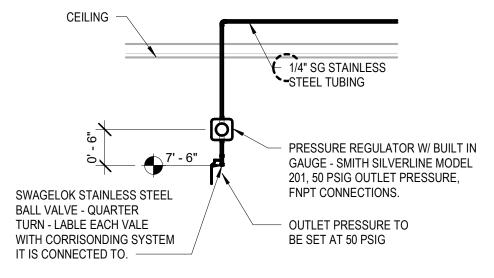

## 3 TYPICAL SG PIPE SECTION - TWENTY-FOUR LOCATIONS 3/4" = 1'-0"

## **IUB** RESEARCH LAB **RENOVATIONS**

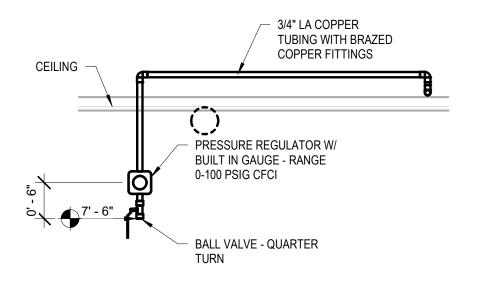

**BL072 CHEMISTRY** 800 E KIRKWOOD AVE, BLOOMINGTON, IN 47405 BL027 SWAIN WEST 729 E 3RD ST, BLOOMINGTON, IN 47405 BL070 SIMON HALL 212 S HAWTHORNE DR, BLOOMINGTON, IN 47405


CLIENT PROJECT NO. - 20240397

## 4 LA CEILING SECTION - TYPICAL SIX LOCATIONS 3/4" = 1'-0"


**BIDDING SET** JANUARY 9, 2025

DATE

DESCRIPTION

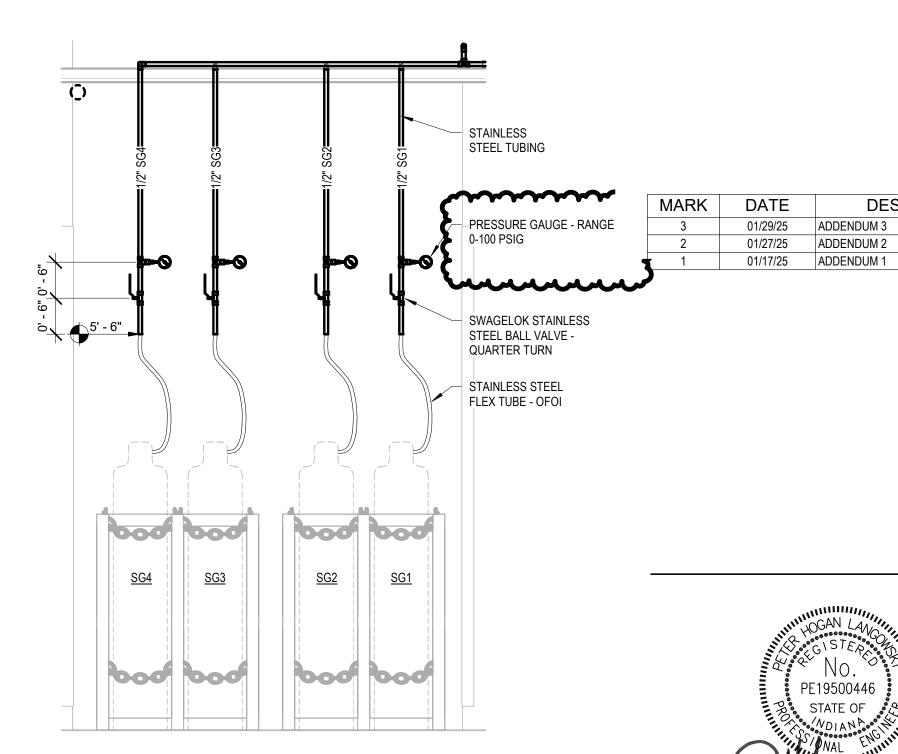


5 SG TANKS CONNECTIONS
3/4" = 1'-0"

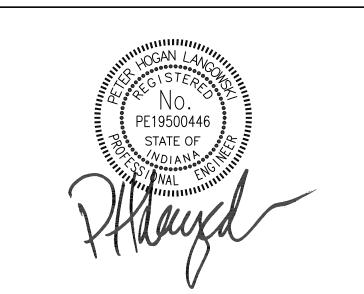

BL027 SWAIN -SUB-BASEMENT PLANS SW S19-S21 AREA

DATE BSALS PROJECT NO. NOV 27,2024

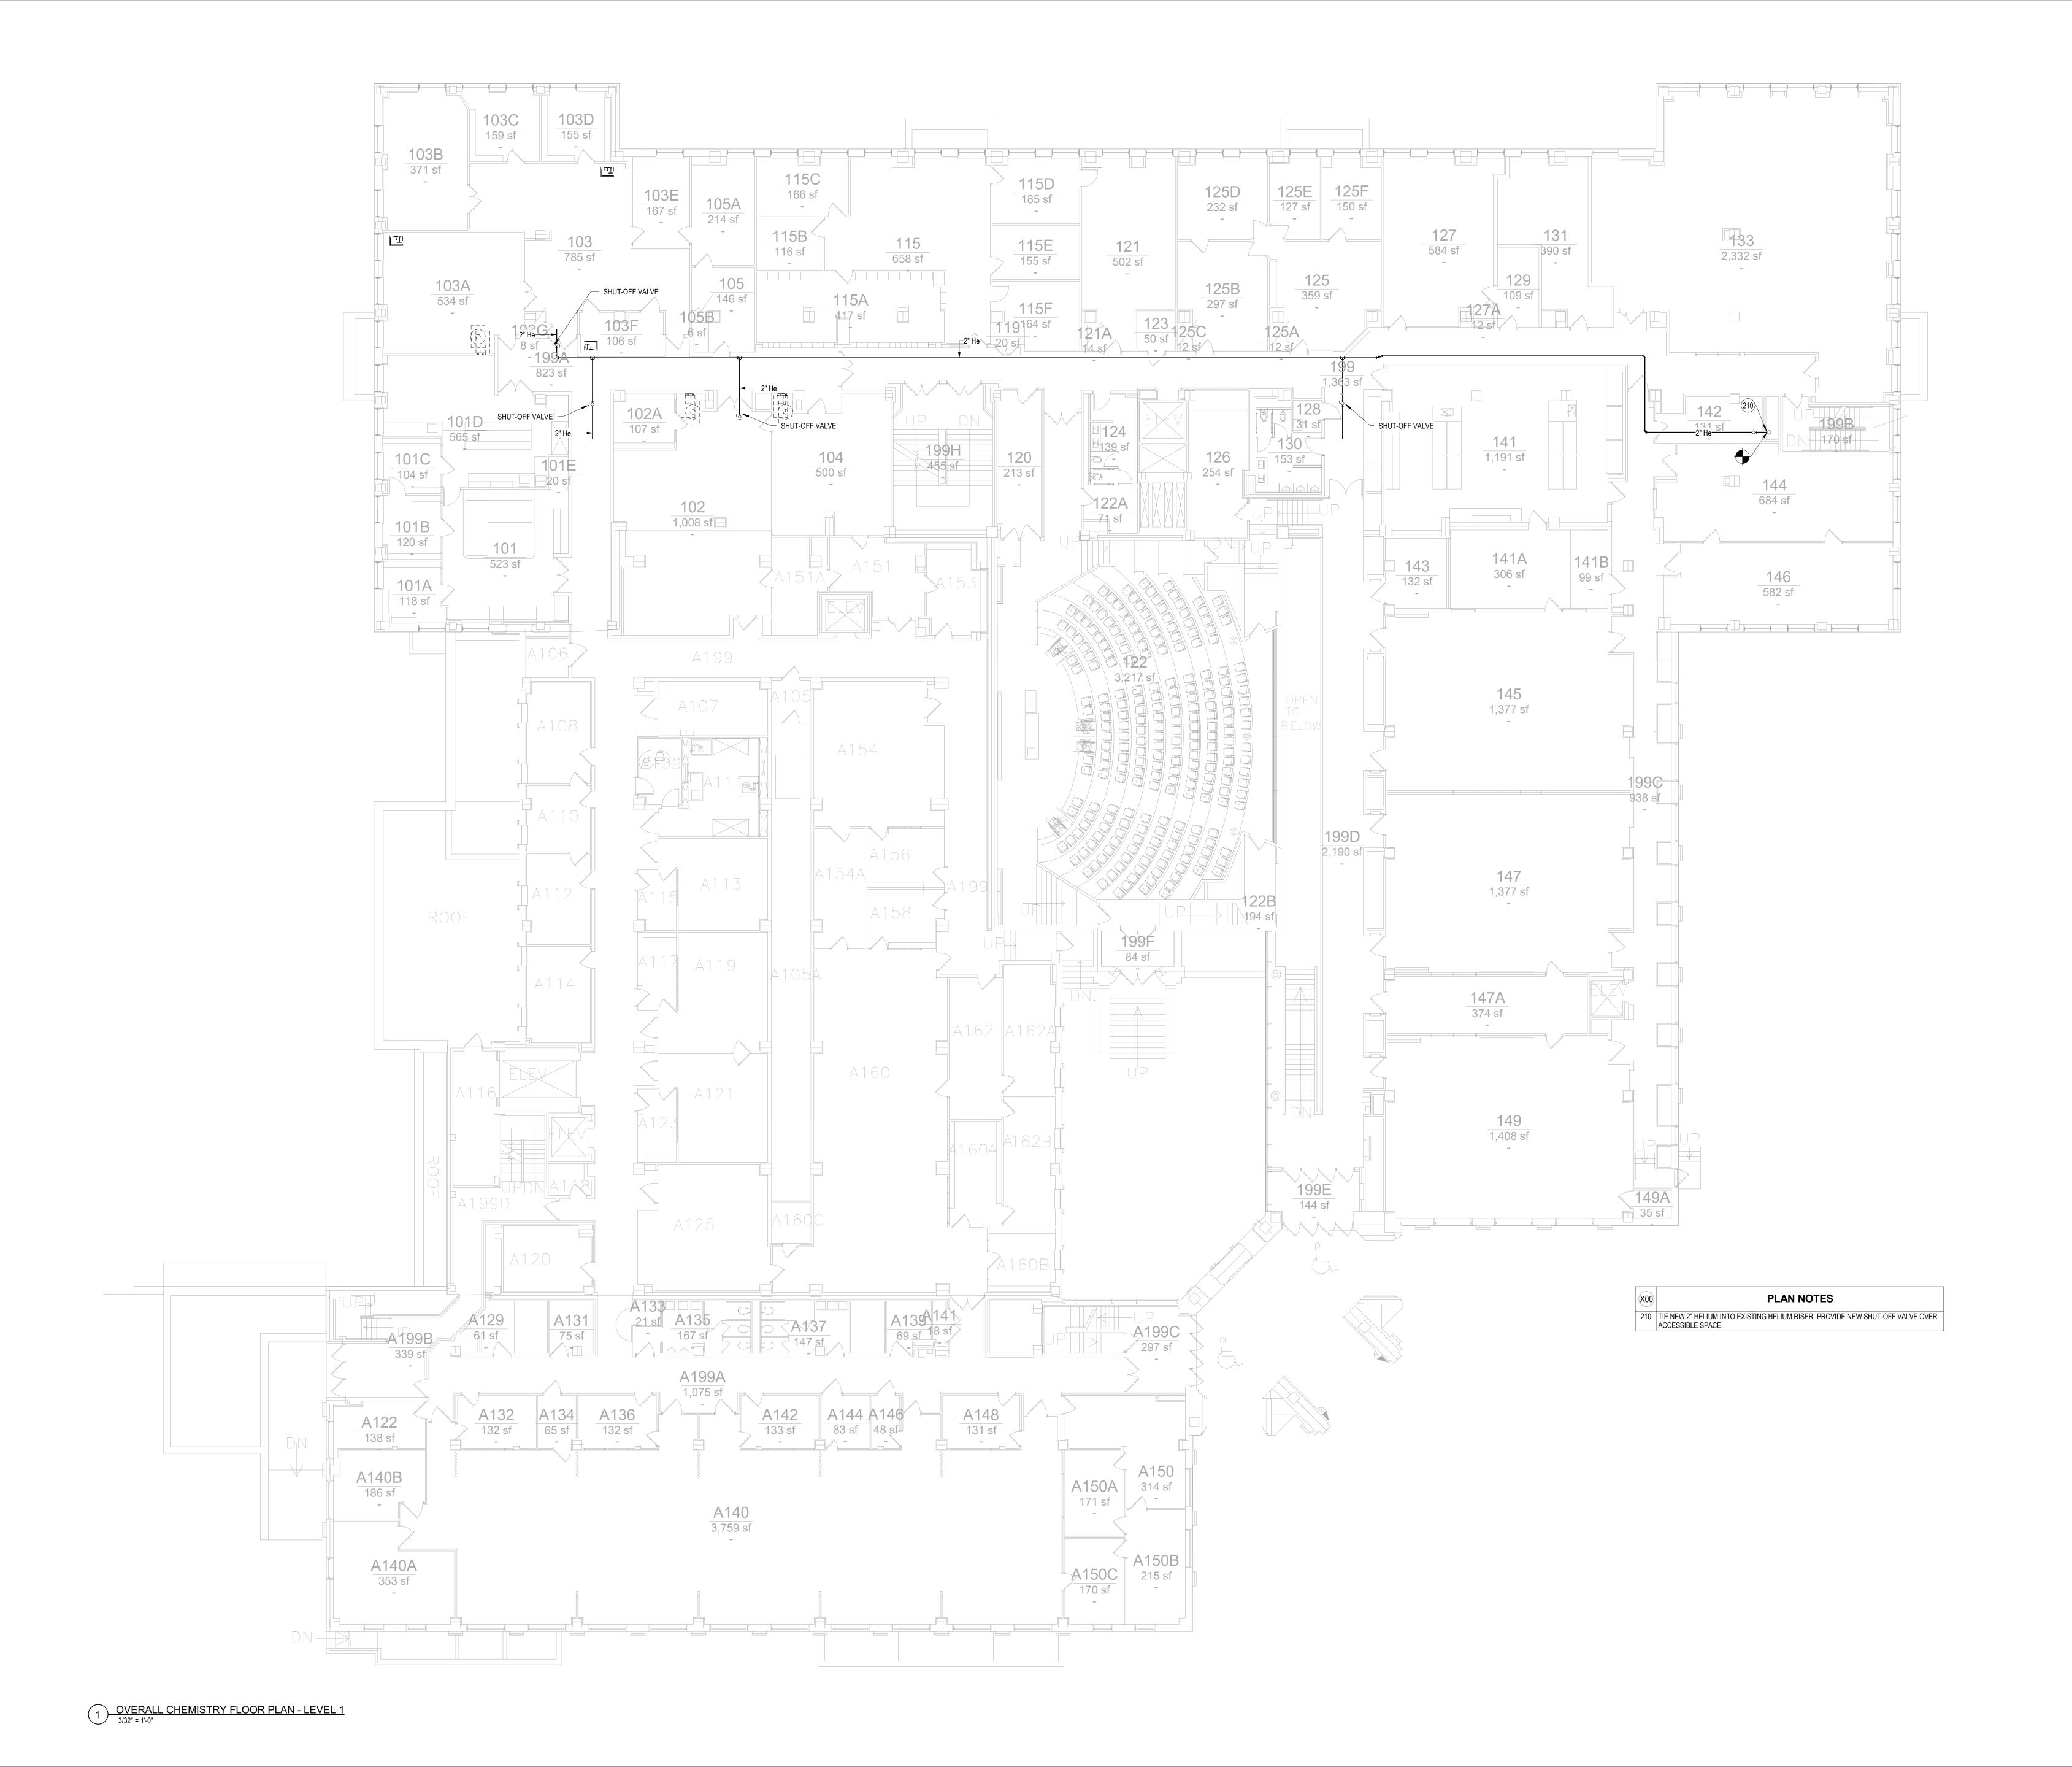



## IUB RESEARCH LAB RENOVATIONS

BL072 CHEMISTRY
800 E KIRKWOOD AVE, BLOOMINGTON, IN 47405
BL027 SWAIN WEST
729 E 3RD ST, BLOOMINGTON, IN 47405
BL070 SIMON HALL
212 S HAWTHORNE DR, BLOOMINGTON, IN 47405

CLIENT PROJECT NO. - 20240397

BIDDING SET JANUARY 9, 2025


MARK	DATE	DESCRIPTION
3	01/29/25	ADDENDUM 3
2	01/27/25	ADDENDUM 2
1	01/17/25	ADDENDUM 1

BL072 CHEMISTRY -OVERALL FLOOR PLAN -LEVEL 1

DATE
BSALS PROJECT NO.

100360477

12 P209

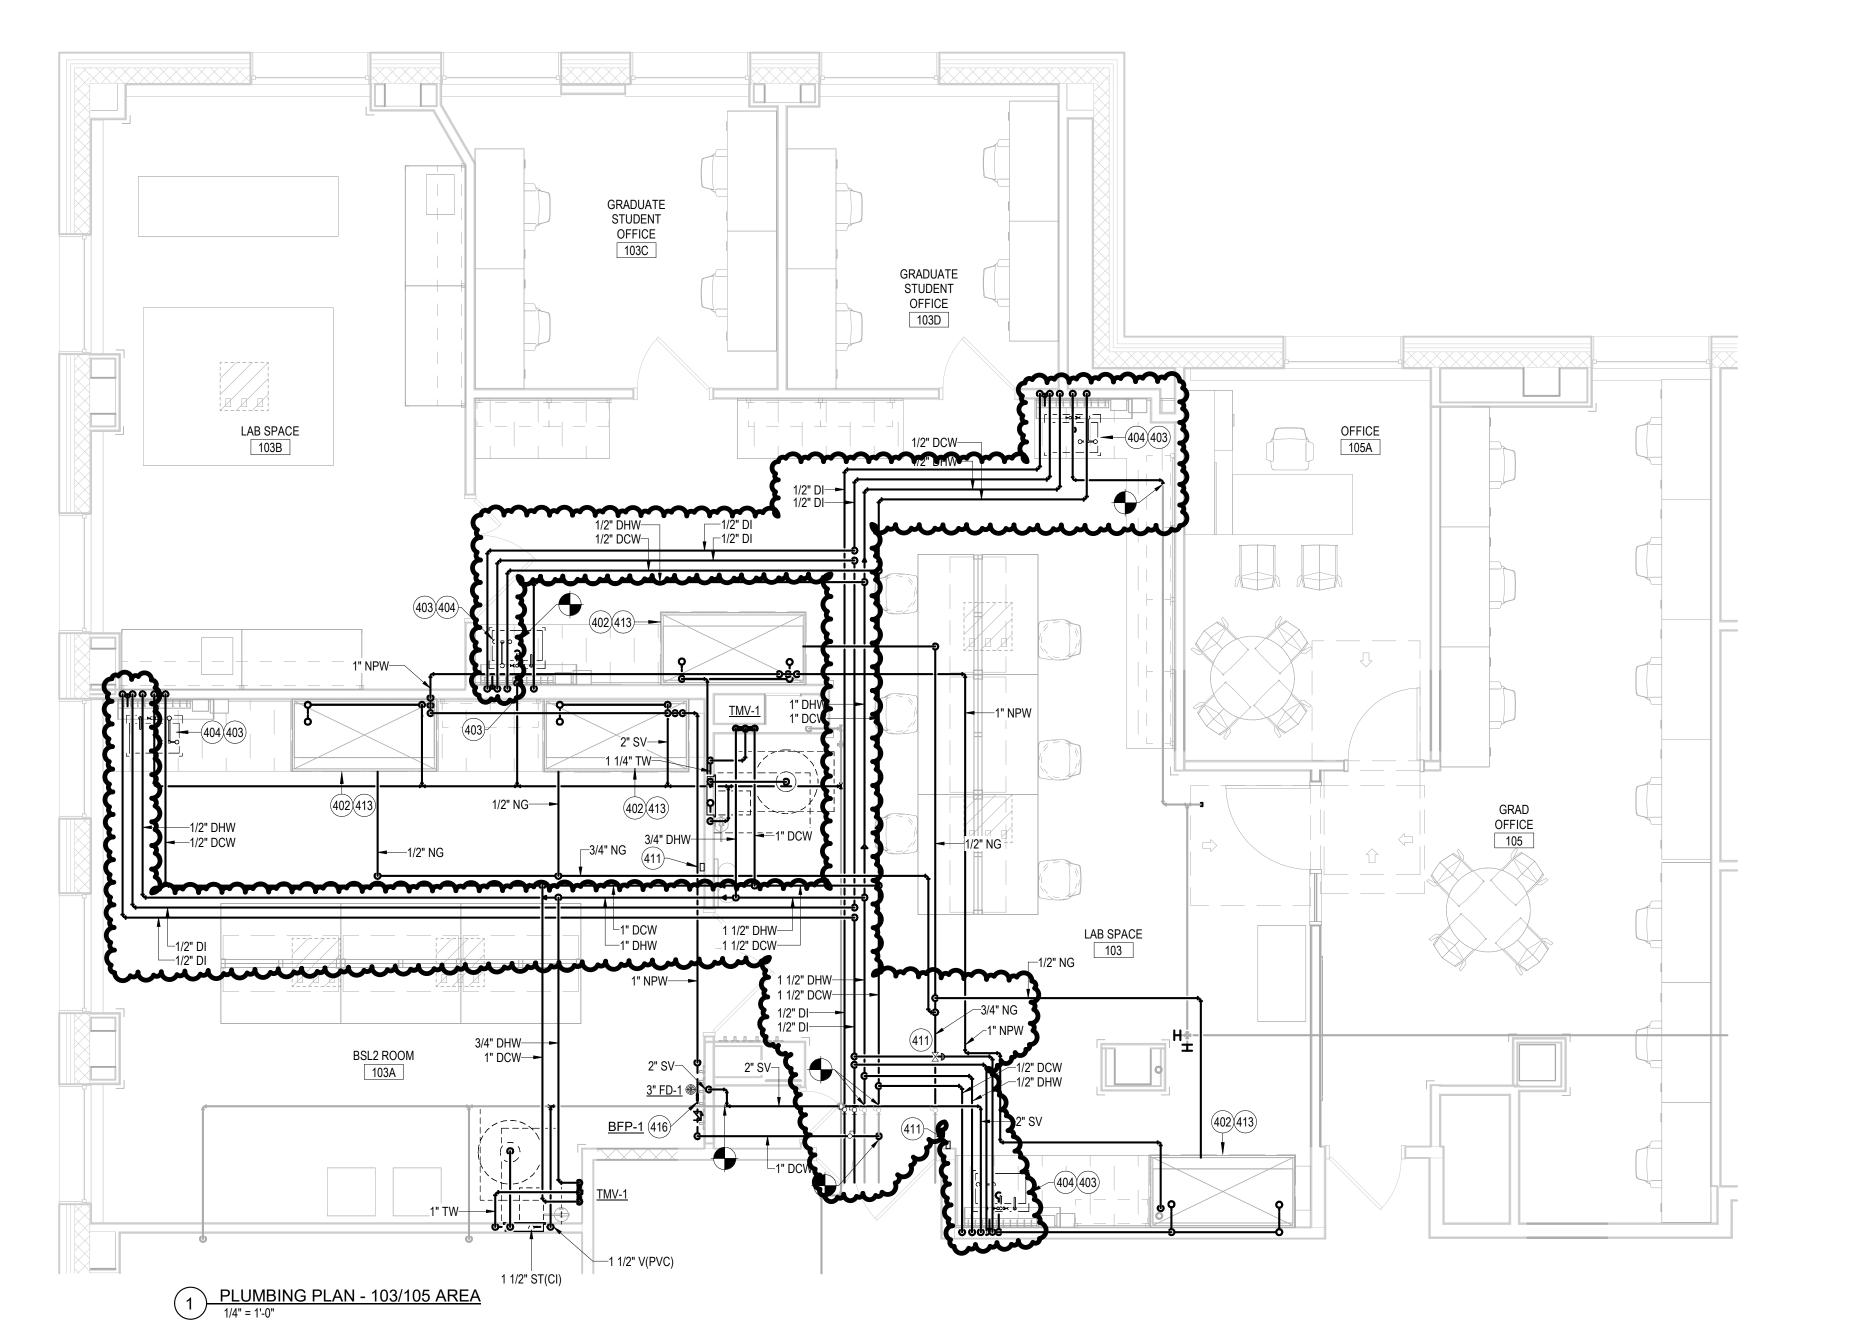

- PLANNOTES 401 PROVIDE 3/8" NITROGEN AND 3/8" LAB AIR TO CEILING SERVICE PANEL. 402 PROVIDE COLD WATER, NATURAL GAS, NITROGEN, LAB AIR AND SPECIAL GAS TO FUME 404 PROVIDE NEW THERMO MIXING VALVE UNDER SINK TO EMERGENCY EYE WASH SET THEMO MIXING VALVE AT /2 DEGREE AND FLOW OF 3 GPM. 411 PROVIDE EMERCENCY SHUT-OFF BUTTON AND SOLENOID VALVE FOR NATURAL CAS COORDINATE POWER SOURCE VOLTAGE AND LOCATION WITH ELECTRICAL TRADES. MANUFACTURER BURNABY - MODEL MESO AUXILIARY SHUT-OFF AND ASCO GAS SHUTOFF VALVE (ALUMINUM BODY, 2-WAY NORMALLY CLOSED). MOUNT BUTTON AT 4'-0" AFF AND PROVIDE WALL MOUNTED SIGNAGE: "NATURAL GAS SHUTOFF".

412 PROVIDE ALICAT MAS FLOW METER MCS SERIES FOR NITROGEN GAS PIPING.

- 413 PROVIDE SPECIAL WASTE PIPING AND VENT TO TWO CUP SINKS. ROUTE PIPING BEHIND HOOD AND CONNECT TO WASTE PIPE FROM SINK. 416 PROVIDE 1" BACKFLOW PREVENTER FOR NPW PIPING SERVICE TO FUME HOODS.
- CONNECT COMPLETE TO EACH HOOD'S WATER CONNECTION (TWO CUP SINK FIXTURES). SEE BACKFLOW PREVENTION DETAIL FOR ADDITIONAL REQUIREMENTS. 423 PROVIDE A SINGLE STAINLESS SG TUBE RUNNING DOWN THE WALL AT THE TANK, THE TUBE WOULD END AT 5'-6" AFF WITH A BALL VALVE AT 6'-0" AFF AND A 0-100 PSIG

PRESSURE GAUGE AT 6'-6" AFF. CYLINDERS AND PRESSURE REGULATORS AND HOSING ARE THEN OFOI.

ᡊᢇᠬᠬᠬᠬᠬᠬᠬᠬᠬᠬᠬᠬᠬᠬᠬᠬᠬᠬᠬᠬᠬ LAB VACUUM SYSTEM A LOCAL ROOM-LEVEL LAB VACUUM SYSTEM(S) HAS BEEN IDENTIFIED IN THE 119000 SPECIFICATION AND ON THE LAB FURNISHINGS DRAWINGS. THE PLUMBING TRADESPEOPLE AND DIVISION 22 CONTRACTOR SHALL PHYSICALLY INSTALL THE 119000 SYSTEM'S VACUUM PUMP, TUBING AND FITTINGS, AND TUBING HANGERS WHICH ARE FURNISHED BY THE 119000 SUPPLIER. THE PLUMBING TRADESPEOPLE AND DIVISION 22 CONTRACTOR SHALL PROVIDE ADDITIONAL TUBING HANGERS AND OTHER INSTALLATION HARDWARE WHICH ARE NOT FURNISHED BY THE 119000 SUPPLIER. COORDINATE CLOSELY WITH THE 119000 SUPPLIER SUCH THAT THE FINISHED COMPLETED VACUUM SYSTEM INSTALLATION MEETS THE 119000 SUPPLIER WRITTEN INSTALLATION INSTRUCTIONS. 

OFFICE 105A

GRAD OFFICE 105

## **IUB** RESEARCH LAB

**RENOVATIONS** 

BSA LifeStructures

9365 Counselors Row, Suite 300 Indianapolis, IN 46240-1478


ph 317.819.7878 fx 317.819.7288

BL072 CHEMISTRY 800 E KIRKWOOD AVE, BLOOMINGTON, IN 47405 BL027 SWAIN WEST 729 E 3RD ST, BLOOMINGTON, IN 47405 BL070 SIMON HALL 212 S HAWTHORNE DR, BLOOMINGTON, IN 47405

CLIENT PROJECT NO. - 20240397

**BIDDING SET** JANUARY 9, 2025

DESCRIPTION 3 01/29/25 ADDENDUM 3
2 01/27/25 ADDENDUM 2
1 01/17/25 ADDENDUM 1

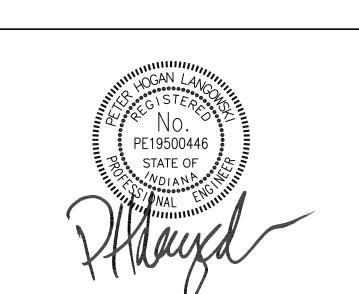

BL072 CHEMISTRY -PLUMBING PLAN - CH 103/105 AREA

DATE
BSALS PROJECT NO.

P210

2" SW-


GRADUATE STUDENT OFFICE


STATE TO THE STATE OF THE STATE

January Control of LA

GRADUATE STUDENT OFFICE 103D

2 PLUMBING PLAN - LEVEL OG 1/4" = 1'-0"

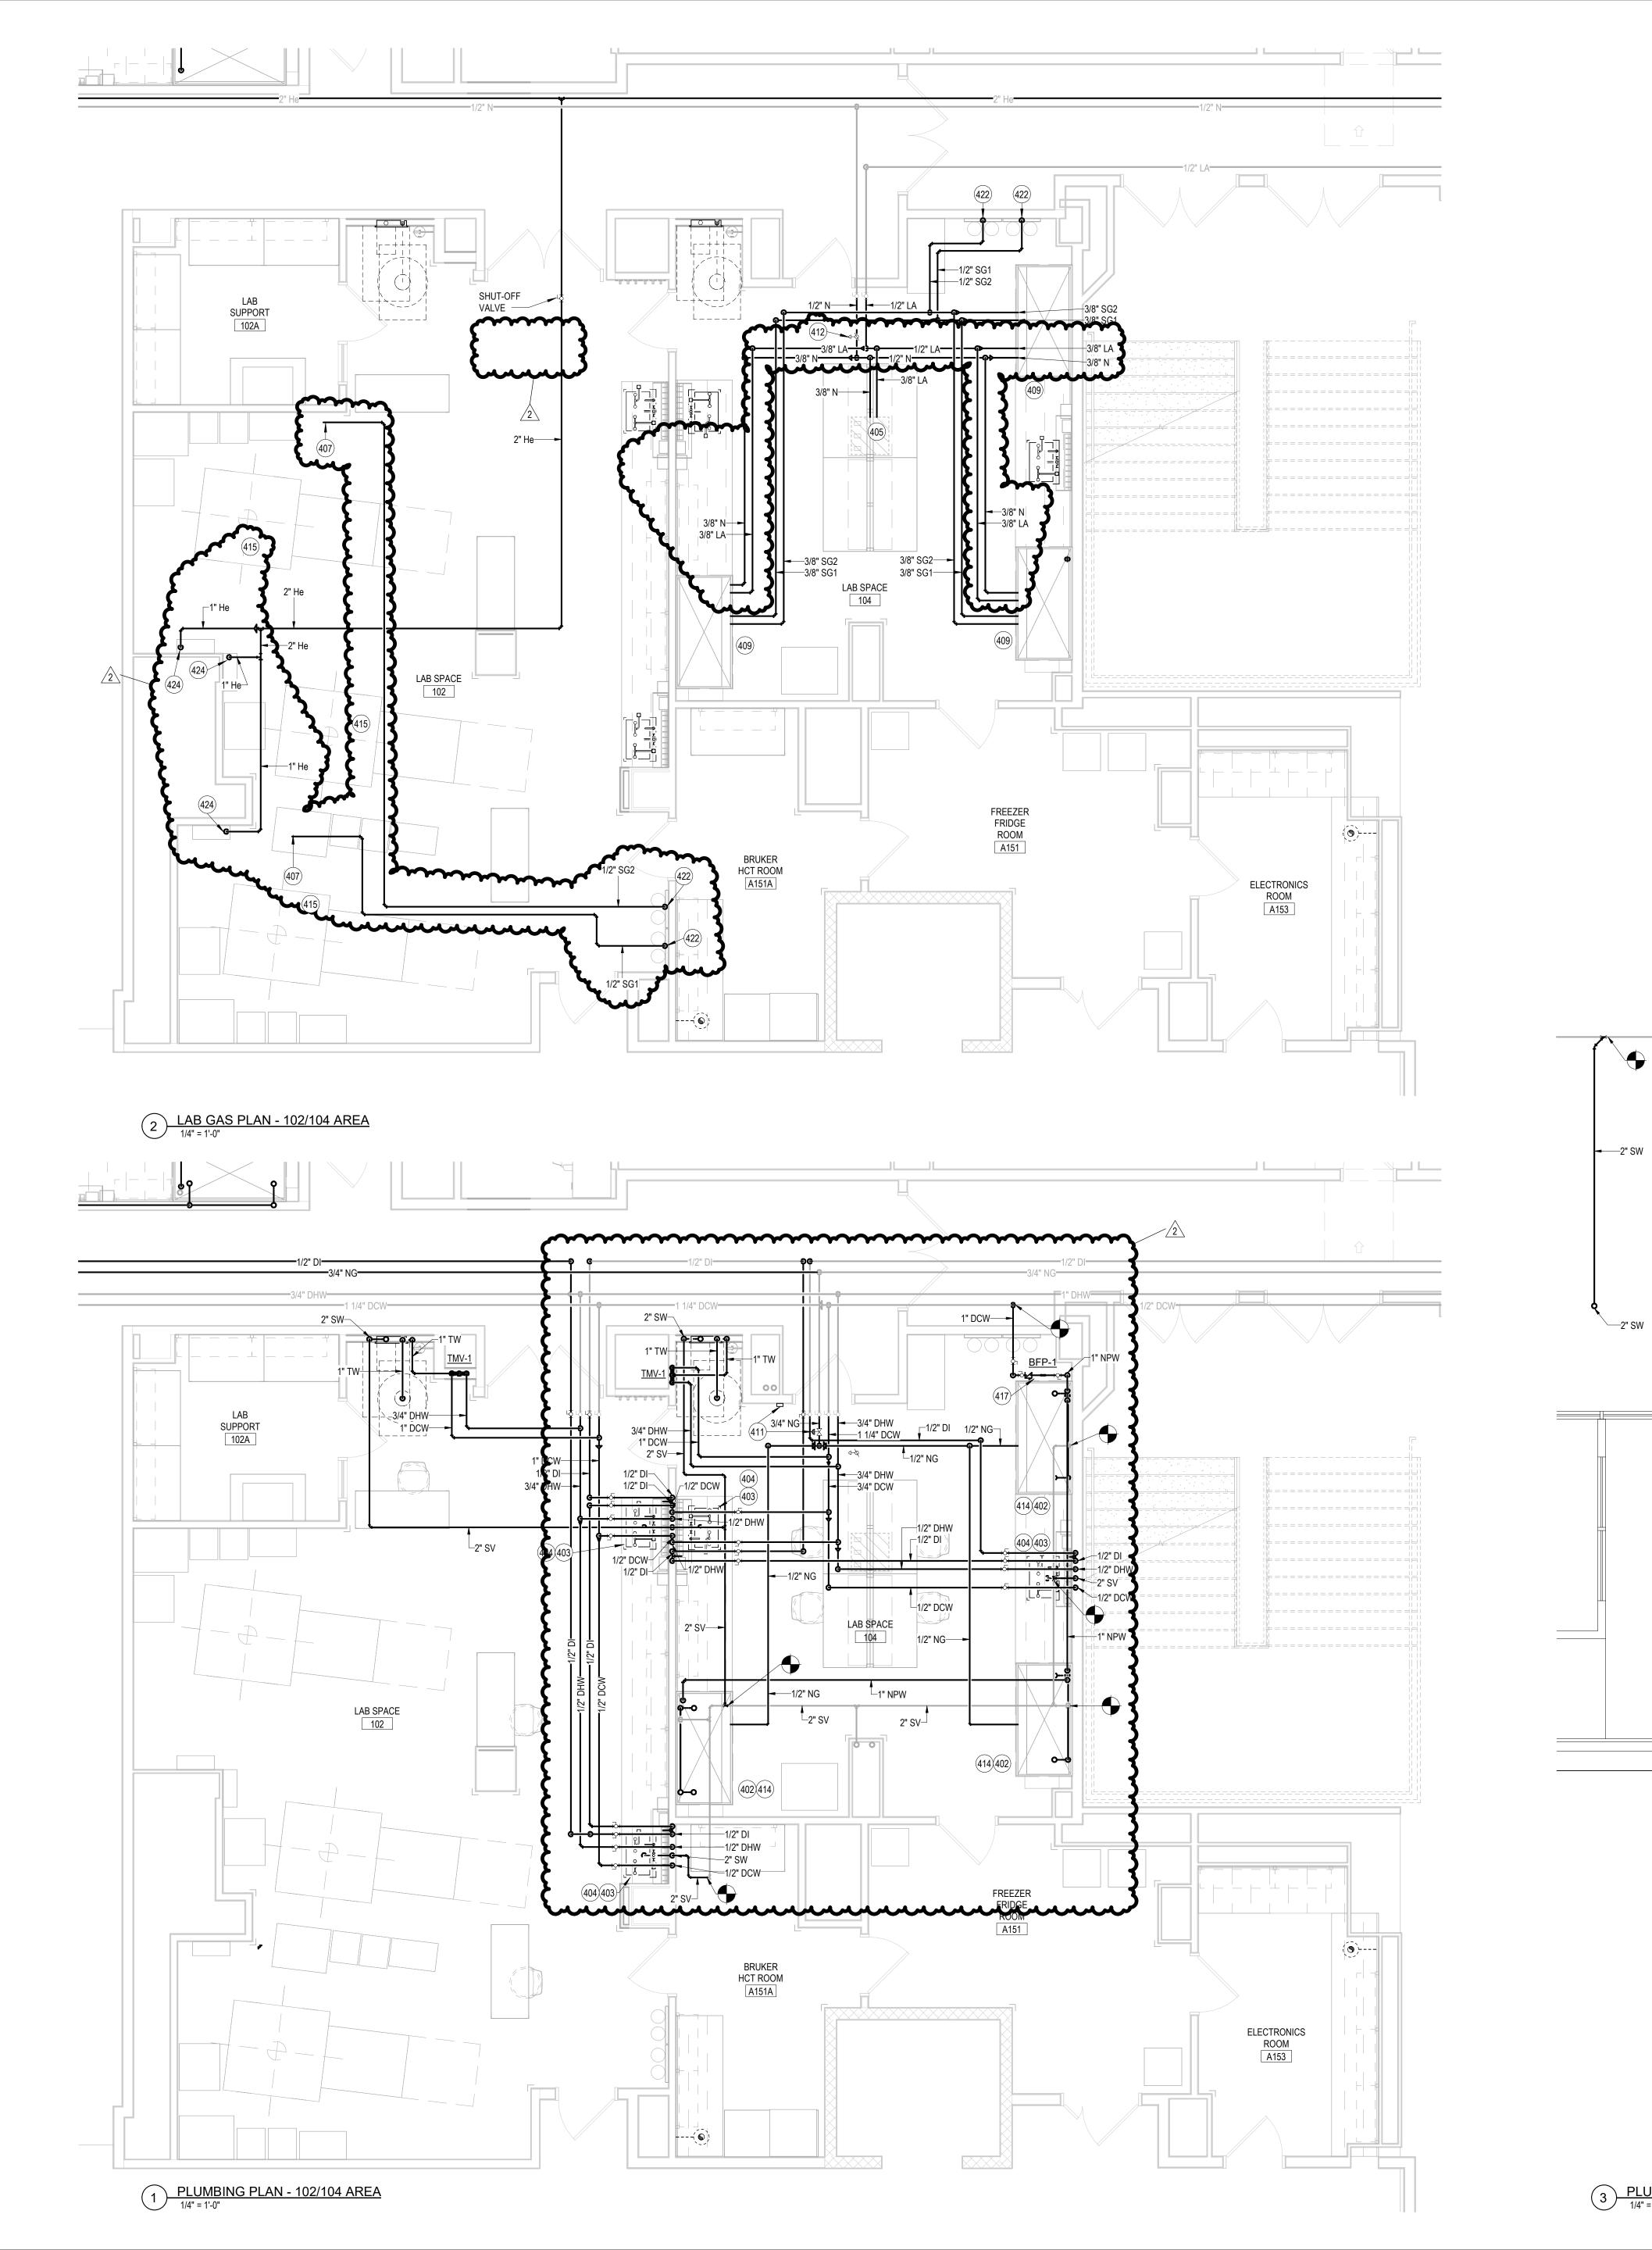

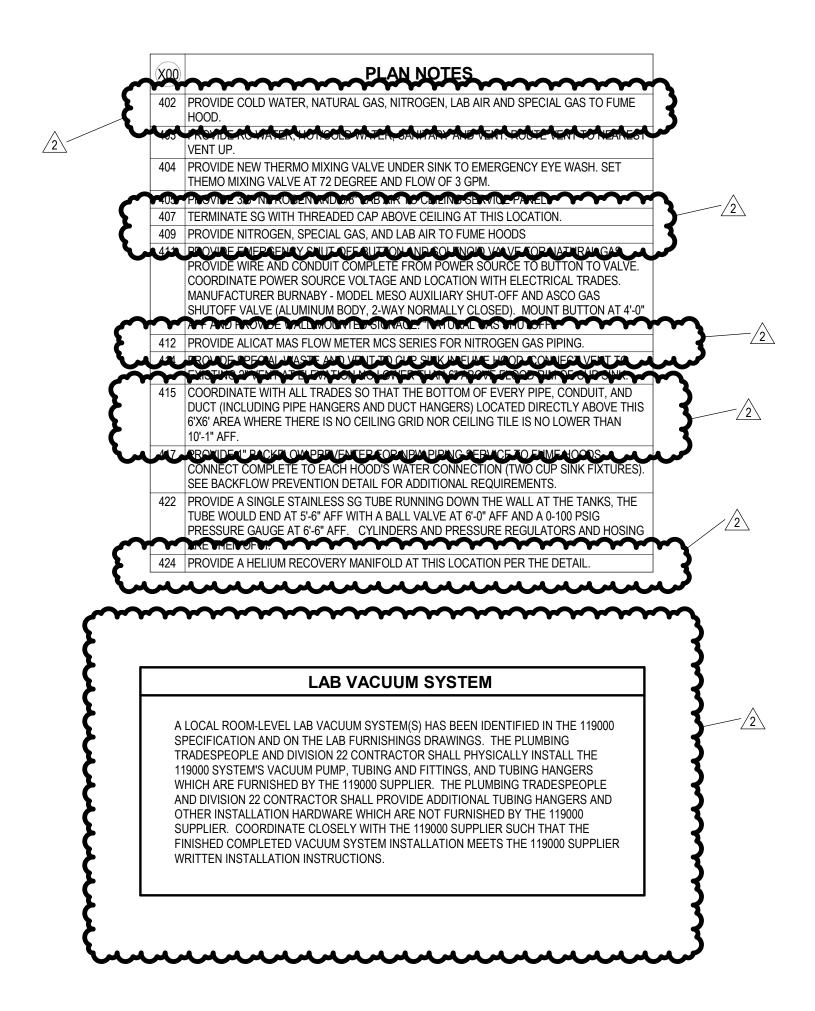

# BSA LifeStructures 9365 Counselors Row, Suite 300 Indianapolis, IN 46240-1478 ph 317.819.7878 fx 317.819.7288

## IUB RESEARCH LAB RENOVATIONS

BL072 CHEMISTRY
800 E KIRKWOOD AVE, BLOOMINGTON, IN 47405
BL027 SWAIN WEST
729 E 3RD ST, BLOOMINGTON, IN 47405
BL070 SIMON HALL
212 S HAWTHORNE DR, BLOOMINGTON, IN 47405

CLIENT PROJECT NO. - 20240397

BIDDING SET JANUARY 9, 2025

MARK	DATE	DESCRIPTION
3	01/29/25	ADDENDUM 3
2	01/27/25	ADDENDUM 2
1	01/17/25	ADDENDUM 1



BL072 CHEMISTRY -PLUMBING PLAN - CH 102/104 AREA

DATE
BSALS PROJECT NO.

D211

JAN 1, 201?



2" SW-√

2" SW--0

2" SW—**-6** 

----2" SW

2" SW---

ENDLINE CLEANOUT

A LOCAL ROOM-LEVEL LAB VACUUM SYSTEM(S) HAS BEEN IDENTIFIED IN THE 119000 SPECIFICATION AND ON THE LAB FURNISHINGS DRAWINGS. THE PLUMBING TRADESPEOPLE AND DIVISION 22 CONTRACTOR SHALL PHYSICALLY INSTALL THE 119000 SYSTEM'S VACUUM PUMP, TUBING AND FITTINGS, AND TUBING HANGERS WHICH ARE FURNISHED BY THE 119000 SUPPLIER. THE PLUMBING TRADESPEOPLE AND DIVISION 22 CONTRACTOR SHALL PROVIDE ADDITIONAL TUBING HANGERS AND OTHER INSTALLATION HARDWARE WHICH ARE NOT FURNISHED BY THE 119000 SUPPLIER. COORDINATE CLOSELY WITH THE 119000 SUPPLIER SUCH THAT THE FINISHED COMPLETED VACUUM SYSTEM INSTALLATION MEETS THE 119000 SUPPLIER WRITTEN INSTALLATION INSTRUCTIONS.

#### PLAN NOTES

- 400 REROUTE NEW WASTE PIPING TO AVOID MECHANICAL DUCT WORK AND HYDRONIC
- 403 PROVIDE RO WATER, HOT/COLD WATER, SANITARY AND VENT. ROUTE VENT TO NEAREST VENT UP.

# 404 PROVIDE NEW THERMO MIXING VALVE UNDER SINK TO EMERGENCY EYE WASH. SET THEMO MIXING VALVE AT 72 DEGREE AND FLOW OF 3 GPM. 405 PROVIDE 3/8" NITROGEN AND 5/8" LAB AYR TO CEILING SERVICE PANEL. 410 PROVIDE NITROGEN AND LAB AIR WITH BALL VALVE 0'-6" ABOVE COUNTER TOP. CONFIRM EXACT LOCATION AND CONFIGURATION WITH OWNER PRIOR TO INSTALLING PIPING.

PROVIDE WIRE AND CONDUIT COMPLETE FROM POWER SOURCE TO BUTTON TO VALVE.
COORDINATE POWER SOURCE VOLTAGE AND LOCATION WITH ELECTRICAL TRADES.
MANUFACTURER BURNABY - MODEL MESO AUXILIARY SHUT-OFF AND ASCO GAS
SHUTOFF VALVE (ALUMINUM BODY, 2-WAY NORMALLY CLOSED). MOUNT BUTTON AT 4'-0"
AFF AND PROVIDE WALL MOUNTED SIGNAGE: "NATURAL GAS SHUTOFF".

#### PLAN NOTES

PROVIDE 1" BACKFLOW PREVENTER FOR NPW PIPING SERVICE TO FUME HOODS.
 CONNECT COMPLETE TO EACH HOOD'S WATER CONNECTION (TWO CUP SINK FIXTURES).
 SEE BACKFLOW PREVENTION DETAIL FOR ADDITIONAL REQUIREMENTS.
 PROVIDE SPECIAL WASTE PIPING, FITTINGS, AND HANGERS FROM PENETRATION OF THIRD FLOOR SLAB ABOVE TO THE CONNECTION TO THE STACK. COORDINATE ROUTING WITH ALL NEW INSTALLATIONS (DUCTWORK, PIPING, CONDUIT, ETC.) AND ANY EXISTING INSTALLATIONS TO REMAIN.

PROVIDE A SINGLE STAINLESS SG TUBE RUNNING DOWN THE WALL AT THE TANKS, THE TUBE WOULD END AT 5'-6" AFF WITH A BALL VALVE AT 6'-0" AFF AND A 0-100 PSIG PRESSURE GAUGE AT 6'-6" AFF. CYLINDERS AND PRESSURE REGULATORS AND HOSING



**IUB** 

RESEARCH

RENOVATIONS

BL072 CHEMISTRY
800 E KIRKWOOD AVE, BLOOMINGTON, IN 47405
BL027 SWAIN WEST
729 E 3RD ST, BLOOMINGTON, IN 47405
BL070 SIMON HALL
212 S HAWTHORNE DR, BLOOMINGTON, IN 47405

CLIENT PROJECT NO. - 20240397


**BIDDING SET** 


JANUARY 9, 2025

MARK DATE


3 01/29/25 ADDENDUM 3
2 01/27/25 ADDENDUM 2
1 01/17/25 ADDENDUM 1


DESCRIPTION

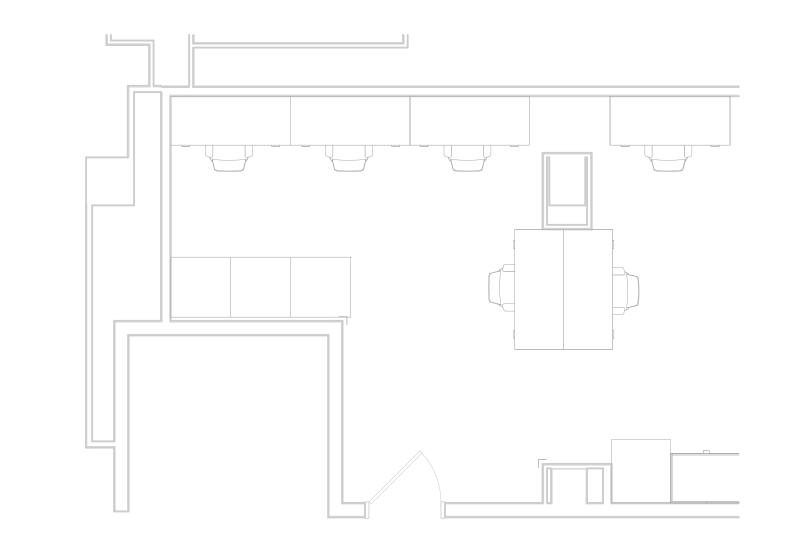

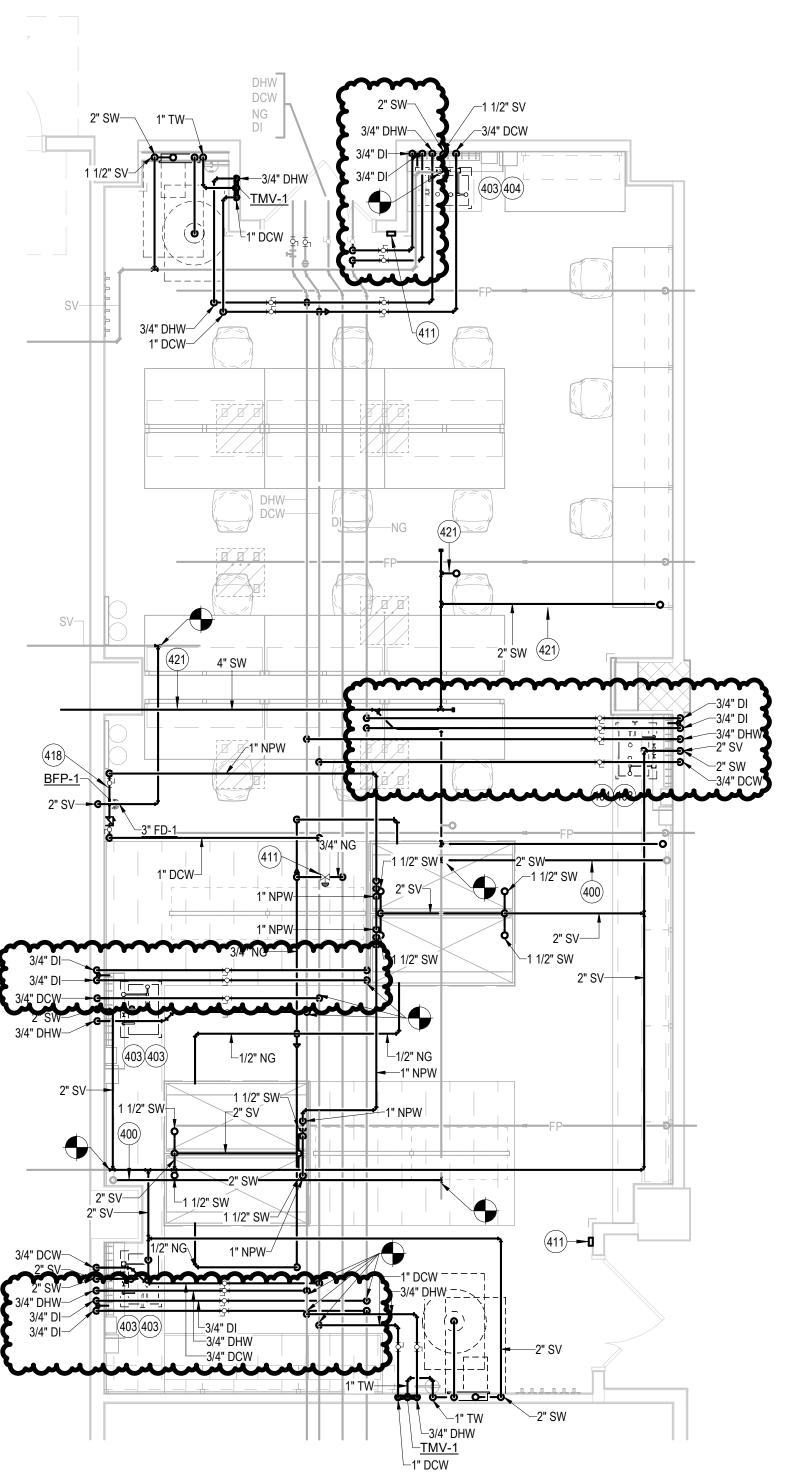



3 PLUMBING PLAN - A251 / A252 AREA
1/4" = 1'-0"

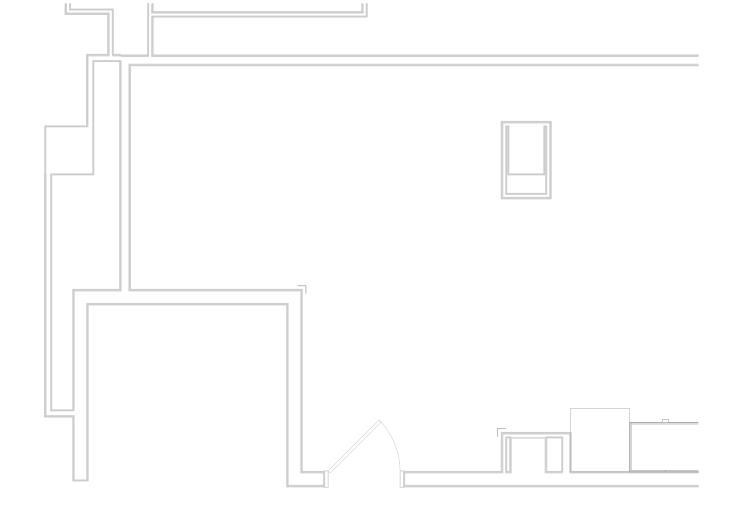

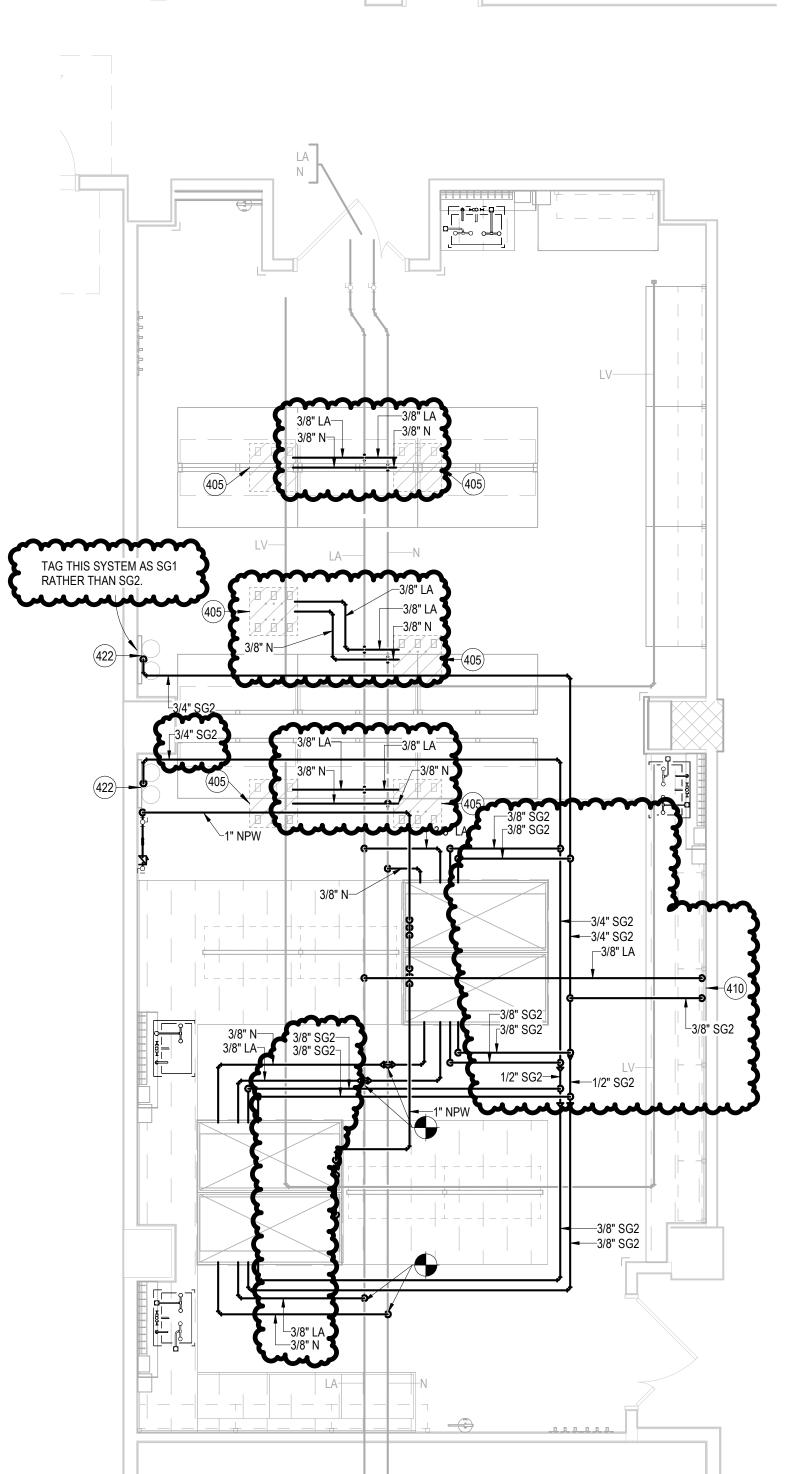


1 LAB GAS PLAN - A251/A252 AREA 1/4" = 1'-0"

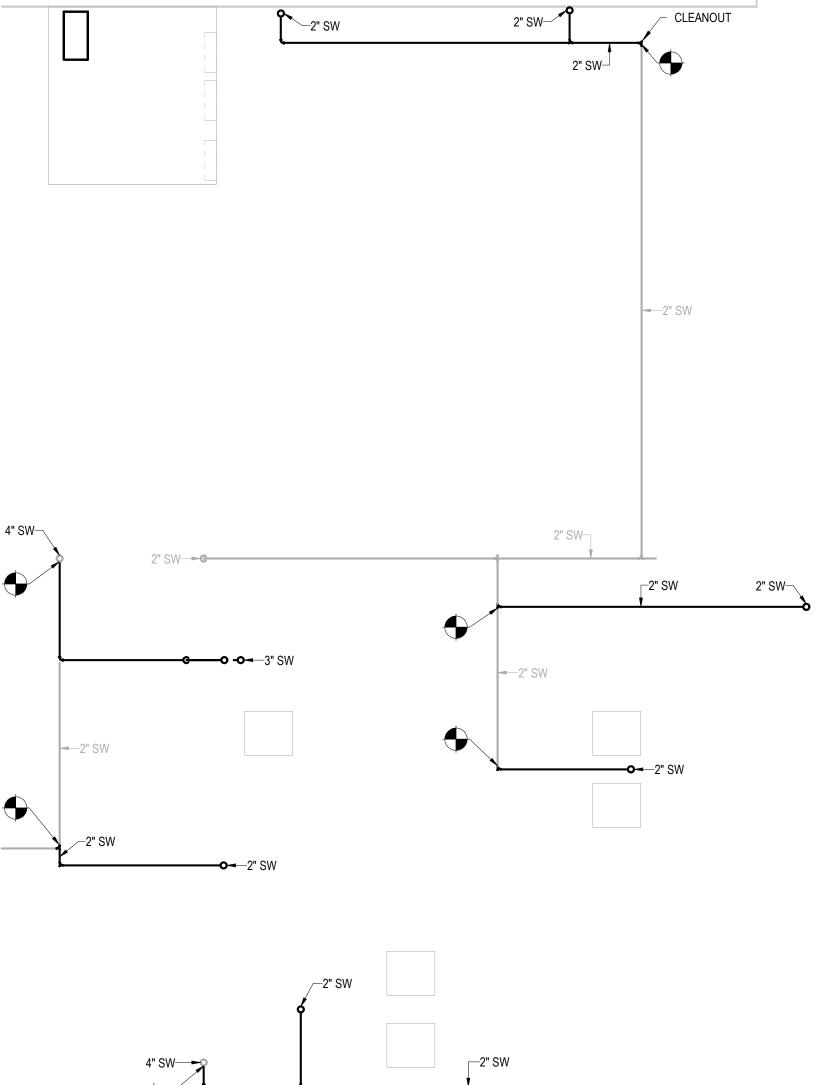

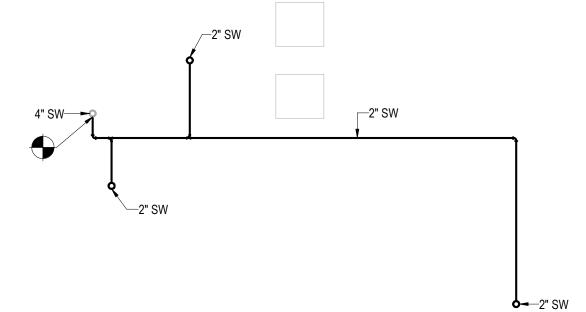

2 FIRST FLOOR SANITARY - CH A251/A252 AREA

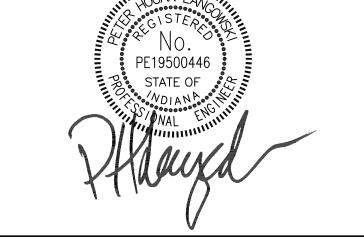

BL072 CHEMISTRY -PLUMBING PLAN - CH A251/A252 AREA

DATE
BSALS PROJECT NO.

P21

© BSA LifeStructures Inc.

LAB VACUUM SYSTEM A LOCAL ROOM-LEVEL LAB VACUUM SYSTEM(S) HAS BEEN IDENTIFIED IN THE 119000 SPECIFICATION AND ON THE LAB FURNISHINGS DRAWINGS. THE PLUMBING TRADESPEOPLE AND DIVISION 22 CONTRACTOR SHALL PHYSICALLY INSTALL THE 119000 SYSTEM'S VACUUM PUMP, TUBING AND FITTINGS, AND TUBING HANGERS WHICH ARE FURNISHED BY THE 119000 SUPPLIER. THE PLUMBING TRADESPEOPLE AND DIVISION 22 CONTRACTOR SHALL PROVIDE ADDITIONAL TUBING HANGERS AND OTHER INSTALLATION HARDWARE WHICH ARE NOT FURNISHED BY THE 119000 SUPPLIER. COORDINATE CLOSELY WITH THE 119000 SUPPLIER SUCH THAT THE FINISHED COMPLETED VACUUM SYSTEM INSTALLATION MEETS THE 119000 SUPPLIER

WRITTEN INSTALLATION INSTRUCTIONS.

᠕ᠰᡳᠰᡳᠰᡳᠰᡳᠰᡳᠰᡳᠰᡳᠰᡳᠰᡳᠰᡳᠰᡳᠰᡳᠰᡳᠰᡳᠰᡳᠰᡳᠰᡳ

PLAN NOTES PROVIDE 3/8" NITROGEN AND 3/8" LAB AIR TO CEILING SERVICE PANEL. 402 PROVIDE COLD WATER, NATURAL GAS, NITROGEN, LAB AIR AND SPECIAL GAS TO FUME MOSA PROVIDE BOWATER HOTICOHAWATER CAMITARY AND VENT HOUTE VENT IN MEREST

412 PROVIDE ALICAT MAS FLOW METER MCS SERIES FOR NITROGEN GAS PIPING. M100 PROVIDE 1" AGCEL ON PREVENTED FOR NOW PLONG ERVICE TO FIME NOODS

SEE BACKFLOW PREVENTION DETAIL FOR ADDITIONAL REQUIREMENTS. 420 PROVIDE SPECIAL WASTE PIPING, FITTINGS, AND HANGERS FROM PENETRATION OF SECOND FLOOR SLAB ABOVE TO THE CONNECTION TO THE STACK. COORDINATE ROUTING WITH ALL NEW INSTALLATIONS (DUCTWORK, PIPING, CONDUIT, ETC.) AND ANY EXISTING INSTALLATIONS TO REMAIN.

**PLAN NOTES** 


422 PROVIDE A SINGLE STAINLESS SG TUBE RUNNING DOWN THE WALL AT THE TANKS, THE TUBE WOULD END AT 5'-6" AFF WITH A BALL VALVE AT 6'-0" AFF AND A 0-100 PSIG PRESSURE GAUGE AT 6'-6" AFF. CYLINDERS AND PRESSURE REGULATORS AND HOSING ARE THEN OFOI. 425 CONNECT TO EXISTING 1 1/2" SV UP

ALL FOUR AUXILIARY SHUTOFFS AND BOTH SOLENOID VALVES TOGETHER SUCH THAT


DEPRESSING ANY OF THE FOUR SHUTOFFS CLOSED BOTH OF THE SOLENOID VALVES.

AZO CONVECTIBLIZIO FECIAL WAS LER PROMOTINATO EXISTINGO WAS IN PIREBELOW PROVIDE EMERGENCY SHUT-OFF BUTTON AND SOLENOID VALVE FOR NATURAL GAS. PROVIDE WIRE AND CONDUIT COMPLETE FROM POWER SOURCE TO BUTTON TO VALVE. COORDINATE POWER SOURCE VOLTAGE AND LOCATION WITH ELECTRICAL TRADES. MANUFACTURER BURNABY - MODEL MESO AUXILIARY SHUT-OFF AND ASCO GAS SHUTOFF VALVE (ALUMINUM BODY, 2-WAY NORMALLY CLOSED). MOUNT BUTTON AT 4'-0" AFF AND PROVIDE WALL MOUNTED SIGNAGE: "NATURAL GAS SHUTOFF". FOR A140 WIRE

BSA LifeStructures 9365 Counselors Row, Suite 300 Indianapolis, IN 46240-1478 ph 317.819.7878 fx 317.819.7288

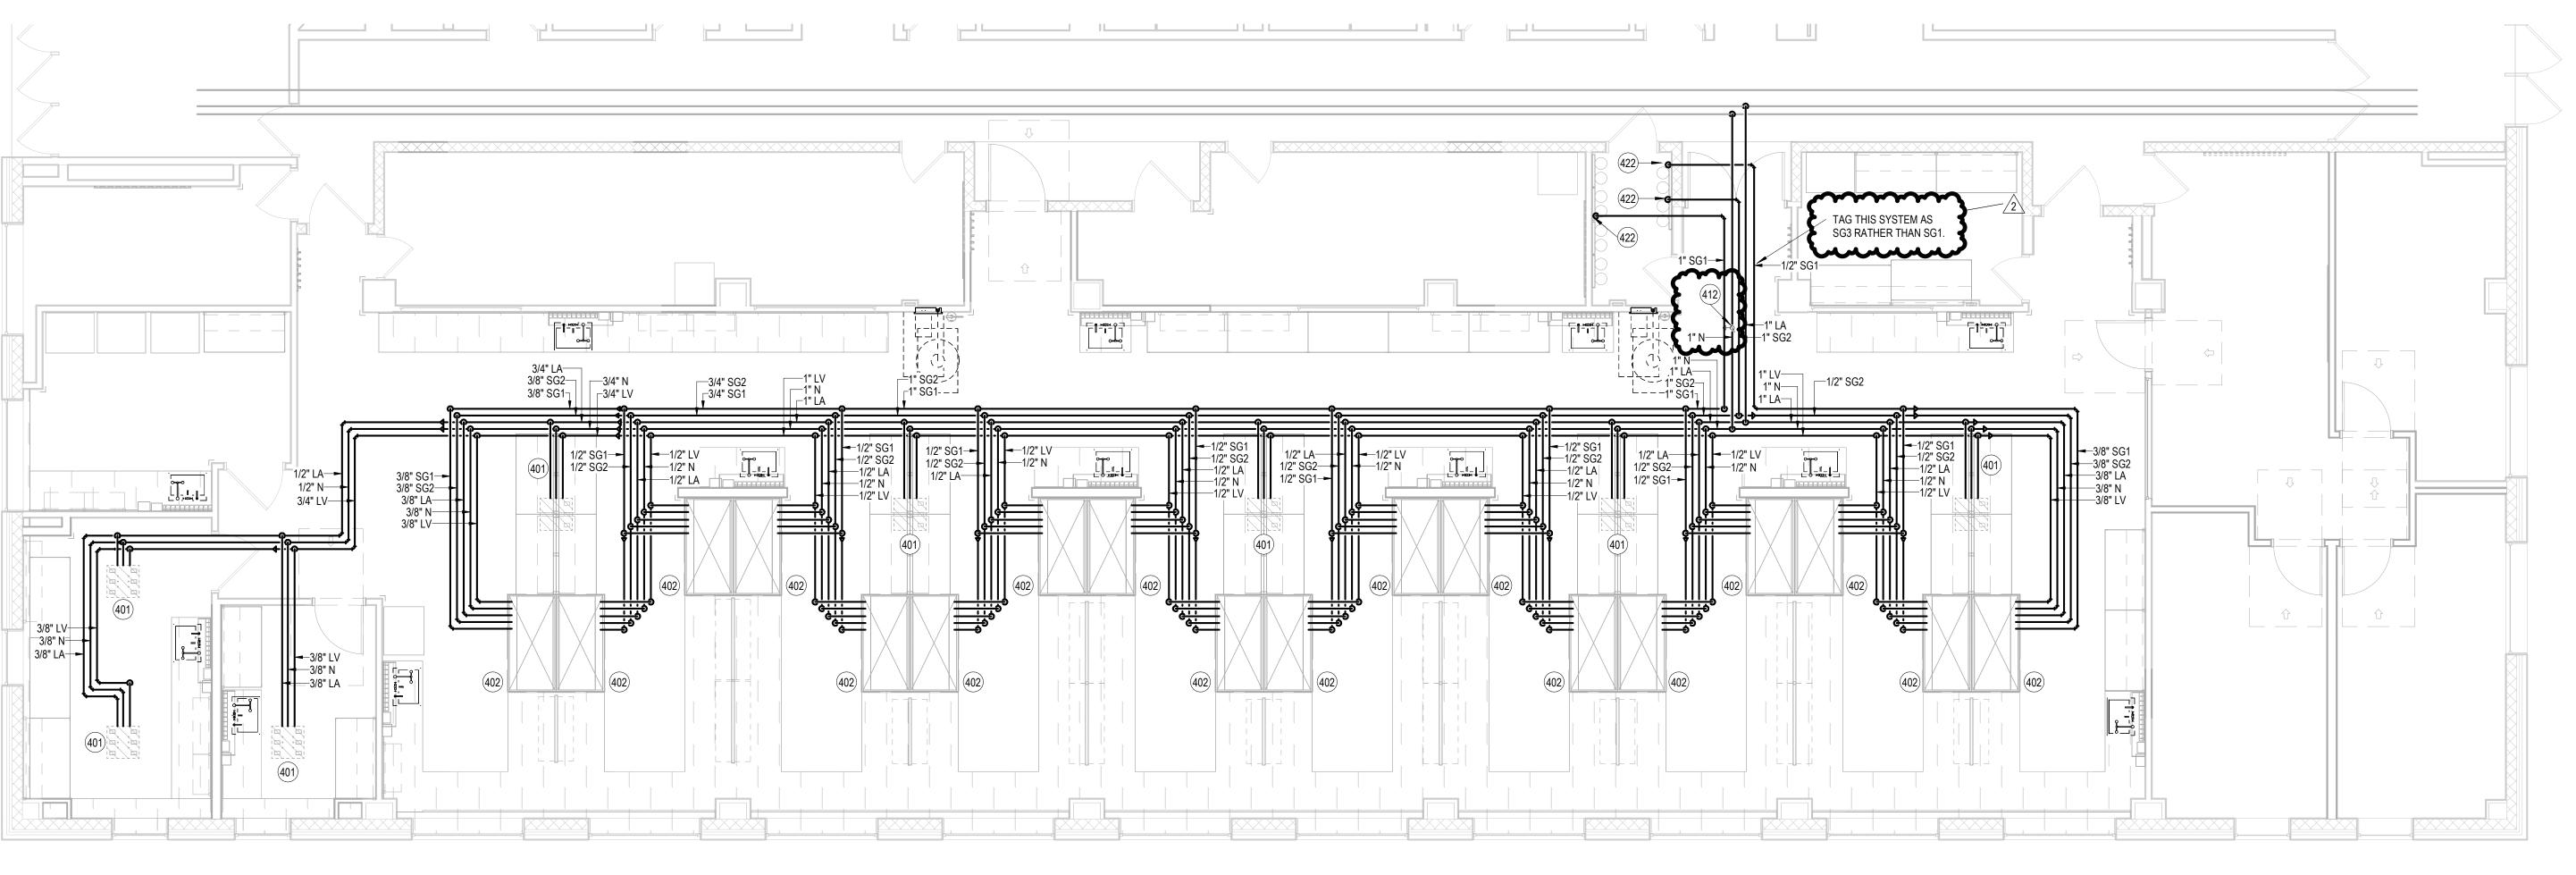

1 LAB GAS PLAN - A140 AREA 3/16" = 1'-0"

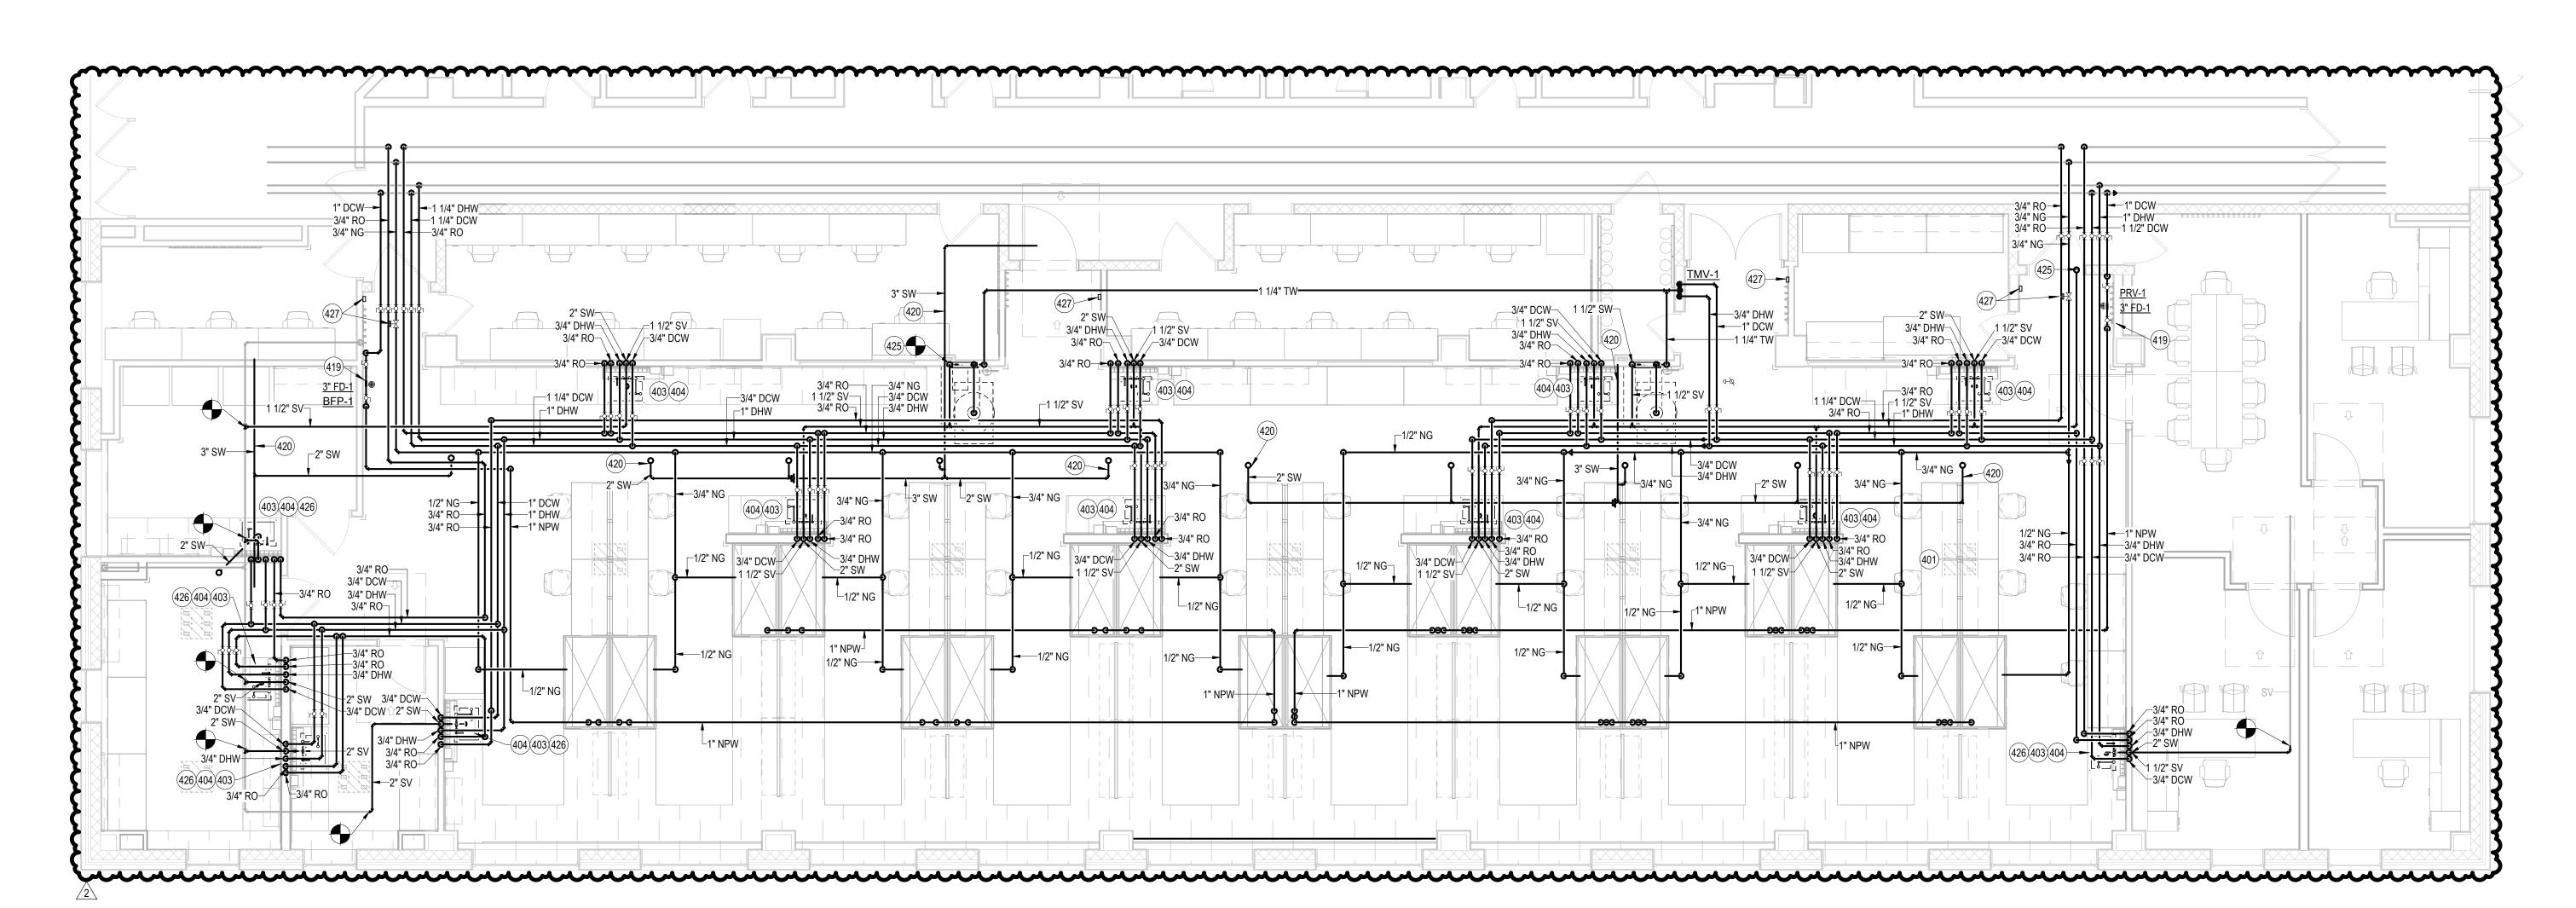

2 PLUMBING PLAN - A140 AREA 3/16" = 1'-0"

# **IUB** RESEARCH **RENOVATIONS**

BL072 CHEMISTRY 800 E KIRKWOOD AVE, BLOOMINGTON, IN 47405 **BL027 SWAIN WEST** 729 E 3RD ST, BLOOMINGTON, IN 47405 **BL070 SIMON HALL** 212 S HAWTHORNE DR, BLOOMINGTON, IN 47405

CLIENT PROJECT NO. - 20240397

**BIDDING SET** JANUARY 9, 2025


MARK	DATE	DESCRIPTION
3	01/29/25	ADDENDUM 3
2	01/27/25	ADDENDUM 2
1	01/17/25	ADDENDUM 1



BL072 CHEMISTRY -PLUMBING PLANS -CH A140 AREA

BSALS PROJECT NO.



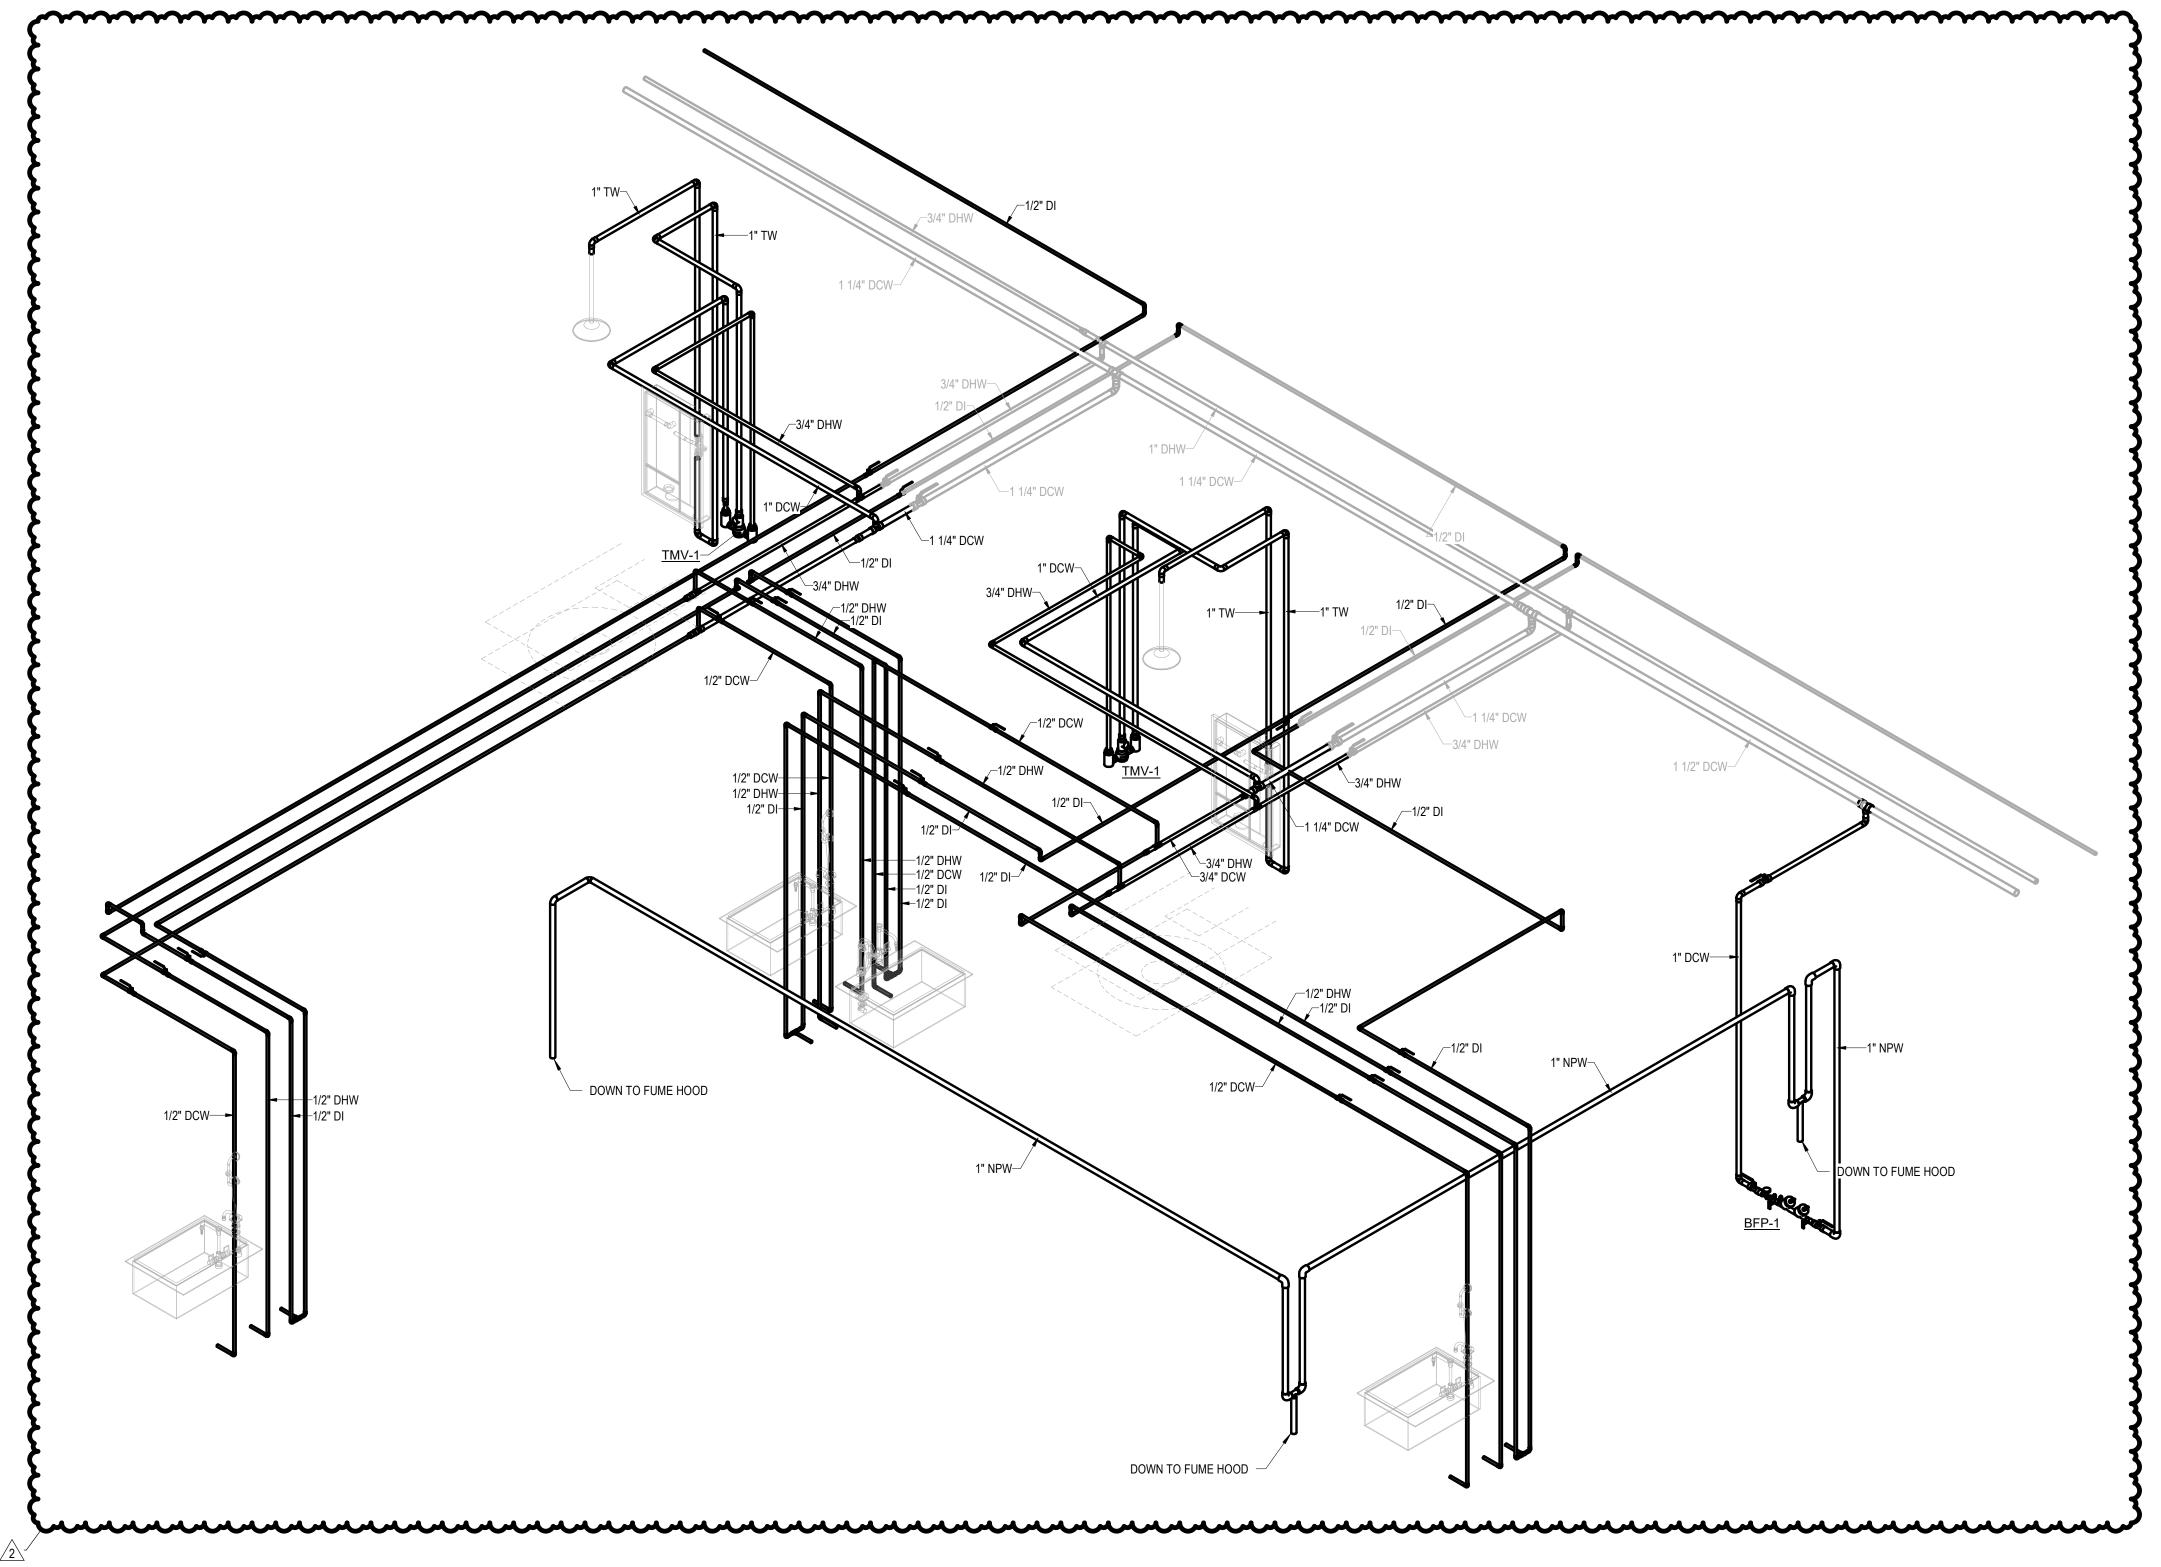

1 WATER RISER DIAGRAM - AREA 102/104

## IUB RESEARCH LAB RENOVATIONS

BL072 CHEMISTRY 800 E KIRKWOOD AVE, BLOOMINGTON, IN 47405 BL027 SWAIN WEST 729 E 3RD ST, BLOOMINGTON, IN 47405 BL070 SIMON HALL 212 S HAWTHORNE DR, BLOOMINGTON, IN 47405

CLIENT PROJECT NO. - 20240397

BIDDING SET JANUARY 9, 2025

MARK	DATE	DESCRIPTION
3	01/29/25	ADDENDUM 3
2	01/27/25	ADDENDUM 2
1	01/17/25	ADDENDUM 1




BL072 CHEMISTRY -WATER RISER DIAGRAM

DATE BSALS PROJECT NO.

P402

© BSA LifeStructures I



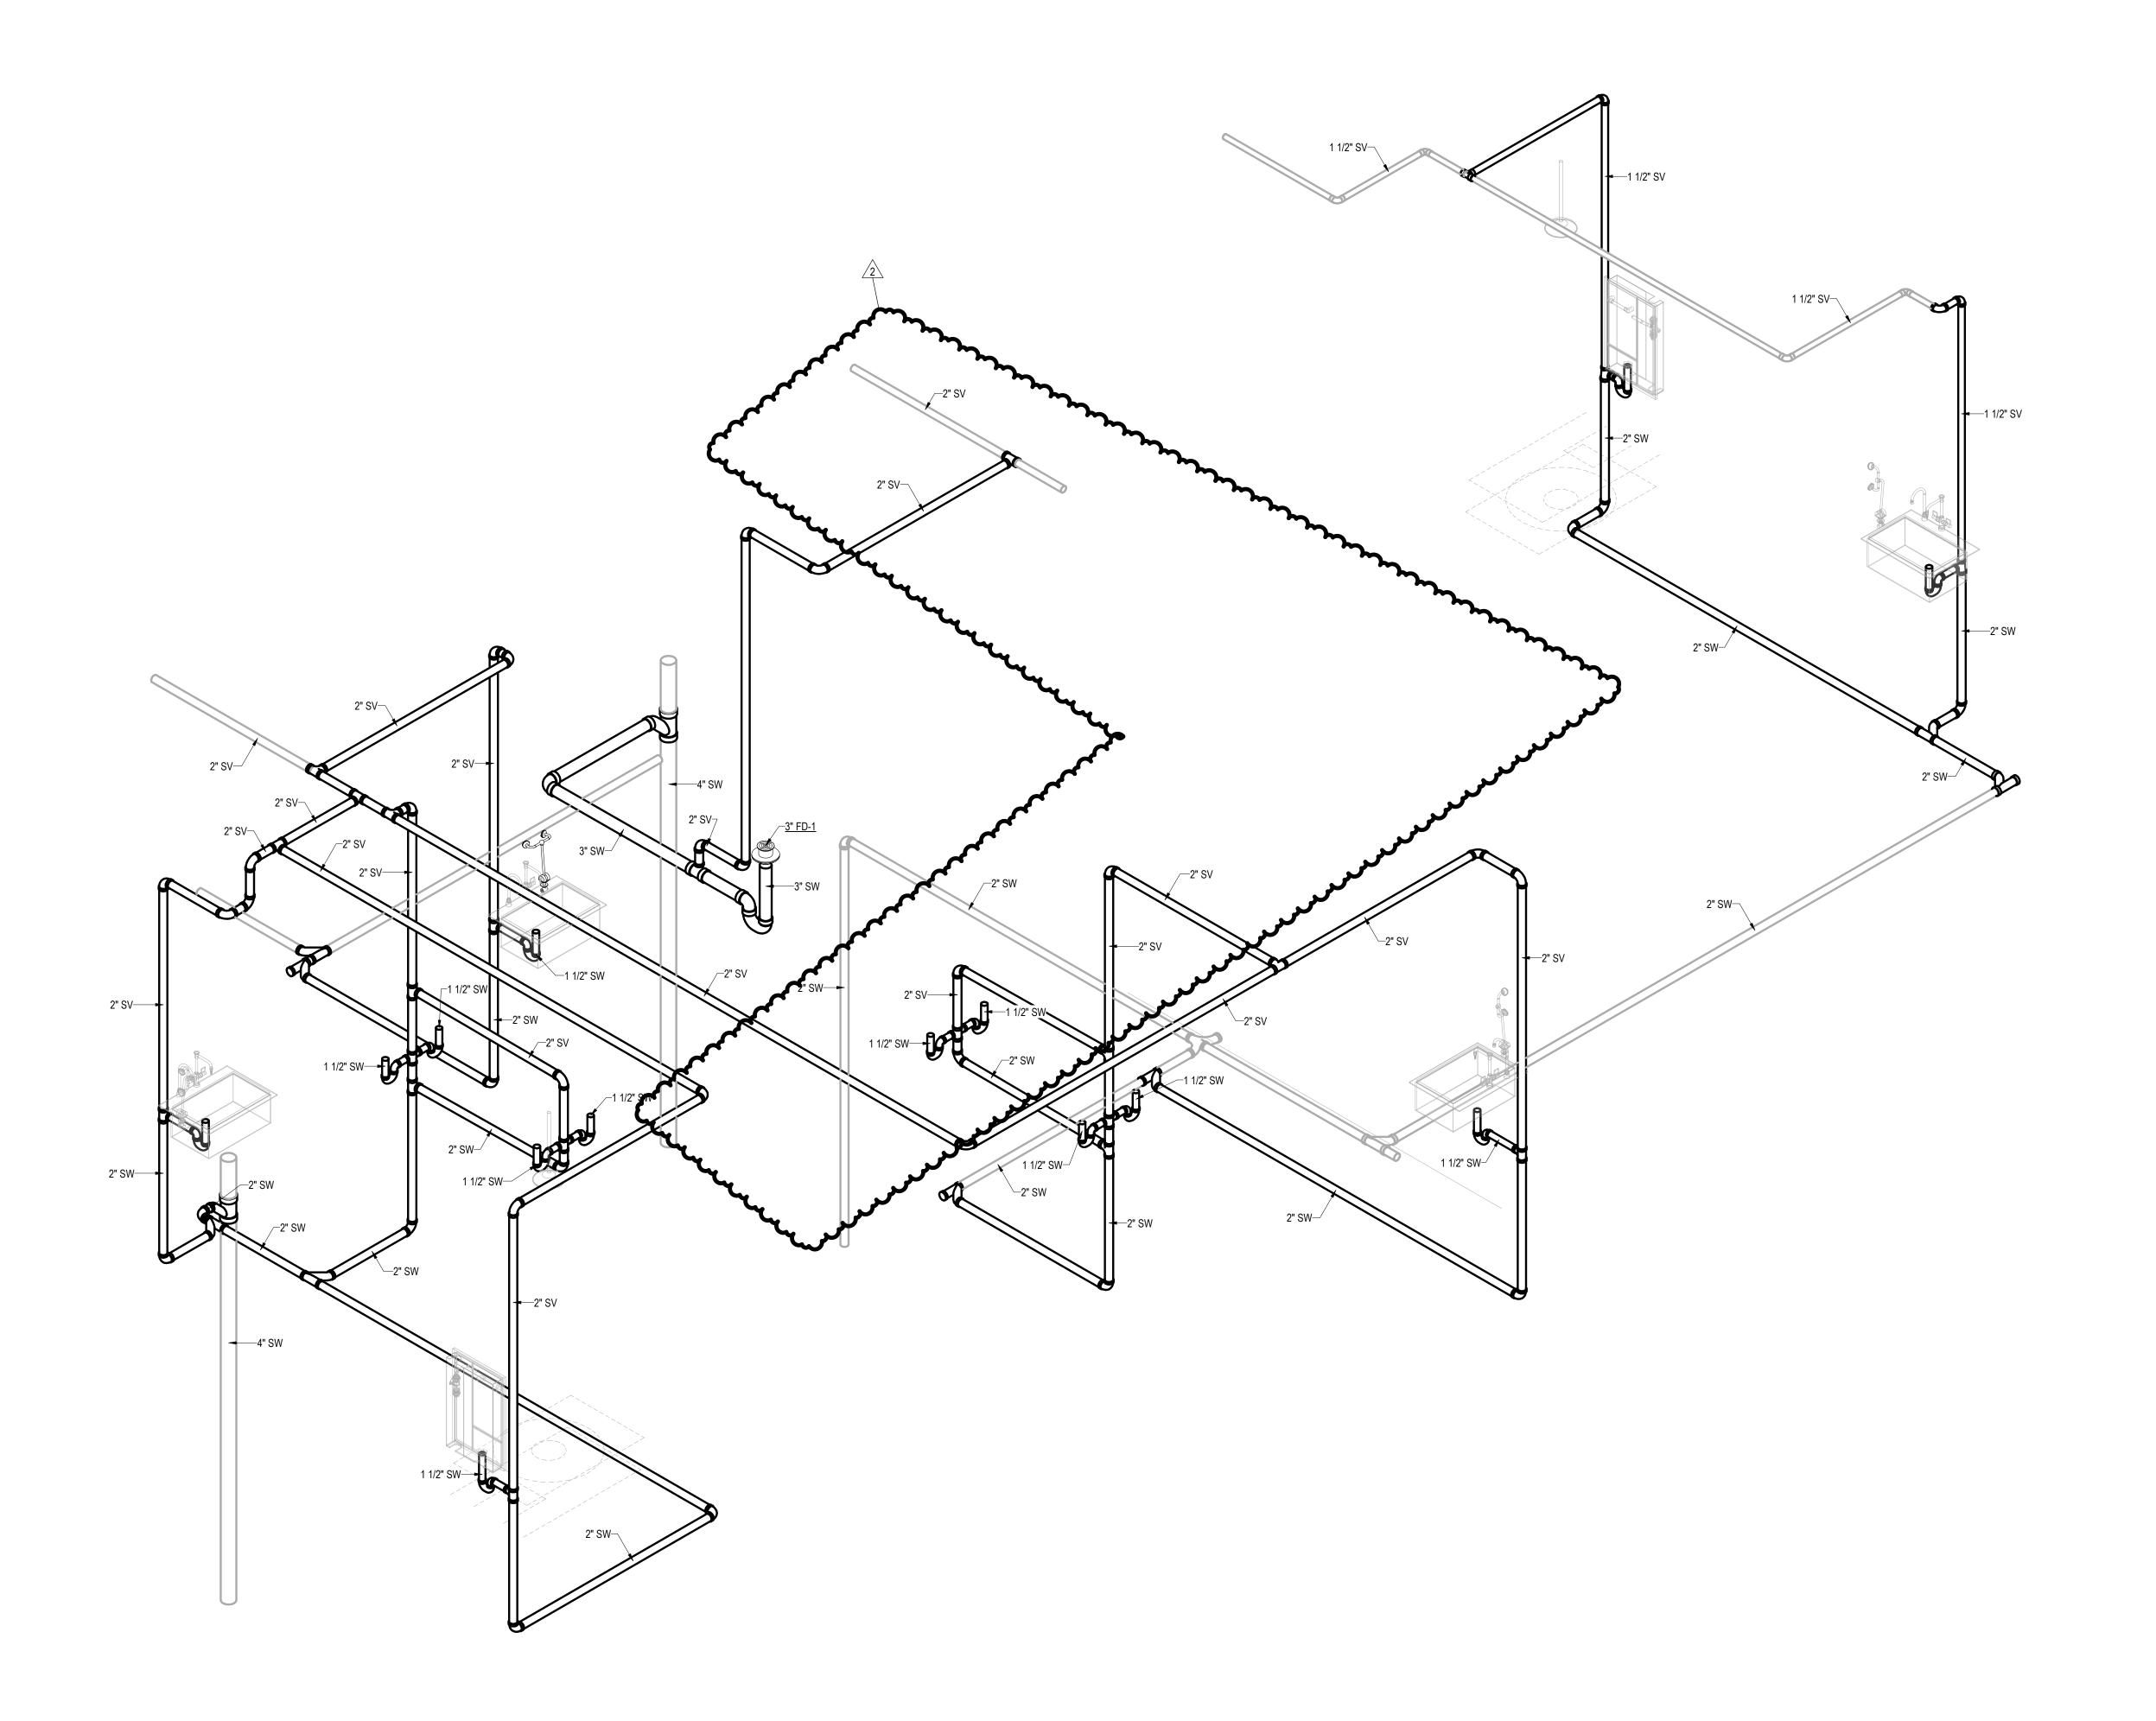

1 SANITARY RISER DIAGRAM A251/A252

## IUB RESEARCH LAB RENOVATIONS

BL072 CHEMISTRY
800 E KIRKWOOD AVE, BLOOMINGTON, IN 47405
BL027 SWAIN WEST
729 E 3RD ST, BLOOMINGTON, IN 47405
BL070 SIMON HALL
212 S HAWTHORNE DR, BLOOMINGTON, IN 47405

CLIENT PROJECT NO. - 20240397

BIDDING SET JANUARY 9, 2025


MARK	DATE	DESCRIPTION
3	01/29/25	ADDENDUM 3
2	01/27/25	ADDENDUM 2
1	01/17/25	ADDENDUM 1



BL072 CHEMISTRY -PLUMBING RISER DIAGRAM

DATE
BSALS PROJECT NO.

P403

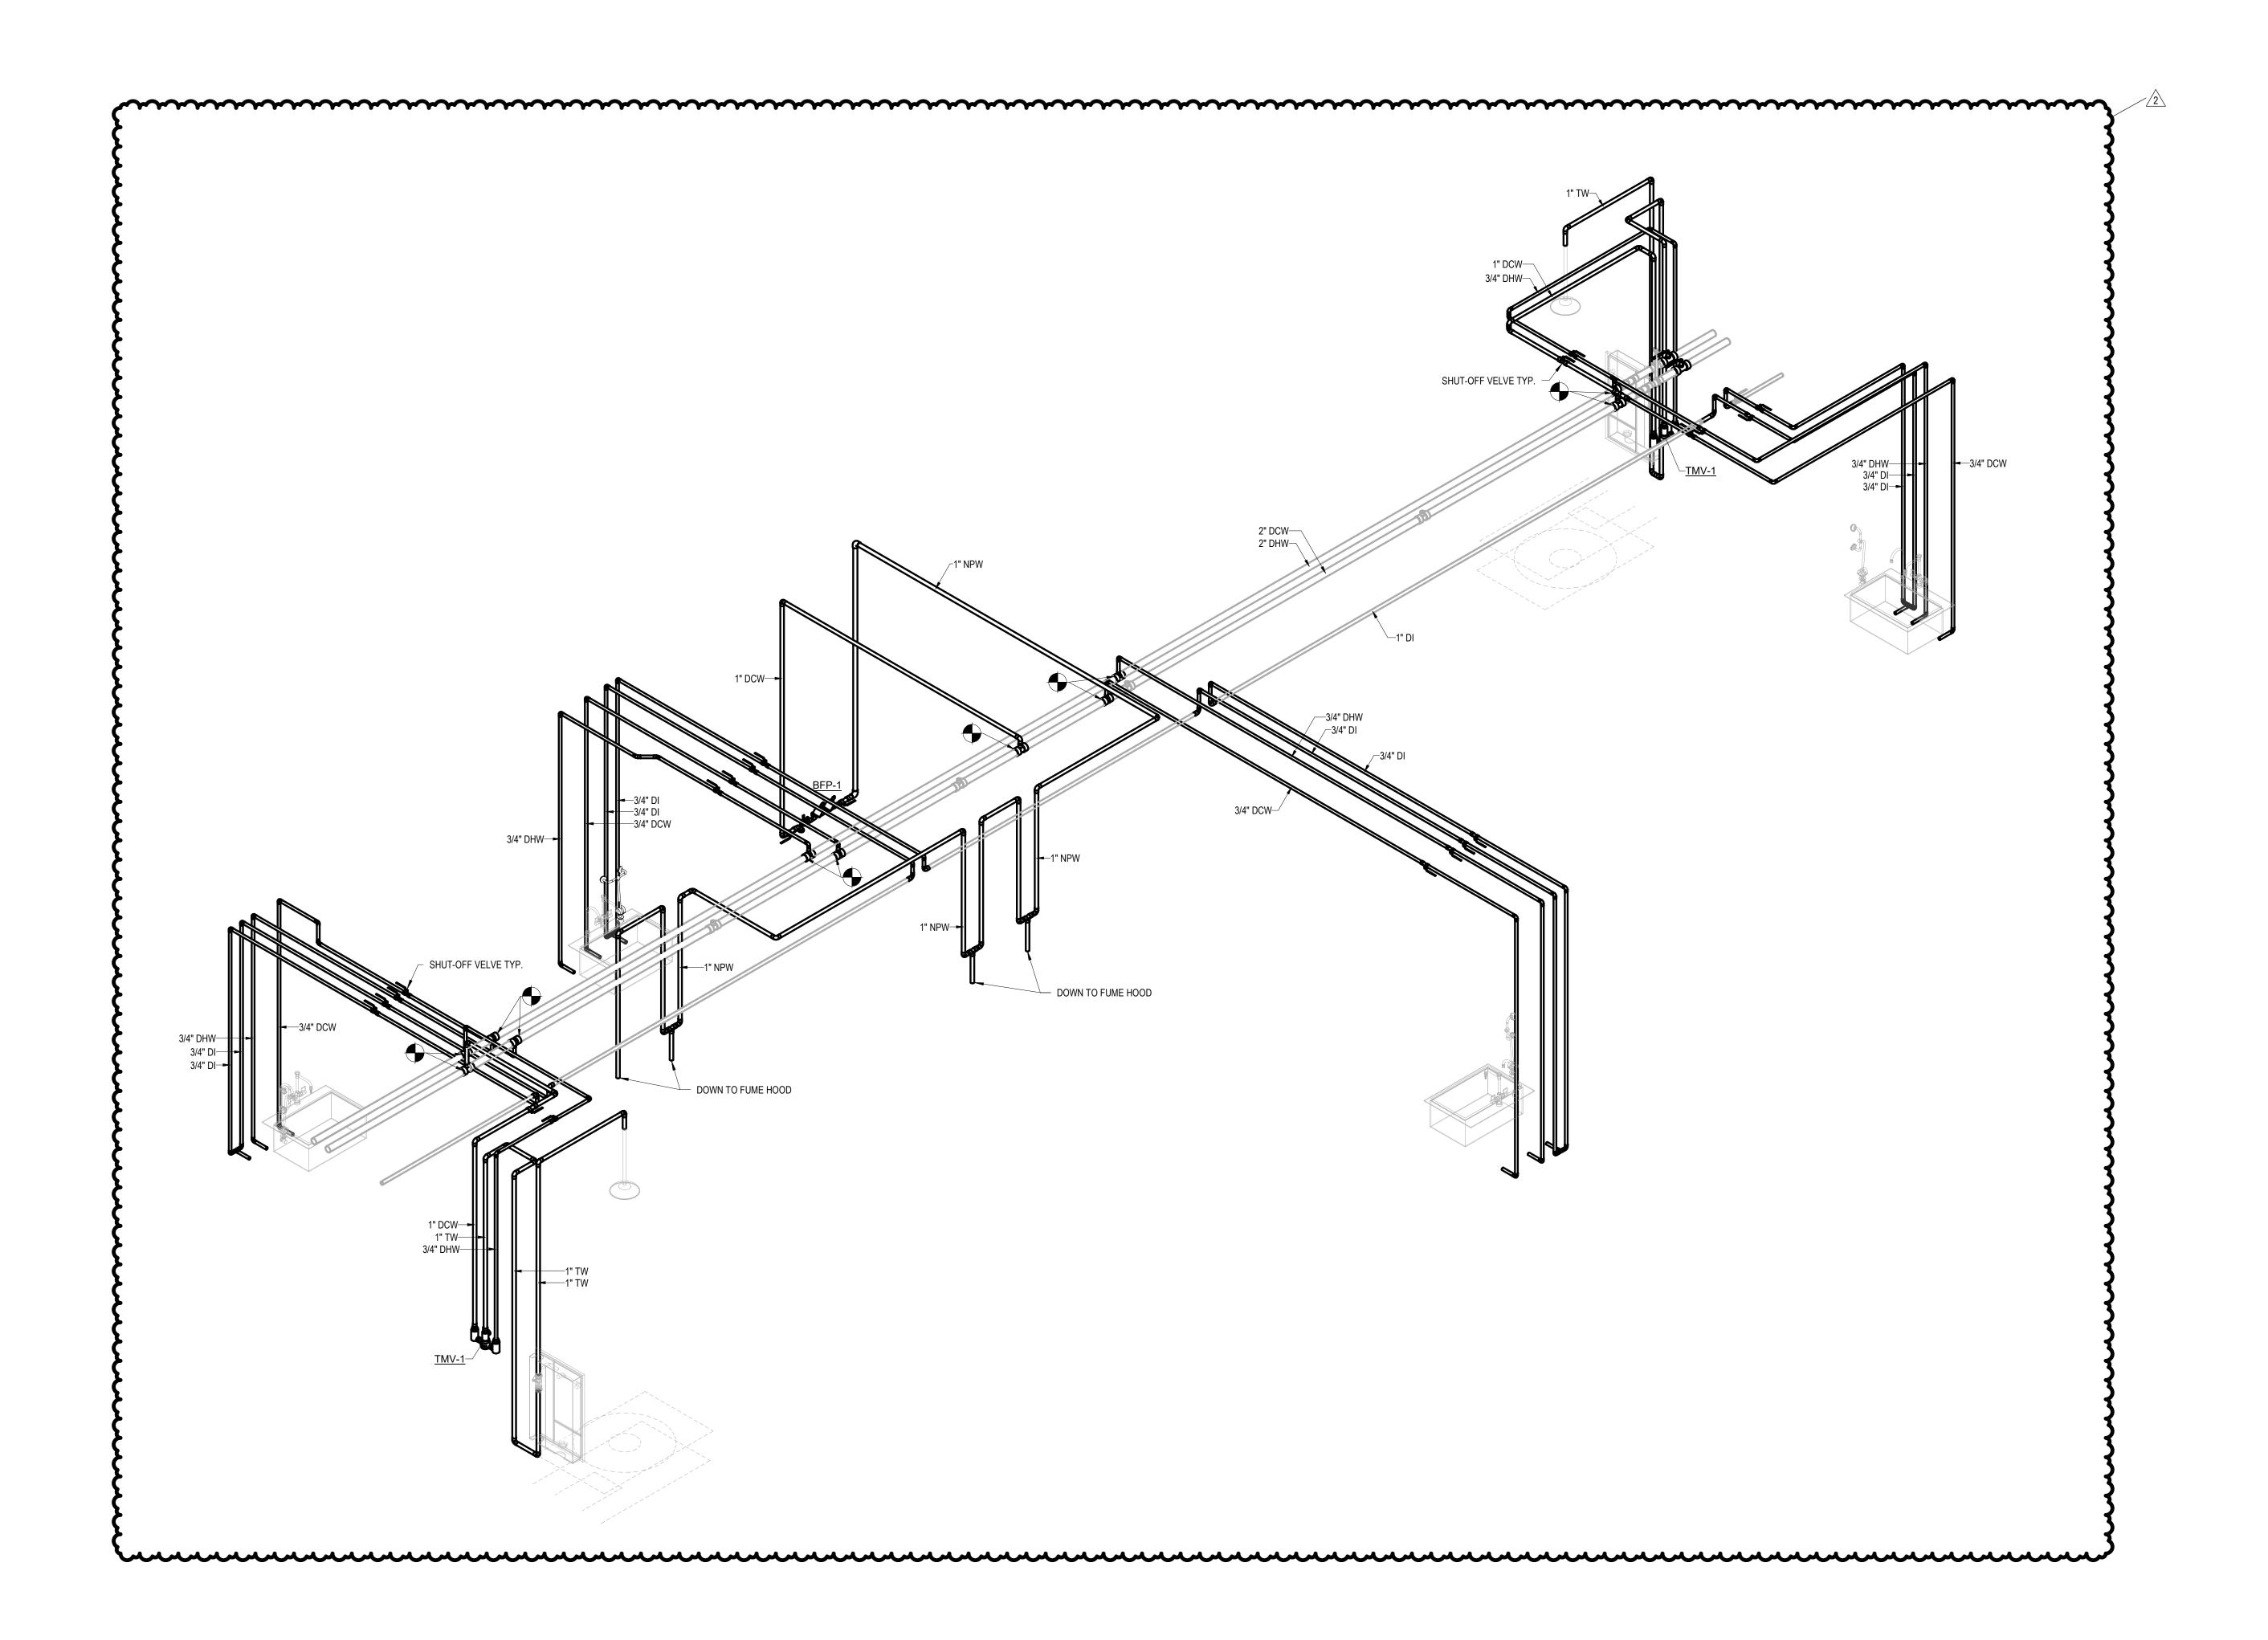

1 WATER RISER DIAGRAM - AREA A251/A25255



## IUB RESEARCH LAB RENOVATIONS

BL072 CHEMISTRY 800 E KIRKWOOD AVE, BLOOMINGTON, IN 47405 BL027 SWAIN WEST 729 E 3RD ST, BLOOMINGTON, IN 47405 BL070 SIMON HALL 212 S HAWTHORNE DR, BLOOMINGTON, IN 47405

CLIENT PROJECT NO. - 20240397

BIDDING SET JANUARY 9, 2025

MARK	DATE	DESCRIPTION
3	01/29/25	ADDENDUM 3
2	01/27/25	ADDENDUM 2
1	01/17/25	ADDENDUM 1




BL072 CHEMISTRY -PLUMBING RISER DIAGRAM

DATE JAN 1, 201?
BSALS PROJECT NO. 00360477

P404

© BSA LifeStructures Inc.



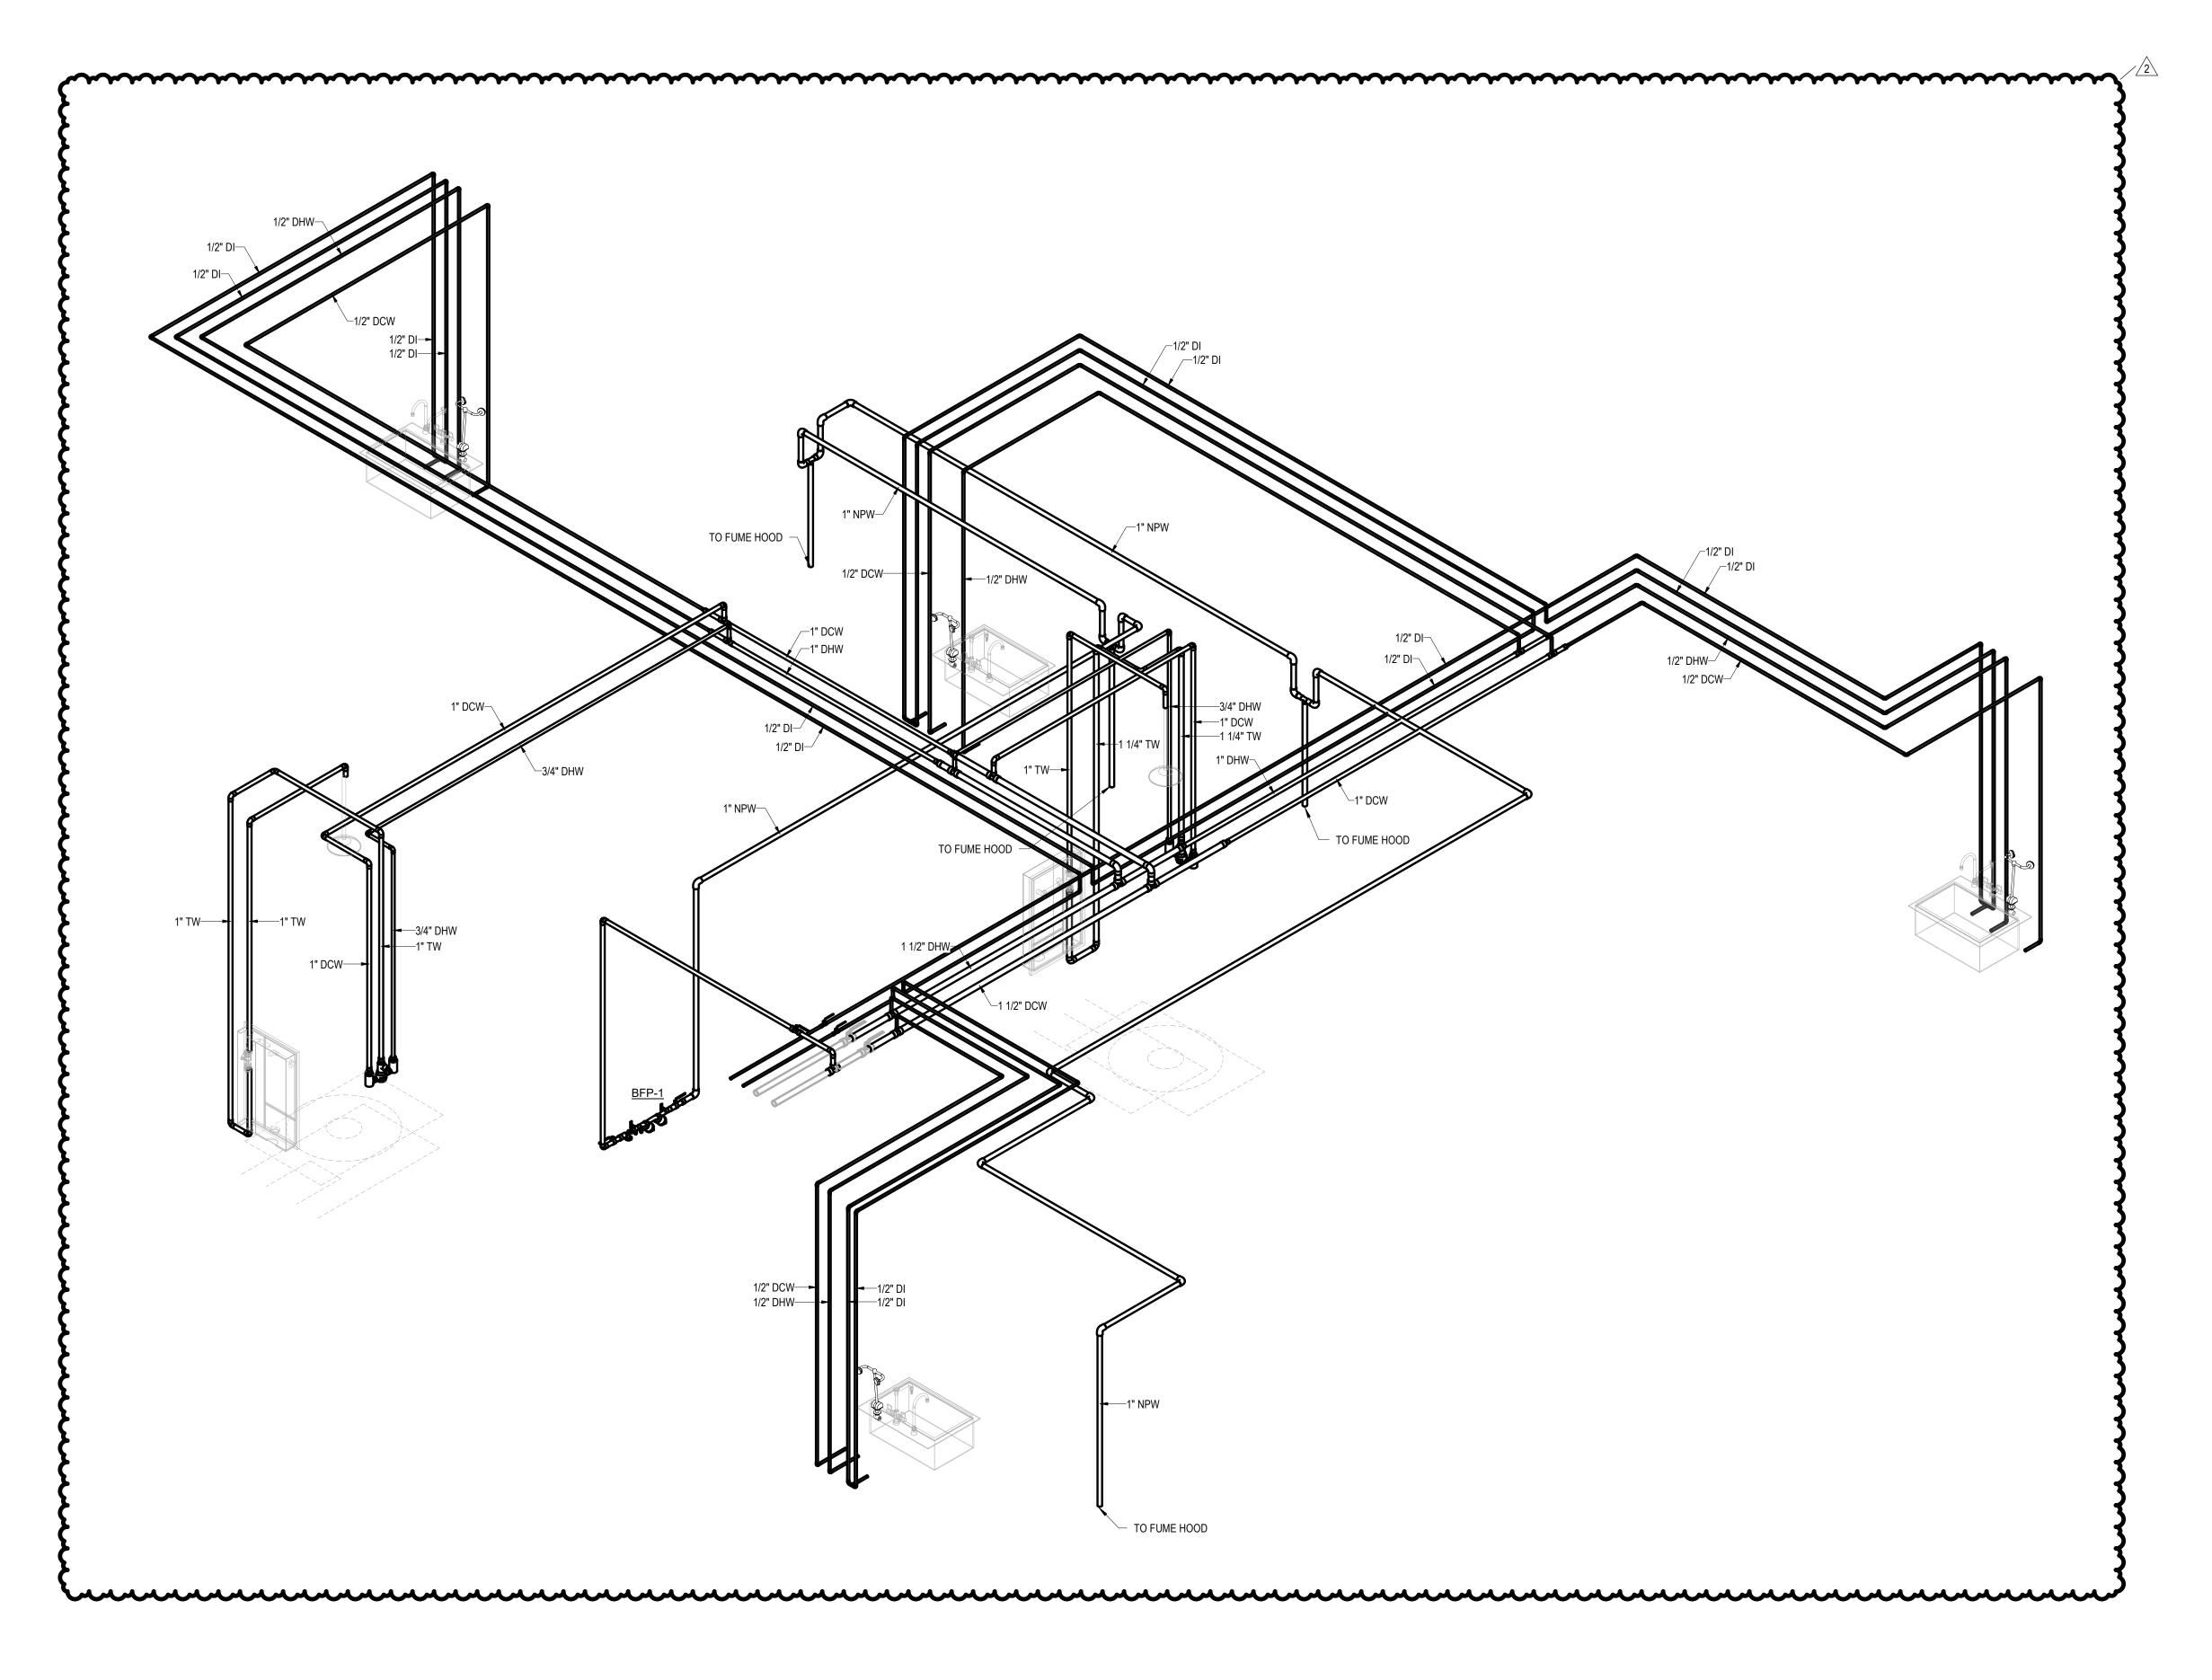

1 WATER RISER DIAGRAM - AREA 103/105


## IUB RESEARCH LAB RENOVATIONS

BL072 CHEMISTRY 800 E KIRKWOOD AVE, BLOOMINGTON, IN 47405 BL027 SWAIN WEST 729 E 3RD ST, BLOOMINGTON, IN 47405 BL070 SIMON HALL 212 S HAWTHORNE DR, BLOOMINGTON, IN 47405

CLIENT PROJECT NO. - 20240397

BIDDING SET JANUARY 9, 2025

MARK	DATE	DESCRIPTION
3	01/29/25	ADDENDUM 3
2	01/27/25	ADDENDUM 2
1	01/17/25	ADDENDUM 1

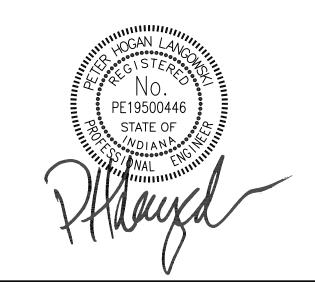


BL072 CHEMISTRY -PLUMBING RISER DIAGRAM

DATE BSALS PROJECT NO.

P406



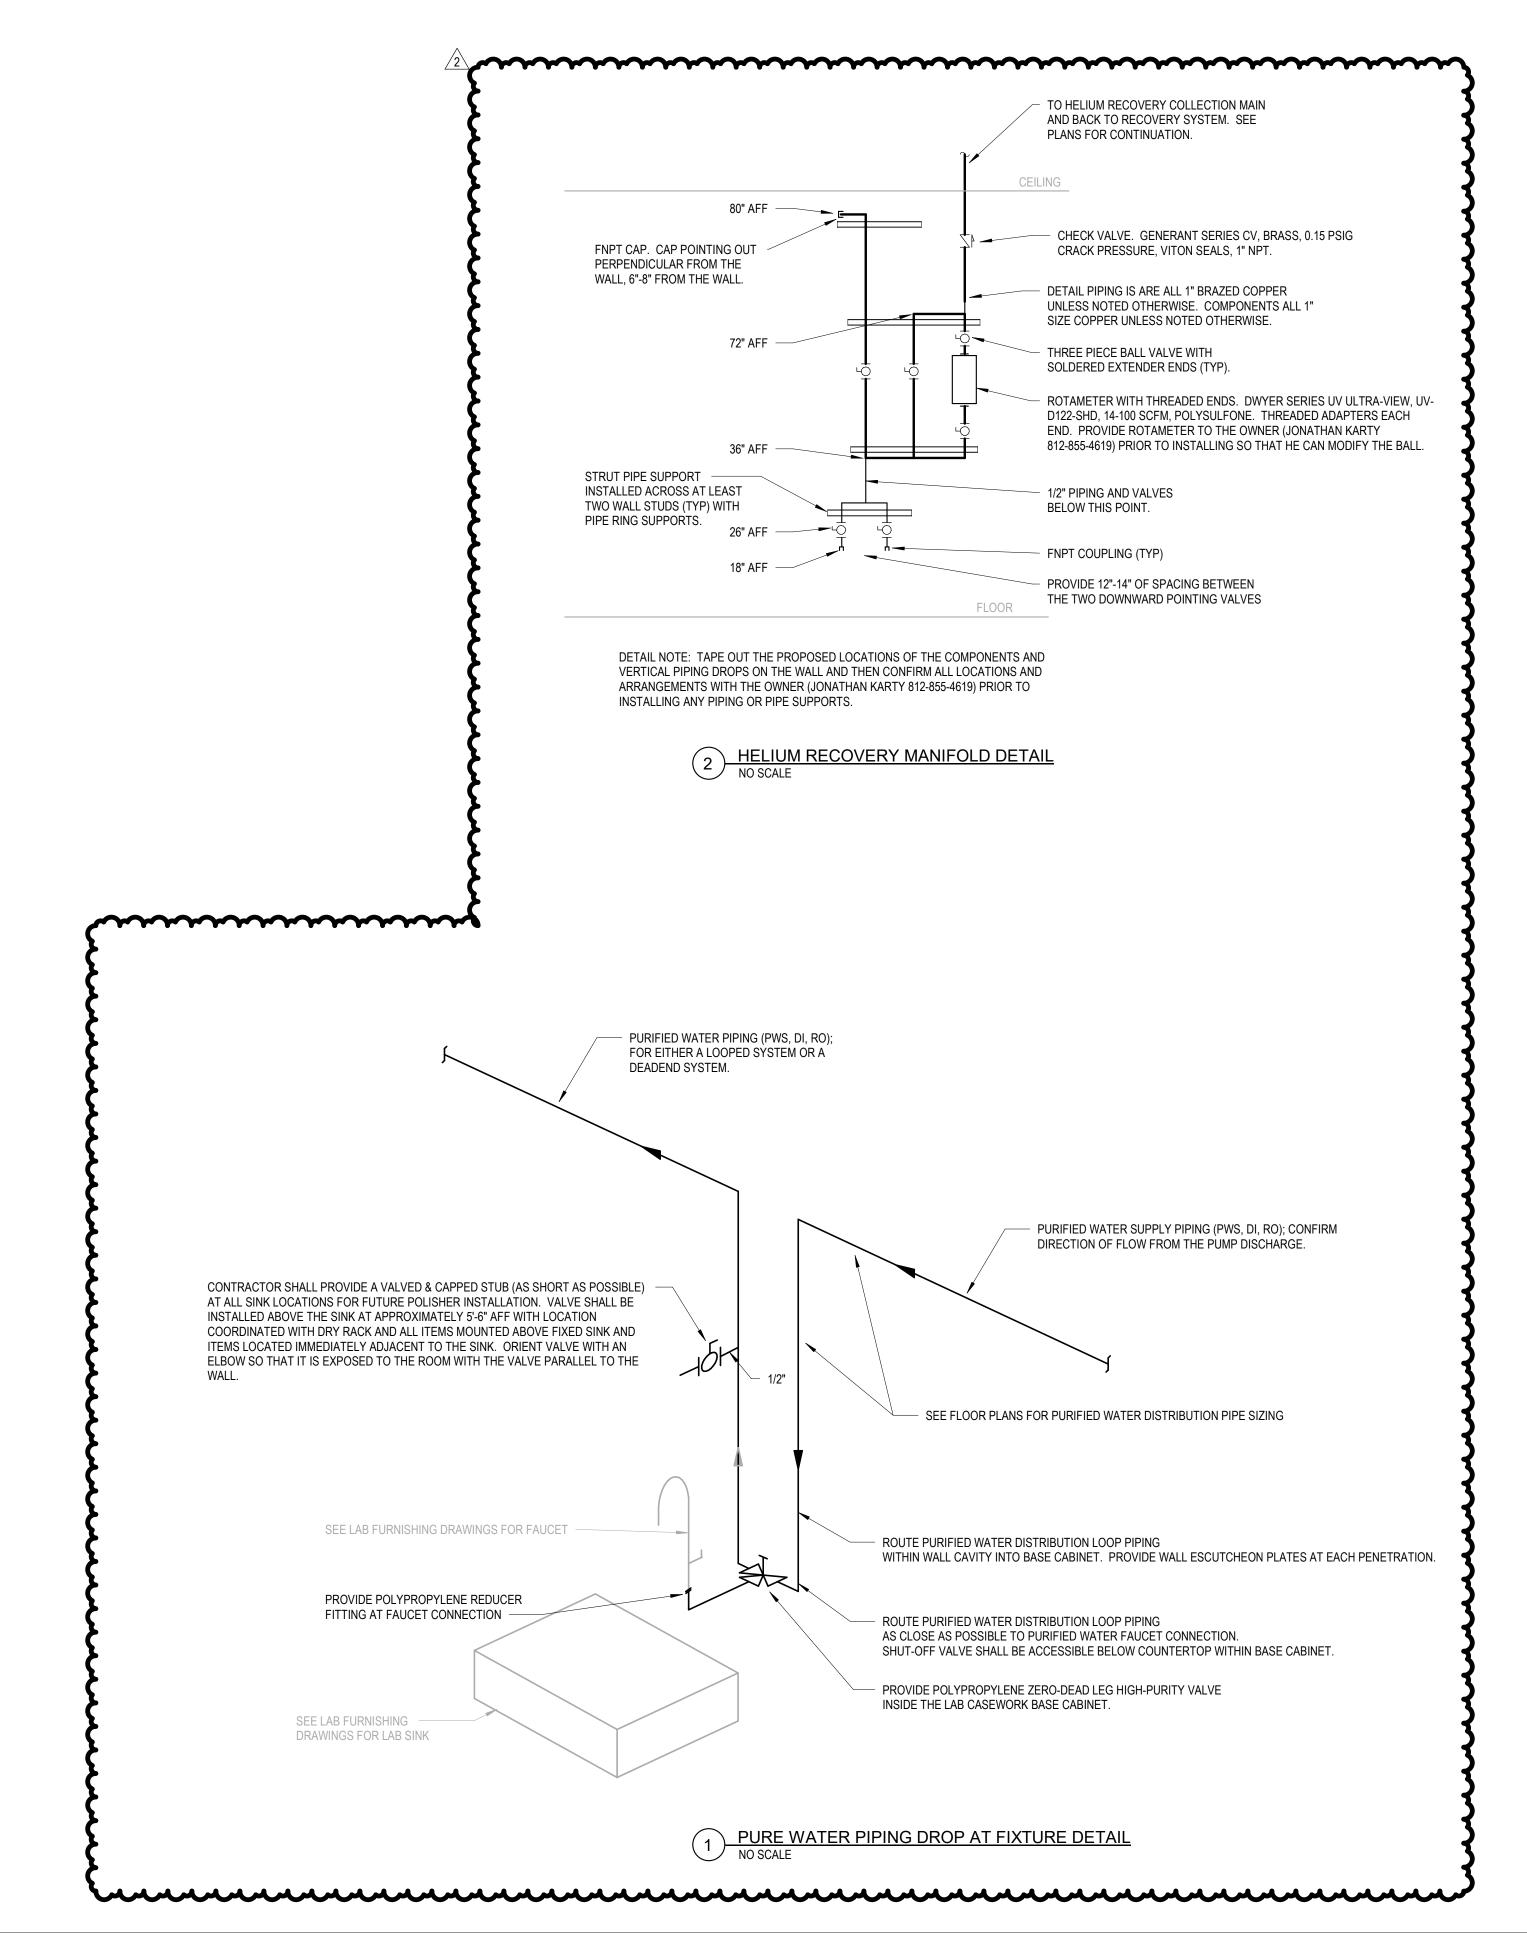


## IUB RESEARCH LAB RENOVATIONS

BL072 CHEMISTRY
800 E KIRKWOOD AVE, BLOOMINGTON, IN 47405
BL027 SWAIN WEST
729 E 3RD ST, BLOOMINGTON, IN 47405
BL070 SIMON HALL
212 S HAWTHORNE DR, BLOOMINGTON, IN 47405

CLIENT PROJECT NO. - 20240397

BIDDING SET JANUARY 9, 2025

MARK	DATE	DESCRIPTION
3	01/29/25	ADDENDUM 3
2	01/27/25	ADDENDUM 2
1	01/17/25	ADDENDUM 1

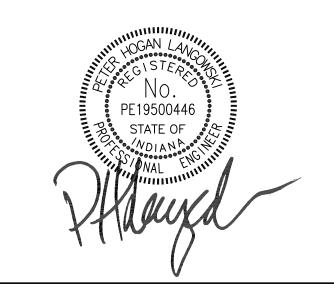

PLUMBING DETAILS

DATE	JAN 1, 2
BSALS PROJECT NO.	00360

P50

© BSA LifeStructure