ADDENDUM NUMBER TWO

.

To the Drawings and Project Manual Dated:

SEPT 29, 2025

Entitled:

Indiana University Launch Accelerator for Biosciences 1302 Indiana Ave. Indianapolis, IN 46202

Prepared By:

BSA 175 S. Rangeline Rd., Suite 200 Carmel, IN 46032

Addendum Dated: OCT 21, 2025

IU Project #: 20250072 BSALS Project #: 00360481

CONTRACTOR QUESTIONS

1. See attached list of bidder questions with design team responses.

CHANGES TO THE PROJECT MANUAL

2. Section 316000

a. In Part 3, 3.1-B, the allowable bearing pressure should read 6000 PSF in lieu of 5000 PSF.

CHANGES TO THE DRAWINGS

3. Sheet C110

- a. Revise the project narrative under section A3 as shown on the clouded portion of the attached revised drawing.
- b. Revise the references to the BMP to indicate a Storm Settler SSET-6 unit in sections C2 and C3 as shown on the clouded portion of the attached revised drawing.

4. Sheet C300

- a. Revise the spot grades in the entry plaza area as shown on the clouded portion of the attached revised drawing.
- b. Revise the stoop locations for the doors as shown on the clouded portion of the attached revised drawing.

5. Sheet C310

a. Revise the diversion structure detail as shown on the clouded portion of the attached revised drawing.

6. Sheet C400

- a. Revise the gas meter location as shown on the clouded portion of the attached revised drawing.
- b. Revise note #28 as shown on the clouded portion of the attached revised drawing.

7. Sheet C500

- a. Revise the MEP yard layout as shown on the clouded portion of the attached revised drawing.
- b. Add speed tables at pedestrian crossings as shown on the clouded portion of the attached revised drawing.
- c. Revise the notes as shown on the clouded portion of the attached revised drawing.

8. Sheet C510

a. Add the concrete speed table detail as shown on the clouded portion of the attached revised drawing.

9. Sheet LA100

a. Replace sheet

10. Sheet Figure 1

a. Replace Sheet

11. Sheet Figure 2

- a. Replace Sheet
- 12. Sheet Figure 3
 - a. Replace Sheet
- 13. Sheet Figure 4
 - a. Replace Sheet
- 14. Sheet Figure 5
 - a. New Sheet
- 15. Sheet Figure 6
 - a. New Sheet
- 16. Sheet Figure 7
 - a. New Sheet
- 17. Sheet Figure 8
 - a. New Sheet
- 18. Sheet Figure 9
 - a. New Sheet
- 19. Sheet Figure 10
 - a. New Sheet
- 20. Sheet Figure 11
 - a. New Sheet
- 21. Sheet S007
 - a. Add base plate detail TYPE 7 for a round column as shown on the clouded portion of the attached revision drawing.
- 22. Sheet S110A
 - a. Add footing steps along the west face of the building to accommodate a water line, per the clouded portion of the attached revision drawing.
 - b. Add a row to the base plate schedule for the 24 inch diameter column as shown on the clouded portion of the attached revision drawing.
- 23. Sheet S110B
 - a. Modify column sizes at C.4/15 and D15 as shown on the clouded portion of the attached revision drawing.

END OF ADDENDUM NUMBER TWO

Attachments: C110, C300, C310, C400, C500, C510, LA100, Figure 1 through 11, S007, S110A, S110B, Bidder RFI responses

•

PROJECT LOCATION

LAT: 39.7848094 LONG: -86.1811584

OWNER'S INFORMATION

P.K. Patel Indiana University Director of Engineering ppatel@indiana.edu

OPERATOR'S INFORMATION

(812) 855-7894

Todd France F.A. Wilhelm 3914 Prospect Street Indianapolis, IN 46203

(317) 524-9025

toddfrance@fawilhelm.com

NOTICE OF INTENT

All parties defined as owners must submit a Notice of Intent (NOI) at least 48 hours prior to commencement of on-site construction activities. Submittal of late NOI's is not prohibited; however, authorization under the construction general permit is only for discharges that occur after permit coverage is granted. Unpermitted discharges may be subject to enforcement actions by the EPA. For the purposes of this permit, an owner is defined as any party meeting either of the following requirements

- 1) The party has operational control over the construction plans and specifications, including the ability to make modifications to those plans and specifications.
- 2) The party has day-to-day operational control of those activities at a project that are necessary to ensure compliance with a stormwater pollution prevention plan

A1 - INDEX OF LOCATION OF REQUIRED PLAN ELEMENTS

for the site or other permit conditions.

Refer to this sheet for the location of all required plan elements. Included for reference is the construction drawing sheet list for location of specific plan items

3	SHEET #	SHEET NAME
	1 of 2 & 2 of 2	ATLA//NSPS LAND TITLE SURVEY
	C001	PROJECT INFORMATION SHEET
	C100's	STORMWATER POLLUTION PREVENTION PLANS
	C110	STORMWATER POLLUTION PREVENTION NOTES
	C200	SITE DEMOLITION PLAN
	C300's	SITE GRADING & DRAINAGE PLAN
	???	SITE IMPROVEMENT PLAN
	???	SITE LANDSCAPE PLAN
,		

A2 - VICINITY MAP


Refer to Project Information Sheet - Sheet C001

ne project consists of the construction a new building (Launch Accelerator for Bioscience), new parking, green space and A BMP Storm Settler SSET-6, nanufactured by Storm Trap. Strormwater runoff fro the site will drain to the Indianapolis storm sewer system then ultimately to Fall Creek.

LAT: 39.7848094 LONG: -86.1811584 A5 - LEGAL DESCRIPTION OF THE PROJECT SITE

16 NORTH

A6 - 11X17-INCH PLAT SHOWING BUILDING LOT NUMBERS/BOUNDARIES AND ROAD LAYOUT/NAMES

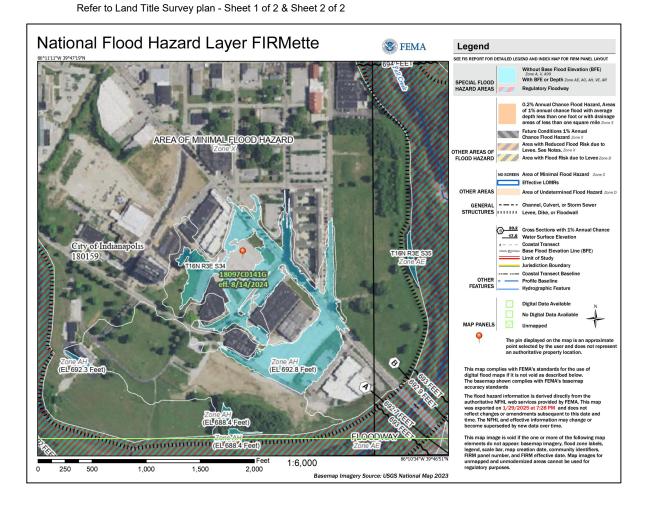

A8 - LAND USE OF ALL ADJACENT PROPERTIES

South: Manufacturing Building

Higher Educational Building A9 - IDENTIFICATION OF A U.S. EPA APPROVED OR ESTABLISHED TMDL

Fall Creek Escherichia Coli (E. coli), Pathogens TMDL 2004-03-31


A10 - IDENTIFICATION OF ALL RECEIVING WATERS

Fall Creek. City of Indianapolis storm sewer system. A11 - IDENTIFICATION OF DISCHARGES TO A WATER ON THE CURRENT 303(d) LIST OF IMPAIRED WATERS AND POLLUTANT(S) FOR WHICH

Fall Creek Discharge: E.Coli, PCBs

A12 - A SOILS MAP OF THE PREDOMINATE SOIL TYPES

Urban Land Genesee Complex soils are well drained, have seasonal high watertable at 4.0 to 6.0 ft and are on floodplains. Slopes are0 to 2 percent. The native vegetation is hardwoods. The surface layer is silt loam and has moderate organic matter content (2.0 to 4.0 percent). Permeability is moderate (0.6 to 2 in/hr) in the most restrictive layer above 60 inches. Available water capacity is high (11.6 inches in the upper 60 inches). The PH of the surface layer in non-limed areas is 6.6 to 7.8. The flooding hazard is a management concerns for crop production. Because of the flooding hazard, this soil has a severe

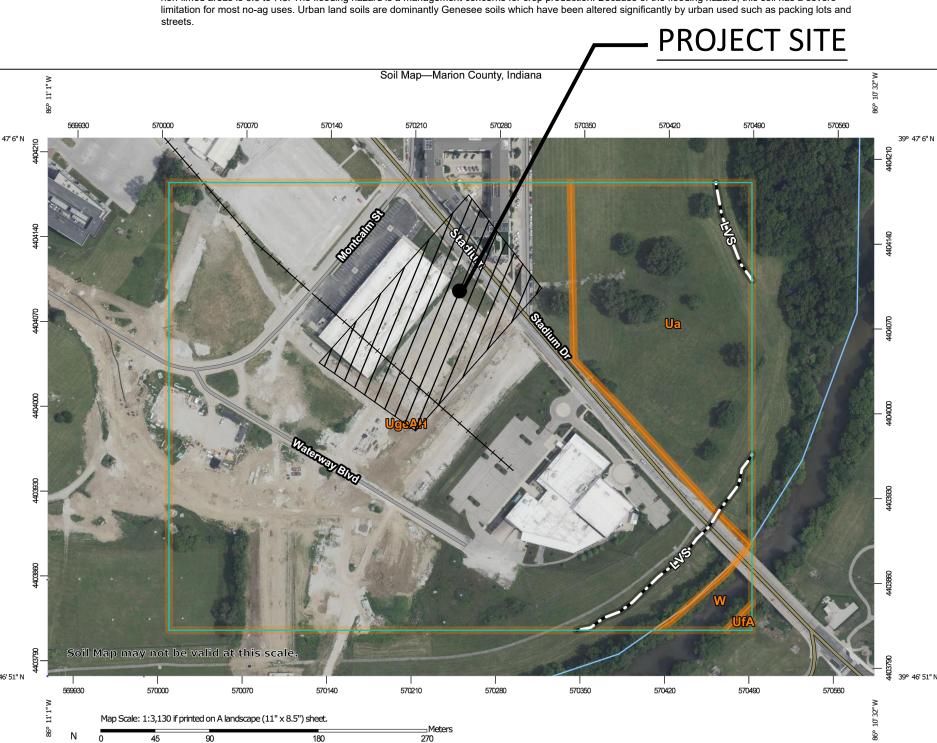

Map Unit Symbol Map Unit Name Acres in AOI Urban land-Genesee complex 0 to 2 percent slopes, frequently flooded, brief duration

Map projection: Web Mercator Corner coordinates: WGS84 Edge tics: UTM Zone 16N WGS84

A13 - IDENTIFICATION AND LOCATION OF ALL KNOW WETLANDS, LAKES, AND WATER COURSES ON OR ADJACENT TO THE PROJECT SITE No Wetlands have been identified on or adjacent to the site. Fall creek is located to the south and White River is located to the west of the site.

A14 - IDENTIFICATION OF ANY STATE OR FEDERAL WATER QUALITY PERMITS OR AUTHORITIES THAT REQUIRED FOR CONSTRUCTION ACTIVITIES Indiana Department of Environmental Management (IDEM) - Construction Stormwater General Permit (CSGP)

A15 - IDENTIFICATION AND DELINEATION OF EXISTING COVER, INCLUDING NATURAL BUFFERS

Approximate area of existing vegetative cover are as shown on the Topographic Survey plan - Sheet 1 of 2 & Sheet 2 of 2 and Demolition Plan C200. The site includes open lot with grass and gravel.

A16 - EXISTING SITE TOPOGRAPHY AT INTERVAL APPROPRIATE TO INDICATE DRAINAGE PATTERNS Refer to Topographic Survey plan - Sheet 1 of 2 & Sheet 2 of 2

A17 - LOCATION(S) WHERE RUN-OFF ENTERS THE PROJECT SITE See general areas where run-off enters the site on Site Grading & Drainage Plan. Refer to C300.

A18 - LOCATION(S) WHERE RUN-OFF DISCHARGES FROM THE PROJECT SITE PRIOR TO LAND DISTURBANCE

Refer to Topographic plan - Sheet 1 of 2 & Sheet 2 of 2. Existing stormwater runoff from the site drains into the Indianapolis storm sewer system then

A19 - LOCATION OF ALL EXISTING STRUCTURES ON THE PROJECT SITE

Refer to Topographic plan - Sheet 1 of 2 & Sheet 2 of 2

A20 - EXISTING PERMANENT RETENTION OR DETENTION FACULTIES, INCLUDING MANMADE WETLAND, DESIGNED FOR THE PURPOSE OF STORMWATER MANAGEMEN

Refer to Topographic Survey plan - Sheet 1 of 2 & Sheet 2 of 2. A21 - LOCATION WHERE STORMWATER MAY BE DIRECTLY DISCHARGED INTO GROUND WATER SUCH AS ABANDONED WELLS, SINKHOLE, OR KARST FEATURES

N/A A22 - SIZE OF THE PROJECT AREA EXPRESSED IN ACRES

3.27 Acres.

A23 - TOTAL EXPECTED LAND DISTURBANCE EXPRESSED IN ACRES

2.89 Acres.

A24 - PROPOSED FINAL TOPOGRAPHY

Refer to Grading and Drainage Plan, Sheet C300. A25 - LOCATION AND APPROXIMATE BOUNDARIES OF ALL DISTURBED AREAS

Approximate boundaries of disturbed areas are as identified on the Stormwater Pollution Prevention Plan, Sheet C100.

A26 - LOCATION, SIZE AND DIMENSIONS OF ALL STORMWATER DRAINAGE SYSTEM SUCH AS CULVERTS, STORMWATER SEWER, AND CONVEYANCE

Location and size of stormwater systems. Refer to Grading and Drainage Plan, Sheet C300

A27 - LOCATION, OF SPECIFIC POINTS STORMWATER AND NON-STORMWATER DISCHARGES WILL LEAVE THE PROJECT SITE. Refer to Grading and Drainage Plan, Sheet C300. Stormwater will dischare to the City of Indianpolis storm sewer, then to Fall Creek. There areno proposed

non-storm discharges from the site. A28 - LOCATION OF ALL PROPOSED SITE IMPROVEMENTS, INCLUDING ROADS, UTILITIES, LOT DELINEATION AND IDENTIFICATION, PROPOSED STRUCTURES AND COMMON AREAS.

Refer to Site Improvement Plan, Sheet C500.

A29 - LOCATION, OF ALL ON-SITE AND OFF-SITE SOIL STOCKPILES AND BORROW AREAS

Excess soil shall be immediately stockpiled, surrounded with silt fence, and seeded where indicated in grading plan in accidence with all applicable laws. No topsoil stockpiles are anticipated for this project. All demolished materials and excavated soils shall be removed and legally disposed of off-site at a commercial landfill at the end of construction unless noted otherwise.

A30 - CONSTRUCTION SUPPORT ACTIVITIES THAT ARE EXPECTED TO BE PART OF THE PROJECT. Construction Entrance Stone, Construction Entrance Mat, Concrete Cleanout, Silt Fence, Inlet Protection, Dewatering Bag, Construction Storage Area and Soil

A31 - LOCATION, OF ANY IN-STREAM ACTIVITIES THAT ARE PLANNED FOR THIS PROJECT INCLUDING BUT NO LIMITED TO STREAM CROSSINGS AND

No in-stream activities are planned for this project.

 $\frac{\text{B1 - DESCRIPTION OF THE POTENTIAL POLLUTANT GENERATING SOURCES AND POLLUTANTS INCLUDING}{\text{ALL POTENTIAL NON-STORMWATER DISCHARGES:}}$

Material storage areas Construction waste material

Fuel storage areas and fueling areas

_eaking Vehicles and equipment Sanitary waste from temporary toilet falsities

Soil tracking off site from construction equipment

The following materials may be staged or stored on site at various points during construction.

Structural backfill Pavement base stone

HDPE, PVC, RCP, or Ductile iron pipe Precast concrete, HDPE, or PVC drainage and sanitary structures

PERMANENT SURFACE STABILIZATION SPECIFICATIONS

Staging of existing decorative stone from existing rain gardens through coordination of the MS4

B2 - STABLE CONSTRUCTION ENTRANCE LOCATIONS AND SPECIFICATIONS

Construction entrance will be in place prior to any site construction demolition. Entrances are shown on the Erosion Control Plan. Refer to Erosion Control Plans

for Dentils, installation and maintenance specifications.

B3 -SPECIFICATION FOR TEMPORARY AND PERMANENT STABILIZATION TEMPORARY SURFACE STABILIZATION SPECIFICATIONS Surface stabilization is required on any bare or thinly vegetated areas. Temporary surface stabilization must follow the Construction Stormwater General Permit

3.4 Stabilization Requirement - for temporary stabilization, stabilization must be initiation by the end of the seventh day for areas left idle. Stabilization activity must be completed within 14 days after initiation

1. Loosen lawn area to a minimum depth of 6 inches. Mix soil amendments and fertilizers with topsoil at rates specified. Organic soil amendments such as peat, compost, or manure shall be applied at 2" depth evenly over soil and incorporated into the top 6" If topsoil. Provide fertilizer with percentage of

nitrogen required to provide not less than 1 pound of actual nitrogen per 1,000 square feet of lawn area and not less that 4 percent phosphoric acid and 2 percent potassium. At least 50 percent of nitrogen to be organic form. Delay mixing of fertilizer if planting will not follow placing of planting soil within a few

2. Fertilizer for lawns: provide a fast release fertilizer with a composition of 1 lb per 1,000 spare feet of actual nitrogen, 4 percent phosphorous, and 2 percent potassium by weight.

3. Slow-release fertilizer for trees and shrubs: granular fertilizer consisting of 50 percent water-insoluble nitrogen, phosphorous and potassium made up of a composition by weight of 5 percent.

4. Grade lawn and grass areas to a smooth, even surface with loose, uniformly fine texture. Limit fine grading to areas that can be planted within immediate future. Remove trash, debris, stones larger than 1 inch diameter, and other objects that may inter with planting or maintenance operations. Sow seed

using a spreader of seeding machine. Do not seed when wind velocity exceeds 5 miles per hour. Distribute seed evenly over entire area by sowing equal quantity in 2 directions at right angles to each other.

Rake seed lightly into top $\frac{1}{8}$ inch of soil, roll lightly, and water with a fine spray. Install erosion control blankets as indicated on the Erosion Control Plan. Protect seeded areas against erosion by spreading clean, seed-free straw mulch after completion of spreading operations. Spread uniformly to form a

continuous blanket not less that 1-1/2 inches loose measurements over seeded areas. 9. Water newly planted lawn areas and keep moist until new grass is established. Immediately repair any lawn areas disturbed by construction activities

10. Refer to the Permanent Seeding Details within the Erosion Control Detail Sheet, for timing of permanent seeding, grass seed specifications and mulching 11. In areas to get landscape beds apply mulch in lieu of seeding. Mulch is to be properly anchored or covered with blanket. Refer to C110 for installation,

B4 - SEDIMENT CONTROL MEASURES FOR CONCENTRATED FLOW AREAS

B5 - SEDIMENT CONTROL MEASURES FOR SHEET FLOW AREAS

maintenance, and specification.

Some run-off is proposed across the parking lot which will transition into a shallow concentrated flow profile after 100ft of distance but still in a sheet flow across the parking lot. No swales are proposed. Silt fence is to be installed at edge of parking lot before entering the detention basin. Inlet protection measures will also be installed in all inlets in the parking lot. Refer to Stormwater Pollution Prevention Plan for locations and C111 for specifications, installation, and maintenance

Sheet flow areas will be protected by seed and mulch or hydro seeding. Erosion control blankets will be installed on sloped areas where the slope exceeds 4:1 (horizontal to vertical). Silt fencing will be utilized to prevent sedimentation from leaving the site. Refer to the Stormwater Pollution Prevention Plan for locations and C111 for specifications, installation, and maintenance procedures.

B6 - RUNOFF CONTROL MEASURES A permanent underground stormwater detention system is proposed .

B7 - STORMWATER OUTLET PROTECTION MEASURES

The detention system will discharge directly into the city storm sewer.

B8 - GRADE STABILIZATION STRUCTURE LOCATIONS Silt fence will be installed around the perimeter of the site.

B10 - MEASURES UTILIZED FOR WORK WITHIN WATERBODIES:

B9 - DEWATERING APPLICATIONS AND MANAGEMENT METHODS:

1. Shall not cause erosion from the discharge. Dewatering water shall discharge to stable, erosion- resistant surfaces, such as but not limited to, clean stone

or well-vegetated grassy areas; Shall not have a discharge with a visible sheen, foam, and/or pollutants at a level that requires additional treatment and/or an alternate permit; Shall route dewatering water through a sediment control (e.g., sediment trap or basin, pumped water filter bag) designed to prevent discharges with visual

4. Shall not be placed on steep surfaces: and 5. Shall not use the receiving water or MS4 as part of the treatment area.

B11 - MAINTENANCE GUIDELINES FOR EACH PROPOSED STORMWATER QUALITY MEASURE: Refer to sheets C111 for specifications, installation, & maintenance procedures for proposed maintenance guides for stormwater quality measures including silt

fence, inlet basket, concrete washout, rip-rap outlet protection, mulching, and construction entrance All impacted areas, as well as all erosion and sediment control devices, will be inspected every seven (7) calendar days and within 24 hours after a rianfall of 0.5 inch or greater. Where sites have been final or temporarily stabilized or on sites where runoff is unlikely due to winter conditions (e.g. site is covered with snow, ice, or frozen ground exists), such inspections shall be conducted at least once every month.

Inspections shall be conducted and a written report prepared, by a designated and qualified person familiar with the USEPA NPDES Storm Water General Permit, this SWPPP, and the Project.

Inspection reports shall be completed including scope of the inspection, name(s) and qualifications of personnel making the inspection, the date of the inspection, observations relating to the implementation of the SWPPP, and any actions taken as a result of incidents of noncompliance noted during the inspection. The inspection report should state whether the site was in compliance or identify and incidents of noncompliance. The contractor shall keep a copy of the inspection reports on site and permanently for a period of two years following construction. The on-site reports may be requested by inspections conducted by the local governing authority.

Locations where vehicles exit the site shall be inspected for evidence of off-site sediment tracking daily. Each contractor and subcontractor shall be responsible for maintaining the Construction Entrance and other controls as described in this SWPPP.

Material Storage Inspections Inspectors must evaluate areas used for storage of materials that are exposed to precipitation. The purpose is to ensure that materials are protected and/or impounded so that pollutants cannot discharge from storage areas. Off-site material storage areas used solely by the subject project are considered to be part of the project and must be included in the erosion control plans and site inspection reports.

Seeded areas will be inspected to confirm that a healthy stand of vegetation is maintained. The site has achieved final stabilization once all areas are covered with pavement or have a stand of vegetation with at least 70% of the background vegetation density. The density of 70% or greater must be maintained to be considered as stabilized. The operator or their representative will water, fertilize, and reseed disturbed areas as needed to achieve this goal.

All controls should be inspected at least once every seven (7) calendar days unless noted otherwise and following any storm event of 0.5 inch or greater. The

construction entrance must be inspected daily. The following is a list of inspection/maintenance practices that will be used for specific controls: Geotextiles/Frosion Control Mats: Missing or loose matting must be replaced or re-anchored 2. Inlet Protection: If silt fence inlet protection is to be used, sediment should be removed when it reaches approximately one-half the height of the fence. If a sump is used, sediment should be removed when the volume of the basin is reduced by 50%.

Mulching: Inspect for thin or bare spots caused by natural decomposition or weather-related events. Mulch in high traffic areas should be replaced on a regular basis to maintain uniform protection Silt Fence: Removal of built-up sediment will occur when the sediment reaches one-third the height of the fence.

Stabilized Construction Entrance: Periodic re-grading and top dressing with additional stone. Vegetation: Protect newly seeded areas from excessive runoff and traffic until vegetation is established. Establish a watering and fertilizing schedule. Good Housekeeping: Litter, construction debris, and construction chemicals exposed to stormwater shall be prevented from becoming a pollutant source

for stormwater discharges through screening of outfalls and daily pickup of litter.

In the event that sediment escapes the construction site, off-site accumulations of sediment must be removed at a frequency sufficient to minimize adverse impacts. An example of this may be the situation where sediment has washed into the street and could be carried into the storm sewers by the next rainfall and/or pose a safety hazard to user of public street.

Modifications/Revisions to SWPPP Based on inspection results, any necessary modification to this SWPPP shall be implemented within seven (7) calendar days of the inspection. A modification is necessary if a control measure or operational procedure does not provide adequate pollutant control. All revisions shall be recorded on a Record of Revisions

within seven (7) calendar days of the inspection. It is the responsibility of the operator to maintain effective pollutant discharge controls. Physical site conditions or contractor/subcontractor practices could make it necessary to install more control than were originally planned. Fore example, localized concentrations of surface runoff or unusually steep areas could required additional silt barrier or other structural controls. Assessing the need for and installing additional controls will be a continuing contractor/subcontractor

and update this SWPPP in order to accomplish the intended goals. Compliance of the site with the General Construction Permit remains the responsibility of all operators that have submitted an NOI until such time as they have

submitted a Notice of Termination (NOT). The permittee's authorization to discharge under the General Construction Permit terminates at midnight of the day the NOT is signed. All permittees must submit a NOT within thirty (30) days after one or more of the following conditions have been met:

responsibility until final stabilization is achieved. Contractors and subcontractors implementing this SWPPP must remain alert to the need to periodically refine

Another operator/permittee has assumed control over all areas of the site that have not been finally stabilized In residential construction operations, temporary stabilization has been completed and the residence has been transferred to the homeowner B12 - SEQUENCE DESCRIBING STORMWATER QUALITY MEASURE IMPLEMENTATION RELATIVE TO LAND-DISTURBING ACTIVITIES

Pre-construction Activity 1. The exact locations of all existing utilities within the project limits are to verified prior to construction. 2. Schedule pre-construction meeting with local stormwater authority 48 hours prior to start of construction.

3. Install protection fencing for existing trees to remain in place within the project limits

Final stabilization has been achieved on all portions of the site for which the permittee was responsible.

Construction Site Access

2. Post the NOI and contact information at the construction entrance. NOI to remain posted for duration of the project. 3. Install construction staging pads, fueling station, material storage areas, concrete washout, construction parking areas, and stabilize construction

1. Utilize the gravel construction entrance for installation of the perimeter silt fence. Add stone if needed.

Initial Land Clearing and Grading Activities 1. Add protection measures to existing inlets.

Strip the topsoil. Secondary Land Grading Activities

. Begin site grading/construction of detention basins and remove unneeded excess earth. 2. Complete the cut and fills on the site. Final grade and seed the basin slopes. Stabilize slopes with erosion control blanket. 3. Install storm sewer system and install inlet protection immediately upon complete of the inlet and install rip-rap outlet protection prior to installing outlets.

1. Apply temporary seeding or mulch and stabilize slopes in areas where rough grading has been completed. 2. Apply permanent seeding or mulch and stabilize slopes in areas where final grading has been completed.

1. Prior to building construction. Install stone surface for payed areas. 2. Building pads left dormant for more than 10 days, must be temporarily seeded

3. Start building construction. Install staging area for building materials and stabilize. Final Shaping/Landscaping

1. Utilize topsoil salvage in applicable areas and apply permanent seeding. 2. Apply permanent seeding around the perimeter of the site. 3. Complete utility installation, curbs, paving, and building construction. 4. Install landscaping plant material and stabilize all disturbed areas.

5. Remove all erosion and sediment control practices when areas have a uniform grass cover.

B13 - PROVISIONS FOR EROSION AND SEDIMENT CONTROL ON INDIVIDUAL RESIDENTIAL BUILDING LOTS REGULATED UNDER THE PROPOSED

The site is not currently subdivided, therefore the entire site is on this plan's Erosion Control Plan.

B14 - MATERIAL HANDLING AND SPILL PREVENTION AND SPILL RESPONSE PLAN MEETING THE REQUIREMENTS IN 327 IAC 2-6.1:

No solid material, including building materials, is permitted to be discharged to surface waters or buried on site. All solid waste materials, including disposable materials incidental to construction activity, must be collected in containers or closed dumpster's. The collection containers must be emptied periodically and the collected material hauled to a landfill permitted by the State and/or appropriate local municipality to accept the waste for disposal.

A foreman or supervisor should be designated in writing to oversee, enforce, and instruct construction workers on proper solid waste procedures.

Whenever possible, minimize the use of hazardous materials and generation of hazardous wastes. All hazardous waste materials will be disposed in the manner specified by federal, state, or local regulations or by the manufacturer

requency sufficient to minimize off-site impacts.

Use containment berms in fueling and maintenance areas and where potential for spills is high. A foreman or supervisor should be designated in writing to oversee, enforce, and instruct construction workers on proper hazardous waste procedures. The

location of any hazardous waste storage areas should be indicated on the stormwater pollution prevention plan by the operator following on-site location of the

Dust Control/Off-Site Vehicle Tracking uring construction, water trucks should be used, as needed, by each contractor or subcontractor to reduce dust. After construction, the site should stabilized to

Construction traffic should enter and exit the site at a Construction Entrance with a rock pad or equivalent device. The purpose of the rock pad is to minimize the amount of soil and mud that is tracked onto existing street. If sediment escapes the construction site, off-site accumulations of sediment must be removed a

B15 - MATERIAL HANDLING AND STORAGE PROCEDURES ASSOCIATED WITH CONSTRUCTION ACTIVITY:

and be serviced regularly. All expenses associated with providing sanitary facilities are the responsibility of the contractors and subcontractors. The location of any sanitary facilities should be indicated on the stormwater pollution prevention plan by the operator following on-site location of said facilities.

Contractors and subcontractors must comply with all state and local sanitary sewer, portable toilet, or septic system regulations. Sanitary facilities shall be provided at the site by each contractor or subcontractor throughout construction activities. The sanitary facilities should be utilized by all construction personnel

Water used to establish and maintain grass, to control dust, and for other construction purposes must originate from a public water supply or private well approved by the State or local health department.

equipment fueling, maintenance, and cleaning should only be completed in protected areas (i.e., bermed area). Leaking equipment and maintenance fluids will be collected and not allowed to discharge onto soil where they may be washed away during a rain event. Equipment wash-down (except wheel washes) should take place within an area surrounded by a berm. The use of detergents is prohibited.

Chemicals, paint, solvents, fertilizers, and other toxic or hazardous materials should be stored in their original containers (if original container is not resalable, store the products in a clearly labeled, waterproof container). Except during application, the containers should be kept in trucks or in bermed areas within covered storage facilities. Runoff containing such materials shall be collected, removed from the site, and disposed of in accordance with the federal, state, and

As may be required by federal, state or local regulations, the Contractor should have a Hazardous Materials Management Plan and/or Hazardous Materials Spill and Prevention Program in place. A foreman or supervisor should be designated in writing to oversee, enforce, and instruct construction workers on proper hazardous materials storage and handling procedures. The location of any hazardous material storage areas should be indicated on the stormwater pollution prevention plan by the operator following on-site location of the storage areas.

Discharge of hazardous substances or oil into stormwater is subject to reporting requirements. In the event of a spill of a hazardous substance, the operator is required to notify the National Response Center (1-800-424-8802) to properly report the spill. In addition, the operator shall submit a written description of the release (including the type and amount of material released, the date of the release, the circumstances of the release, and the steps to be taken to prevent future spill to the local governing authority. The SWPPP must be revised within 14 calendar days after the release to reflect the release, stating the information above along with modifications minimize the possibility of future occurrences. Each contractor and subcontractor is responsible for complying with these

Il concrete truck waste material shall be completely contained and disposed in accordance with all local, state, and federal regulations. A pit or container is required when cleaning concrete chutes. See location of washout on SWPPF

linor - Small spills that typically involve oil, gasoline, paint, hydraulic fluid, etc. can be controlled by the first responder at the discovery of the spill.

• Contain spill to prevent material from entering storm or groundwater. Do not flush with water or bury. • Use absorbent material to clean-up spill material and any subsequently contaminated soil and dispose of properly. Semi-Significant Spills - Approximately ten gallons or less of pollutant with no contamination of ground or surface waters. Minor spills can be generally controlled by the first responder with help from other site personnel. This response may require other operations to stop to make sure the spill is quickly and safely

addressed. At the discovery of the spill: Contain spill to prevent material from entering storm or ground water. Do not flush with water or bury. • Use absorbent material to clean-up spills and dispose of properly. Spills on impervious surfaces should be disposed of as soon as possible to prevent

migration deeper into the soil and groundwater. Dispose of contaminated soils or absorbents properly. Contact 911 if the spill could be a safety issue

 Contact supervisors and designated site inspectors, including MS4 personnel, immediately Contaminated solids are to be removed to an approved landfill. Major or Hazardous Spills - More than ten gallons, there is the potential for death, injury or illness to humans or animals, or has the potential for surface or groundwater pollution Control or contain the spill without risking bodily harm. Temporarily plug storm drains if possible to prevent migration of the spill into the stormwater System. Immediately contact the local Fire Department at 911 to report any hazardous material spill. • Contact supervisors and designated site inspectors immediately. Governing authorities, including MS4 personnel, responsible for stormwater facilities should

be contacted as well. The contractor is responsible for having these contact numbers available at the job site. A written report should be submitted to the

owner as soon as possible. • As soon as possible but within 2 hours of discovery, contact the local agency responsible for spill management. The following information should be noted for future reports to the agency:

 Name, address, and phone number of person making the spill report The location of the spill

 The time of the spill • Identification of the spilled substance • Approximate quantity of the substance that has been spilled or may be further spilled

 The duration and source of the spill • Name and location of the damaged waters Name of spill response organization

What measures were taken in the spill response

Additional regulations or requirements may be present. A spill response professional should be consulted to make sure all appropriate and required steps have been taken. Contaminated solids should only be removed from the site after approval is give by the appropriate agency

The proposed land use is for education and research. The pollutants and sources of each pollutant normally expected from this type of land use are:

C1 - DESCRIPTION OF POLLUTANTS AND THEIR SOURCES ASSOCIATED WITH THE PROPOSED LAND USE

Type of Pollutant: Oil, gasoline, diesel fuel, any hydrocarbon associated with vehicular fuels and lubricants, grease, antifreeze, windshield cleaner solution, brake fluid, dust, rubber, glass, metal and plastic fragments, grit, road de-icing materials.

Pollutant Source: Building Type of Pollutant: Cleaning solutions or solvents, leaks from HVAC equipment, grit from roof drainage, aggregate or rubber fragments from roofing system. Pollutant Source: Trash Dumpster

Type of Pollutant: Cleaning solutions or solvents, litter (paper, plastic, general refuse associated with distribution operations), uneaten food products, bacteria.

Type of Pollutant: Any pollutant associated with vehicular sources, grit from asphalt wearing surface, bituminous compounds from periodic maintenance (sealing, resurfacing, and patching), pavement de-icing materials, paint fragments from parking stall striping, concrete fragments, wind-blown litter from off-site sources, elevated water temperatures from contact with impervious surfaces.

ood housekeeping measures such as regular street or pavement sweeping, installation of trash receptacles, and reduction in fertilizer overspray can be

Pollutant Source: Lawn and Landscape Areas Type of Pollutant: Fertilizers, soil, organic material (leaves, mulch, grass clippings)

C2 - DESCRIPTION OF PROPOSED POST-CONSTRUCTION STORMWIND A CONSTRUCTION he primary BMP for the project is a Storm Settler SSET-6 as manufactured by Storm Trap. The detained run-off leaving the project is connected to the storn ewer. Maintenance of this unit is to be handled by the owner. Permanent Vagetation osoil will be placed in lawn areas and seeded with grass, and graded not to exceed 3:1 slopes. Proposed landscape trees and shrubs will also be added. These bio areas will act as a natural filter strip to help improve stormwater quality. The vegetated areas will slow the velocities of stormwater runoff, reduce

ail Storm Settler SSET-6, manufactured by Storm Trap

incorporated by the owner and/or occupant.

sediment runoff, and reduce problems associated with mud or dust from bare soils.

C4 - SEQUENCE DESCRIBING STORMWATER QUALITY MEASURE IMPLEMENTATION

The Contractor shall implement permanent erosion control measures as soon as it is practical. Permanent seeding or sodding shall occur when the disturbed area is at final grade. Once the project has been completed and before final approval of the project, the Contractor shall inspect all previously installed measures for compliance with the standard specifications and construction The Contractor shall remove any built-up sediment deposits and repair any measures that have failed, including reseeding or sodding any areas where surface runoff has removed the previously installed measure. All disturbed ground shall be temporarily seeded if it is left undisturbed for more than seven (7) calendar days, and any additional seeding or sodding shall be completed when the

Seed/sod shall be used in all disturbed areas for permanent storm water quality measures and placed in accordance with ISS 621. Vegetation works to reduce sediment migration by holding soil in place, as well as filtering sheet flow runoff as it moves over the vegetation. Since roadway pollutants often bind to soil particles, this keeps much of the roadway pollution on-site. Catch basins have been included within the proposed storm sewer system to collect sand and gravel from the roadway. Temporary inlet protection will prevent sediment from entering the storm sewer system during construction allowing it to operate as designed

throughout construction One BMP (Storm Settler) will be installed on the proposed storm water system. Utilizing the BMP allows the capture of sediment and other pollutants before it leaves the project site.

C5 - DESCRIPTION OF MAINTENANCE GUIDELINES FOR POST-CONSTRUCTION STORMWATER QUALITY MEASURES

Maintenance requirements for the stormwater quality measures which will remain in place after construction is complete, are described in the Operation 8 Maintenance Manual which is submitted under separate cover. A summary of basic maintenance is below:

On-Site Water Quality BMP

Inspections of permanent BMPs shall be performed by the BMP owner to ensure BMPs function as designed and permitted. The owner is also required to perform maintenance activities. Upon request by BNS, the owner shall self-certify, with BNS, that inspections and maintenance activities were completed at least annually, in accordance with the O&M Manual and that the BMP functions as designed and permitted. Each BMP in the system shall be considered individually for inspection, maintenance and self-certification purposes. A BMP system will have multiple BMPs for the purpose of inspection, maintenance and self-certification. Each BMP shall have access and features, such as inspection ports, clean outs, easements and drives necessary for inspection and maintenance. Easements must extend to public right-of-way for access. Routine inspections and maintenance are the responsibility of the current BMP owner. The approved O&M Manual. inspection forms and maintenance form(s) should be used as guidance for performing such activities. Completed inspection forms and maintenance records must be maintained by the current BMP owner and produced upon request by BNS within forty-eight (48) hours.

P K Patel Indiana University Director of Engineering

ppatel@indiana.edu (812) 855-7894

quality or quantity feature.

(317) 524-9025

Inspect grass and plants annually. Replace plantings as needed. Reseed as necessary to maintain a consistent ground cover. No plant species listed on the Indiana Invasive Species Council Invasive Plant List (all Invasive Rank categories) shall be planted on the site including within any post-construction water

C6 - ENTITY THAT WILL BE RESPONSIBLE FOR OPERATION AND MAINTENANCE OF THE POST-CONSTRUCTION STORMWATER MEASURES:

F.A. Wilhelm 3914 Prospect Street Indianapolis, IN 46203 toddfrance@fawilhelm.com

175 S. Rangeline Rd, Suite 200


Carmel, IN 46032

ph 317.819.7878 fx 317.819.7288

SUITE 1700 DETROIT, MI 48226 smithgroup.com

CONSULTING

9365 Counselors Row, Suite 116 Indianapolis, IN 46240 ph 317.617.4270

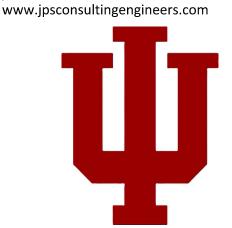

ACCELERATOR

CLIENT PROJECT NO. - 20250072


INDIANAPOLIS, INDIANA

CUMULATIVE DOCUMENTS **BP1-CD: SITE AND FOUNDATION PACKAGE**

ISSUED / REVISIONS SCHEDULE DESCRIPTION


08/15/2025 CITY SUBMITTAL

09/29/2025 BP1-CD: SITE AND FOUNDATION PACKAGE 10/21/2025 ADDENDUM #2

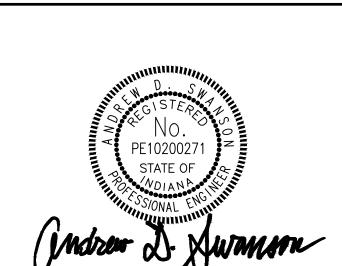

STORMWATER POLLUTION PREVENTION NOTES

BSA PROJECT NO.

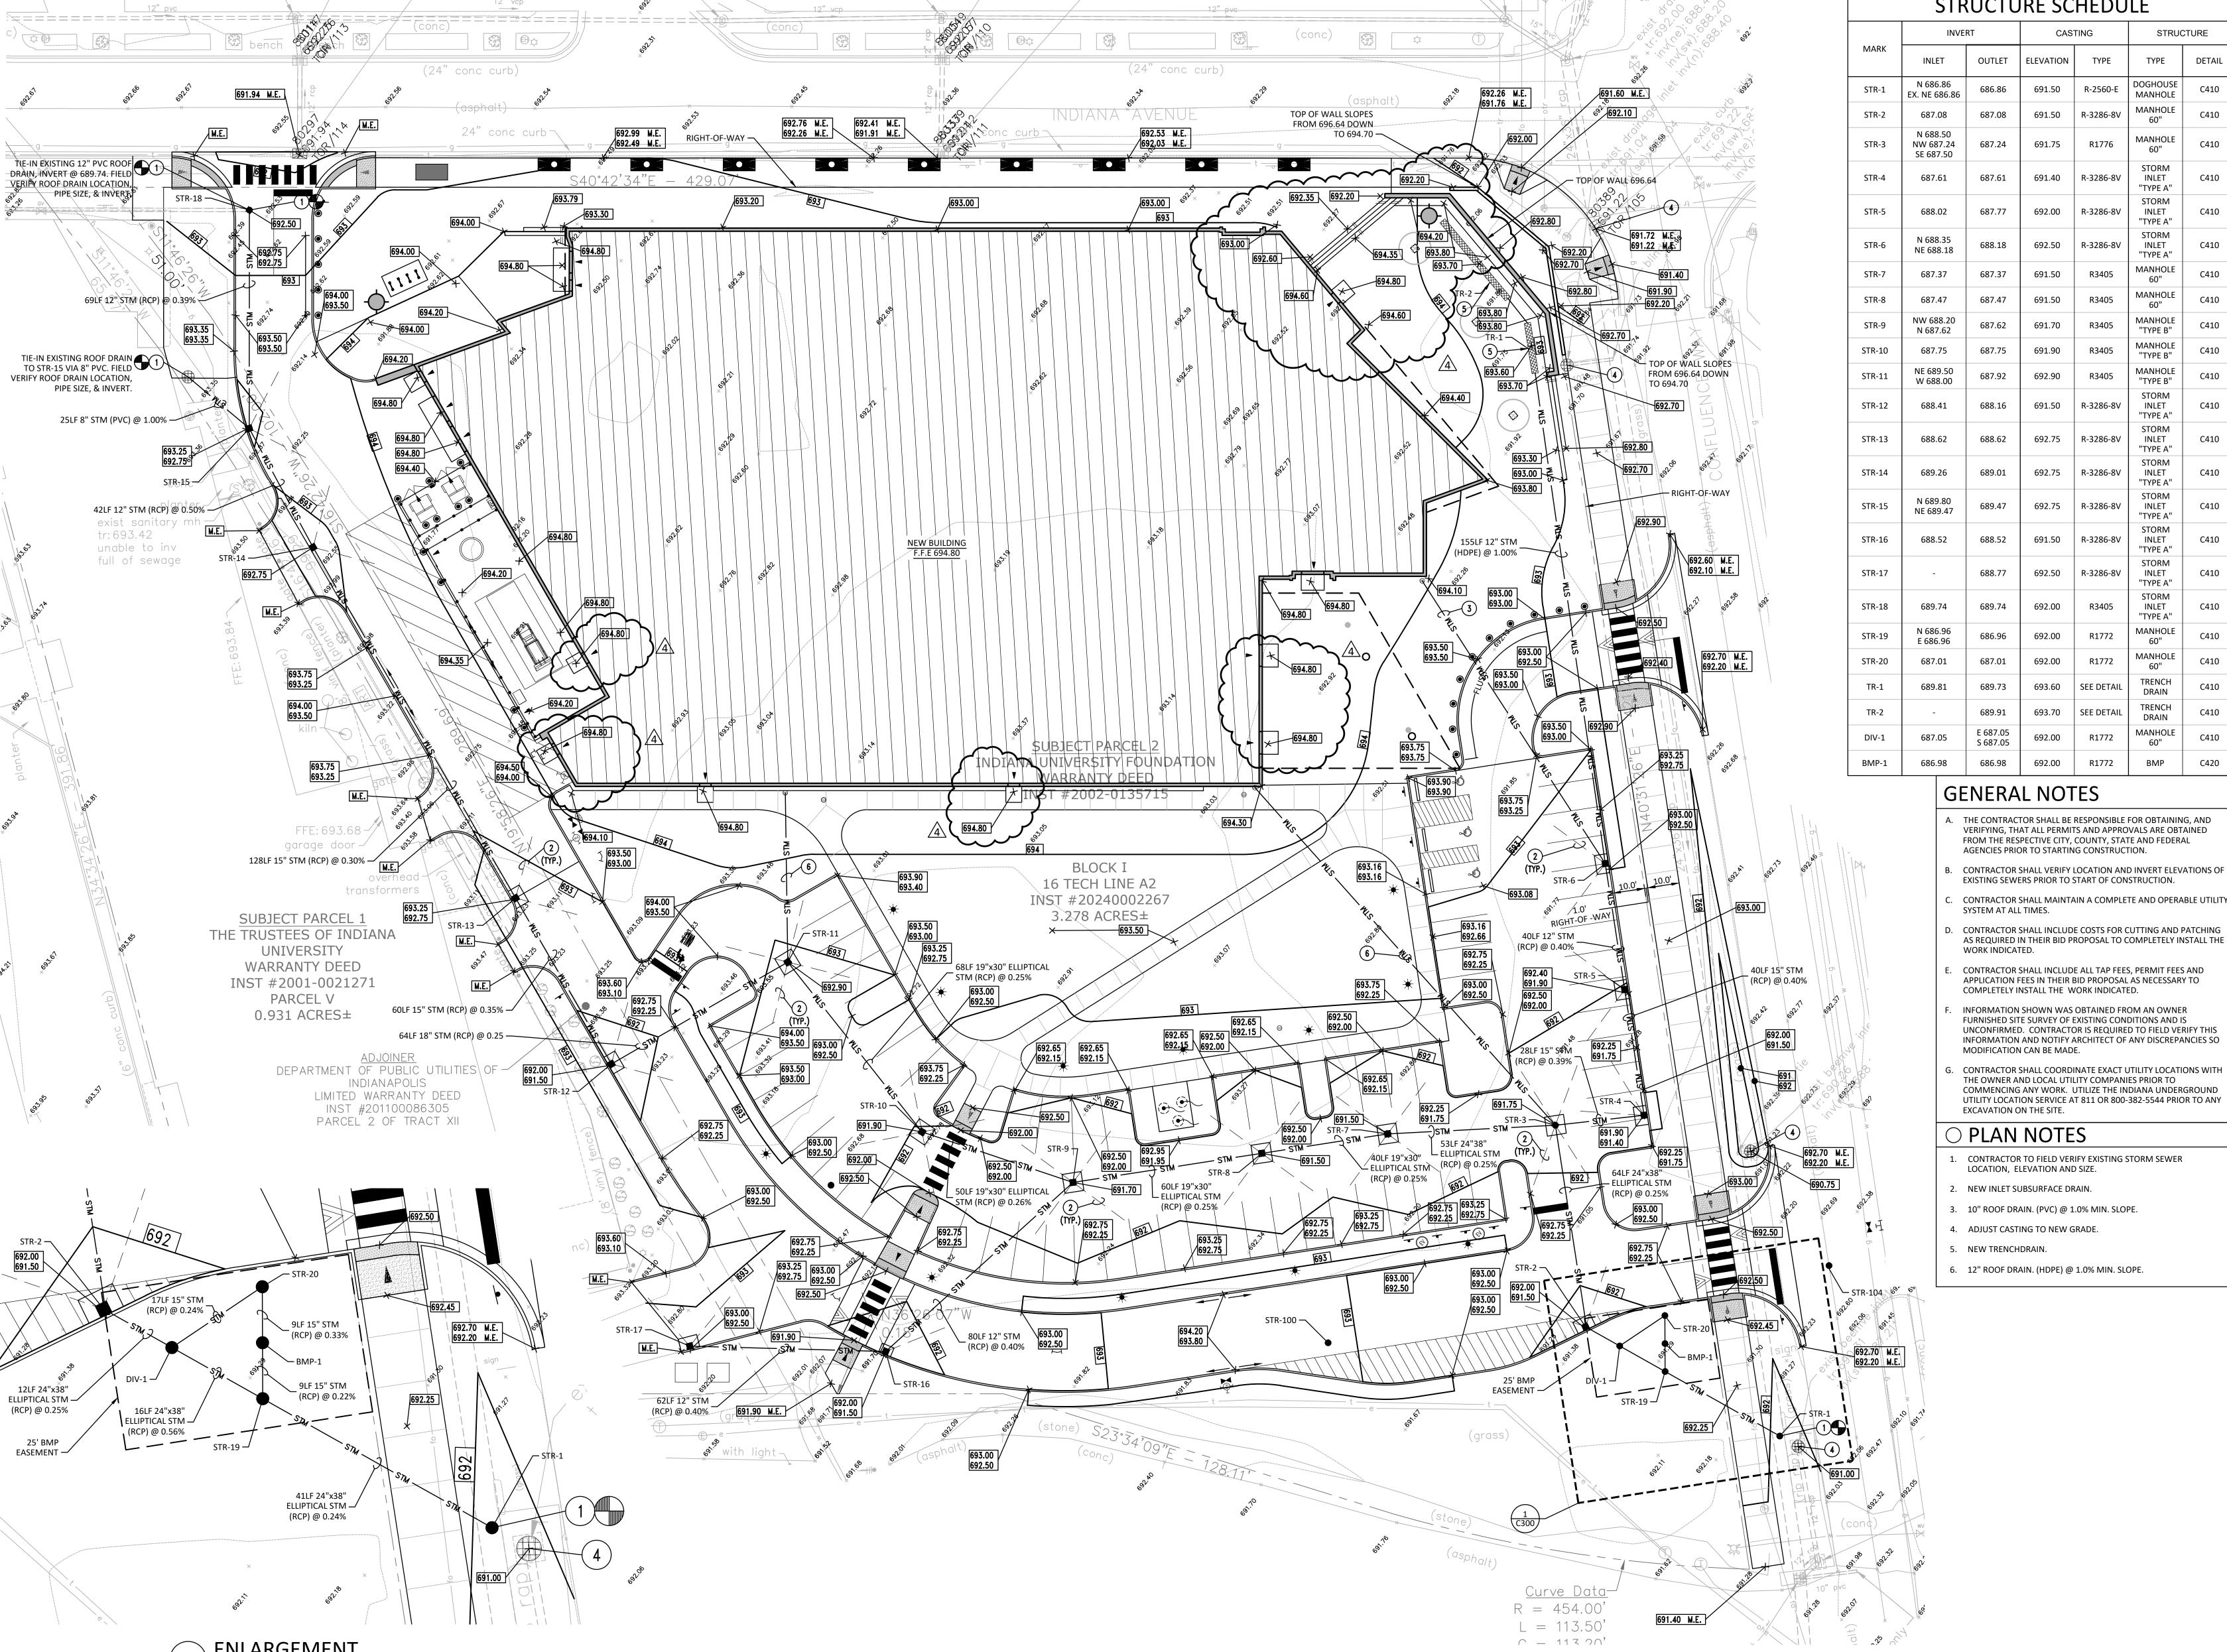

1 ENLARGEMENT
SCALE: 1"=10"

	STR	RUCTU	IRE SC	HEDU	LE	
	INVE	RT	CAS	TING	STRUC	CTURE
MARK	INLET	OUTLET	ELEVATION	ТҮРЕ	TYPE	DETAIL
STR-1	N 686.86 EX. NE 686.86	686.86	691.50	R-2560-E	DOGHOUSE MANHOLE	C410
STR-2	687.08	687.08	691.50	R-3286-8V	MANHOLE 60"	C410
STR-3	N 688.50 NW 687.24 SE 687.50	687.24	691.75	R1776	MANHOLE 60"	C410
STR-4	687.61	687.61	691.40	R-3286-8V	STORM INLET "TYPE A"	C410
STR-5	688.02	687.77	692.00	R-3286-8V	STORM INLET "TYPE A"	C410
STR-6	N 688.35 NE 688.18	688.18	692.50	R-3286-8V	STORM INLET "TYPE A"	C410
STR-7	687.37	687.37	691.50	R3405	MANHOLE 60"	C410
STR-8	687.47	687.47	691.50	R3405	MANHOLE 60"	C410
STR-9	NW 688.20 N 687.62	687.62	691.70	R3405	MANHOLE "TYPE B"	C410
STR-10	687.75	687.75	691.90	R3405	MANHOLE "TYPE B"	C410
STR-11	NE 689.50 W 688.00	687.92	692.90	R3405	MANHOLE "TYPE B"	C410
STR-12	688.41	688.16	691.50	R-3286-8V	STORM INLET "TYPE A"	C410
STR-13	688.62	688.62	692.75	R-3286-8V	STORM INLET "TYPE A"	C410
STR-14	689.26	689.01	692.75	R-3286-8V	STORM INLET "TYPE A"	C410
STR-15	N 689.80 NE 689.47	689.47	692.75	R-3286-8V	STORM INLET "TYPE A"	C410
STR-16	688.52	688.52	691.50	R-3286-8V	STORM INLET "TYPE A"	C410
STR-17	-	688.77	692.50	R-3286-8V	STORM INLET "TYPE A"	C410
STR-18	689.74	689.74	692.00	R3405	STORM INLET "TYPE A"	C410
STR-19	N 686.96 E 686.96	686.96	692.00	R1772	MANHOLE 60"	C410
STR-20	687.01	687.01	692.00	R1772	MANHOLE 60"	C410
TR-1	689.81	689.73	693.60	SEE DETAIL	TRENCH DRAIN	C410
TR-2	-	689.91	693.70	SEE DETAIL	TRENCH DRAIN	C410
DIV-1	687.05	E 687.05 S 687.05	692.00	R1772	MANHOLE 60"	C410
BMP-1	686 98	686 98	692.00	R1772	RMP	C420

GENERAL NOTES


- THE CONTRACTOR SHALL BE RESPONSIBLE FOR OBTAINING, AND VERIFYING, THAT ALL PERMITS AND APPROVALS ARE OBTAINED FROM THE RESPECTIVE CITY, COUNTY, STATE AND FEDERAL AGENCIES PRIOR TO STARTING CONSTRUCTION.
- CONTRACTOR SHALL VERIFY LOCATION AND INVERT ELEVATIONS OF EXISTING SEWERS PRIOR TO START OF CONSTRUCTION.
- CONTRACTOR SHALL MAINTAIN A COMPLETE AND OPERABLE UTILITY SYSTEM AT ALL TIMES.
- CONTRACTOR SHALL INCLUDE COSTS FOR CUTTING AND PATCHING AS REQUIRED IN THEIR BID PROPOSAL TO COMPLETELY INSTALL THE
- CONTRACTOR SHALL INCLUDE ALL TAP FEES, PERMIT FEES AND APPLICATION FEES IN THEIR BID PROPOSAL AS NECESSARY TO
- INFORMATION SHOWN WAS OBTAINED FROM AN OWNER FURNISHED SITE SURVEY OF EXISTING CONDITIONS AND IS UNCONFIRMED. CONTRACTOR IS REQUIRED TO FIELD VERIFY THIS INFORMATION AND NOTIFY ARCHITECT OF ANY DISCREPANCIES SO
- . CONTRACTOR SHALL COORDINATE EXACT UTILITY LOCATIONS WITH THE OWNER AND LOCAL UTILITY COMPANIES PRIOR TO COMMENCING ANY WORK. UTILIZE THE INDIANA UNDERGROUND UTILITY LOCATION SERVICE AT 811 OR 800-382-5544 PRIOR TO ANY EXCAVATION ON THE SITE.

O PLAN NOTES

- 1. CONTRACTOR TO FIELD VERIFY EXISTING STORM SEWER LOCATION, ELEVATION AND SIZE.
- 2. NEW INLET SUBSURFACE DRAIN.
- 3. 10" ROOF DRAIN. (PVC) @ 1.0% MIN. SLOPE.
- 4. ADJUST CASTING TO NEW GRADE.
- 5. NEW TRENCHDRAIN.
- 6. 12" ROOF DRAIN. (HDPE) @ 1.0% MIN. SLOPE.

RCΔ
BSA LifeStructures 175 S. Rangeline Rd, Suite 200 Carmel, IN 46032 ph 317.819.7878 fx 317.819.728
SMITHGROU
500 GRISWOLD SUITE 1700 DETROIT, MI 48226 313.983.3600 smithgroup.com
JPS CONSULTING ENGINEERS, LLC
9365 Counselors Row, Suite 116 Indianapolis, IN 46240 ph 317.617.4270

819.7288 OUP ING RS, LLC

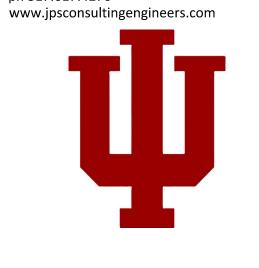

LAUNCH **ACCELERATOR FOR BIOSCIENCES**

INDIANAPOLIS, INDIANA


CLIENT PROJECT NO. - 20250072

CUMULATIVE DOCUMENTS **BP1-CD: SITE AND FOUNDATION PACKAGE**

ISSUED / REVISIONS SCHEDULE

DESCRIPTION 08/15/2025 CITY SUBMITTAL 09/29/2025 BP1-CD: SITE AND FOUNDATION PACKAGE


10/15/2025 ADDENDUM #1 10/21/2025 ADDENDUM #2

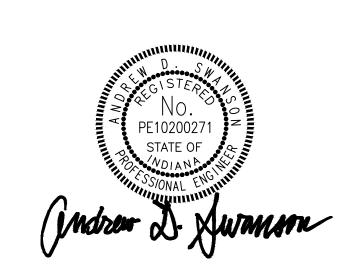

SITE GRADING, DRAINAGE & UTILITY PLAN

DATE BSA PROJECT NO. REF. SHEET INDEX

C300

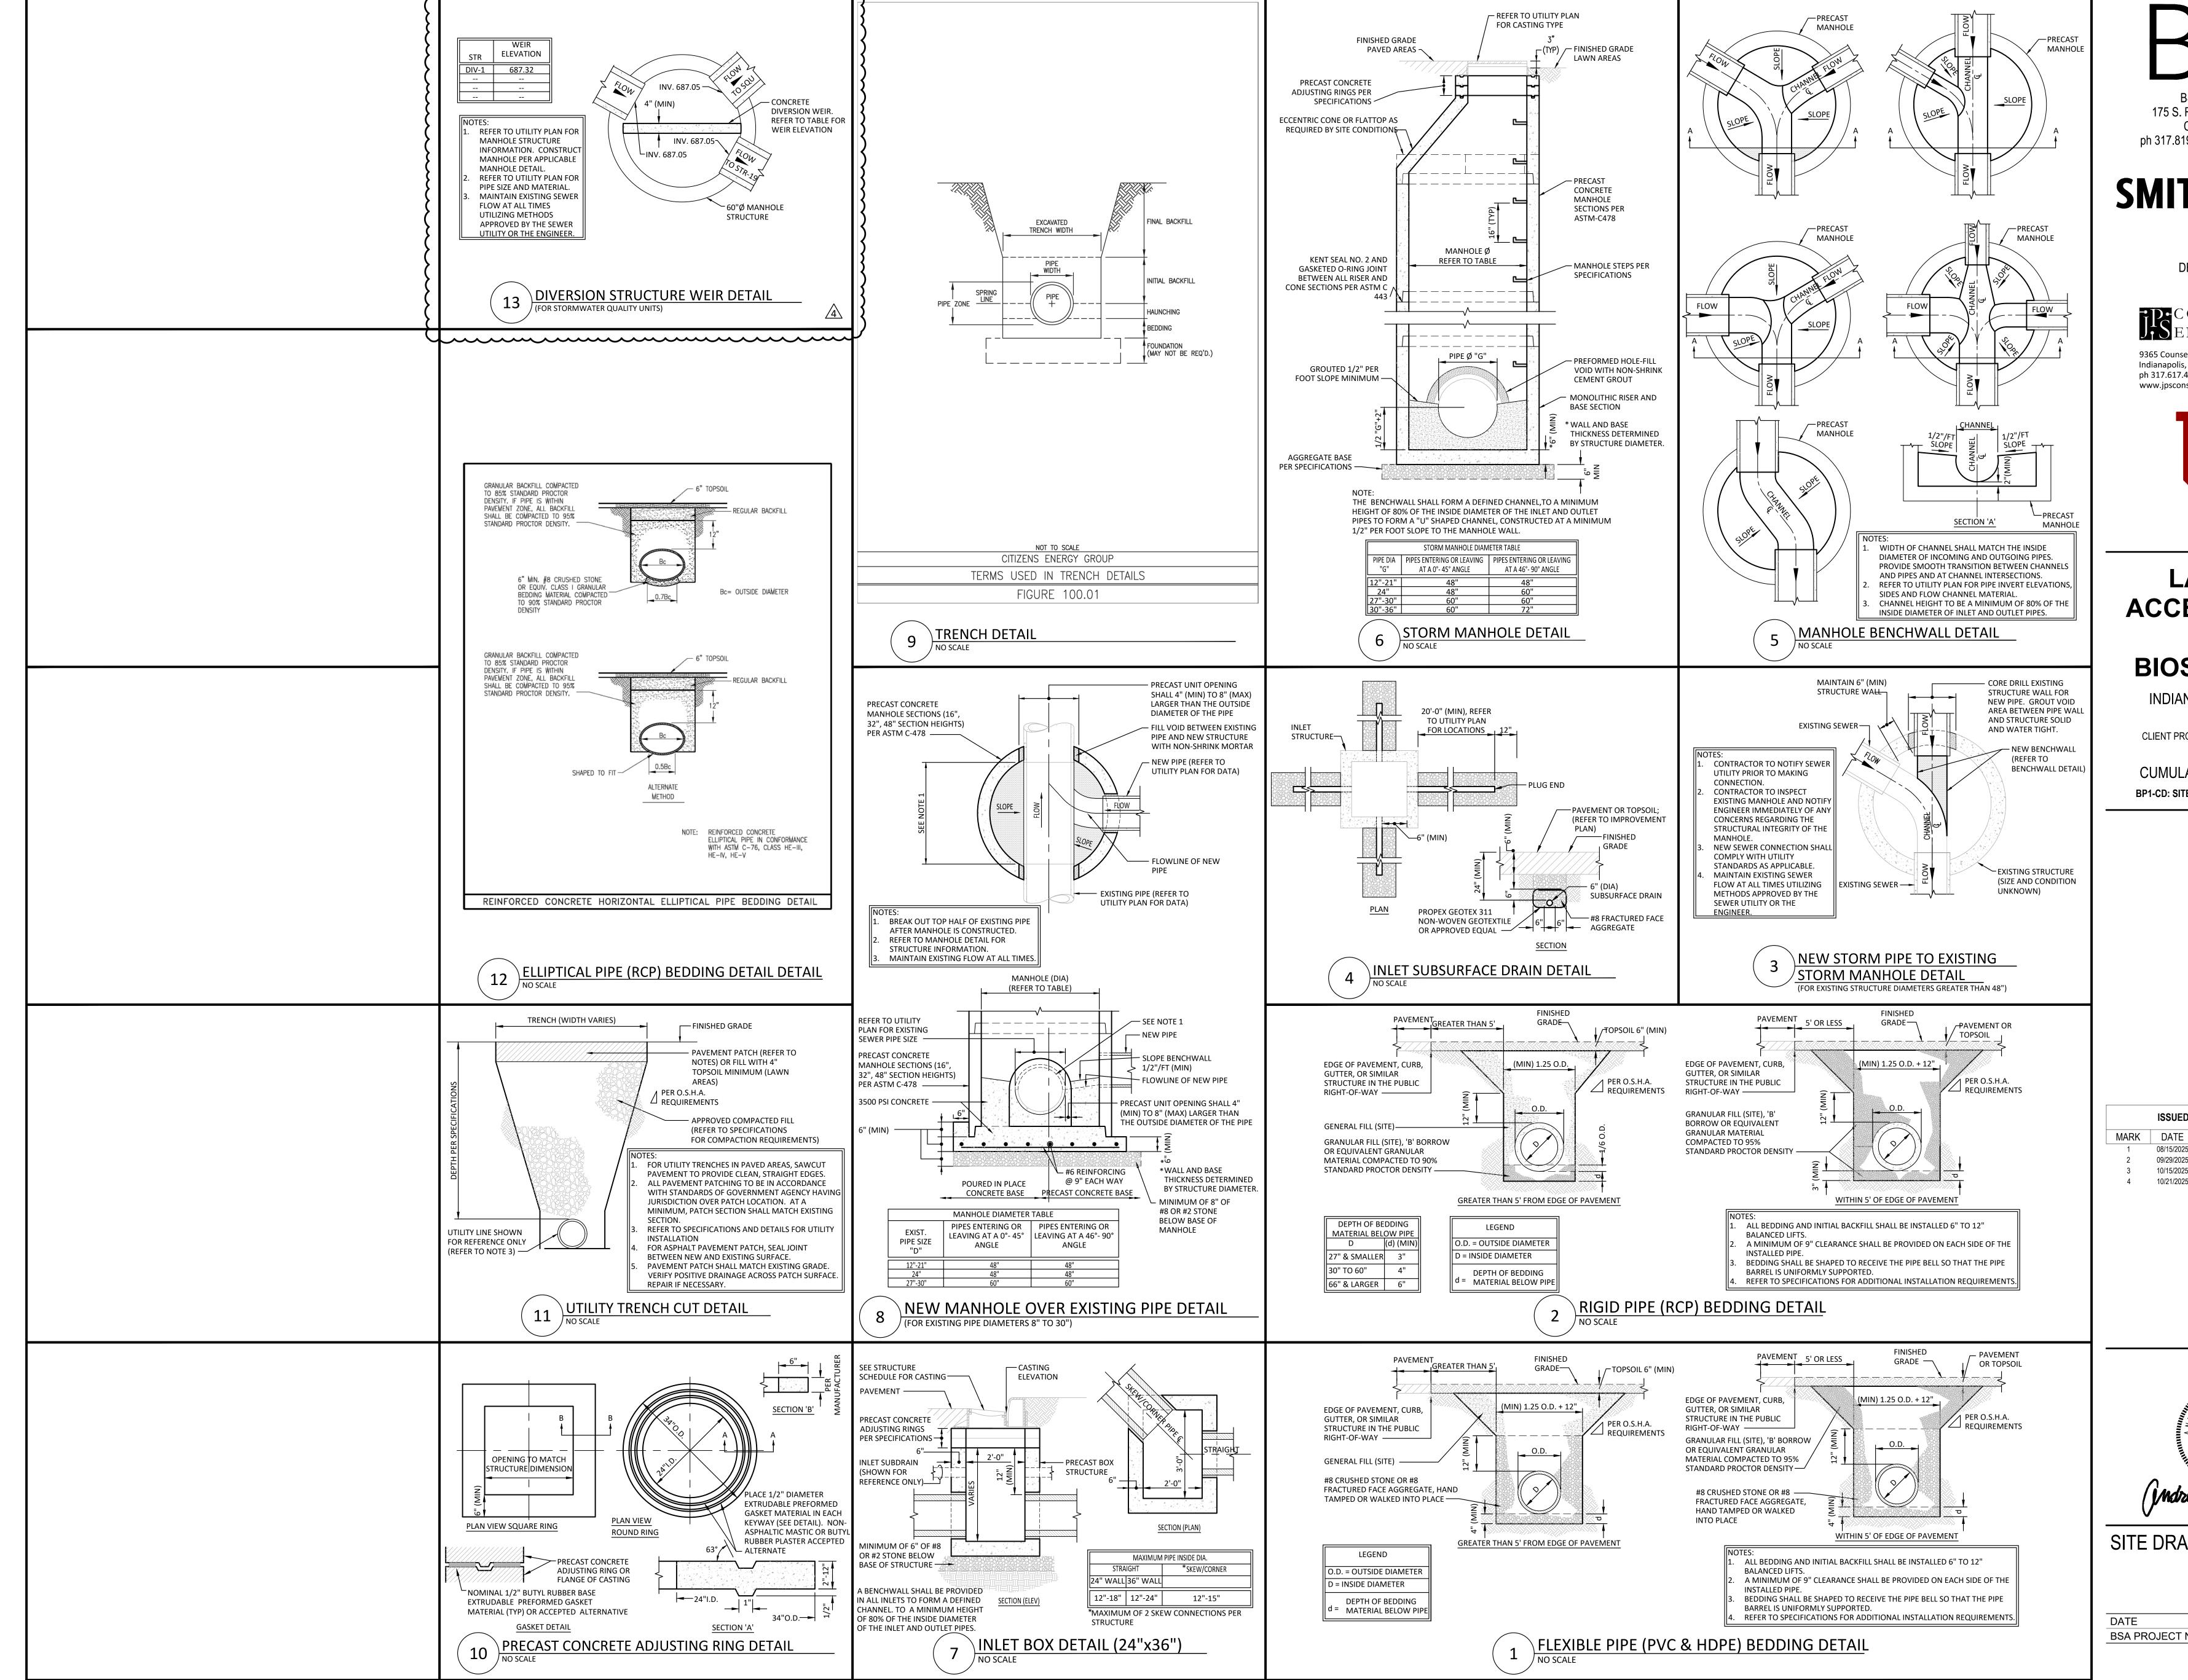

BSA LifeStructures

BSA LifeStructures 175 S. Rangeline Rd, Suite 200 Carmel, IN 46032 ph 317.819.7878 fx 317.819.7288

SMITHGROUP

500 GRISWOLD
SUITE 1700
DETROIT, MI 48226
313.983.3600
smithgroup.com

9365 Counselors Row, Suite 116 Indianapolis, IN 46240 ph 317.617.4270 www.jpsconsultingengineers.com



LAUNCH ACCELERATOR FOR BIOSCIENCES


INDIANAPOLIS, INDIANA

CLIENT PROJECT NO. - 20250072

CUMULATIVE DOCUMENTS
BP1-CD: SITE AND FOUNDATION PACKAGE

ISSUED / REVISIONS SCHEDULE
RK DATE DESCRIPTION


08/15/2025 CITY SUBMITTAL
09/29/2025 BP1-CD: SITE AND FOUNDATION PACKAGE
10/15/2025 ADDENDUM #1
10/21/2025 ADDENDUM #2

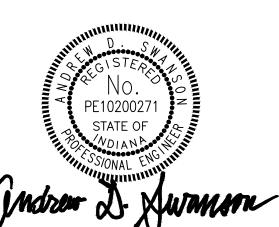

SITE DRAINAGE DETAILS

DATE REF. SHEET INDEX
BSA PROJECT NO. 00360481

C310

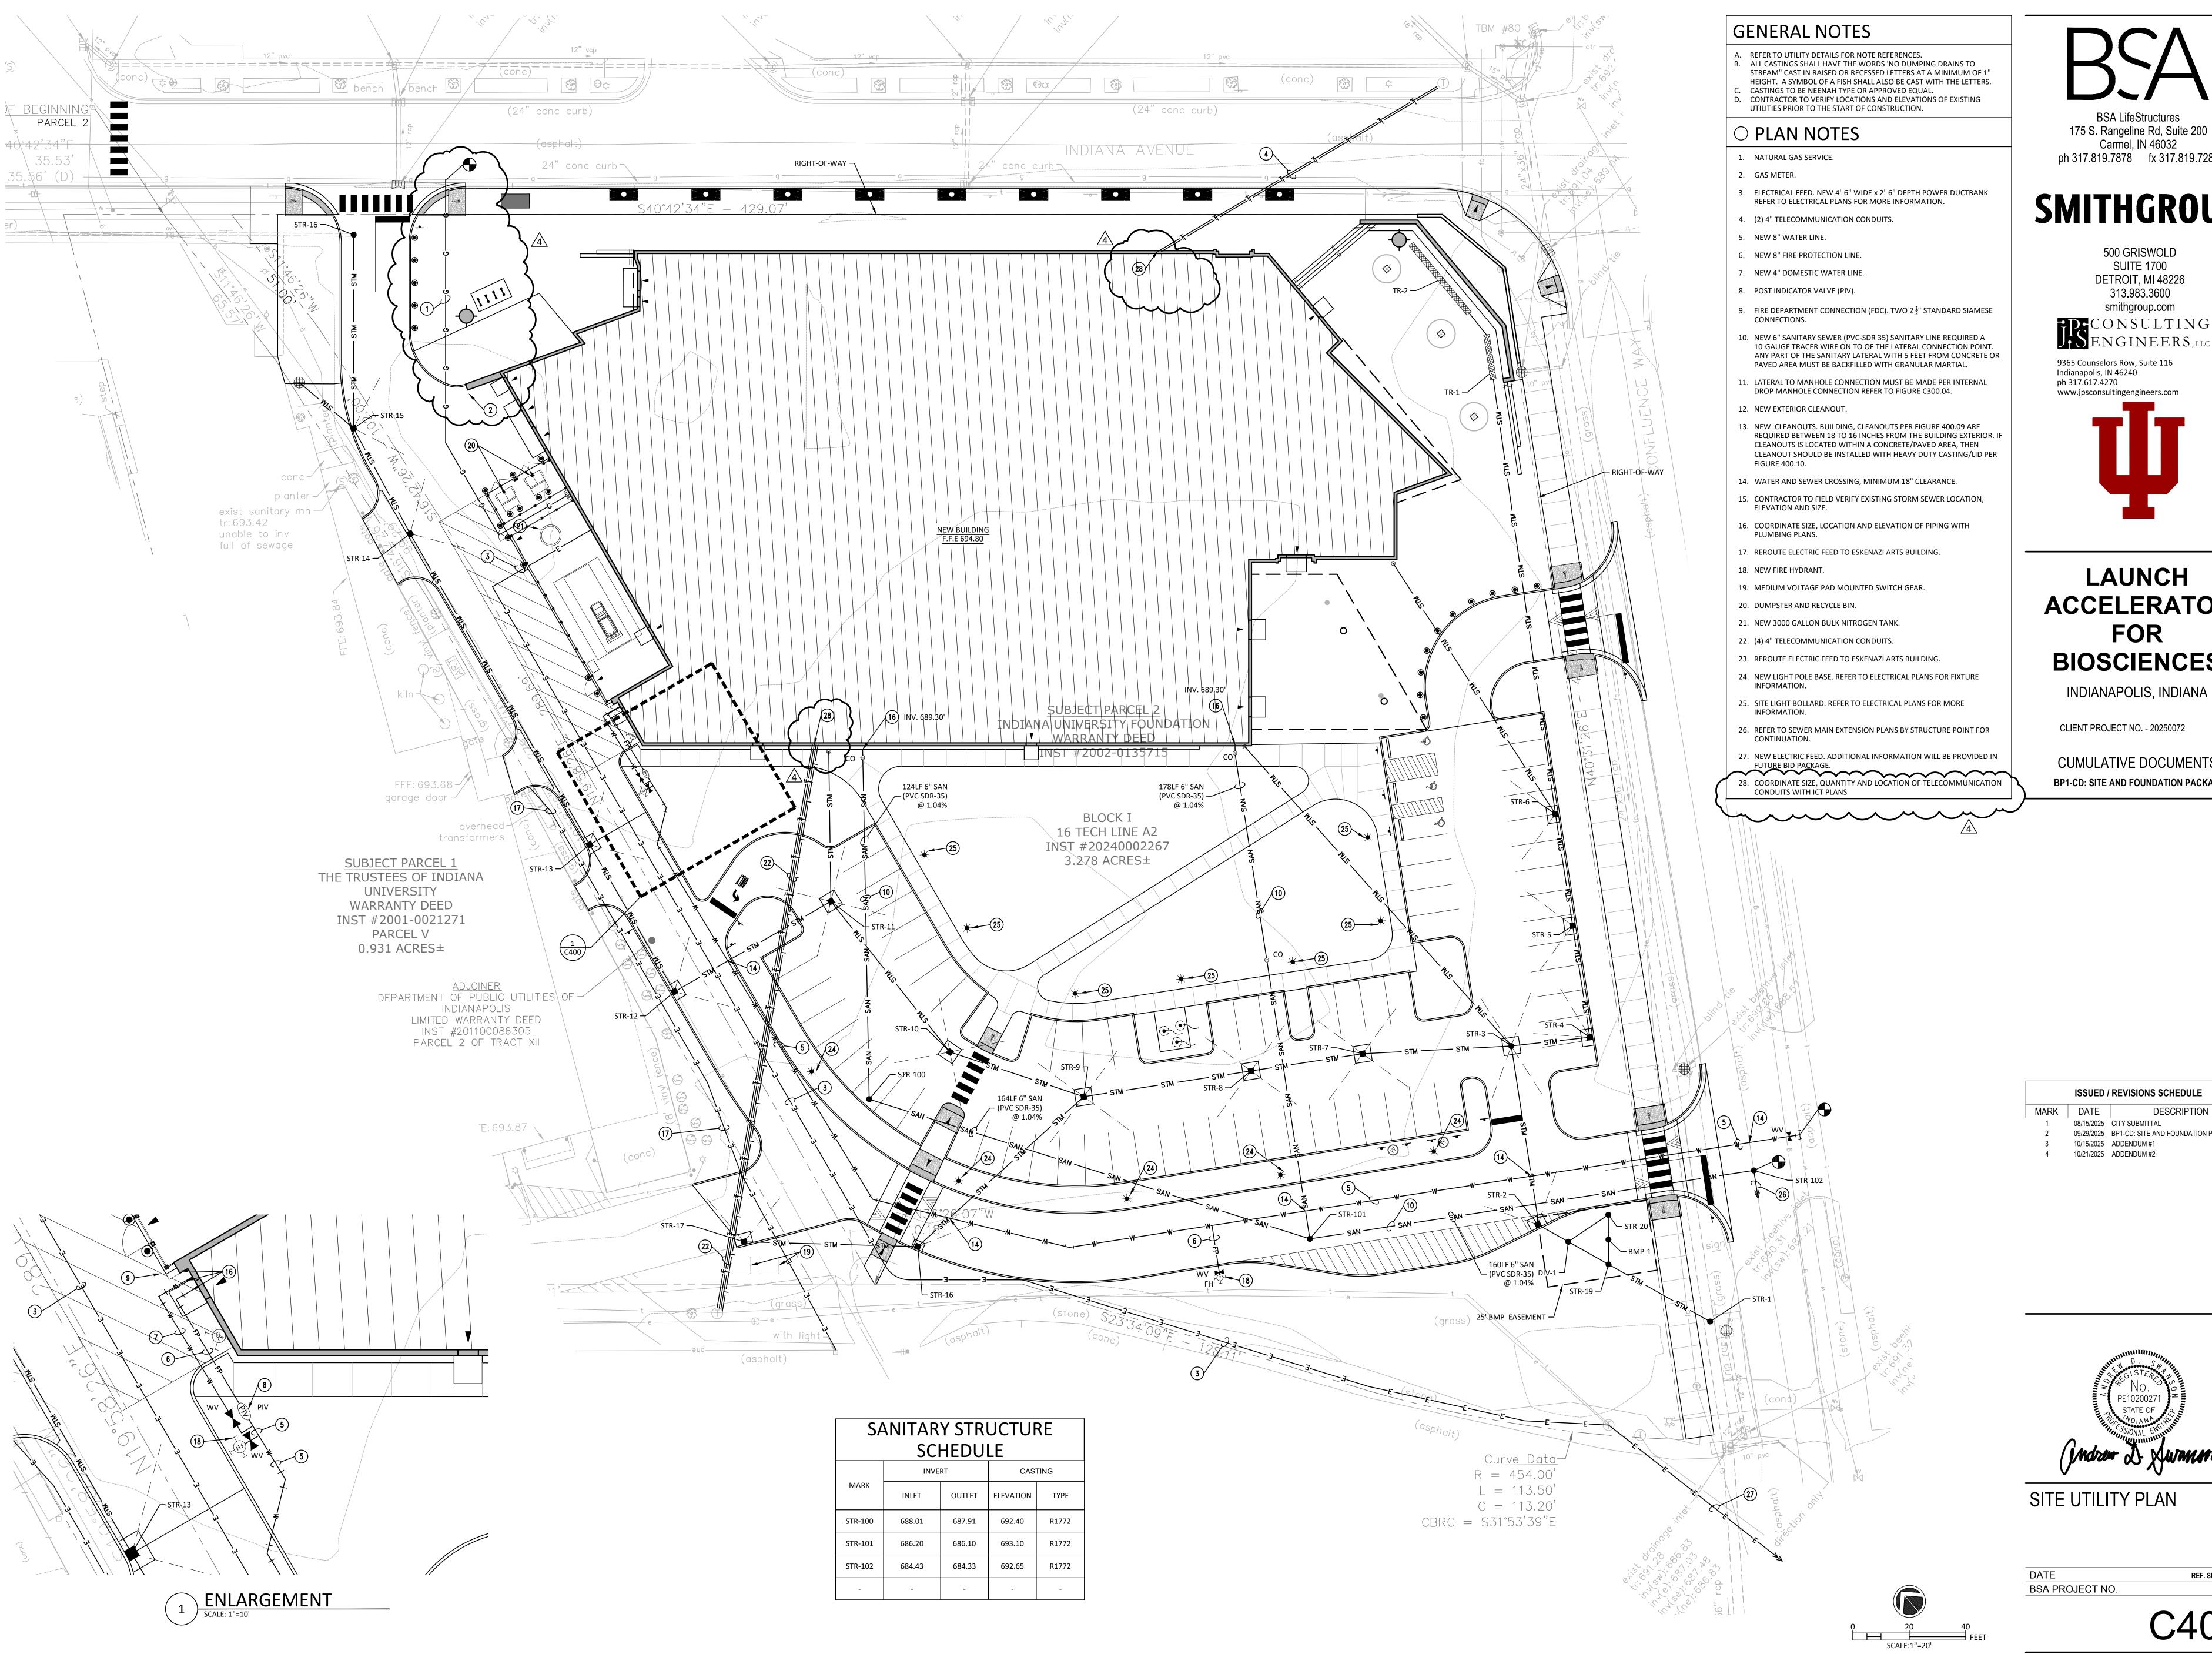

BSA LifeStructures 175 S. Rangeline Rd, Suite 200 Carmel, IN 46032 ph 317.819.7878 fx 317.819.7288

SMITHGROUP

500 GRISWOLD **SUITE 1700** DETROIT, MI 48226 313.983.3600

smithgroup.com CONSULTING ENGINEERS, LLC

LAUNCH **ACCELERATOR FOR BIOSCIENCES**

CUMULATIVE DOCUMENTS

BP1-CD: SITE AND FOUNDATION PACKAGE

ISSUED / REVISIONS SCHEDULE

DESCRIPTION 08/15/2025 CITY SUBMITTAL


09/29/2025 BP1-CD: SITE AND FOUNDATION PACKAGE 10/15/2025 ADDENDUM #1

10/21/2025 ADDENDUM #2

SITE UTILITY PLAN

REF. SHEET INDEX

C400

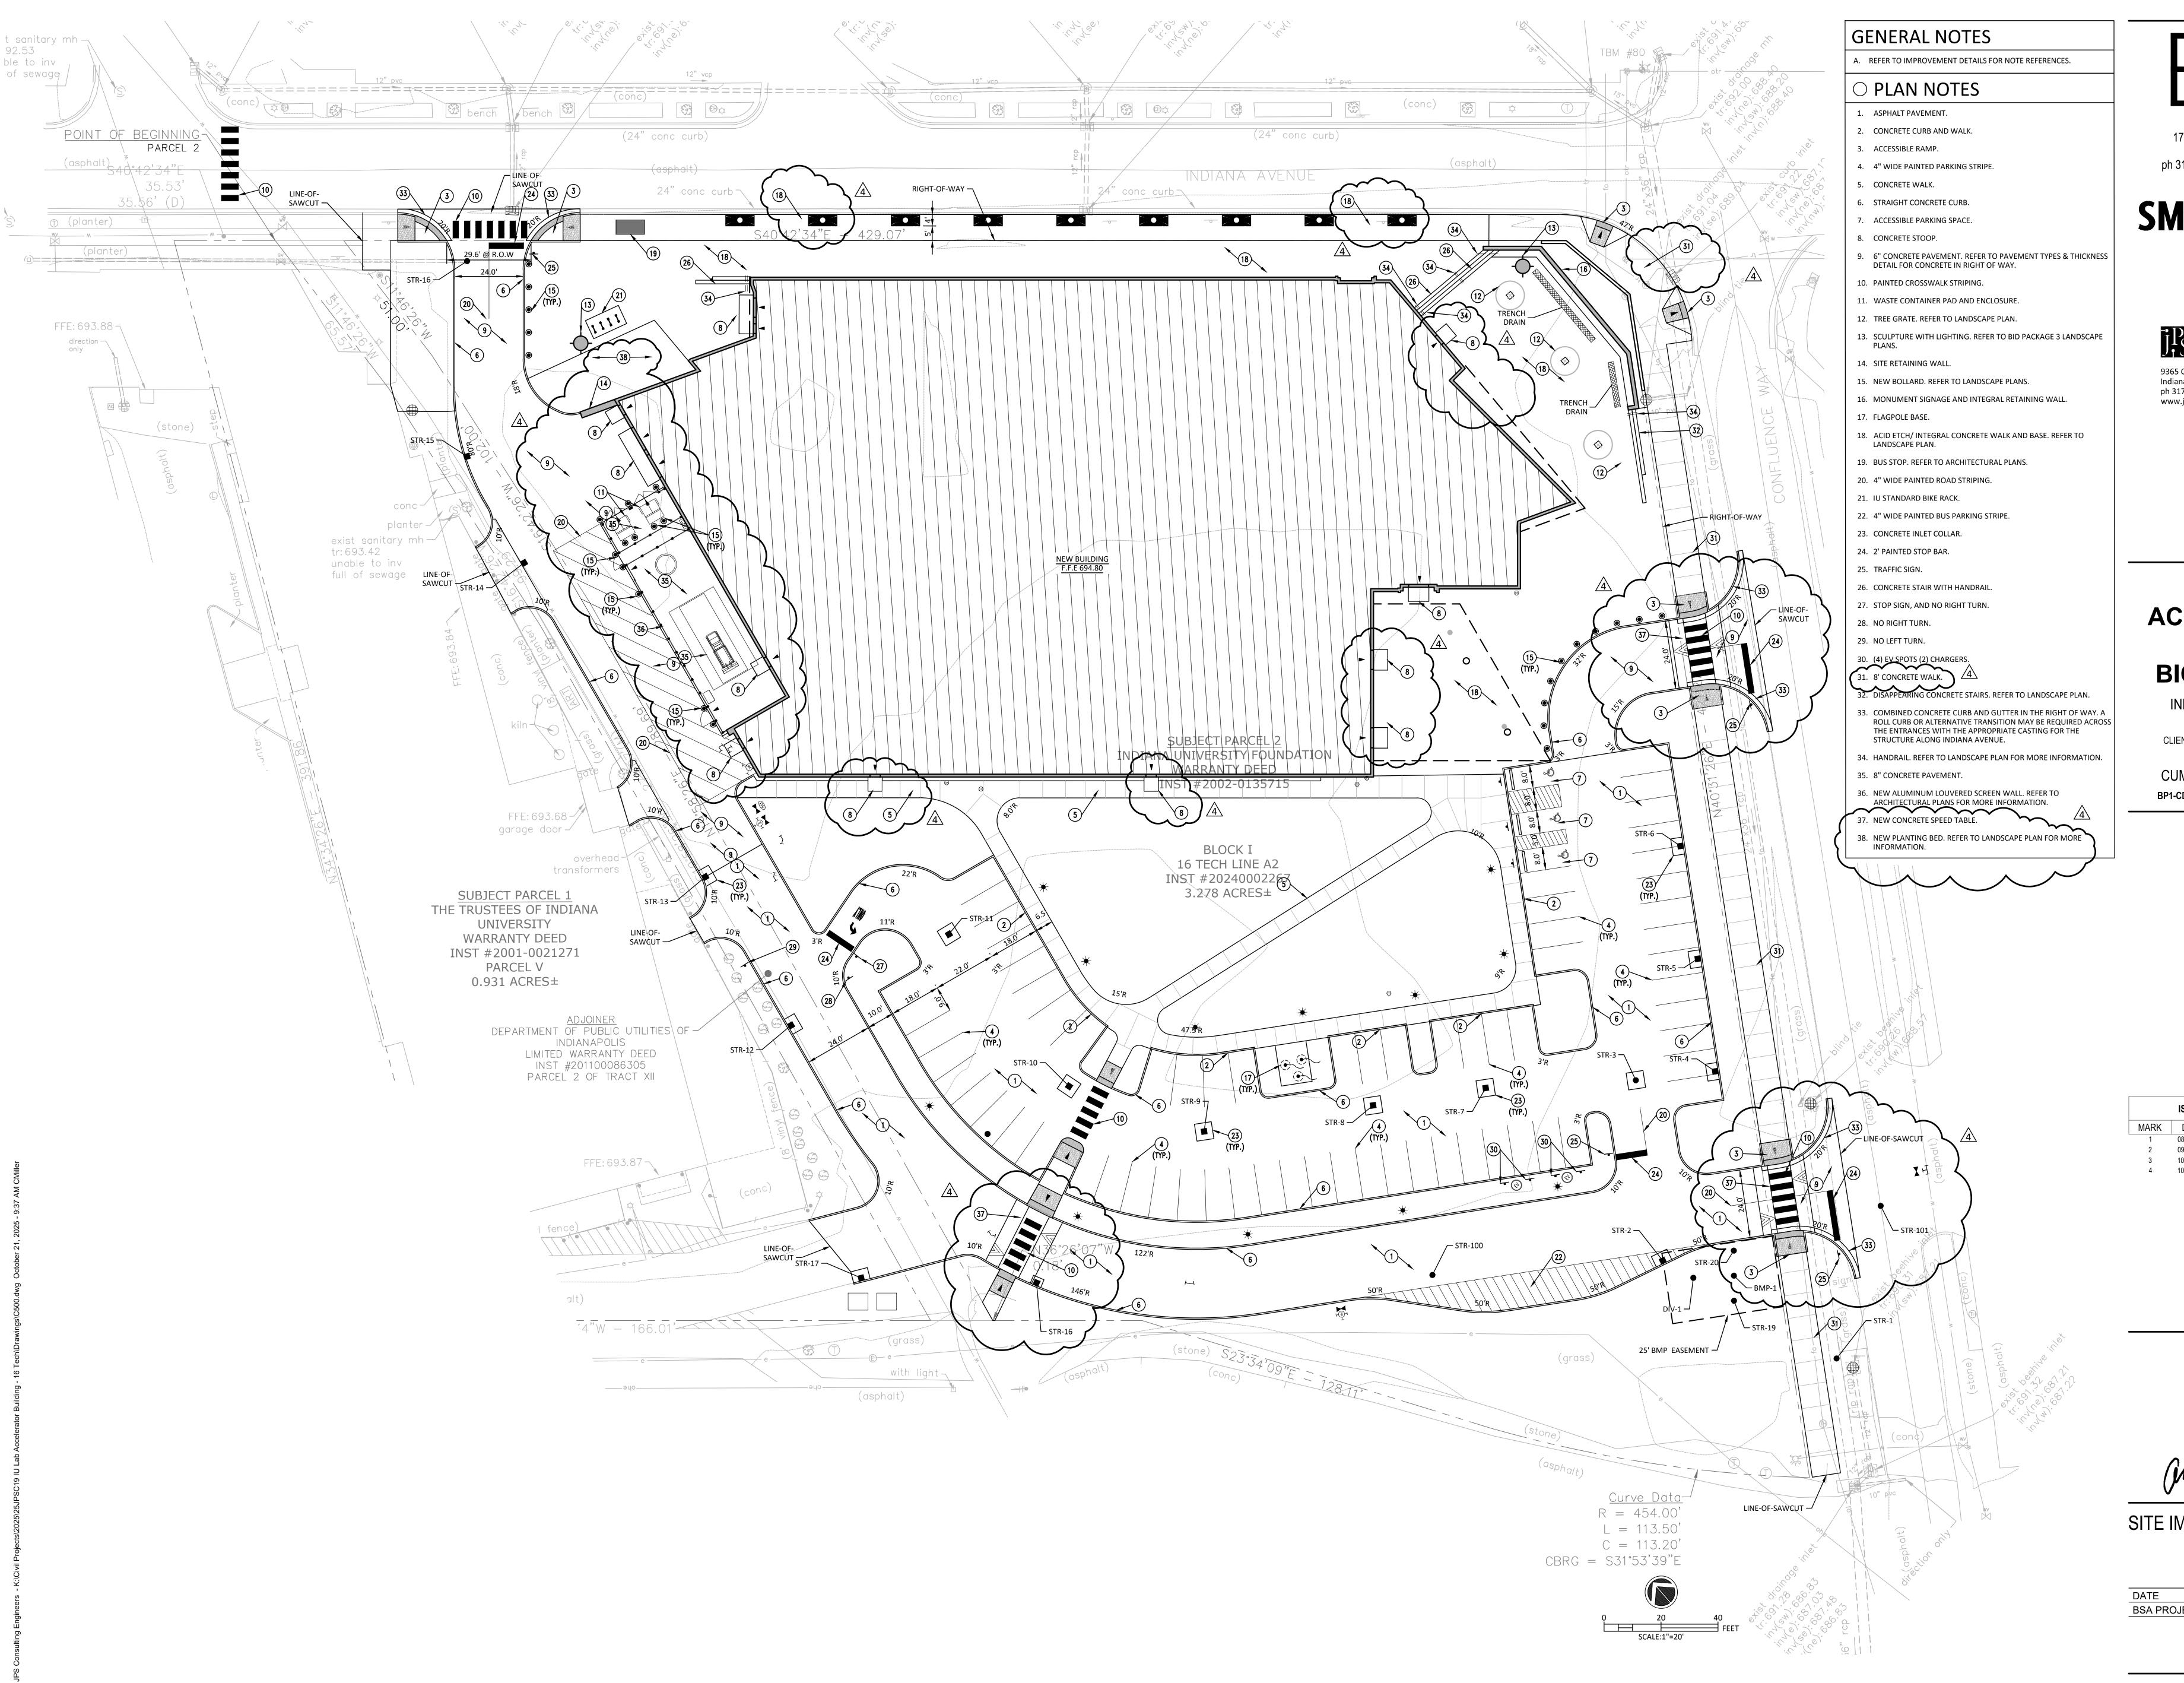

BSA

BSA LifeStructures 175 S. Rangeline Rd, Suite 200 Carmel, IN 46032 ph 317.819.7878 fx 317.819.7288

SMITHGROUP

500 GRISWOLD SUITE 1700 DETROIT, MI 48226 313.983.3600 smithgroup.com

smithgroup.com

CONSULTING
ENGINEERS,LLC

9365 Counselors Row, Suite 116 Indianapolis, IN 46240

Indianapolis, IN 46240 ph 317.617.4270 www.jpsconsultingengineers.com



LAUNCH ACCELERATOR FOR BIOSCIENCES

INDIANAPOLIS, INDIANA

CLIENT PROJECT NO. - 20250072

CUMULATIVE DOCUMENTS
BP1-CD: SITE AND FOUNDATION PACKAGE

ISSUED / REVISIONS SCHEDULE

DATE DESCRIPTION

08/15/2025 CITY SUBMITTAL
09/29/2025 BP1-CD: SITE AND FOUNDATION PACKAGE
10/15/2025 ADDENDUM #1


10/21/2025 ADDENDUM #2





SITE IMPROVEMENT PLAN

DATE BSA PROJECT NO.

C500

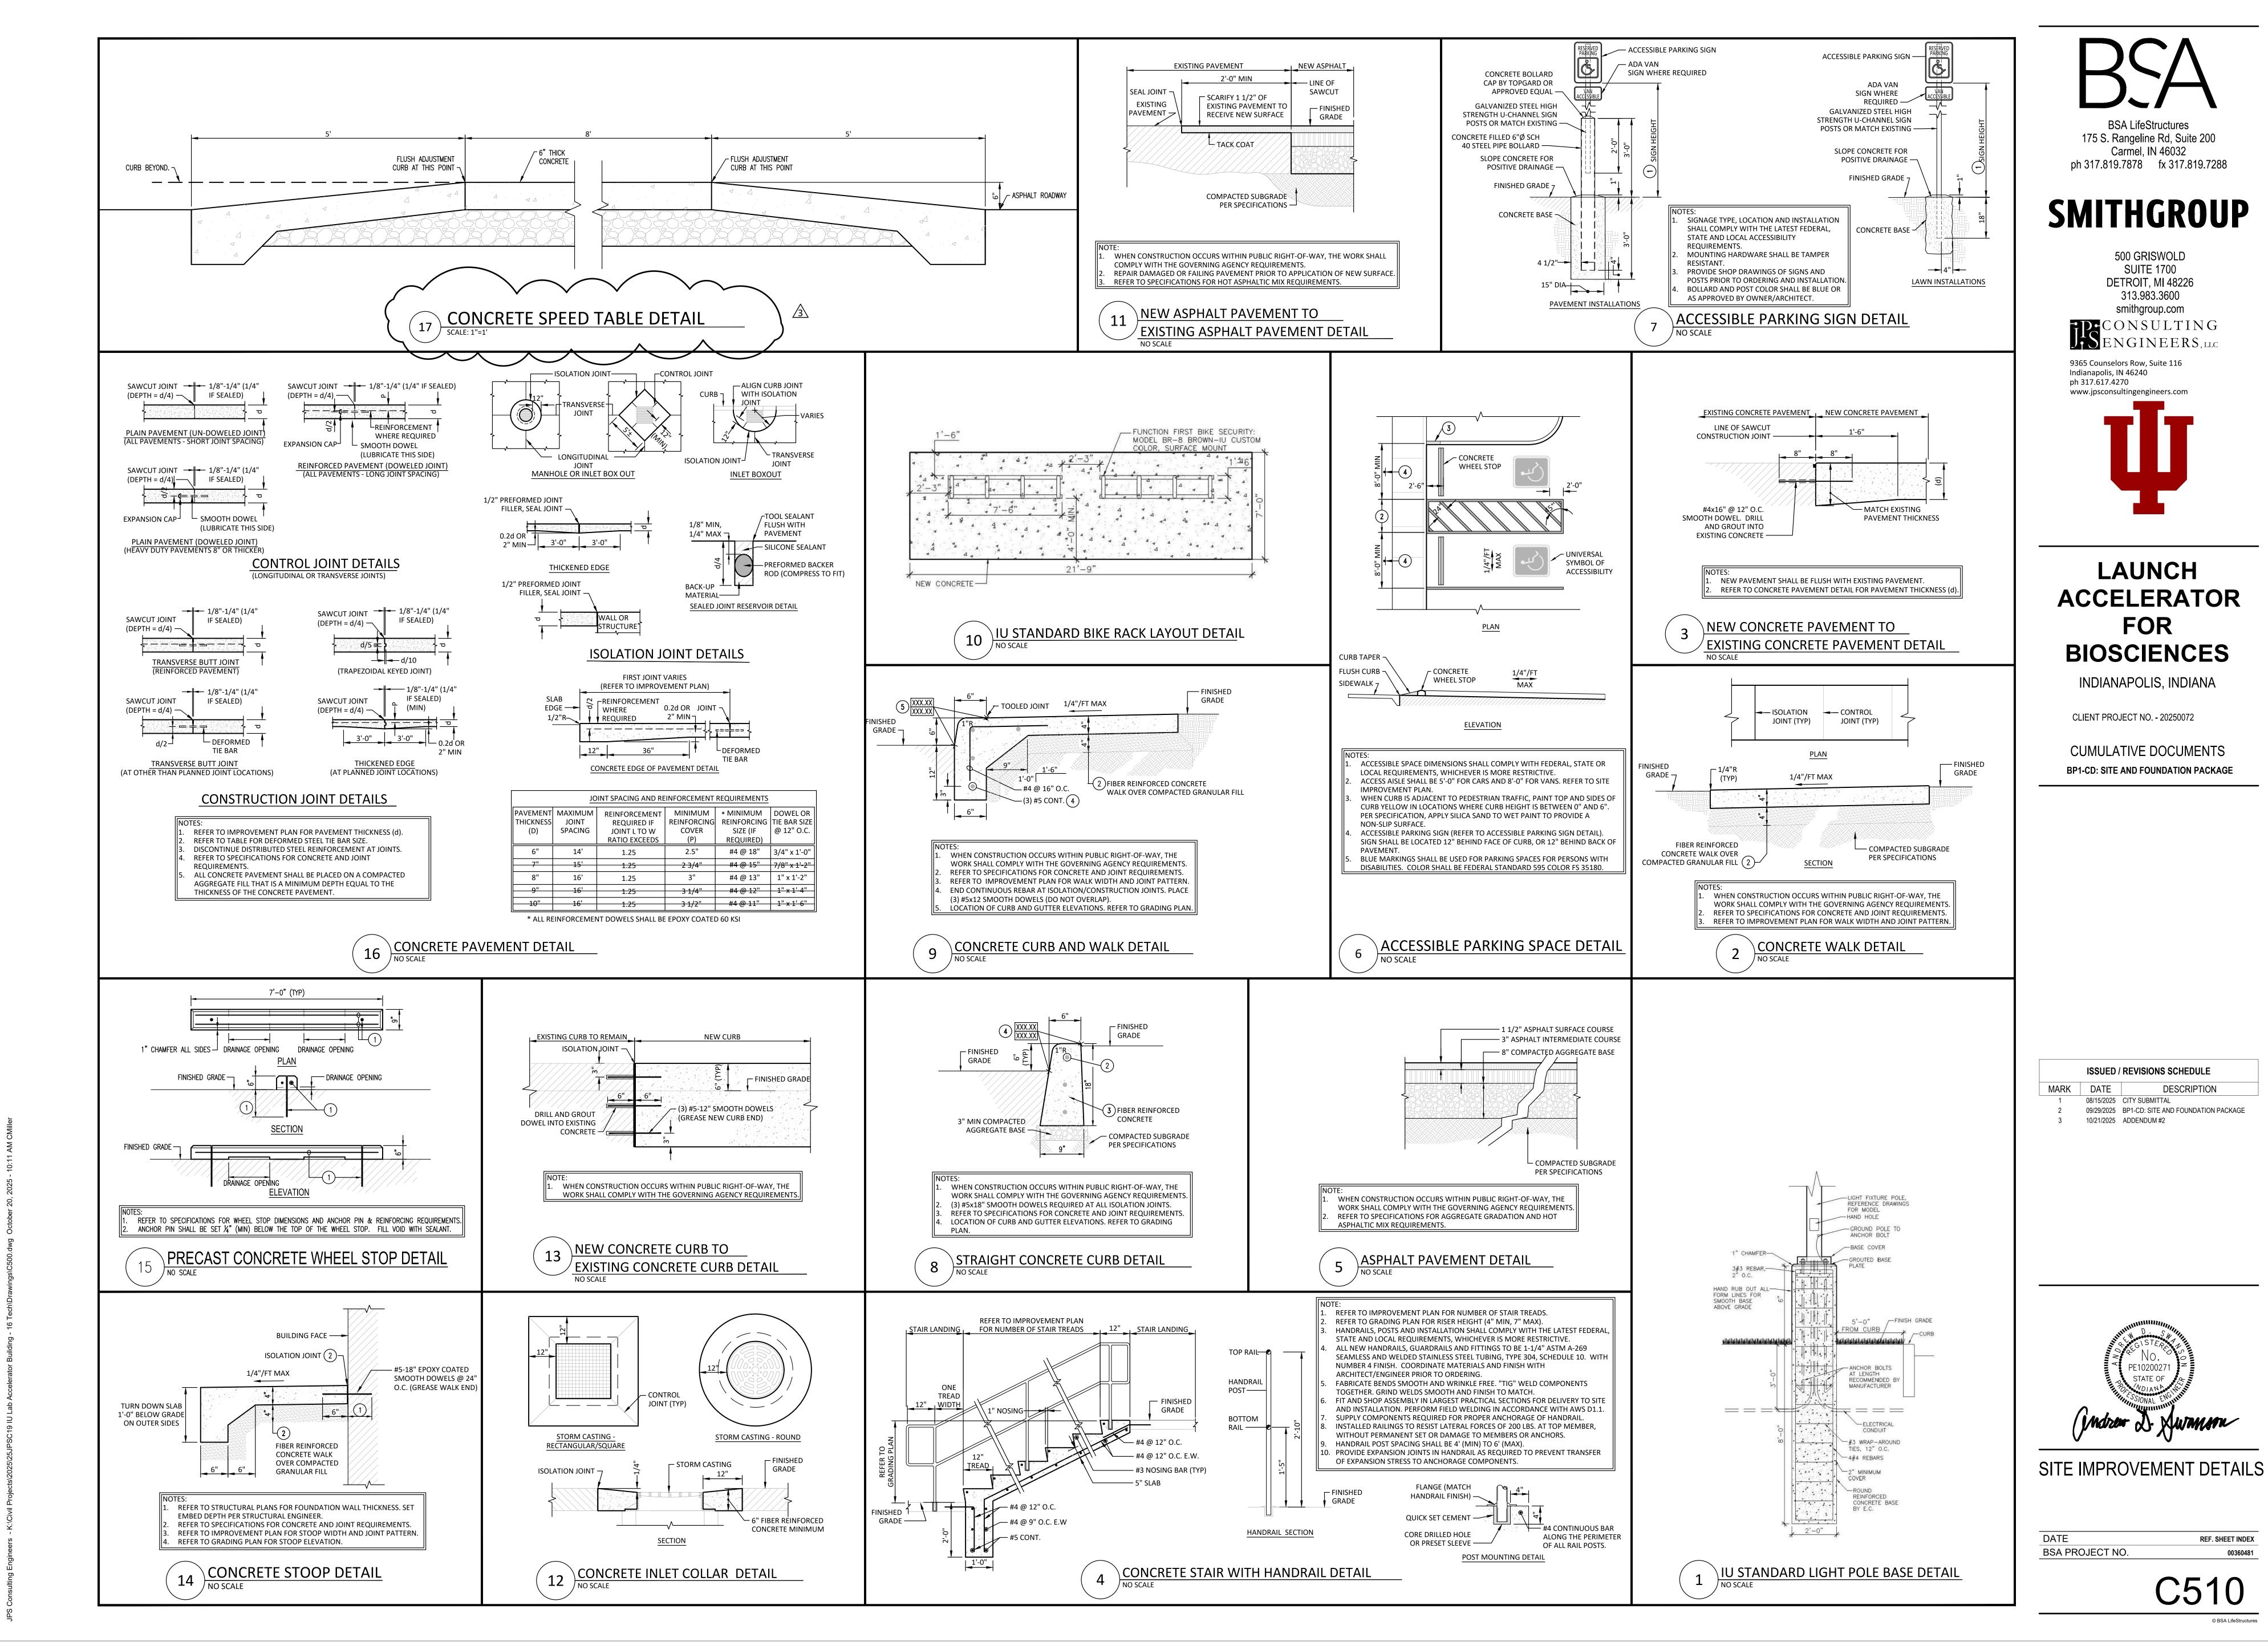

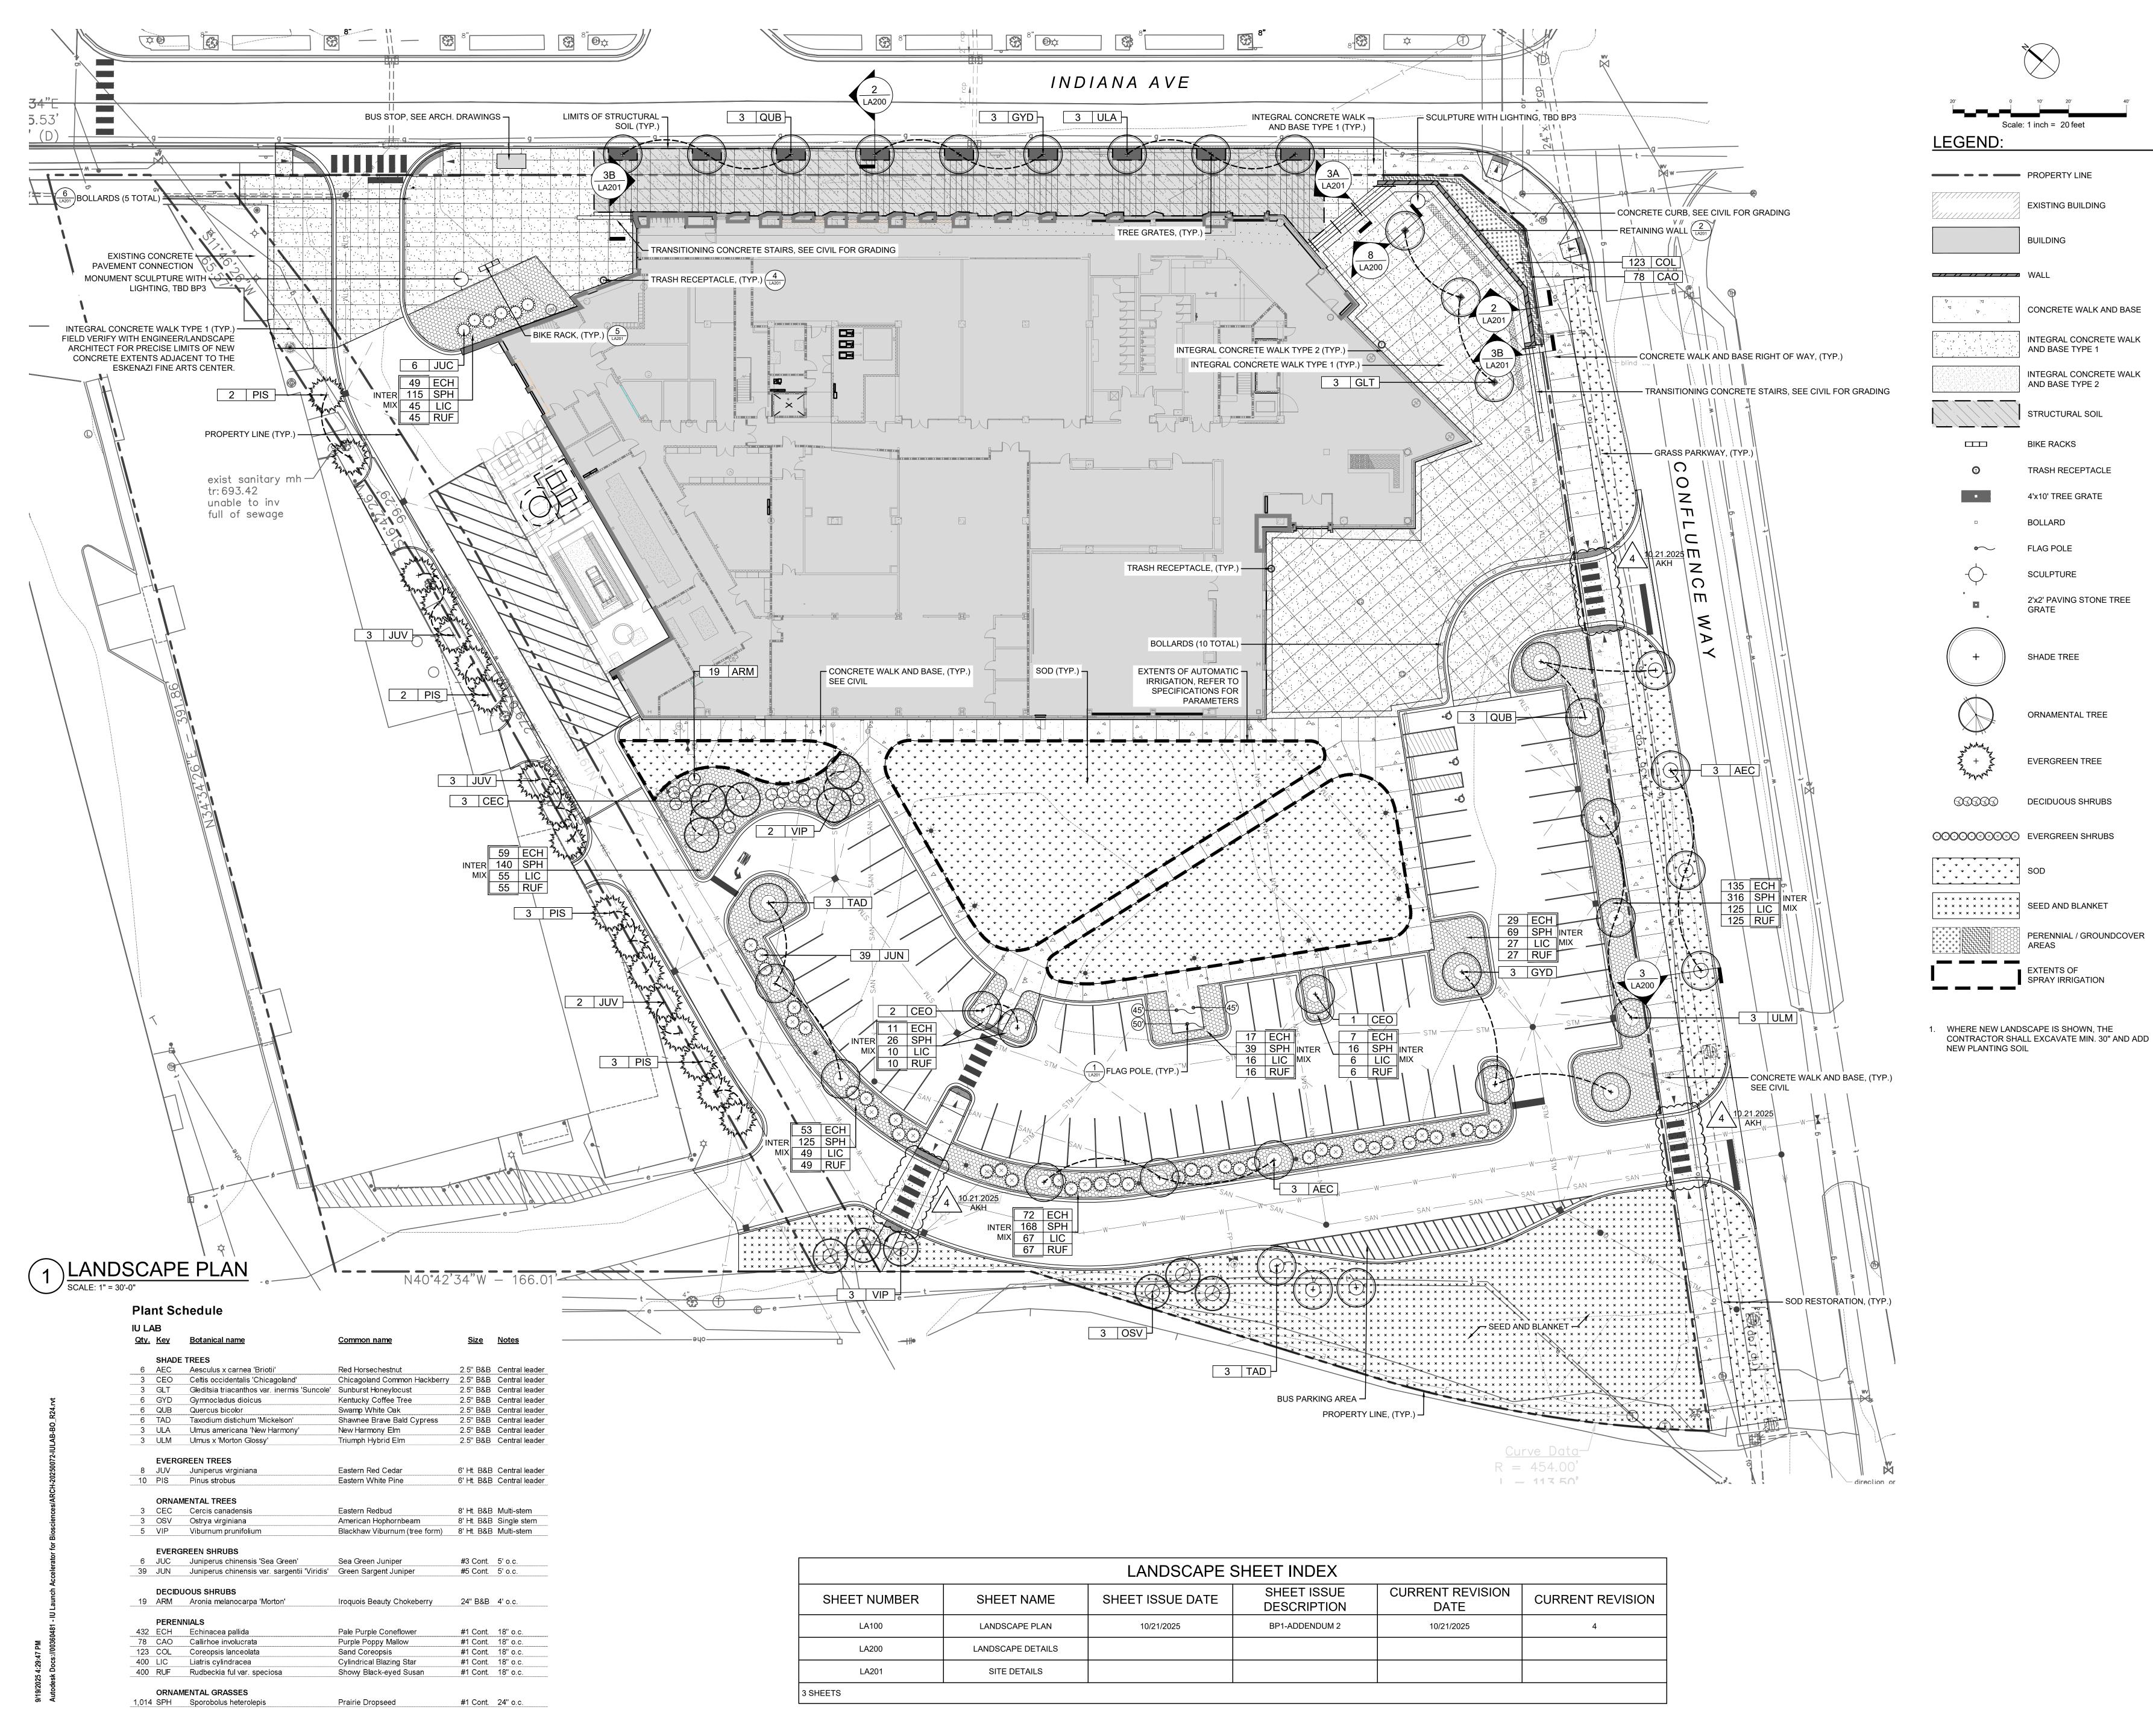

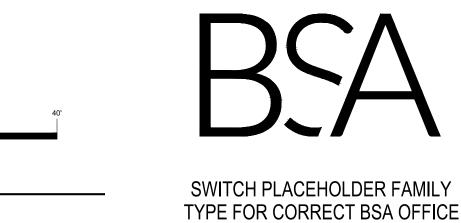

500 GRISWOLD SUITE 1700 DETROIT, MI 48226 313.983.3600 smithgroup.com



LAUNCH ACCELERATOR FOR BIOSCIENCES

INDIANAPOLIS, INDIANA

CLIENT PROJECT NO. - 20250072

CUMULATIVE DOCUMENTS
BP1-CD: SITE AND FOUNDATION PACKAGE

 ISSUED / REVISIONS SCHEDULE

 MARK
 DATE
 DESCRIPTION

 4
 10/21/2025
 BP1-ADDENDUM 02

 3
 10/15/2025
 BP1-ADDENDUM 01

09/29/2025 BP1-CD: SITE AND FOUNDATION PACKAGE



LANDSCAPE PLAN

DATE	REF: SHEET INDEX	
BSA PROJECT NO.	0036048 ²	

LA10

SHEET INDEX - ARCHITECTURAL / INTERIOR FINISH						
				CURRENT	CURRENT	
SHEET NUMBER	SHEET NAME	SHEET ISSUE DATE	SHEET ISSUE DESCRIPTION	REVISION DATE	REVISION	
VIMS						
FIGURE 1	TITLE SHEET AND GENERAL NOTES	09/29/2025 E	BP1-CD: SITE AND FOUNDATION PACKAGE	10/21/2025	2	
FIGURE 2	VIMS MEMBRANE AND COLLECTION PIPE LAYOUT (FOUNDATION)	09/29/2025 E	BP1-CD: SITE AND FOUNDATION PACKAGE	10/21/2025	2	
FIGURE 3	FIRST FLOOR VIMS PIPE RISER & TEST PIN LAYOUT	10/21/2025 E	BP1-CD: SITE AND FOUNDATION PACKAGE	10/21/2025	2	
FIGURE 4	SECOND FLOOR VIMS PIPE RISER LAYOUT	10/21/2025 E	BP1-CD: SITE AND FOUNDATION PACKAGE	10/21/2025	2	
FIGURE 5	THIRD FLOOR VIMS PIPE RISER LAYOUT	10/21/2025 E	BP1-CD: SITE AND FOUNDATION PACKAGE	10/21/2025	2	
FIGURE 6	FOURTH FLOOR VIMS PIPE RISER LAYOUT	10/21/2025 E	BP1-CD: SITE AND FOUNDATION PACKAGE	10/21/2025	2	
FIGURE 7	FIFTH FLOOR VIMS PIPE RISER LAYOUT	10/21/2025 E	BP1-CD: SITE AND FOUNDATION PACKAGE	10/21/2025	2	
FIGURE 8	PENTHOUSE FLOOR VIMS PIPE RISER LAYOUT	10/21/2025 E	BP1-CD: SITE AND FOUNDATION PACKAGE	10/21/2025	2	
FIGURE 9	ROOF VIMS PIPE RISER LAYOUT	10/21/2025 E	BP1-CD: SITE AND FOUNDATION PACKAGE	10/21/2025	2	
FIGURE 10	VIMS DETAIL MEMBRANE	09/29/2025 E	BP1-CD: SITE AND FOUNDATION PACKAGE	10/21/2025	2	
FIGURE 11	VIMS DETAIL PIPING & MISC	09/29/2025 E	BP1-CD: SITE AND FOUNDATION PACKAGE	10/21/2025	2	

NOTICE FOR CONTRACTOR

ALL CONTRACTORS AND SUBCONTRACTORS PERFORMING WORK SHOWN ON OR RELATED TO THESE PLANS SHALL CONDUCT THEIR OPERATIONS SO THAT ALL EMPLOYEES ARE PROVIDED A SAFE PLACE TO WORK AND THE PUBLIC IS PROTECTED. ALL CONTRACTORS AND SUBCONTRACTORS SHALL COMPLY WITH THE "OCCUPATIONAL SAFETY AND HEALTH REGULATIONS" OF THE U.S. DEPARTMENT OF LABOR AND ALL LOCAL AND STATE REGULATIONS.

THE OWNER AND THE VIMS DESIGNER SHALL NOT BE RESPONSIBLE IN ANY WAY FOR CONTRACTORS' AND SUBCONTRACTORS' COMPLIANCE WITH THE "OCCUPATIONAL SAFETY AND HEALTH REGULATIONS" OF THE U.S. DEPARTMENT OF LABOR AND ALL LOCAL AND STATE REGULATIONS.

CONTRACTOR AGREES THAT HE SHALL ASSUME SOLE AND COMPLETE RESPONSIBILITY FOR JOB SITE CONDITIONS DURING THE COURSE OF CONSTRUCTION OF THIS PROJECT, INCLUDING SAFETY OF ALL PERSONS AND PROPERTY, THAT THIS REQUIREMENT SHALL APPLY CONTINUOUSLY AND NOT BE LIMITED TO NORMAL WORKING HOURS. AND THAT THE CONTRACTOR SHALL DEFEND. INDEMNIFY. AND HOLD THE OWNER AND THE VIMS DESIGNER HARMLESS FROM ANY AND ALL LIABILITY REAL OR ALLEGED, IN CONNECTION WITH THE PERFORMANCE OF WORK ON THIS PROJECT, E CEPT FOR LIABILITY ARISING FROM THE SOLE NEGLIGENCE OF THE OWNER OR THE VIMS DESIGNER.

IN CASE OF CONFLICT BETWEEN THESE PLANS AND OTHER SITE DESIGN DOCUMENTS AND OR MANUFACTURER SPECIFICATIONS REQUIREMENTS. THE APPROPRIATE PARTIES COMPANIES WITH CONFLICTING DOCUMENTATION SHALL CONFER TO DETERMINE A MUTUALLY AGREED UPON SOLUTION.

I. <u>APPLICABILITY</u> A. GENERAL

- 1. A PASSIVE VAPOR INTRUSION MITIGATION SYSTEM (VIMS) SHALL BE INSTALLED AND WILL INCLUDE A VOC-ATTENUATING MEMBRANE (15-MIL THICKNESS WITH EVOH CORE), OR EQUIVALENT. UNDERLAIN BY A LOW-PROFILE VAPOR COLLECTION SYSTEM VENTED AT THE ROOF.
- 2. VIMS DETAILS PRESENTED IN THESE PLANS AND SPECIFICATIONS SHALL BE UTILI ED IN THE CONSTRUCTION OF THE BUILDING DESIGNATED ON PLANS. THE BASIS OF DESIGN IS THE INSTALLATION OF A SUBSLAB MEMBRANE AND ANY ASSOCIATED VENTING MATERIALS AS DESCRIBED IN THESE PLANS. MANUFACTURER REFERENCE TO THESE PRODUCTS IS PROVIDED BELOW AS APPROVED PROVIDERS OF THE MEMBRANE AND MATERIALS ONLY AND MAY BE SUBSTITUTED FOR EQUIVALENT PRODUCTS IF APPROVED BY THE VIMS DESIGNER.
 - ¹ STEGO INDUSTRIES LLC, SAN CLEMENTE, CA (877) 464-7834
- ² W.R. MEADOWS, INC., HAMPSHIRE, IL (847) 214-2100 ³ VIAFLE, SIOU FALLS, SD (605) 335-0174
 - ⁴ RADONAWAY, WARD HILL, MA (800) 767-3703.
 - ⁵ ISI BUILDING PRODUCTS, EAST PEORIA, IL (866) 698-6562 6 LAND SCIENCE A DIVISION OF REGENESIS, SAN CLEMENTE, CA (949) 481-8118
- 3. THE VIMS MEMBRANE WILL ALSO SERVE AS A MOISTURE-BLOCKING MEMBRANE AND WILL REPLACE ANY VAPOR OR MOISTURE BARRIER SPECIFIED IN THE STRUCTURAL DETAILS E CEPT FOR THE ELEVATOR PIT. INSTALLATION OF A MOISTURE OR VAPOR BARRIER BETWEEN THE VIMS MEMBRANE AND BUILDING FLOOR SLAB MAY VOID THE WARRANTY PROVIDED BY THE VIMS MEMBRANE MANUFACTURER.

B. SYSTEM COMPONENTS

- 1. THE VIMS CONSTRUCTION SHALL CONSIST OF, BUT NOT BE LIMITED TO, THE FOLLOWING a) SUPPLY AND INSTALL MINIMUM 4-INCH LAYER OF AGGREGATE BENEATH FOUNDATION SLAB

) SUPPLY AND INSTALL LOW PROFILE VAPOR COLLECTION PIPING AND ASSOCIATED FITTINGS

- c) SUPPLY AND INSTALL 4-INCH PVC CONVEYANCE PIPING
- d) SUPPLY AND INSTALL 4-INCH PVC TRANSITION PIPING
- e) SUPPLY AND INSTALL 15-MIL VOC-ATTENUATING MEMBRANE f) PERFORM SMOKE TESTING OF THE VIMS MEMBRANE
- g) SUPPLY AND INSTALL SCH. 40 PVC VERTICAL VENT RISER PIPING, SAMPLE PORTS WITH FITTINGS (QTY 1 PER CONVEYANCE TRUNKLINE)
- h) COMPLETE CONNECTION OF VERTICAL VENT RISER PIPING TO ROOF AS APPROPRIATE i) INSTALL ROOF-MOUNTED VENTILATORS
- 2. ALL MATERIALS ARE TO BE DELIVERED TO THE PROJECT SITE IN THEIR ORIGINAL UNBROKEN PACKAGES BEARING THE MANUFACTURER'S LABEL SHOWING BRAND, WEIGHT, VOLUME, BATCH NUMBER, AND DATE. MATERIALS ARE TO BE STORED AT THE PROJECT SITE IN STRICT COMPLIANCE WITH THE MANUFACTURER'S INSTRUCTIONS.

II. VAPOR INTRUSION MITIGATION SYSTEM A. VAPOR COLLECTION AND VENT SYSTEM

A.1 AGGREGATE LAYER

1. A MINIMUM 4-INCH LAYER OF GRAVEL AGGREGATE SHALL BE PROVIDED BENEATH THE FOUNDATION SLAB, AGGREGATE SHALL BE VIRGIN MATERIAL AS DOCUMENTED WITH A LETTER FROM THE QUARRY PROVIDED TO THE DESIGNER IN ADVANCE OF IMPORT. THE AGGREGATE LAYER SHALL BE FINE TO MEDIUM AGGREGATE AND CONTAIN NO MORE THAN 5 FINES (I.E., 5 FINES PASSING 200 SIEVE). THE GRADATION OF THE AGGREGATE PLACED BELOW THE MEMBRANE SHALL MEET THE FOLLOWING SPECIFICATIONS OR AS SPECIFIED IN THE GEOTECHNICAL REPORT IF APPROVED BY THE VIMS DESIGNER

GRAVEL					
	Percent	Passing			
Sieve	3/4" GRAVEL	3/8" GRAVEL			
1-1 2"	100	-			
1"	95100	-			
3 4"	90-100	100			
3 8"	20-55	70-95			
No.4	0-10	0-25			
No. 8	0-5	0-10			
ASTM C 131 Test Grading	B	C			

- 2. THE AGGREGATE WILL BE PLACED 2 INCHES ABOVE AND 1 INCH BELOW THE VAPOR COLLECTION PIPING AS SHOWN IN PLAN SHEET DETAILS.
- 3. ANY AGGREGATE REMOVED DURING PLACEMENT OF UTILITIES MUST BE PLACED BACK TO LEVEL GRADE AND COMPACTED AS SPECIFIED IN THE PROJECT PLANS AND SPECIFICATIONS. UTILITIES PLACED IN THE AGGREGATE LAYER MAY NOT BE LARGER THAN 1-INCH IN DIAMETER. UTILITIES LARGER THAN 1-INCH IN DIAMETER MUST BE BURIED INTO THE SUBGRADE SUCH THAT NO MORE THAN 1 INCH OF THE AGGREGATE LAYER IS AFFECTED.
- 4. THE SUBGRADE UNDER THE AGGREGATE SHALL BE ROLLED SMOOTH AND MOISTURE CONDITIONED AS NECESSARY TO ACHIEVE THE COMPACTION SPECIFIED IN THE GEOTECHNICAL

A.2 SUB-SLAB VAPOR COLLECTION PIPING

- 1. SUB-SLAB LOW PROFILE VAPOR COLLECTION PIPING SHALL BE COMPRISED OF 1-FOOT WIDE BY 1-INCH-THICK CORRUGATED HDPE PIPING WRAPPED IN GEOTE TILE OR EQUIVALENT AS APPROVED BY THE VIMS DESIGNER (SEE DETAILS ON PLANS).
- 2. VAPOR COLLECTION PIPING SHALL BE INSTALLED AT LOCATIONS SHOWN ON PLANS AND PLACED WITHIN THE MINIMUM 4-INCH AGGREGATE LAYER, LOW PROFILE VAPOR COLLECTION PIPING SHALL BE PLACED SUCH THAT NO AREA BENEATH THE SLAB FOUNDATION IS MORE THAN 10 FEET FROM THE VAPOR COLLECTION PIPING AND THE PIPING IS NO CLOSER THAN 12 INCHES FROM SURFACES THAT REPRESENT SIDES OF THE SOIL GAS COLLECTION PLENUM.
- 3. VAPOR COLLECTION PIPING SHALL BE TRANSITIONED TO 4-INCH SOLID SCHEDULE 40 PVC CONVEYANCE PIPING TO THE VENT RISERS, CONNECTING TO SCH. 40 PVC ELBOWS (OR EQUIVALENT) TURNING UP THROUGH THE FLOOR SLAB ADJACENT TO FOUNDATION FOOTINGS AND STRUCTURAL COLUMNS. ALL TRANSITION PIPING SHALL BE IN PLACE PRIOR TO POURING FOUNDATION GRADE BEAMS OR FOOTINGS WHEN POURED SEPARATELY FROM THE FLOOR SLAB. THE PIPING TRANSITIONS SHALL BE ACCOMPLISHED IN COMPLIANCE WITH ALL APPLICABLE BUILDING CODES AND WITH THE APPROVAL OF THE PROJECT STRUCTURAL ENGINEER AND OR BUILDING OFFICIAL. (SEE DETAIL PLANS).

A.3 ABOVE SLAB VAPOR COLLECTION RISER

- 1. TRANSITION PIPING THROUGH THE FLOOR SHALL BE CONNECTED EITHER TO RISERS OF EQUAL OR GREATER CROSS-SECTIONAL AREA E TENDING UP THE ENTIRE
- CONNECTED TO A 4-INCH RISER SEGMENT FITTED WITH A 4-INCH SHUTOFF VALVE AND THEN MANIFOLDED WITH ONE OTHER 4-INCH SEGMENT FOLLOWED BY A CONNECTION TO A 6-INCH RISER E TENDING THE REMAINING HEIGHT OF THE BUILDING.
- LOCATED WITHIN THE WALLS CHASES OR INSTALLED ADJACENT TO INTERIOR SUPPORT COLUMNS (SEE DETAIL PLANS AND REFER TO ARCHITECTURAL SCHEMATICS)

3. THE RISER PIPE TO THE ROOF SHALL BE FULLY SUPPORTED THROUGH THE ENTIRE HEIGHT OF THE

2. VENT RISER TO THE ROOF SHALL BE COMPRISED OF SCH. 40 PVC PIPE. RISER PIPING SHALL BE

- BUILDING WITH PIPE CLAMPS OR SIMILAR. SUCH THAT NO DOWNWARD FORCE (DUE TO THE WEIGHT OF THE RISER PIPE) IS E ERTED ON THE SUBSLAB VENTING SYSTEM.
- 4. IF INSTALLED IN AN INTERIOR WALL, AN 8" 8" MEDIUM SECURITY ACCESS PANEL SHALL BE INSTALLED BETWEEN 2 AND 5 FEET ABOVE THE FLOOR SLAB IN ORDER TO ACCESS THE VENT SYSTEM FOR AIR FLOW RATE MONITORING (SEE DETAILS ON PLANS).
- 5. A 304 STAINLESS STEEL HE REDUCING BUSHING (MNPT FNPT, 1 2" 1 4") SHALL BE TAPPED INTO THE PIPING AND SEALED PERMANENTLY FOR GAS-TIGHT APPLICATIONS. A QUICK-CONNECT COUPLER SHALL BE INSTALLED IN THE BUSHING AND SEALED WITH TEFLON TAPE TO ALLOW FOR REMOVAL DURING MONITORING (SEE DETAIL ON PLANS).
- 6. THE RISER PIPES SHALL BE EQUIPPED WITH SHUTOFF VALVES TO ALLOW FOR SHUTOFF OF AIR FLOW ABOVE THE VALVE DURING SAMPLING OR IN THE EVENT THAT THE PASSIVE SYSTEM IS CONVERTED TO AN ACTIVE SYSTEM. THIS VALVE SHALL BE INSTALLED INLINE ABOVE THE ROOF LINE (SEE DETAIL ON PLANS).
- 7. PLACARDS SHALL BE INSTALLED ON EACH VENT RISER APPRO IMATELY EVERY 5 FEET AND AT ANY E POSED RISER PIPING (SEE DETAIL PLANS).
- 8. A VIMS MEMBRANE IDENTIFICATION SIGN SHALL BE INSTALLED IN UTILITY AND MECHANICAL ROOMS (SEE DETAIL PLANS). THIS SIGN IS TO BE PLACED ON THE WALLS AT EYE LEVEL AND SHALL NOT BE COVFRED OVER. THE LOCATION OF THIS NOTIFICATION WILL BE DETERMINED BY THE CONTRACTOR, OWNER, OR BUILDING OFFICIAL.

A.4 PASSIVE VENTILATOR

- 1. A PASSIVE VENTILATOR CAPABLE OF 26 CFM WITH A 4 MPH WIND SHALL BE INSTALLED AT THE TOP OF EACH VENT RISER PIPE ABOVE THE ROOF LINE. THE VENTILATORS SHALL INCLUDE BASES, REDUCING COUPLINGS, AND ALL OTHER REQUIRED ACCESSORIES FOR A SECURE CONNECTION TO THE VENT RISER PIPING.
- 2. THE AURA AV ROOF VENT IS AN ACCEPTABLE PASSIVE VENTILATOR (SEE DETAIL PLANS). THESE PRODUCTS ARE MANUFACTURED BY ACTIVE VENTILATION PRODUCTS, INC., 1-800-247-3463
- 3. THE PASSIVE VENTILATORS SHALL BE INSTALLED IN ACCORDANCE WITH INDUSTRY STANDARDS AS RECOMMENDED BY THE MANUFACTURER.
- 4. RISER PIPES SHALL TERMINATE A MINIMUM OF 24 INCHES ABOVE THE ROOF-LINE, EQUIPPED AND BRACED APPROPRIATELY IN ACCORDANCE WITH APPLICABLE BUILDING CODES (SEE DETAIL
- 5. ROOF-MOUNTED VENTILATORS SHALL BE LOCATED AT A DISTANCE OF NOT LESS THAN 15 FEET FROM ANY BUILDING AIR INTAKE.

B. VIMS MEMBRANE

B.1 MATERIALS 1. THE VIMS MEMBRANE SHALL CONSIST OF A VOC-ATTENUATING MULTI-LAYERED BARRIER MANUFACTURED USING HIGH QUALITY VIRGIN-GRADE PLASTIC E TRUDED RESINS. ALONG WITH

EMBEDDED VAPOR-PIN (OR EQUIVALENT) PORTS LOCATED AS SHOWN ON PLANS.

2. INSTALLATION OF THE MEMBRANE SHALL BE IN ACCORDANCE WITH THE MANUFACTURER'S SPECIFICATIONS UNLESS OTHERWISE SPECIFIED AND APPROVED BY THE VIMS DESIGNER.

- **B.2 MEMBRANE INSTALLATION** 1. THE VIMS MEMBRANE SHALL CONSIST OF A VOC-ATTENUATING MEMBRANE AS APPROVED BY THE VIMS DESIGNER. THE MEMBRANE SHALL HAVE A THICKNESS OF 15 MILS WITH EVOH CORE, OR EQUIVALENT, AND INSTALLED IN ACCORDANCE WITH THE MANUFACTURER'S SPECIFICATIONS
- UNLESS OTHERWISE SPECIFIED AND APPROVED BY THE VIMS DESIGNER. 2. THE VIMS MEMBRANE SHALL BE PLACED BENEATH THE FLOOR SLAB, FOOTINGS, AND TRENCHES IN ACCORDANCE WITH THESE PLANS AND DETAILS. THE VIMS MEMBRANE SHALL NOT BE PLACED ON
- TOP OF ANY CONCRETE PIERS OR E TENDED REBAR. 3. SEAMS SHALL BE OVERLAPPED A MINIMUM OF 12 INCHES AND SEALED IN ACCORDANCE WITH THE SPECIFICATIONS SET FORTH IN THESE PLANS (SEE DETAIL PLANS).
- 4. THE ELEVATOR PIT WILL BE SEALED FOR PROTECTION AGAINST WATER INGRESS BY THE CONTRACTOR RESPONSIBLE FOR WATERPROOFING AND IS THEREFORE OUTSIDE THE SCOPE OF THESE SPECIFICATIONS.

B.3 PENETRATION SEALS

1. WHERE UTILITIES, VENT LINES, PIPING, ELECTRICAL CONDUITS, VAPOR-PINS ETC. PENETRATE THE VIMS MEMBRANE, A PIPE BOOT, OR EQUIVALENT SEAL AND FORM, SHALL BE PROVIDED TO CREATE A GAS-TIGHT SEAL AROUND THE PENETRATION IN ACCORDANCE WITH THE MANUFACTURER'S SPECIFICATIONS AS SHOWN ON DETAIL PLANS.

WHERE PENETRATIONS SUCH AS ELECTRICAL UTILITY CONDUITS, PLUMBING PIPING, ETC., ARE CONCENTRATED, A CONCRETE PENETRATION BANK WILL BE CONSTRUCTED TO SECURE THE PENETRATIONS IN PLACE. THE PENETRATION BANK SHALL BE CONSTRUCTED USING A MINIMUM. THICKNESS OF 12 INCHES OF NON-SHRINK GROUT E TENDING A MINIMUM OF 8 INCHES FROM ANY PENETRATION, ALLOWING FOR A MINIMUM 6-INCH ATTACHMENT OF THE VIMS MEMBRANE, SIMILAR TO AN ATTACHMENT TO AN INTERIOR FOOTING. THE TOP OF THE PENETRATION BANK SHALL BE BELOW THE BOTTOM OF THE SLAB. PENETRATIONS SHALL NOT BE IN CONTACT WITH ADJACENT PENETRATIONS OR OTHER OBJECTS TO ALLOW PROPER SEALING AROUND THE ENTIRE PENETRATION CIRCUMFERENCE. A LIQUID SEALANT WITHIN A FORM MAY ALTERNATIVELY BE USED ACCORDING TO MANUFACTURER SPECIFICATIONS (SEE DETAIL PLANS).

- 1. THE VIMS SUBCONTRACTOR SHALL BE E PERIENCED WITH VOC-ATTENUATING MEMBRANE INSTALLATION. THE VIMS SUBCONTRACTOR RETAINED BY THE OWNER FOR THE PERFORMANCE OF THIS SCOPE OF WORK IS TO BE TRAINED AND E PERIENCED WITH THE INSTALLATION OF SIMILAR **PRODUCTS**
- 2. A PRE-INSTALLATION CONFERENCE SHALL BE HELD PRIOR TO THE APPLICATION OF THE VIMS MEMBRANE TO COORDINATE PROPER SUBSTRATE AND INSTALLATION CONDITIONS AND PROCEDURES. THE VIMS SUBCONTRACTOR, SITE SUPERINTENDENT, THE FOUNDATION SUBCONTRACTOR, SUBSLAB UTILITY CONTRACTORS, AND THE VIMS DESIGNER SHALL BE PRESENT
- 3. THE INSTALLATION OF THE VIMS MEMBRANE SHALL BE CLOSELY MONITORED BY THE VIMS DESIGNER OR DESIGNATED REPRESENTATIVE. INSPECTIONS SHALL TYPICALLY BE PERFORMED PRIOR TO, DURING, AND SUBSEQUENT TO THE INSTALLATION OF THE VAPOR COLLECTION PIPING AND APPLICATION OF THE VIMS MEMBRANE. IT IS THE RESPONSIBILITY OF THE VIMS SUBCONTRACTOR TO NOTIFY THE OWNER AND VIMS DESIGNER WITHIN 72 HOURS OF BEGINNING ANY PORTION OF THIS WORK.
- 4. ALL SURFACES TO RECEIVE THE VIMS MEMBRANE TERMINATIONS SHALL BE INSPECTED AND APPROVED BY THE VIMS SUBCONTRACTOR FOR THE PERFORMANCE OF THIS SCOPE OF WORK AND BY THE VIMS DESIGNER PRIOR TO COMMENCING WORK.
- 5. PRIOR TO PLACING THE FLOOR SLAB OVER THE MEMBRANE, THE VIMS DESIGNER SHALL INSPECT AND APPROVE THE MEMBRANE IN ACCORDANCE WITH THESE PLANS AND SPECIFICATIONS. CONSTRUCTION OF THE FLOOR SLAB SHALL NOT PROCEED WITHOUT WRITTEN CERTIFICATION OF THE SUCCESSFUL INSTALLATION BY THE VIMS SUBCONTRACTOR.

D. SUBMITTALS

- 1. THE VIMS SUBCONTRACTOR SHALL SUBMIT ANY UPDATES OR REVISIONS TO THE MANUFACTURER'S MATERIAL DATA AND RECOMMENDED INSTALLATION PROCEDURES TO THE VIMS DESIGNER FOR REVIEW AND APPROVAL AT LEAST ONE WEEK PRIOR TO THE CONSTRUCTION OF THE VIMS MEMBRANE
- 2. THE VIMS SUBCONTRACTOR SHALL SUBMIT REPRESENTATIVE SAMPLES OR MANUFACTURER'S PRODUCT SPECIFICATIONS OF THE FOLLOWING TO THE VIMS DESIGNER FOR APPROVAL

VOC-ATTENUATING MEMBRANE

AGGREGATE MATERIAL LOW PROFILE VAPOR COLLECTION PIPING

3. AT THE COMPLETION OF INSTALLATION, THE VIMS SUBCONTRACTOR SHALL SUBMIT A LETTER TO THE VIMS DESIGNER AND TO THE OWNER CERTIFYING THAT VIMS INSTALLATION WAS COMPLETED IN ACCORDANCE WITH THE PROJECT PLANS AND SPECIFICATIONS. AS WELL AS MANUFACTURER SPECIFICATIONS.

E. WARRANTY

- I. KERAMIDA RECOMMENDS THE OWNER OBTAIN A WARRANTY FOR THE VIMS MEMBRANE. THE MANUFACTURER PROVIDES PRODUCT AND OR SYSTEM WARRANTIES FOR THE VIMS MEMBRANE OF NOT LESS THAN 2 YEARS FROM THE DATE OF INSTALLATION.
- . THE VIMS MANUFACTURER MAY REQUIRE SUBMITTAL OF DESIGN DOCUMENTS, ENVIRONMENTAL REPORTS. GEOTECHNICAL REPORTS. OR OTHER DOCUMENTATION FOR REVIEW PRIOR TO ISSUING A WARRANTY, AND ADDITIONAL COSTS MAY APPLY. PLEASE CONTACT THE SELECTED MANUFACTURER FOR WARRANTY TERMS AND CONDITIONS AND ADDITIONAL INFORMATION.
- 3. MANUFACTURERS' E TENDED WARRANTIES MUST BE REQUESTED BY THE OWNER PRIOR TO VIMS INSTALLATION BID REQUESTS.

- 1. WORK IS TO BE PERFORMED ONLY WHEN E ISTING AND FORECASTED WEATHER CONDITIONS ARE WITHIN THE MANUFACTURER'S RECOMMENDATIONS FOR THE MATERIAL AND PRODUCTS USED THE APPLICATION OF THE VIMS MEMBRANE SHALL BE SUSPENDED IF THE AMBIENT TEMPERATURE FALLS BELOW 40 F OR ABOVE 110 F, OR DURING PERIODS OF PRECIPITATION. APPLICATION OF THE VIMS MEMBRANE MAY BE PERFORMED BELOW 40 F, BUT ONLY WITH WRITTEN PERMISSION FROM THE VIMS DESIGNER AND MATERIAL MANUFACTURER.
- 2. 2. ALL PLUMBING, ELECTRICAL, MECHANICAL, AND STRUCTURAL ITEMS THAT ARE LOCATED BENEATH OR THAT PASS THROUGH THE VIMS MEMBRANE SHALL BE POSITIVELY SECURED IN THEIR PROPER POSITIONS AND APPROPRIATELY PROTECTED PRIOR TO INSTALLATION OF VIMS **MEMBRANE**
- 3. THE VIMS MEMBRANE SHALL BE INSTALLED BEFORE PLACEMENT OF REINFORCING STEEL
- 4. REINFORCING STEEL, PIPING, FORMS, ETC. SHALL NOT BEAR DIRECTLY ON THE MEMBRANE, AND EQUIPMENT SHALL NOT BE DRIVEN OVER THE MEMBRANE WITHOUT PRIOR APPROVAL FROM THE VIMS DESIGNER AND MANUFACTURER.

5. STAKES USED TO SECURE THE CONCRETE FORMS SHALL NOT PENETRATE THE VIMS MEMBRANE

- AFTER IT HAS BEEN INSTALLED. IF STAKES NEED TO PUNCTURE THE MEMBRANE AFTER IT HAS BEEN INSTALLED, THE VIMS DESIGNER AND INSTALLER SHOULD BE NOTIFIED, AND NECESSARY REPAIRS NEED TO BE MADE BY THE VIMS SUBCONTRACTOR. 6. FIELD SITUATIONS NOT SPECIALLY DETAILED SHALL BE HANDLED PER THE INTENT OF THESE
- PLANS AND SPECIFICATIONS WITH THE APPROVAL OF THE VIMS DESIGNER. THE APPLICATOR CONTRACTOR MAY SUBMIT SHOP DRAWINGS FOR ALTERNATIVE METHODS. SEE STRUCTURAL FOUNDATION PLANS FOR COMPLETE DEPTHS AND DETAILS OF FOOTING. DEPTHS OF FOOTINGS SHOWN IN THESE PLANS ARE GENERALI ED, ACTUAL FOOTING DEPTHS MAY VARY. 7. APPROPRIATE CARE SHALL BE E RECISED TO PROTECT THE VIMS MEMBRANE AND PREVENT
 - PENETRATIONS SUBSEQUENT TO ITS APPLICATION. THE VIMS MEMBRANE SHALL BE PROTECTED FROM EQUIPMENT TRAFFIC, LIMITED LIGHT PEDESTRIAN TRAFFIC, AND BE KEPT FREE OF DIRT AND DEBRIS. TO THE E TENT POSSIBLE, UNTIL THE FLOOR SLAB IS POURED, IT SHALL BE THE RESPONSIBILITY OF THE GENERAL CONTRACTOR TO ENSURE THAT THE VIMS MEMBRANE IS NOT PENETRATED AFTER THE COMPLETION OF THE INSTALLATION.

G. INSTALLATION **G.1 VAPOR COLLECTION PIPING INSTALLATION**

- 1. VAPOR COLLECTION PIPING SHALL BE CONNECTED TO PROVIDE A GAS-TIGHT SEAL AT ALL CONNECTIONS AND FITTINGS AND SHALL BE CONSTRUCTED OF MATERIALS THAT COMPLY WITH THE UNIFORM PLUMBING AND MECHANICAL CODES. ALL JOINTS SHALL BE TIGHTLY SEALED WITH APPROVED MATERIALS. ANY GLUE OR SOLVENT USED TO SEAL THE PIPING MUST BE LOW VOC.
- 2. PLACEMENT OF AGGREGATE ABOVE THE PIPING SHALL NOT BEGIN BEFORE THE VIMS DESIGNER HAS INSPECTED THE GRADE AND ALIGNMENT OF THE PIPING, THE BEDDING OF THE PIPING, AND THE JOINTS BETWEEN THE PIPING. ALL PIPING LOCATED WITHIN THE AGGREGATE LAYER SHALL BE PROTECTED FROM PHYSICAL DAMAGE.
- 3. SOLID RISER PIPE VERTICAL STACK PIPE SHALL BE LOCATED WITHIN THE WALLS CHASES OR SHALL BE SIMILARLY PROTECTED FROM PHYSICAL DAMAGE. DAMAGE INCURRED DURING CONSTRUCTION OR OCCUPANCY COULD AFFECT SYSTEM PERFORMANCE.

G.2 VIMS MEMBRANE INSTALLATION

- 1. THE SUBGRADE SHALL BE MOISTURE CONDITIONED AND COMPACTED BY THE GRADING CONTRACTOR AS SPECIFIED IN THE PROJECT PLANS AND SPECIFICATIONS. THE FINISHED SURFACE SHALL BE SMOOTH, UNIFORM, AND FREE OF DEBRIS AND STANDING WATER. FINAL SUBGRADE INSPECTION PREPARATION SHALL NOT PRECEDE THE VIMS INSTALLATION BY MORE
- 2. THE AGGREGATE LAYER SHALL BE MOISTURE CONDITIONED AND COMPACTED AS SPECIFIED IN THE PROJECT PLANS AND SPECIFICATIONS.
- 3. IF THE VIMS MEMBRANE IS TO BE PLACED ON A CONCRETE SURFACE, CONCRETE SURFACES SHALL BE LIGHT BROOM FINISHED OR SMOOTHED, FREE OF ANY DIRT, DEBRIS, LOOSE MATERIAL, RELEASE AGENTS, OR CURING COMPOUNDS, ALL VOIDS MORE THAN 1 4-INCH IN WIDTH SHALL BE PROPERLY FILLED WITH NON-SHRINK GROUT OR AS SPECIFIED IN THE PROJECT PLANS AND
- 4. ALL VIMS MEMBRANE PENETRATIONS SHALL BE PREPARED IN ACCORDANCE WITH MANUFACTURER'S SPECIFICATIONS. HOLLOW CONDUIT STAKES SHALL NOT BE USED.
- 5. TRENCHES SHALL BE CUT OVERSI E AS NECESSARY TO ACCOMMODATE THE INSTALLATION OF THE VIMS MEMBRANE.

SPECIFICATIONS. MASONRY JOINTS SHALL BE STRUCK SMOOTH WITH A METAL TROWEL.

- 6. THE WALLS OF FOOTING OR UTILITY TRENCHES SHALL BE SMOOTH AND FREE OF ROOTS OR PROTRUDING ROCKS. 7. IF ORGANIC MATERIALS WITH POTENTIAL FOR GROWTH (E.G., SEEDS OR GRASSES) ARE PRESENT
- MANUFACTURER'S RECOMMENDED RATE PRIOR TO THE INSTALLATION OF THE VIMS MEMBRANE. 8. THE VIMS MEMBRANE SHALL FIRST BE LAID ON THE AGGREGATE LAYER IN ACCORDANCE WITH THE MATERIAL MANUFACTURER'S SPECIFICATIONS. ALL SEAMS SHALL BE OVERLAPPED A MINIMUM OF 12 INCHES. ANY OPEN UTILITY OR OTHER TRENCH PRESENT AT THE TIME OF APPLICATION SHALL HAVE THE VIMS MEMBRANE E TENDING AT LEAST 12 INCHES ONTO THE ADJOINING SUBGRADE.

WITHIN THE SUBGRADE, THE GENERAL CONTRACTOR SHALL APPLY A SOIL STERILANT AT THE

G.3 SEALING PENETRATIONS

CORNERS.

1. ALL PENETRATIONS SHALL BE CLEANED AND PREPARED TO PROVIDE PROPER ADHESION OF THE VIMS MEMBRANE MANUFACTURER RECOMMENDED SEALING PRODUCTS TO PROVIDE A VAPOR

THE VIMS MEMBRANE SHALL BE IN INTEGRAL CONTACT WITH ALL INTERIOR FOUNDATION

2. ALL PENETRATIONS SHOULD BE SECURED PRIOR TO INSTALLATION OF THE VIMS MEMBRANE SYSTEM. PENETRATIONS SHALL NOT BE IN CONTACT WITH ADJACENT PENETRATIONS OR OTHER OBJECTS TO ALLOW PROPER SEALING AROUND THE ENTIRE PENETRATION CIRCUMFERENCE. WHERE PENETRATIONS SUCH AS ELECTRICAL CONDUITS, PLUMBING PIPING, ETC., ARE CONCENTRATED, A CONCRETE PENETRATION BANK IS TO BE CONSTRUCTED PRIOR TO VIMS MEMBRANE PLACEMENT. THE CONCRETE PENETRATION BANK WILL CONSIST OF A MINIMUM THICKNESS OF 12 INCHES OF NON-SHRINK GROUT, E TENDING A MINIMUM OF 8 INCHES BEYOND THE EDGE OF EACH PENETRATION TO ALLOW FOR ATTACHMENT OF THE VIMS MEMBRANE. A LIQUID SEALANT WITHIN A FORM, OR EQUIVALENT, MAY ALTERNATIVELY BE USED ACCORDING TO MANUFACTURER SPECIFICATIONS (SEE DETAIL PLANS).

3. THE VIMS MEMBRANE SHALL BE CUT AROUND PENETRATIONS SO THAT IT LIES FLAT ON THE SUBGRADE. THERE SHOULD NOT BE A GAP LARGER THAN 1 8-INCH BETWEEN THE MEMBRANE AND

H. INSPECTIONS

- 1. THE INSPECTION OF ALL VAPOR CONTROL MEASURES SHALL BE PERFORMED BY THE VIMS DESIGNER, AT A MINIMUM, INSPECTION SHALL TAKE PLACE AT THE FOLLOWING STAGES OF THE
- INSTALLATION, AS DEEMED NECESSARY BY THE VIMS DESIGNER AFTER THE INSTALLATION OF THE LOW-PROFILE VENT PIPING AND PRIOR TO THE INSTALLATION OF THE AGGREGATE LAYER ABOVE THE VENT PIPING
- PERIODICALLY DURING THE INSTALLATION OF THE VIMS MEMBRANE DURING SMOKE TESTING

WARRANTY MAY BE VOIDED.

THE PENETRATION (SEE DETAIL PLANS).

- AFTER INSTALLATION OF THE VIMS MEMBRANE, REINFORCING STEEL, AND ALL FOUNDATION FORM WORK. BUT PRIOR TO AND THROUGHOUT THE PLACEMENT OF CONCRETE FOR THE FLOOR SLAB
- . FINAL SUBGRADE INSPECTION PREPARATION SHALL NOT PRECEDE THE VIMS INSTALLATION BY

DURING AND AT THE COMPLETION OF THE VERTICAL VENT RISER PIPING AND ROOF VENT

MORE THAN 72 HOURS. 3. FIELD QUALITY CONTROL IS A VERY IMPORTANT PART OF ALL APPLICATIONS. THE VIMS

SUBCONTRACTOR SHALL CHECK HIS OWN WORK FOR ALL-AROUND GOOD WORKMANSHIP.

- 4. EACH COMPLETED AREA OF VIMS MEMBRANE SHALL BE SMOKE TESTED AT THE COMPLETION OF THE INSTALLATION IN ACCORDANCE WITH MANUFACTURER'S PROTOCOL TO CONFIRM THE INTEGRITY OF THE VIMS MEMBRANE. A SMOKE TEST SHALL BE CONDUCTED AT A FREQUENCY OF NO FEWER THAN ONCE PER EACH 2,500-SQUARE-FOOT AREA. ANY LEAKS THAT ARE DETECTED SHALL BE REPAIRED ACCORDING TO MANUFACTURER INSTRUCTIONS AND THE AREA RE-TESTED
- UNTIL ALL LEAKS PERFORATIONS ARE ELIMINATED. 5. PRIOR TO PLACING THE CONCRETE SLAB OVER THE VIMS MEMBRANE, THE VIMS SUBCONTRACTOR SHALL CERTIFY IN WRITING THAT THE VIMS MEMBRANE HAS BEEN INSTALLED AND TESTED IN ACCORDANCE WITH THE MANUFACTURER'S SPECIFICATIONS, IS FREE OF LEAKS DEFECTS, AND IS
- INSTALLED IN ACCORDANCE WITH THE SPECIFICATIONS IN THESE PLANS. 6. SERVICES LISTED IN THIS SPECIFICATION AS BEING REQUIRED BY THE VIMS DESIGNER ARE DEPENDENT UPON OWNER AUTHORI ATION OF SAID SERVICES TO VIMS DESIGNER, AND NOTIFICATIONS TO THE VIMS DESIGNER OF THE PROJECT STATUS BY THE VIMS SUBCONTRACTOR. IF THESE SERVICES ARE NOT PERFORMED BY THE VIMS DESIGNER, THE MANUFACTURER'S

RECOMMENDED VAPOR INTRUSION MITIGATION SYSTEM TASKS SUMMARY RECOMMENDED CONTRACTOR /

TASKS TO BE COMPLETED	RECOMMENDED CONTRACTOR / TRADE RESPONSIBLE FOR TASK		
	GENERAL CONTRACTOR	VIMS SUB- CONTRACTOR	
SUBGRADE PREPARATION	•		
PLACEMENT OF 4-INCH MIN. COMPACTED, VIRGIN AGGREGATE LAYER ABOVE SUBGRADE	x		
PREPARATION OF AGGREGATE TO ALLOW FOR MEMBRANE ATTACHMENT TO VERTICAL AND HORI ONTAL SURFACES.	x		
CONSTRUCTION OF 12-INCH THICK CONCRETE PENETRATION BANKS WHERE UTILITY CONDUITS ARE CONCENTRATED.	x		
INSTALLATION OF VAPOR COLLECTION SYS	TEM		
E CAVATION OF TRENCHES FOR TRANSITION PIPING AND LOW-PROFILE VAPOR COLLECTION PIPING	х	х	
INSTALLATION OF PIPE TRANSITIONS THROUGH GRADE BEAMS OR THICKENED SLABS.	х		
INSTALLATION OF VAPOR COLLECTION PIPING AND TRANSITION PIPING	Х	Х	
CONNECTION OF THE VAPOR COLLECTION TO PIPE COUPLINGS.		Х	
BACKFILL OF AGGREGATE OVER THE HEADER PIPE AND VAPOR COLLECTION AFTER INSTALLATIONS IS COMPLETED.	x	x	
CONNECTION OF THE E HAUST PIPE TO A ROOF-MOUNTED VENTILATOR.	Х		
INSTALLATION OF VENT PIPE RISER SAMPLE PORTS AND ACCESS PANEL ON INTERIOR WALL.	х		
INSTALLATION OF 6-INCH VERTICAL VENT RISERS, ENDING A MINIMUM OF 24 ABOVE FINISHED ROOF.	x		
INSTALLATION OF GAS VAPOR MEMBRAN	E		
SITE CLEANUP TO ENSURE REMOVAL OF SHARP OBJECTS FROM THE BUILDING PAD AND FOUNDATION WALLS THAT MAY PENETRATE THE VAPOR MEMBRANE.	X		
PLACEMENT OF VIMS MEMBRANE.		Х	
SEALING OF ALL FLOOR SLAB PENETRATIONS.		X	
PERFORMANCE OF SMOKE TEST AND FINAL QC OF VIMS MEMBRANE.		X	
INSPECTION OF SYSTEM BY CERTIFIED VIMS MEMBRANE TECHNICIAN DURING INSTALLATION.		x	

I. REPAIRS

. KERAMIDA UNDERSTANDS THAT IMPROVEMENTS MAY BE REQUIRED DURING FUTURE BUILDING ADDITIONS OR RENOVATIONS. IF FUTURE IMPROVEMENTS REQUIRE CUTTING THROUGH OR OTHERWISE PENETRATING THE SLAB AND MEMBRANE, THE VIMS DESIGNER SHALL BE NOTIFIED.

2. REPAIRS OF THE VIMS BARRIER SHALL BE CONDUCTED BY A QUALIFIED VIMS INSTALLER. A GENERAL REPAIR DETAIL IS SHOWN IN THE DETAIL PLANS. 3. VIMS DESIGNER SHALL BE NOTIFIED TO PROVIDE CONSTRUCTION OBSERVATION SERVICES TO

STANDARD OF CARE AND LIMITATIONS

YOU, OUR CLIENT, AS REFLECTED IN OUR PROPOSAL

DOCUMENT THE REPAIR OF THE VIMS MEMBRANE.

KERAMIDA'S SERVICES WILL BE PERFORMED IN A MANNER CONSISTENT WITH GENERALLY ACCEPTED PRACTICES OF THE PROFESSION UNDERTAKEN IN SIMILAR DESIGNS IN THE SAME GEOGRAPHICAL AREA DURING THE SAME TIME PERIOD. PLEASE NOTE THAT KERAMIDA DOES NOT WARRANT THE WORK OF THIRD PARTIES SUPPLYING INFORMATION USED IN THE PREPARATION OF THE VAPOR INTRUSION MITIGATION SYSTEM. THESE SERVICES WERE PERFORMED IN ACCORDANCE WITH THE SCOPE OF WORK AGREED WITH



SMITHGROUP

ph 317.819.7878 fx 317.819.7288

DETROIT, MI 48226 313.983.3600 smithgroup.com





LAUNCH **ACCELERATOR BIOSCIENCES**


CLIENT PROJECT NO. - 20250072

INDIANAPOLIS, INDIANA

CUMULATIVE DOCUMENTS BP1-CD: SITE AND FOUNDATION PACKAGE

ISSUED / REVISIONS SCHEDULE

DESCRIPTION 09/29/2025 BP1-CD: SITE AND FOUNDATION PACKAGE 3 | 10/21/2025 | ADDENDUM 2

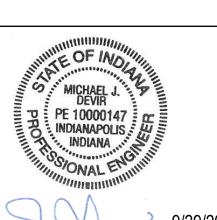

NRPP Mitigation ID 10995-RMS IN Radon Mitigation Number RTM0092

TITLE SHEET AND


REF: SHEET INDEX BSA PROJECT NO.





500 GRISWOLD SUITE 1700 DETROIT, MI 48226 313.983.3600 smithgroup.com



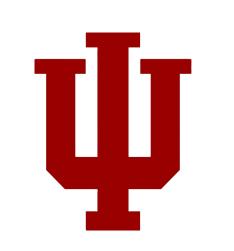


LAUNCH **ACCELERATOR FOR BIOSCIENCES**

INDIANAPOLIS, INDIANA

CLIENT PROJECT NO. - 20250072

CUMULATIVE DOCUMENTS **BP1-CD: SITE AND FOUNDATION PACKAGE**

ISSUED / REVISIONS SCHEDULE 09/29/2025 BP1-CD: SITE AND FOUNDATION PACKAGE

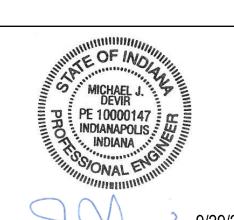


NRPP Mitigation ID 10995-RMS

IN Radon Mitigation Number RTM00924

VIMS MEMBRANE AND COLLECTION PIPE LAYOUT (FOUNDATION)

BSA PROJECT NO.

REF: SHEET INDEX FIGURE 2

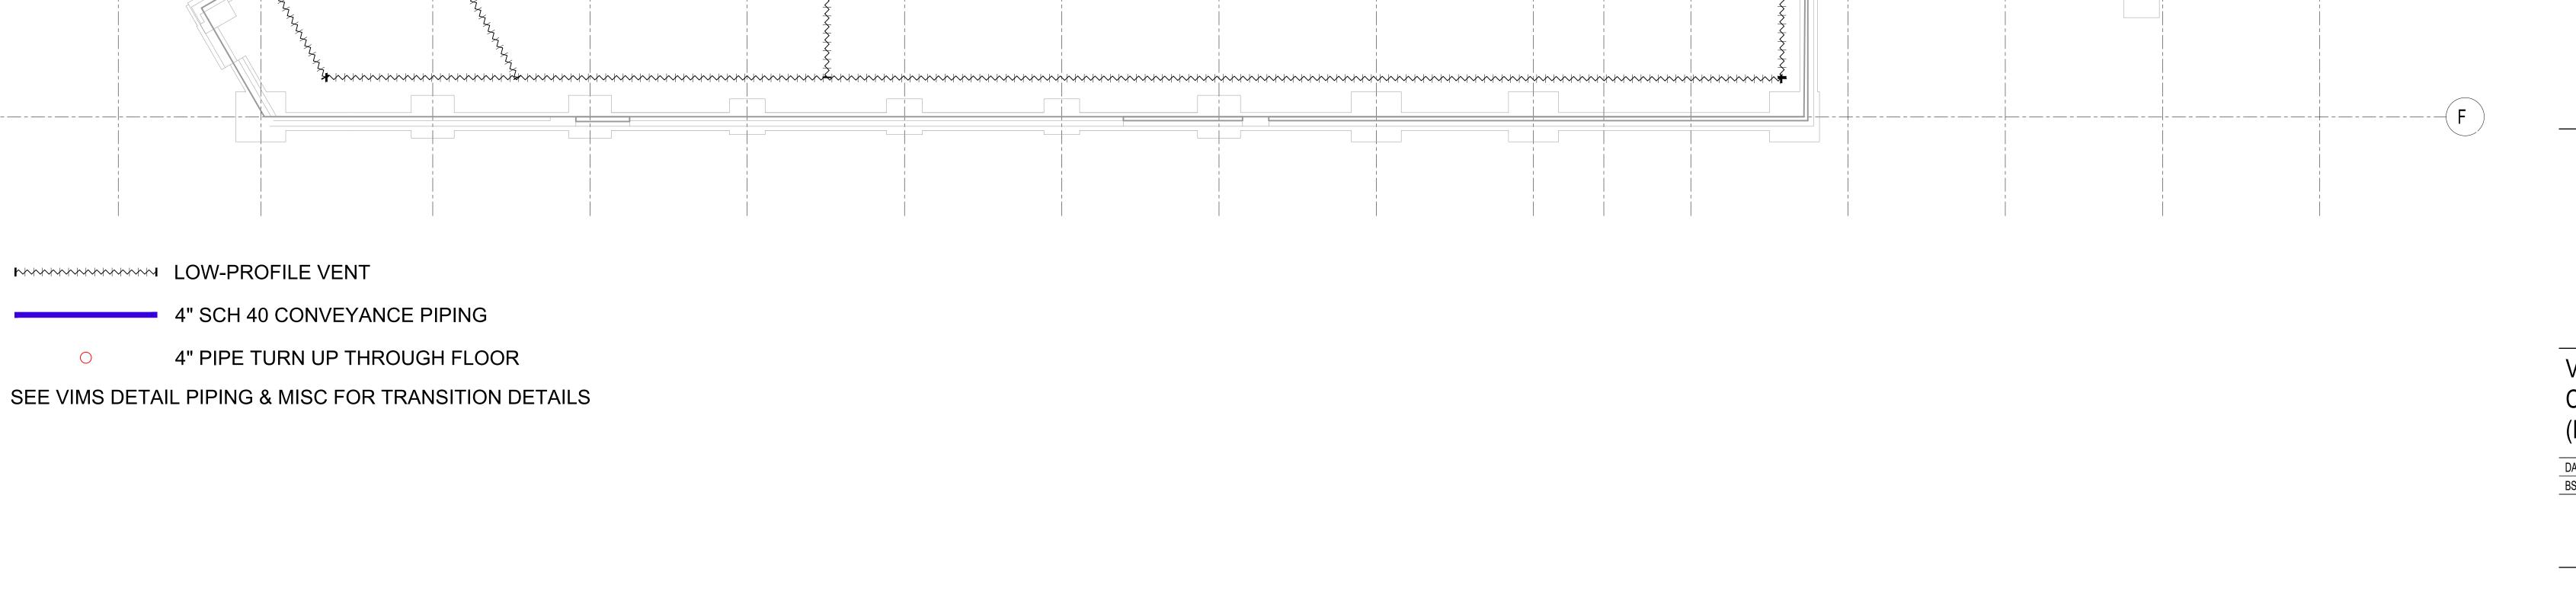

TRANSITION

TRANSITION

 $|\hat{a}_{b}|$

| γ

+

(2) 4" PIPES THRO

-TRANSITION

<u>+</u>

SLAB INTO PUMP ROOM

TRANSITION)

 $\hat{m{x}}$

9'-10"

(2) 4" PIPES THROUG

1

NTO JANITOR'S CL



500 GRISWOLD SUITE 1700 DETROIT, MI 48226 313.983.3600 smithgroup.com





LAUNCH ACCELERATOR FOR BIOSCIENCES

INDIANAPOLIS, INDIANA

CLIENT PROJECT NO. - 20250072


CUMULATIVE DOCUMENTS
BP1-CD: SITE AND FOUNDATION PACKAGE

ISSUED / REVISIONS SCHEDULE

MARK DATE DESCRIPTION

2 09/29/2025 BP1-CD: SITE AND FOUNDATION PACKAGE

3 10/21/2025 ADDENDUM 2

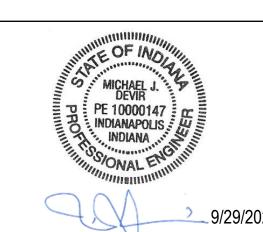


NRPP Mitigation ID 10995-RMS
IN Radon Mitigation Number RTM00924

FIRST FLOOR VIMS PIPE RISER & TEST PIN LAYOUT

DATE REF: SHEET INDEX
BSA PROJECT NO. 00360481

FIGURE 3

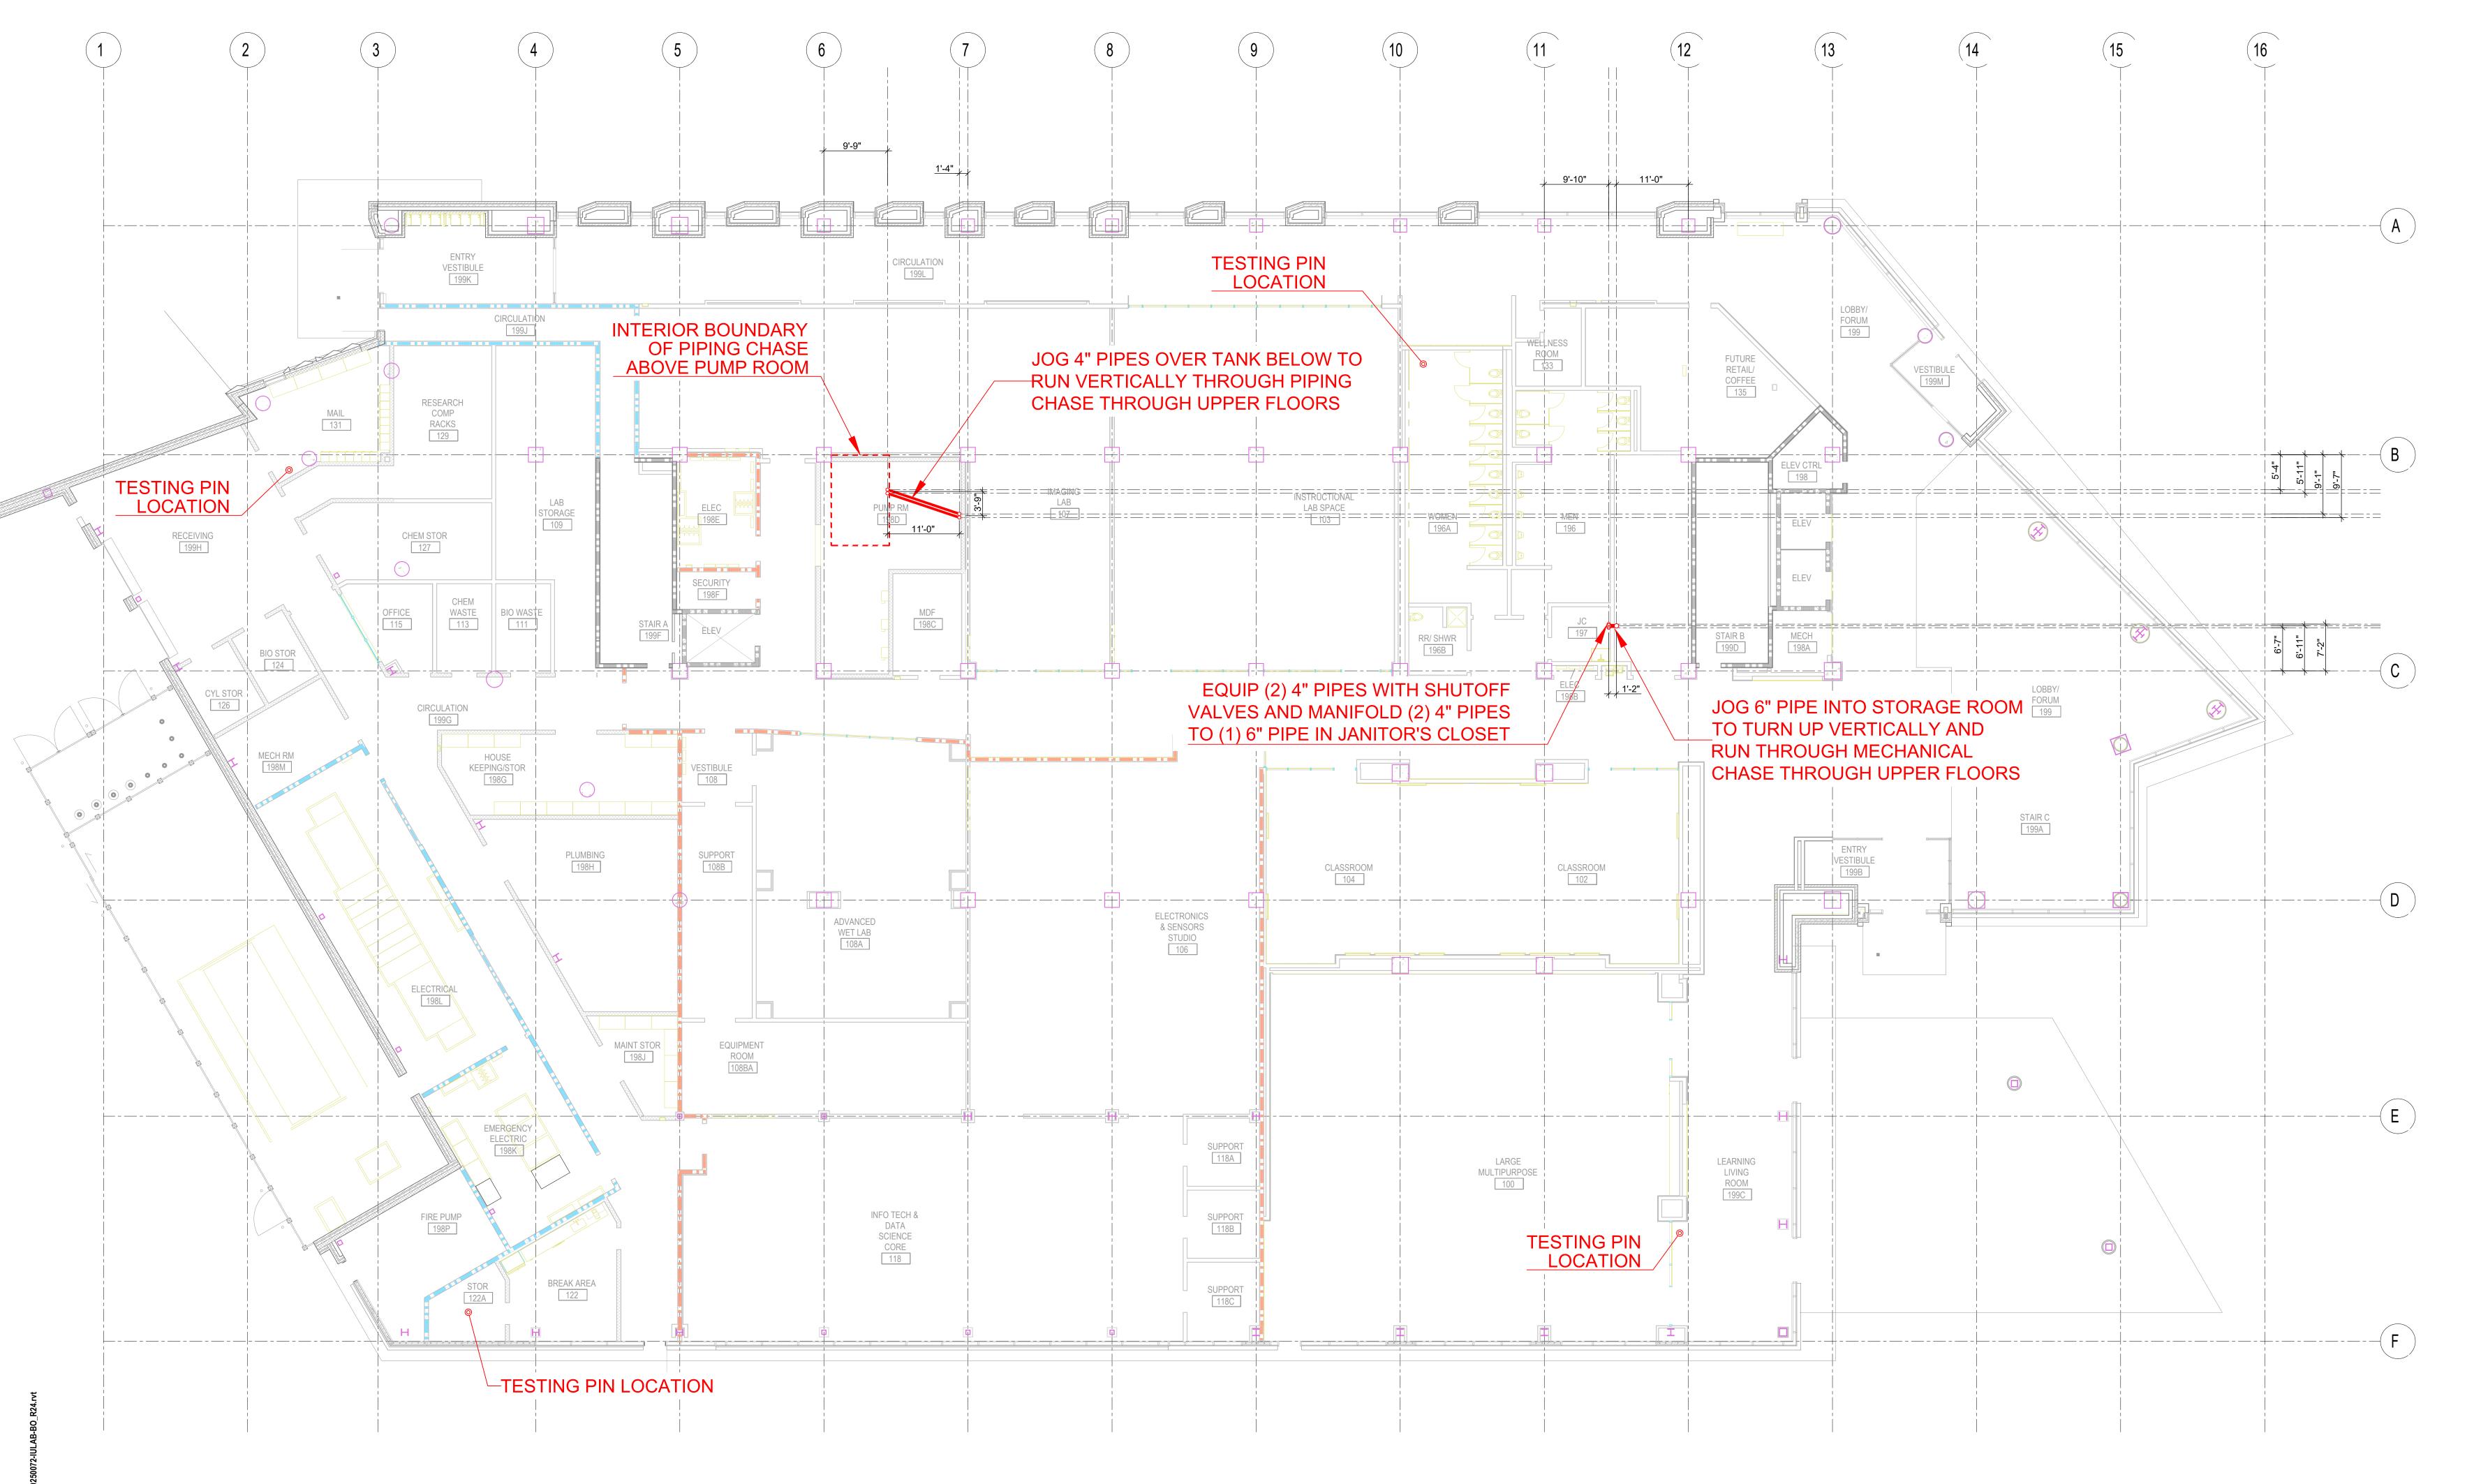



500 GRISWOLD SUITE 1700 DETROIT, MI 48226 313.983.3600 smithgroup.com





LAUNCH ACCELERATOR FOR BIOSCIENCES

INDIANAPOLIS, INDIANA


CLIENT PROJECT NO. - 20250072

CUMULATIVE DOCUMENTS

BP1-CD: SITE AND FOUNDATION PACKAGE

ISSUED / REVISIONS SCHEDULE

ARK DATE DESCRIPTION
2 09/29/2025 BP1-CD: SITE AND FOUNDATION PACKAGE
3 10/21/2025 ADDENDUM 2

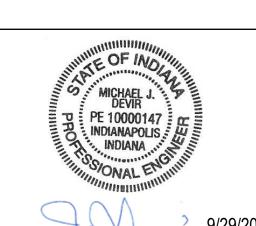


NRPP Mitigation ID 10995-RMS
IN Radon Mitigation Number RTM00924

SECOND FLOOR VIMS PIPE RISER LAYOUT

DATE REF: SHEET INDEX
BSA PROJECT NO. 00360481

FIGURE 4

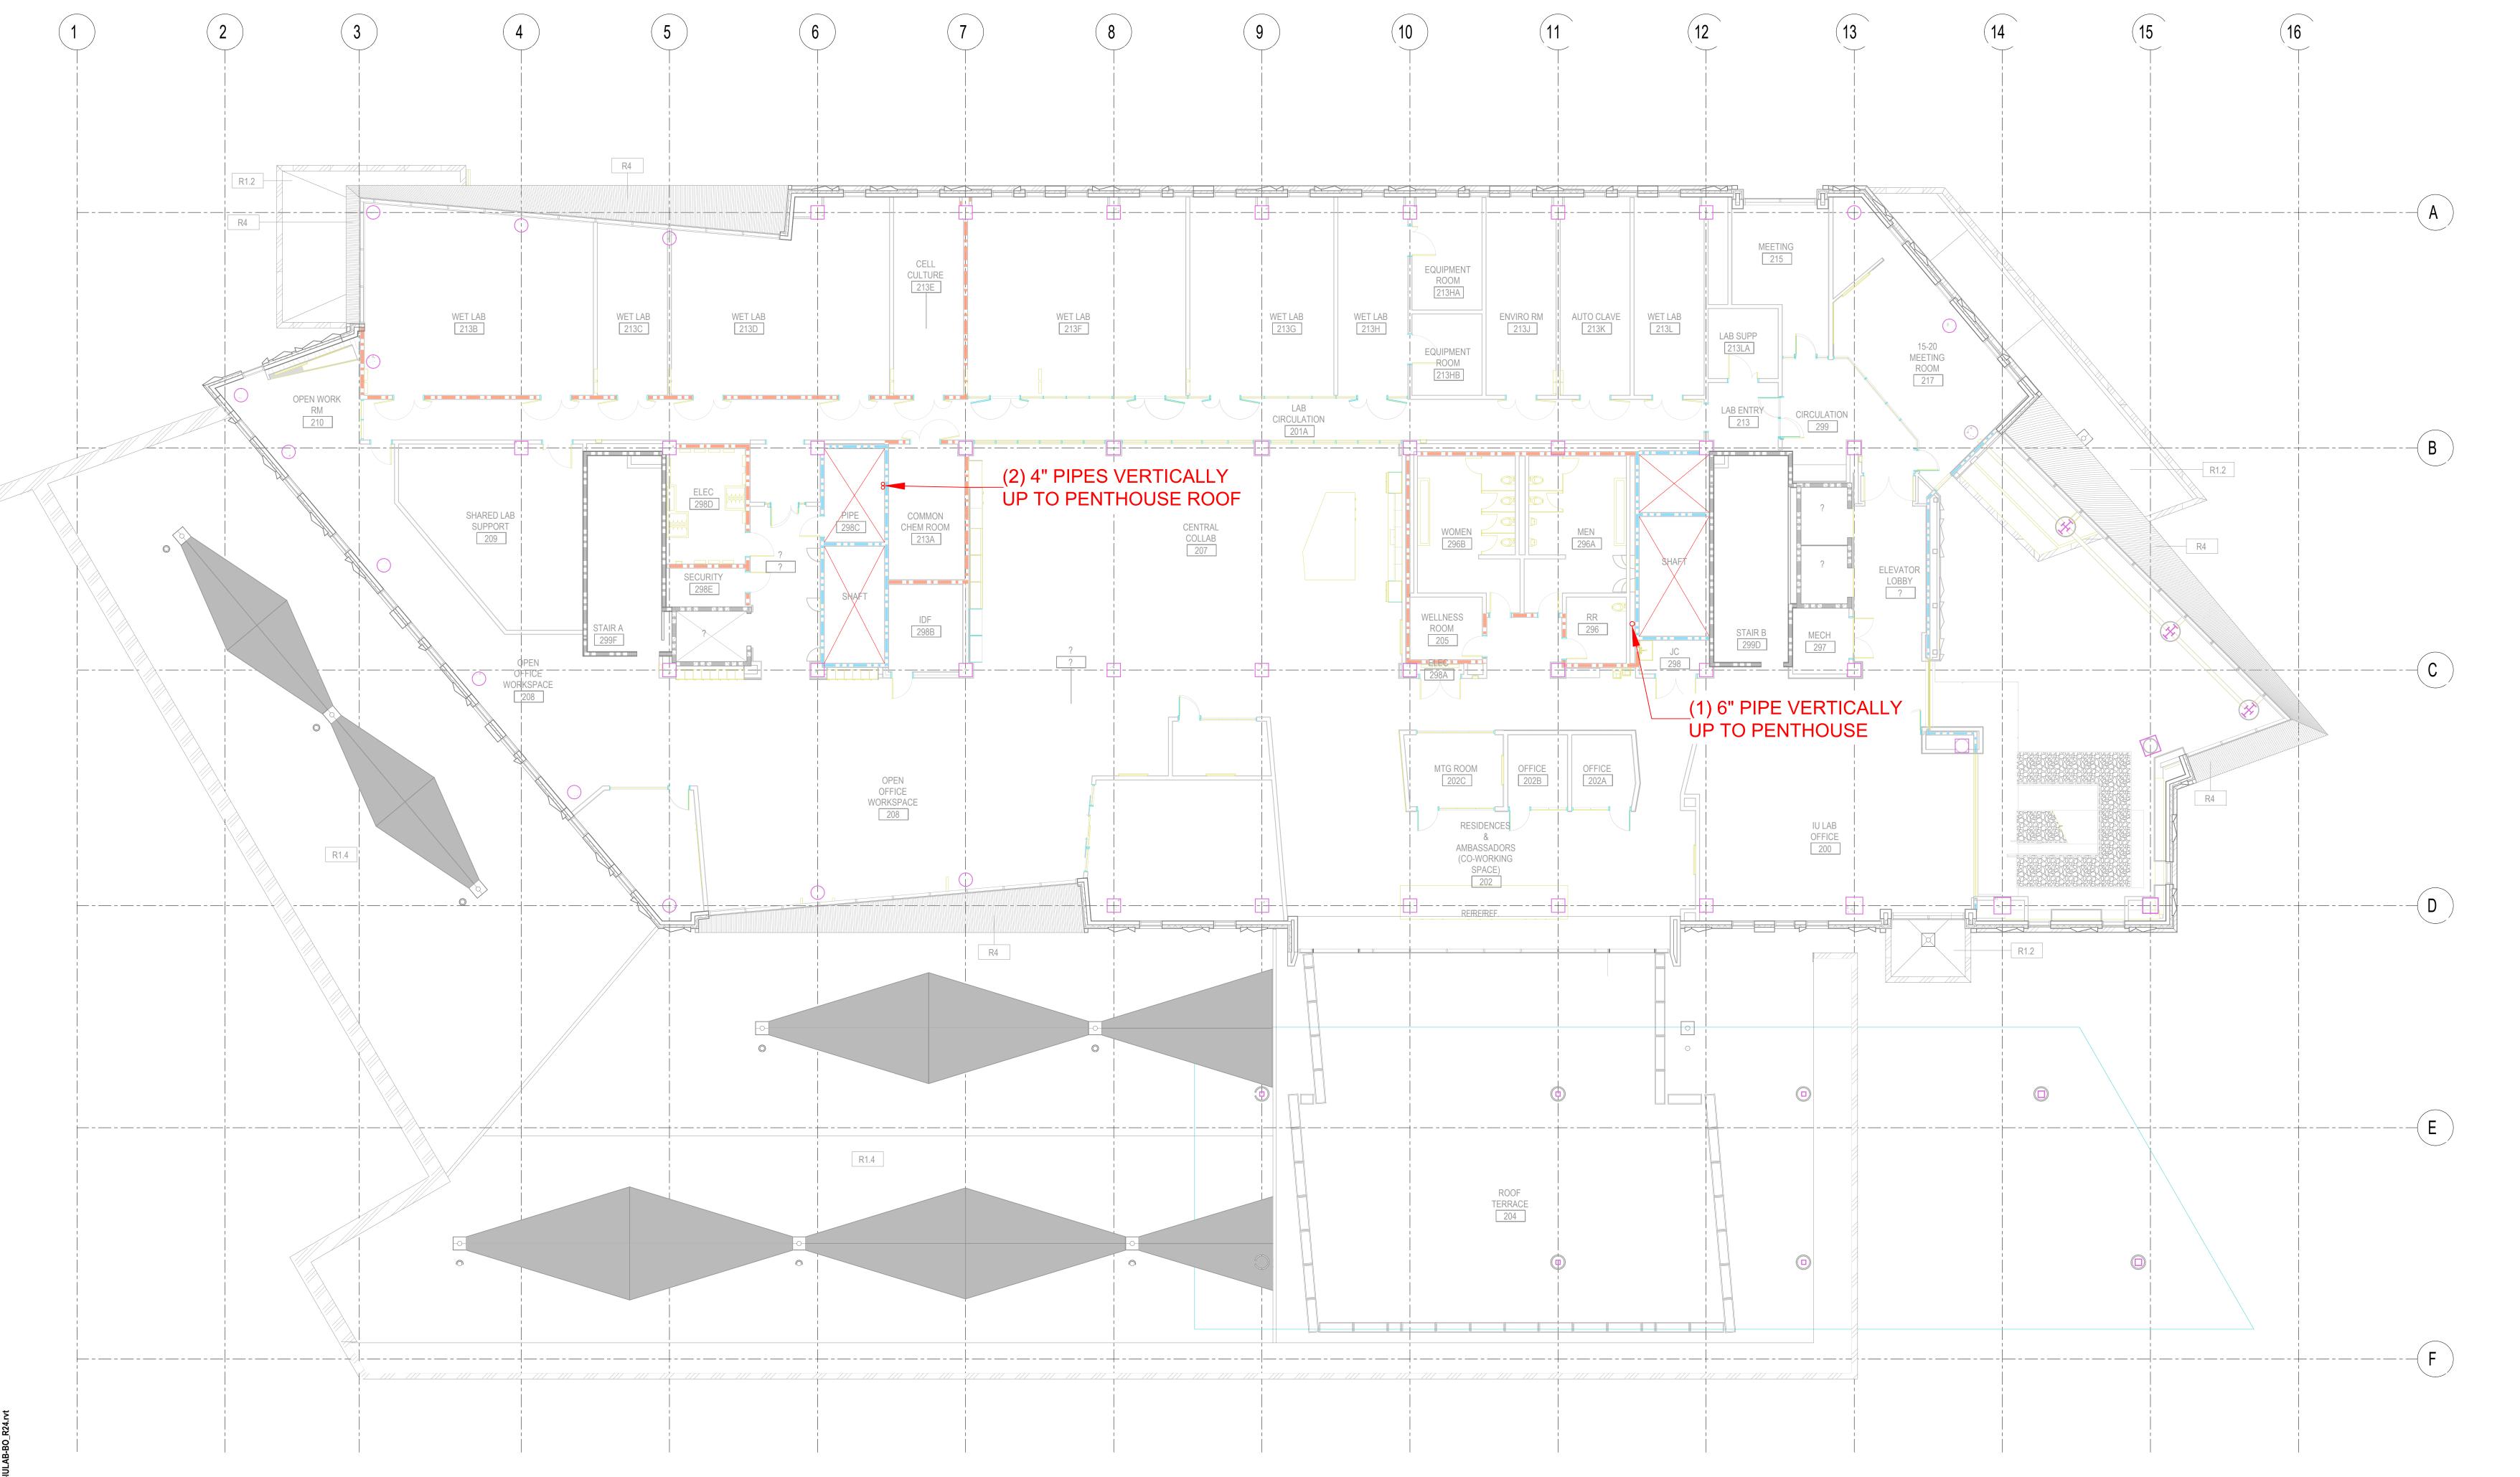





500 GRISWOLD SUITE 1700 DETROIT, MI 48226 313.983.3600 smithgroup.com





LAUNCH ACCELERATOR FOR BIOSCIENCES

INDIANAPOLIS, INDIANA

CLIENT PROJECT NO. - 20250072


CUMULATIVE DOCUMENTS
BP1-CD: SITE AND FOUNDATION PACKAGE

ISSUED / REVISIONS SCHEDULE

MARK DATE DESCRIPTION

2 09/29/2025 BP1-CD: SITE AND FOUNDATION PACKAGE

3 10/21/2025 ADDENDUM 2

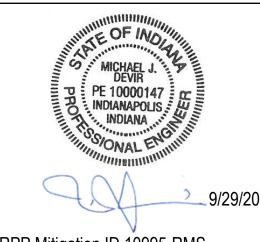

NRPP Mitigation ID 10995-RMS
IN Radon Mitigation Number RTM00924

THIRD FLOOR VIMS PIPE RISER LAYOUT

DATE BSA PROJECT NO.

FIGURE 5



500 GRISWOLD SUITE 1700 DETROIT, MI 48226 313.983.3600 smithgroup.com





LAUNCH ACCELERATOR FOR BIOSCIENCES

CLIENT PROJECT NO. - 20250072


INDIANAPOLIS, INDIANA

CUMULATIVE DOCUMENTS
BP1-CD: SITE AND FOUNDATION PACKAGE

ISSUED / REVISIONS SCHEDULE

MARK DATE DESCRIPTION
2 09/29/2025 BP1-CD: SITE AND FOUNDATION PACKAGE

3 10/21/2025 ADDENDUM 2

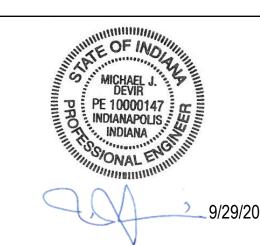


NRPP Mitigation ID 10995-RMS
IN Radon Mitigation Number RTM00924

FOURTH FLOOR VIMS PIPE RISER LAYOUT

DATE BSA PROJECT NO.



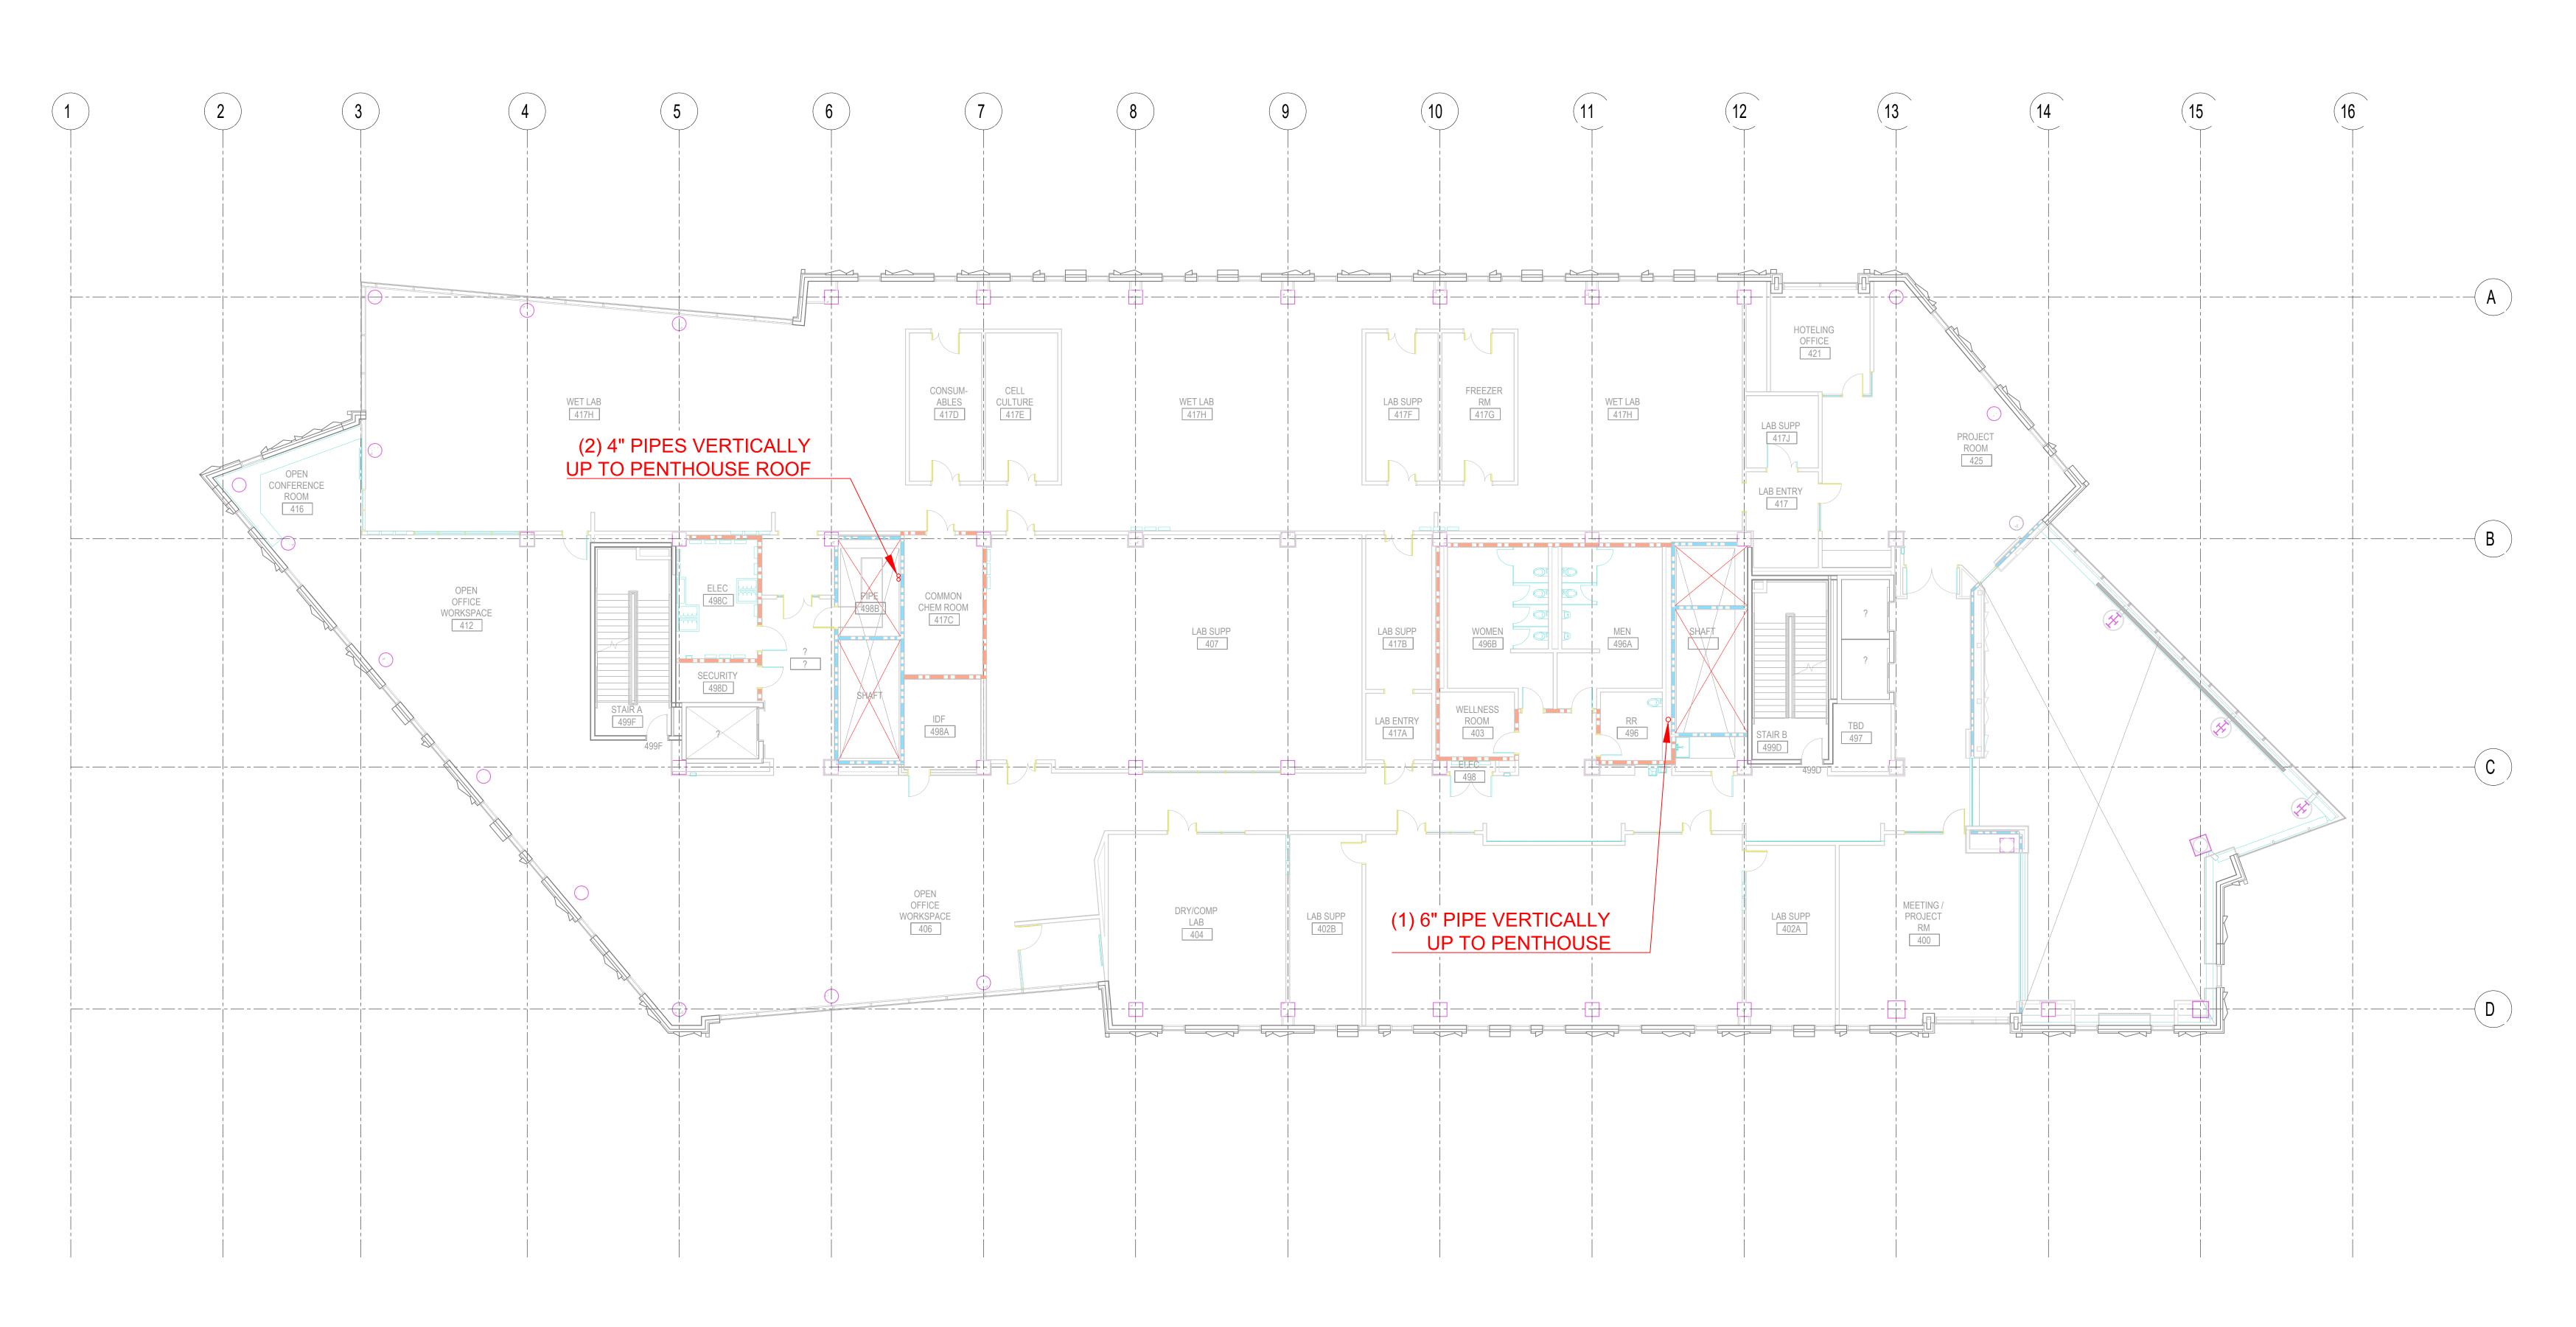





500 GRISWOLD SUITE 1700 DETROIT, MI 48226 313.983.3600 smithgroup.com





LAUNCH ACCELERATOR FOR BIOSCIENCES

CLIENT PROJECT NO. - 20250072


INDIANAPOLIS, INDIANA

CUMULATIVE DOCUMENTS
BP1-CD: SITE AND FOUNDATION PACKAGE

ISSUED / REVISIONS SCHEDULE

MARK DATE DESCRIPTION
2 09/29/2025 BP1-CD: SITE AND FOUNDATION PACKAGE

3 10/21/2025 ADDENDUM 2

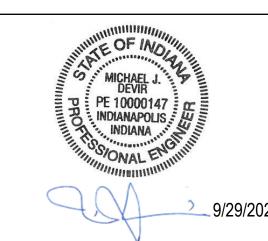


NRPP Mitigation ID 10995-RMS
IN Radon Mitigation Number RTM00924

FIFTH FLOOR VIMS PIPE RISER LAYOUT

DATE
BSA PROJECT NO.

FIGURE 7

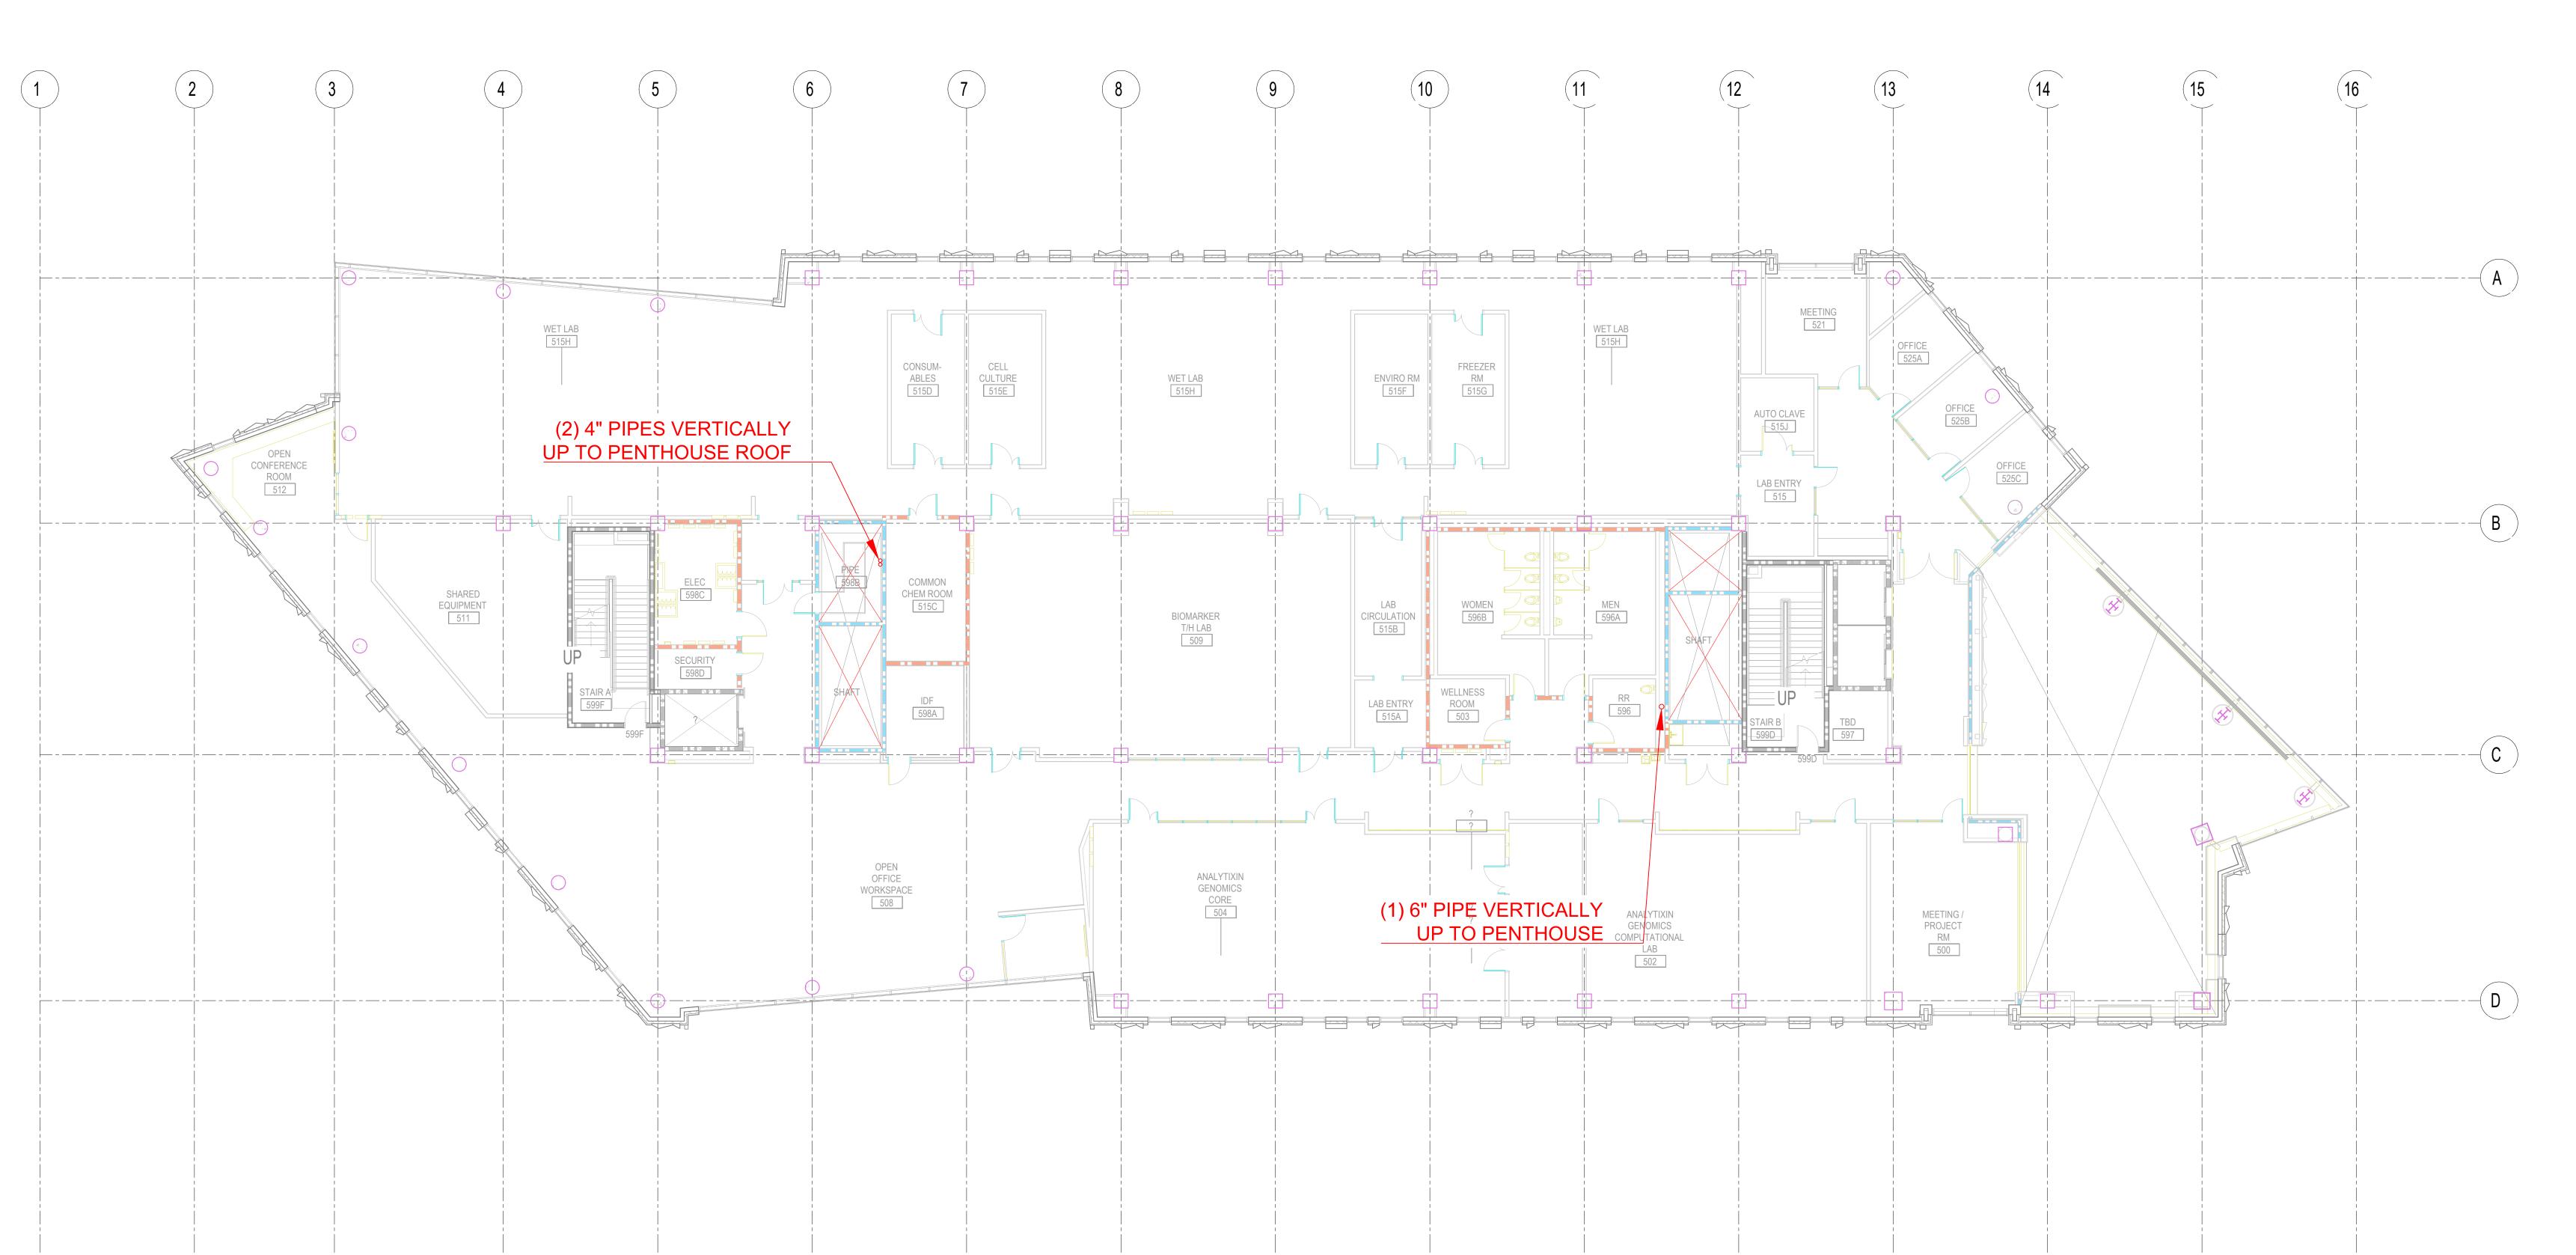



500 GRISWOLD SUITE 1700 DETROIT, MI 48226 313.983.3600 smithgroup.com



11'-0"

MECH RM 698A

R1.1

JOG (1) 6" PIPE HORIZONTALLY TO RUN

VERTICALLY UP TO PENTHOUSE ROOF

(1) 6" PIPE VERTICALLY

UP TO PENTHOUSE



LAUNCH ACCELERATOR FOR BIOSCIENCES

INDIANAPOLIS, INDIANA

CLIENT PROJECT NO. - 20250072


CUMULATIVE DOCUMENTS
BP1-CD: SITE AND FOUNDATION PACKAGE

ISSUED / REVISIONS SCHEDULE

MARK DATE DESCRIPTION

2 09/29/2025 BP1-CD: SITE AND FOUNDATION PACKAGE

3 10/21/2025 ADDENDUM 2

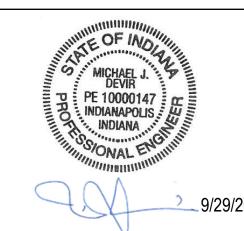

NRPP Mitigation ID 10995-RMS
IN Radon Mitigation Number RTM00924

PENTHOUSE FLOOR VIMS
PIPE RISER LAYOUT

DATE BSA PROJECT NO.

FIGURE 8

REF: SHEET INDEX




ELEV CTRL 698C

(2) 4" PIPES VERTICALLY

UP TO PENTHOUSE ROOF

PENTHOUSE 698

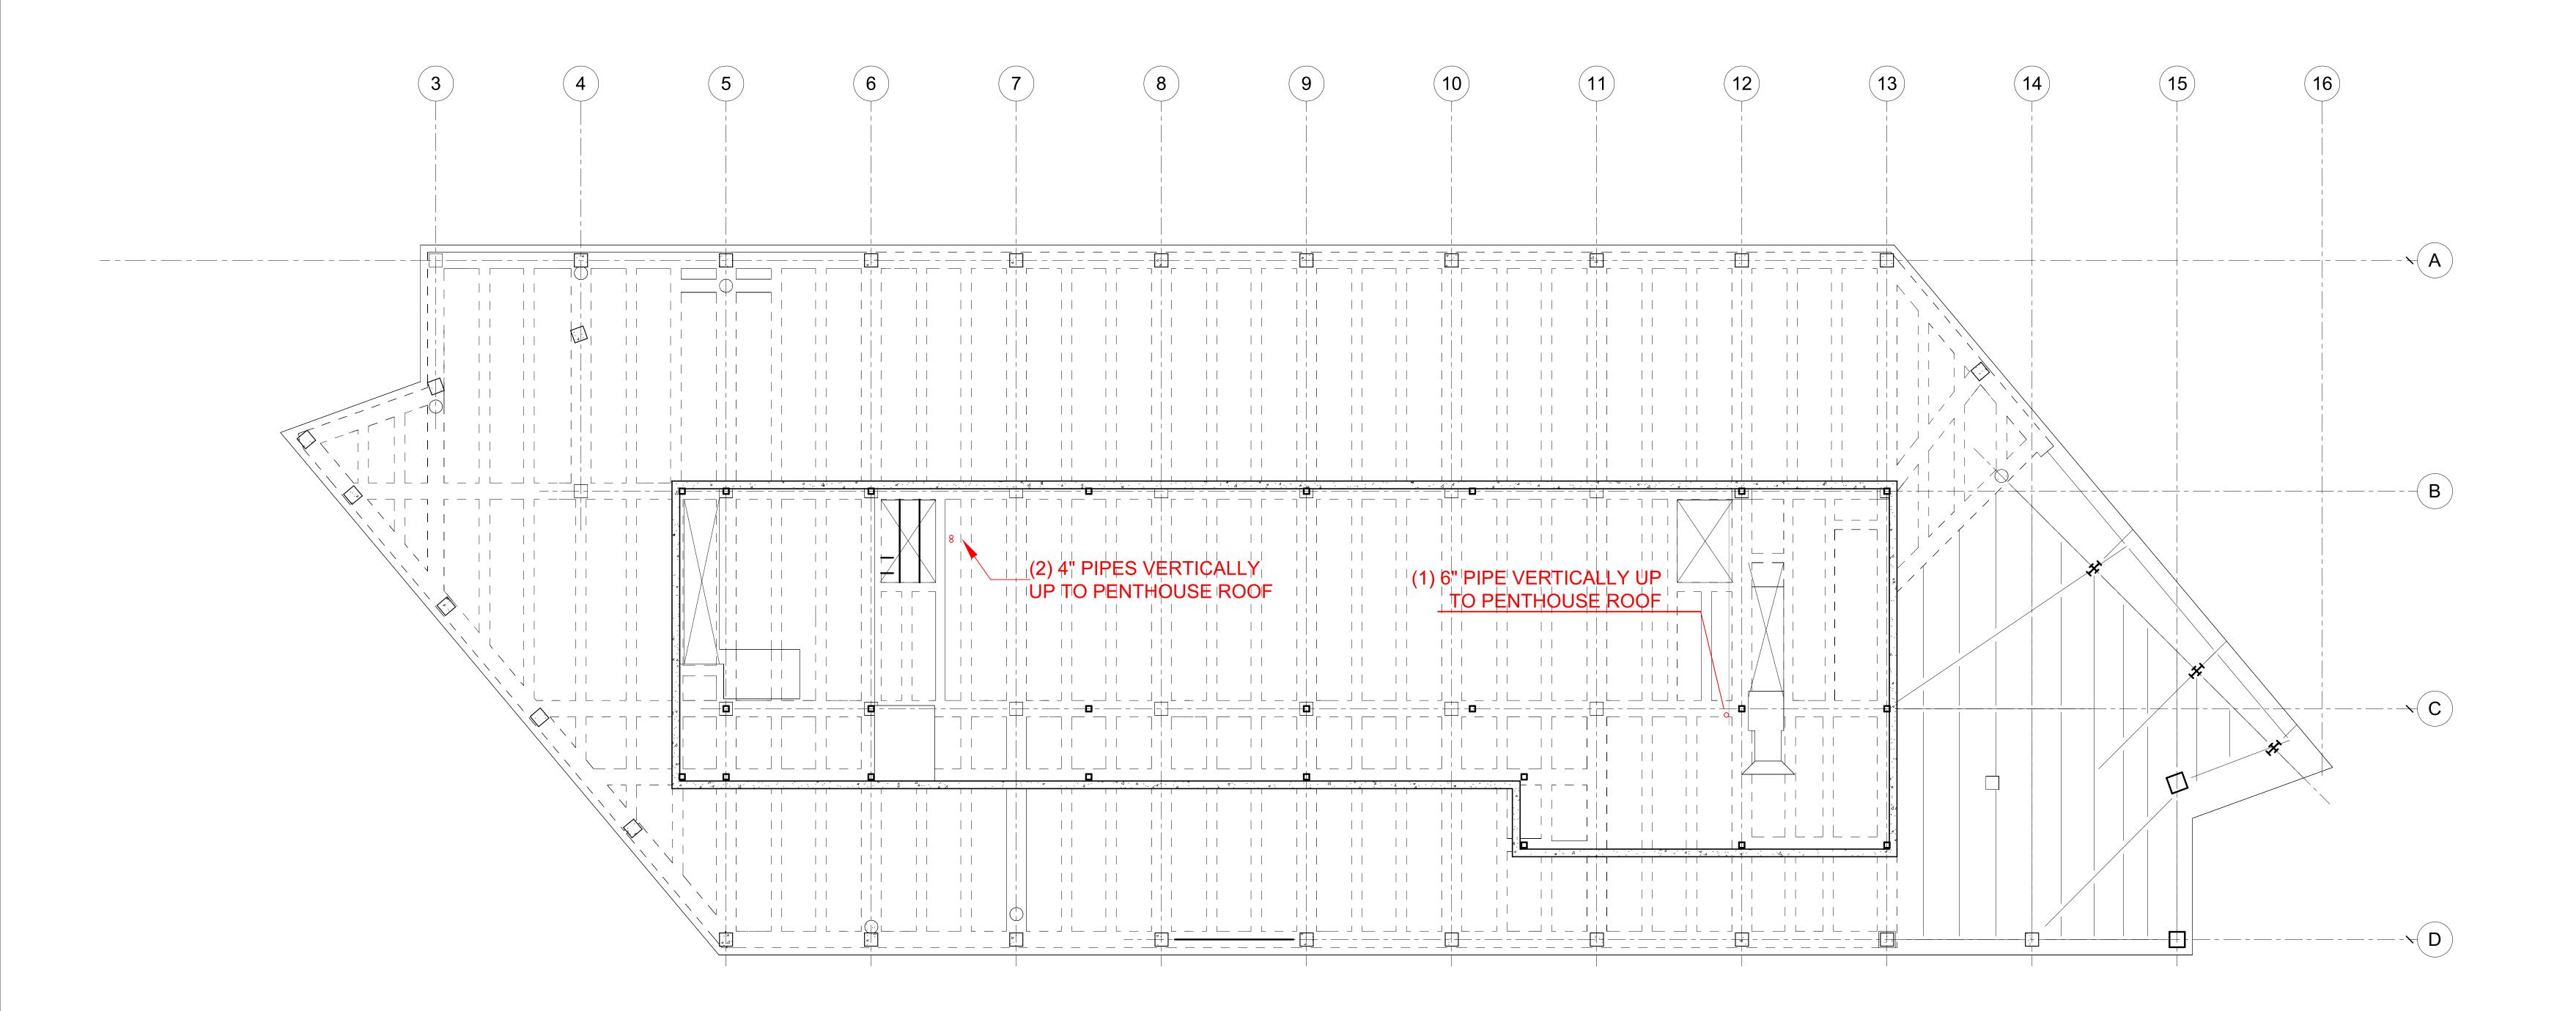



500 GRISWOLD SUITE 1700 DETROIT, MI 48226 313.983.3600 smithgroup.com





LAUNCH ACCELERATOR FOR BIOSCIENCES

INDIANAPOLIS, INDIANA

CLIENT PROJECT NO. - 20250072

CUMULATIVE DOCUMENTS
BP1-CD: SITE AND FOUNDATION PACKAGE

ISSUED / REVISIONS SCHEDULE

MARK DATE DESCRIPTION

2 09/29/2025 BP1-CD: SITE AND FOUNDATION PACKAGE

3 10/21/2025 ADDENDUM 2



NRPP Mitigation ID 10995-RMS
IN Radon Mitigation Number RTM00924


ROOF VIMS PIPE RISER LAYOUT

DATE
BSA PROJECT NO.

00360481

FIGURE 9

© BSA LifeStructures

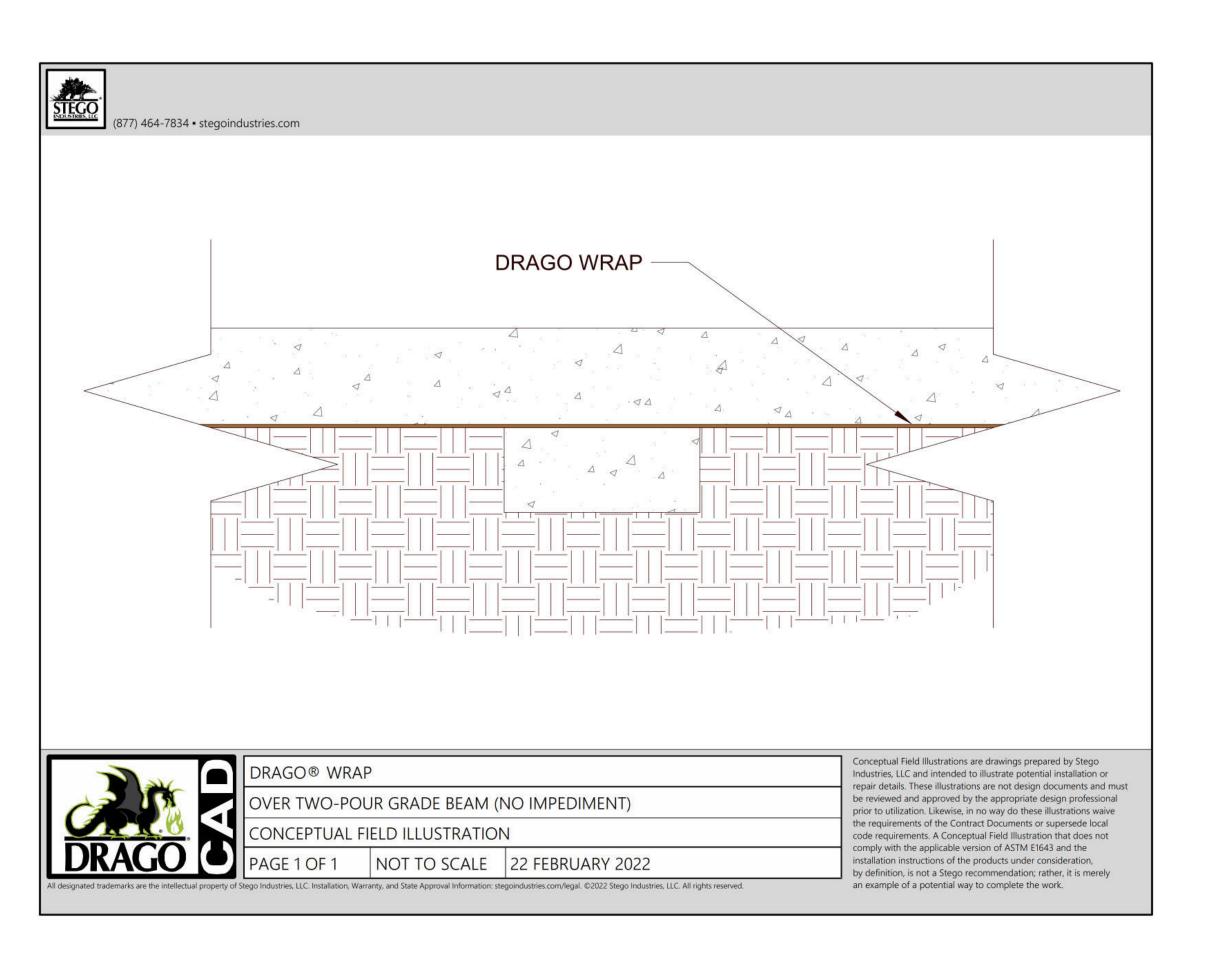

DRAGOTACK TAPE

REBAR (IMPEDIMENT)

nceptual Field Illustrations are drawings prepared by Stego

dustries, LLC and intended to illustrate potential installation or

pair details. These illustrations are not design documents and must

e reviewed and approved by the appropriate design professional

rior to utilization. Likewise, in no way do these illustrations waive

he requirements of the Contract Documents or supersede local

ode requirements. A Conceptual Field Illustration that does not

by definition, is not a Stego recommendation; rather, it is merely


comply with the applicable version of ASTM E1643 and the


nstallation instructions of the products under consideration,


an example of a potential way to complete the work.

77) 464-7834 • stegoindustries.com

DRAGO WRAP -

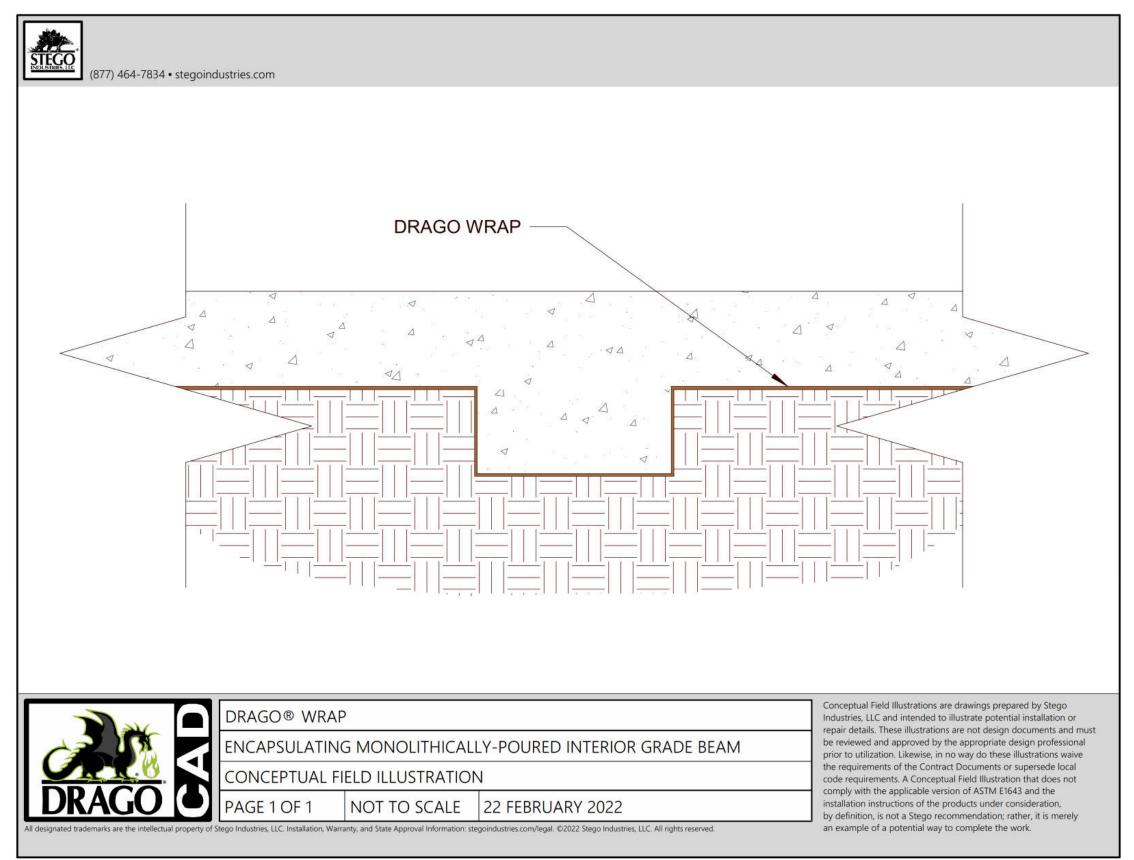

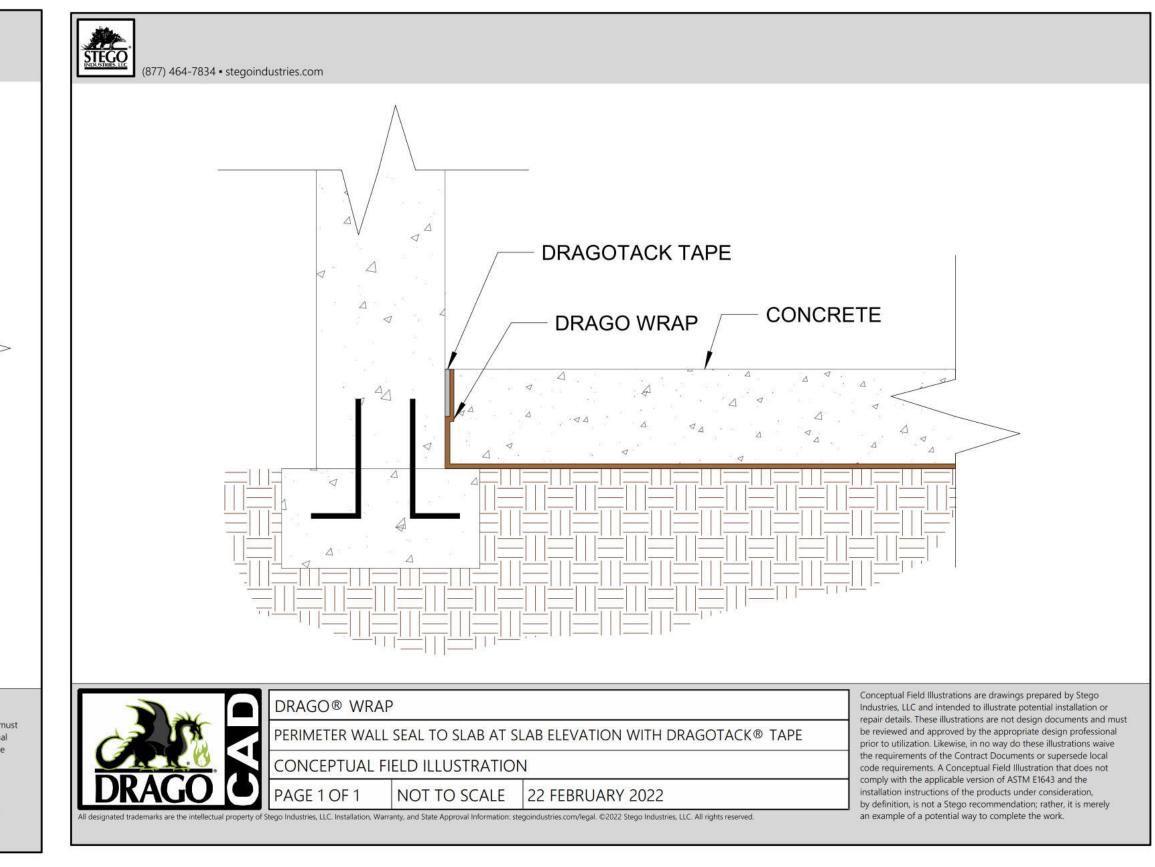

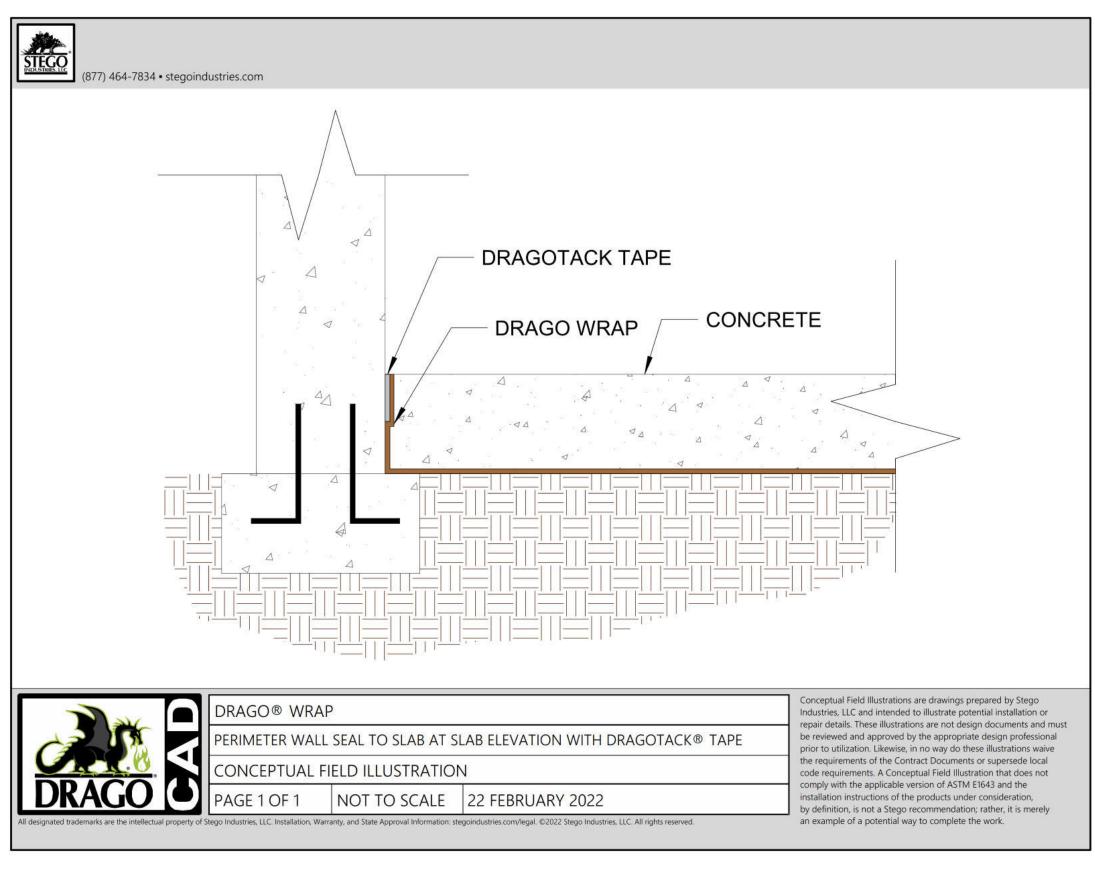










INDIANAPOLIS, INDIANA


CLIENT PROJECT NO. - 20250072


CUMULATIVE DOCUMENTS BP1-CD: SITE AND FOUNDATION PACKAGE

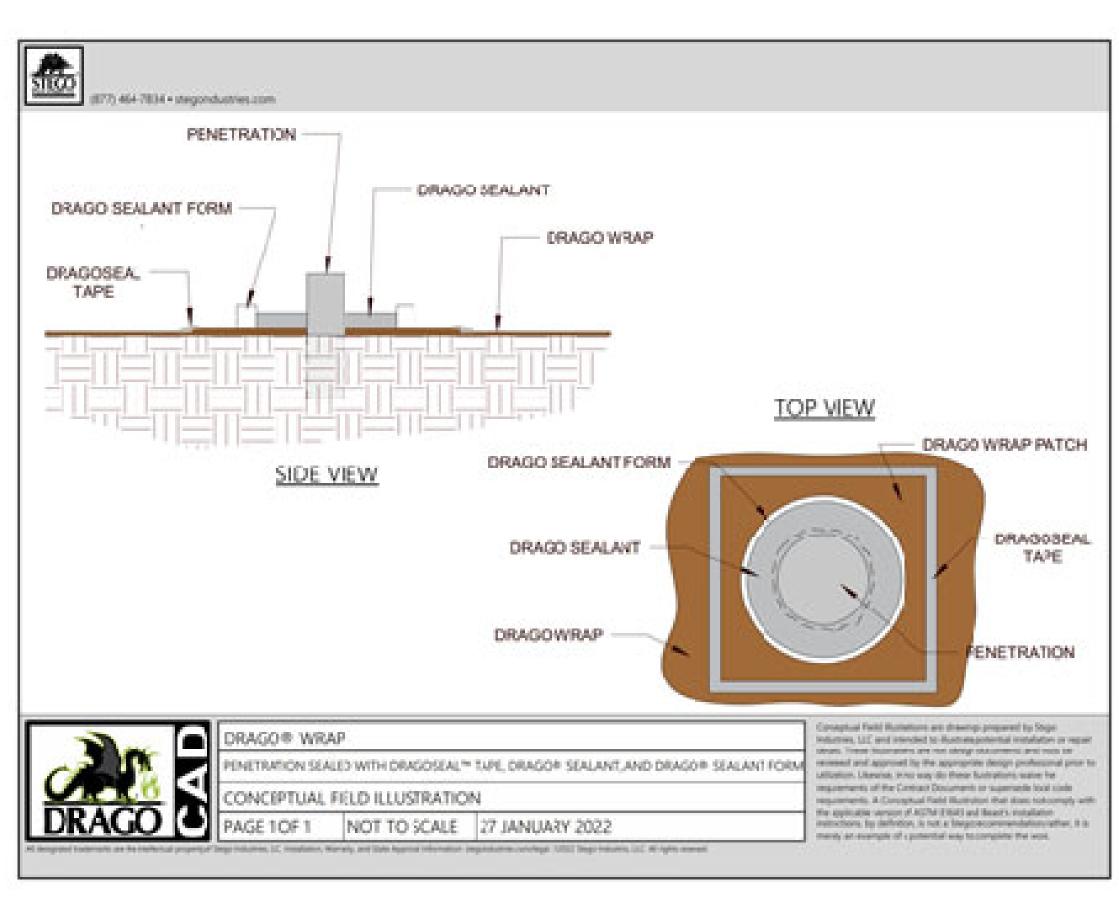

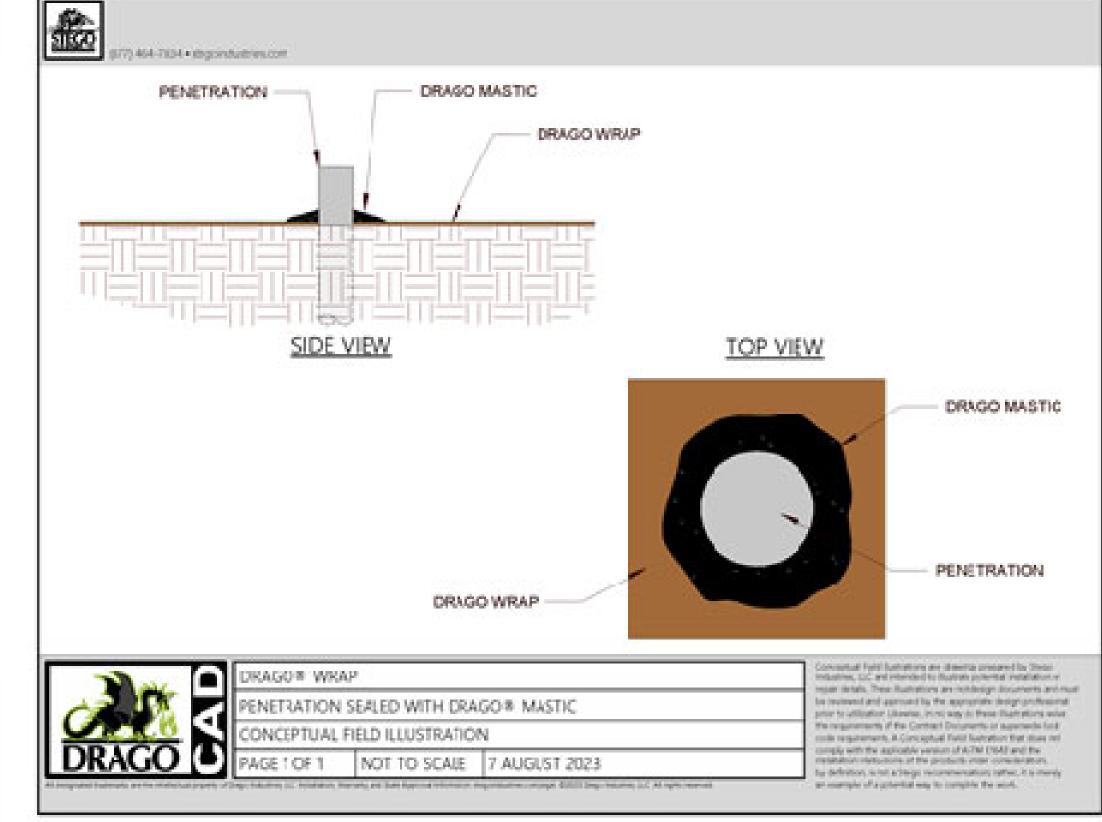

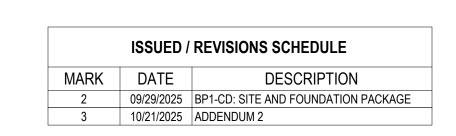

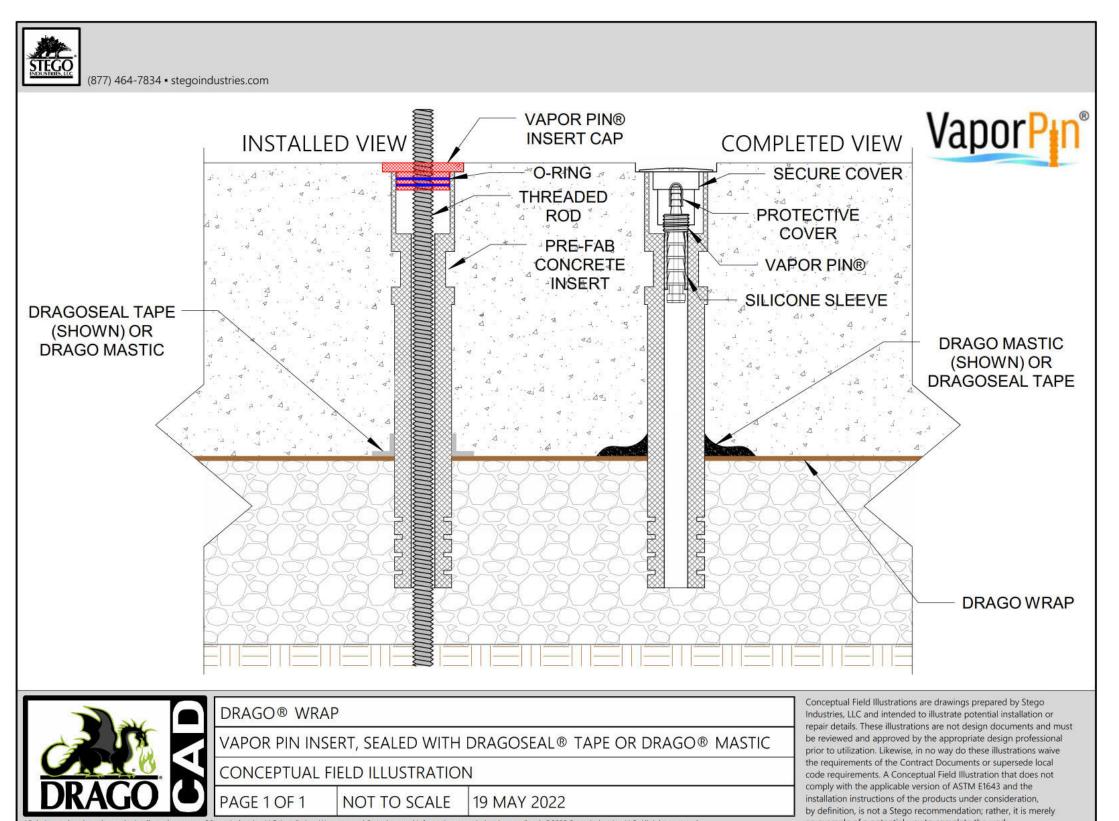


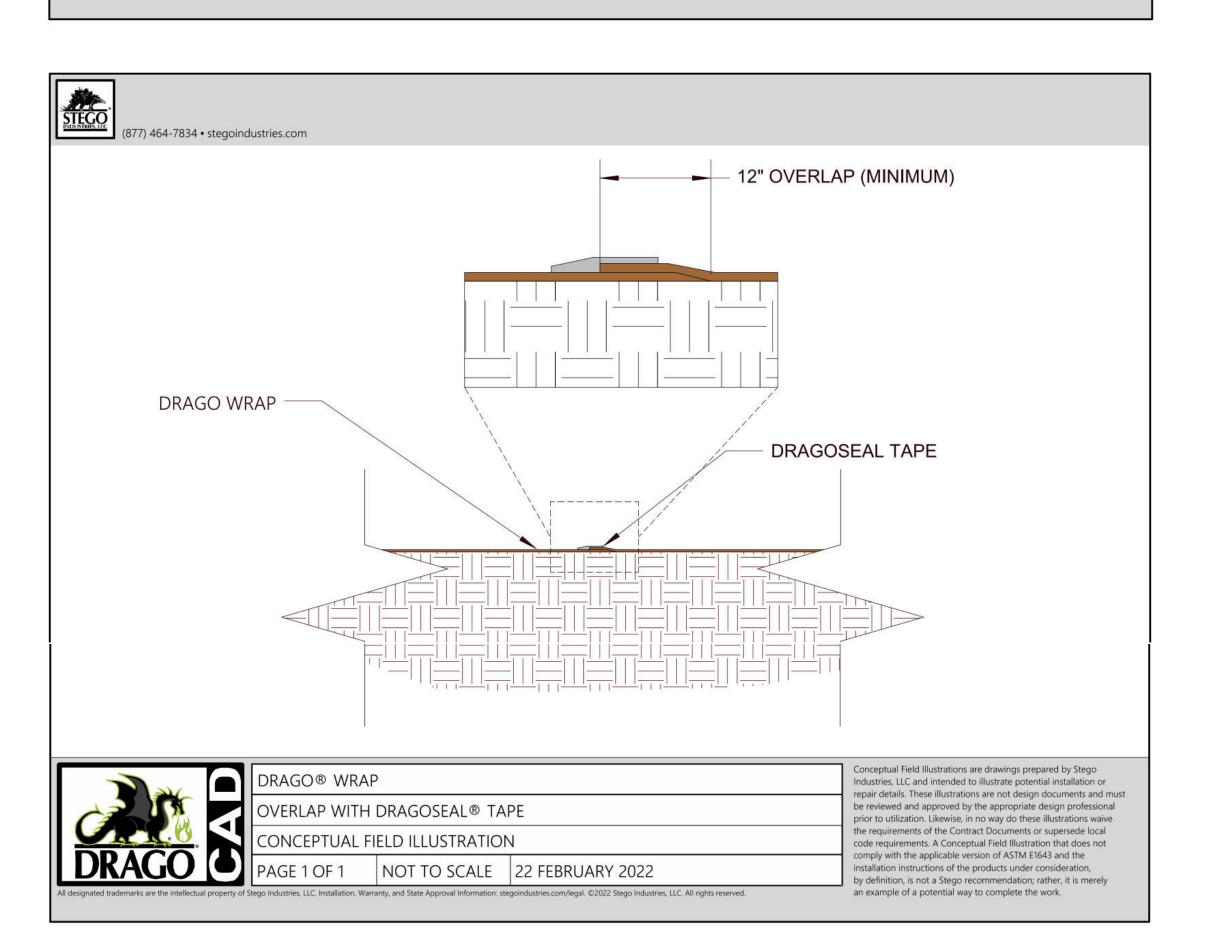

VER TWO-POUR GRADE BEAM, SEALED AT IMPEDIMENT WITH DRAGOTACK® TAPE

CONCEPTUAL FIELD ILLUSTRATION

PAGE 1 OF 1 NOT TO SCALE | 22 FEBRUARY 2022

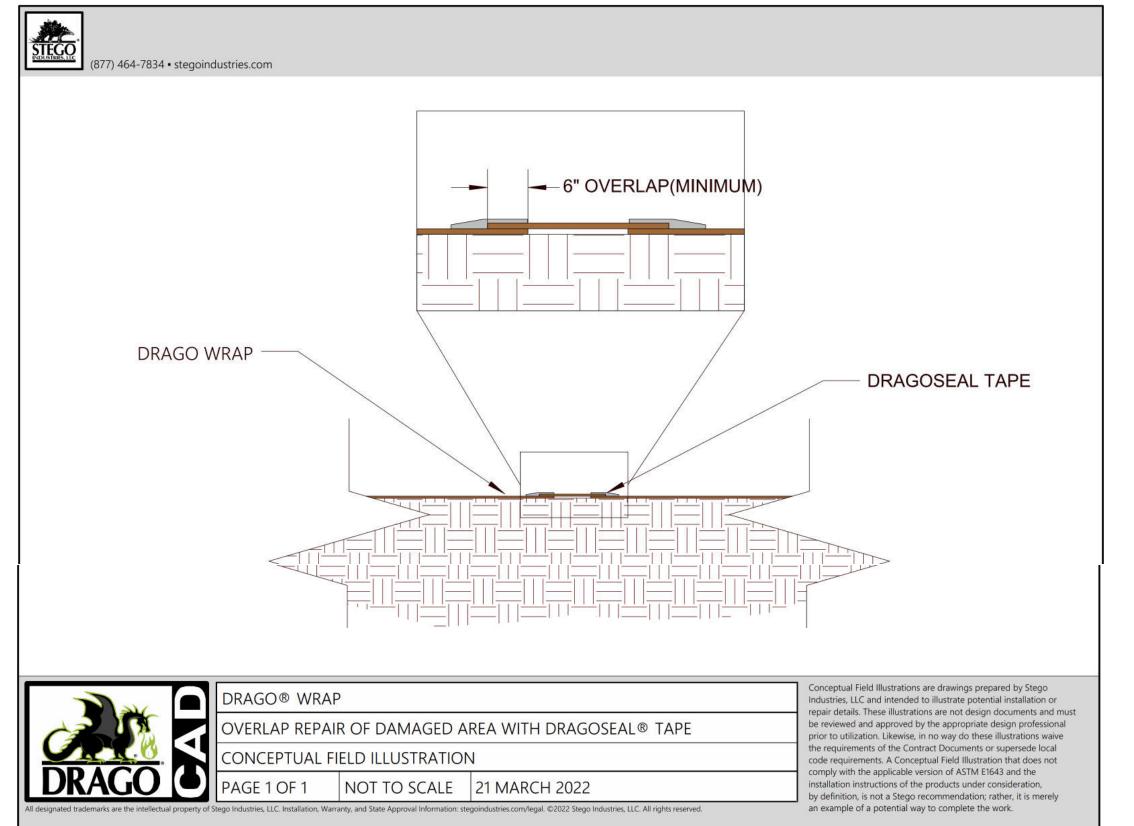



an example of a potential way to complete the work.

DATE

NRPP Mitigation ID 10995-RMS

IN Radon Mitigation Number RTM00924

VIMS DETAIL MEMBRANE

MICHAEL J DEVIR PE 10000147 INDIANAPOLIS INDIANA

BSA PROJECT NO.

FIGURE 10

SUB-SLAB VENT SYSTEM

Hex Reducing Bushing: 304 Stainless Steel, 1/2 in x 1/4 in Fitting Pipe Size, Male NPT x Female NPT

Item # 1RRP6 Mfr. Model # 1RRP6 Catalog Page # 2785

Country of Origin Taiwan. Country of Origin is subject to

The 304 stainless steel construction for this GRAINGER APPROVED hex reducing bushing features a chromium nickel materia View More ∨



Inline Coupler: Chrome Plated CA360 Brass, 1/4 in Pipe Size, Coupler x MNPT, Shut-off, PMC12

Item # 2YCW8 Mfr. Model # MCD1004 Catalog Page # N/A UNSPSC # 40142610

Country of Origin USA. Country of Origin is subject to

Chrome-Plated Brass Push-Button Tube Fittings

Max. pressure: 250 psi Temp. ran View More ∨



VENT PIPE SAMPLE PORT

TOUGH GUY Access Door: 8 in, 8 in, 8 3/8 in, 8 3/8 in, Insulated, 0.064 in Aluminum

Item 2VE89

Mfr. Model 2VE89



GRAINGER APPROVED Access Panel: 8 in, 8 in, 8 in, 8 in, Uninsulated, ABS Plastic

VAPOR

SUB-SLAB VENT PIPE

IF DAMAGED,

IMMEDIATELY

NOTIFY


BUILDING

OWNER


VENT RISER LABEL

Item 447P23

Mfr. Model 34020

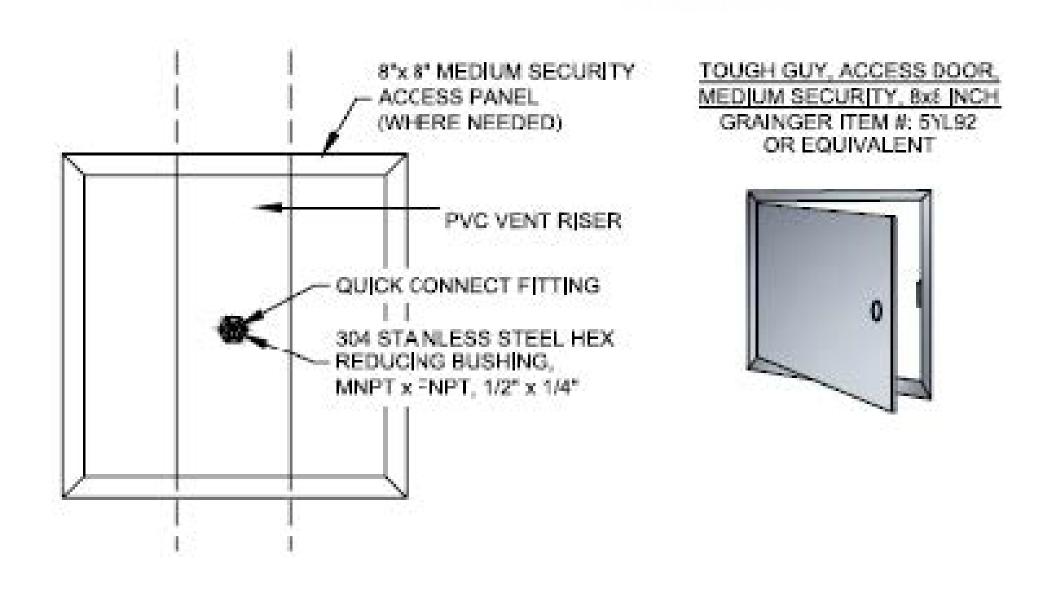

THIS IS A GENERAL DETAIL, LOCATIONS OF ACCESS DOORS TO BE DETERMINED BY OWNER AND VIMS DESIGNER,

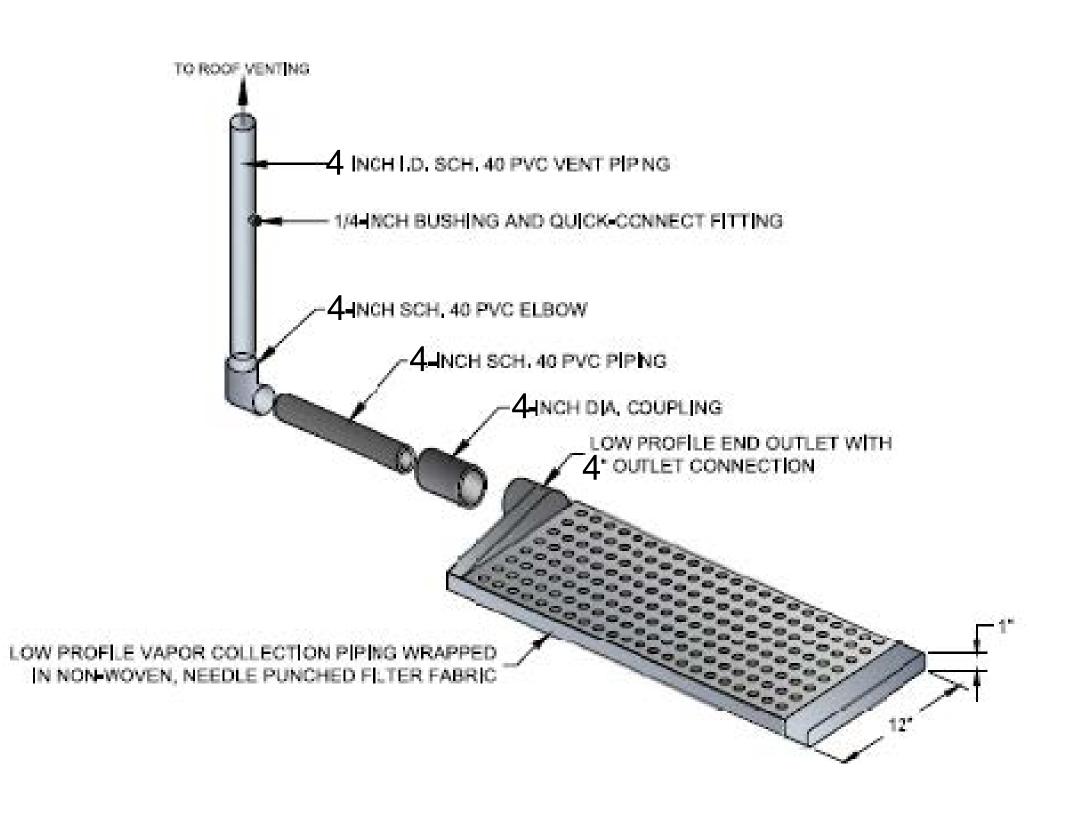

12-INCH LOW PROFILE VENT PIPING

WARNING

THIS BUILDING IS PROTECTED WITH A VAPOR MITIGATION SYSTEM. ANY PROPOSED PENETRATION OR ALTERATION OF FLOOR SLAB REQUIRES NOTIFICATION OF THE OWNER AND INSPECTION BY A QUALIFIED VIMS MEMBRANE DESIGNER.

VIMS MEMBRANE **IDENTIFICATION SIGN**



Preformed Pipe Boot

Square Material Pipe Boot

Seal 2-sided Tape


(minimum

4" Tape


Flexible Tape

4" Tape

Performed Boot

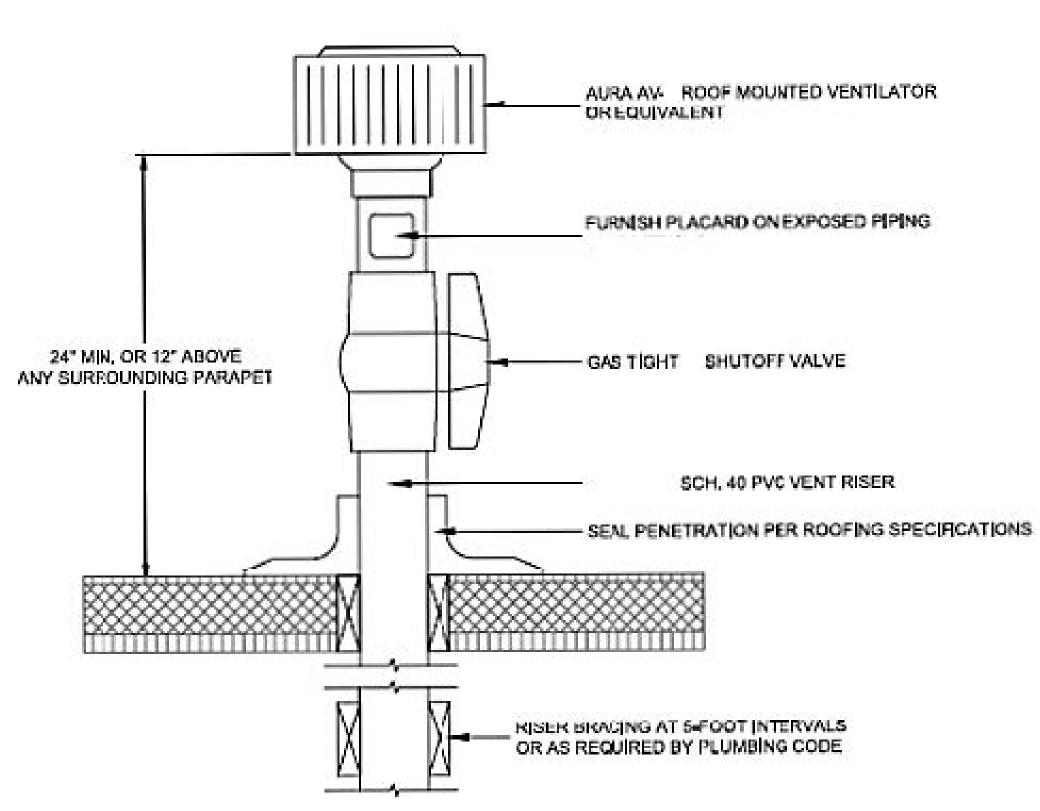

ROOF PENETRATION DETAIL

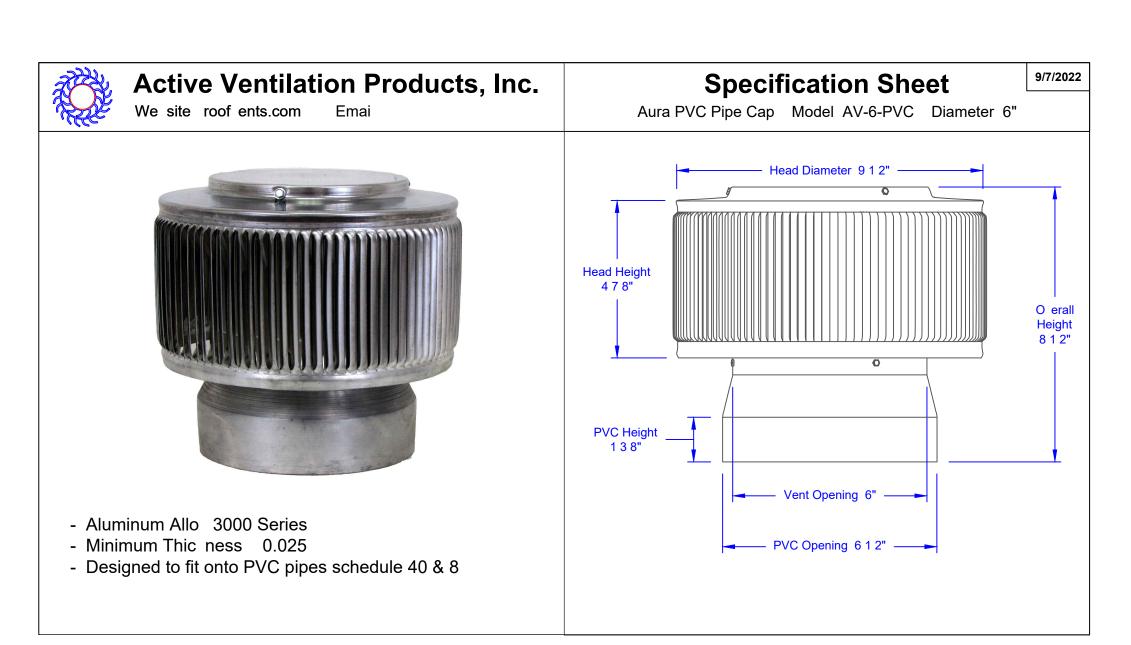

EXAMPLE ROOF MOUNTED VENTILATOR



SMITHGROUP

500 GRISWOLD SUITE 1700 DETROIT, MI 48226 313.983.3600 smithgroup.com






LAUNCH **ACCELERATOR FOR BIOSCIENCES**

INDIANAPOLIS, INDIANA

CLIENT PROJECT NO. - 20250072

CUMULATIVE DOCUMENTS BP1-CD: SITE AND FOUNDATION PACKAGE

ISSUED / REVISIONS SCHEDULE DESCRIPTION 09/29/2025 BP1-CD: SITE AND FOUNDATION PACKAGE 10/21/2025 ADDENDUM 2

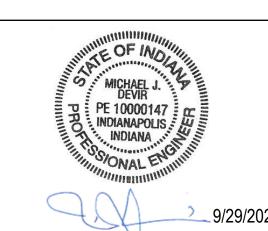


NRPP Mitigation ID 10995-RMS IN Radon Mitigation Number RTM00924

VIMS DETAIL PIPING & MISC

BSA PROJECT NO.

FIGURE 11

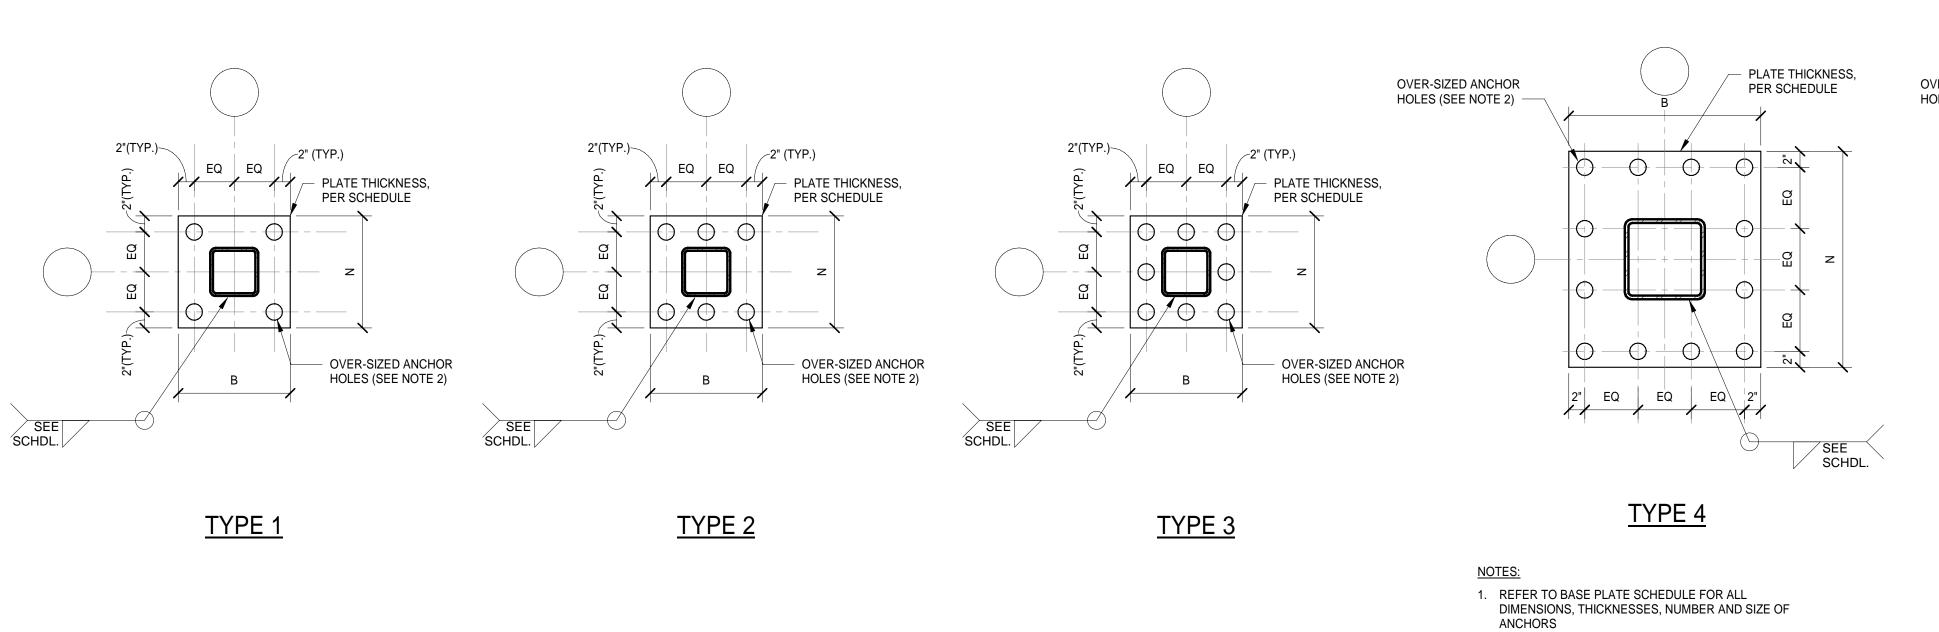


2. PROVIDE THE FOLLOWING ANCHOR HOLE DIAMETER

BASED ON ANCHOR SIZE:

3/4" ANCHOR = 1 5/16" HOLE 1" ANCHOR = 1 13/16" HOLE 1 1/4" ANCHOR = 2 1/16" HOLE 2" ANCHOR = 3 1/4" HOLE

1 TYPICAL BASE PLATE DETAILS
1" = 1'-0"

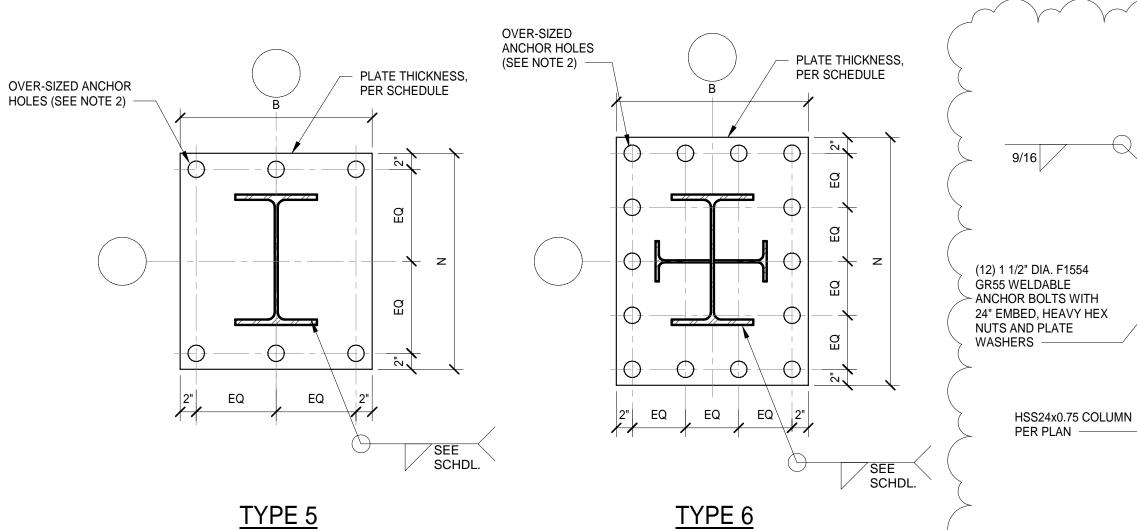

- 36" DIA. x 2 1/2" THICK PLATE HSS24x0.75 COLUMN PER PLAN TYPE 7

BSA LifeStructures 175 S. Rangeline Rd, Suite 200 Carmel, IN 46032 ph 317.819.7878 fx 317.819.7288

SMITHGROUP

500 GRISWOLD **SUITE 1700** DETROIT, MI 48226 313.983.3600 smithgroup.com

JPS CONSULTING ENGINEERS, LLC 9365 Counselors Row, Suite 116 Indianapolis, IN 46240

> ph 317.617.4270 www.jpsconsultingengineers.com




LAUNCH **ACCELERATOR FOR BIOSCIENCES**


INDIANAPOLIS, INDIANA

CLIENT PROJECT NO. - 20250072


CUMULATIVE DOCUMENTS BP1-CD: SITE AND FOUNDATION PACKAGE

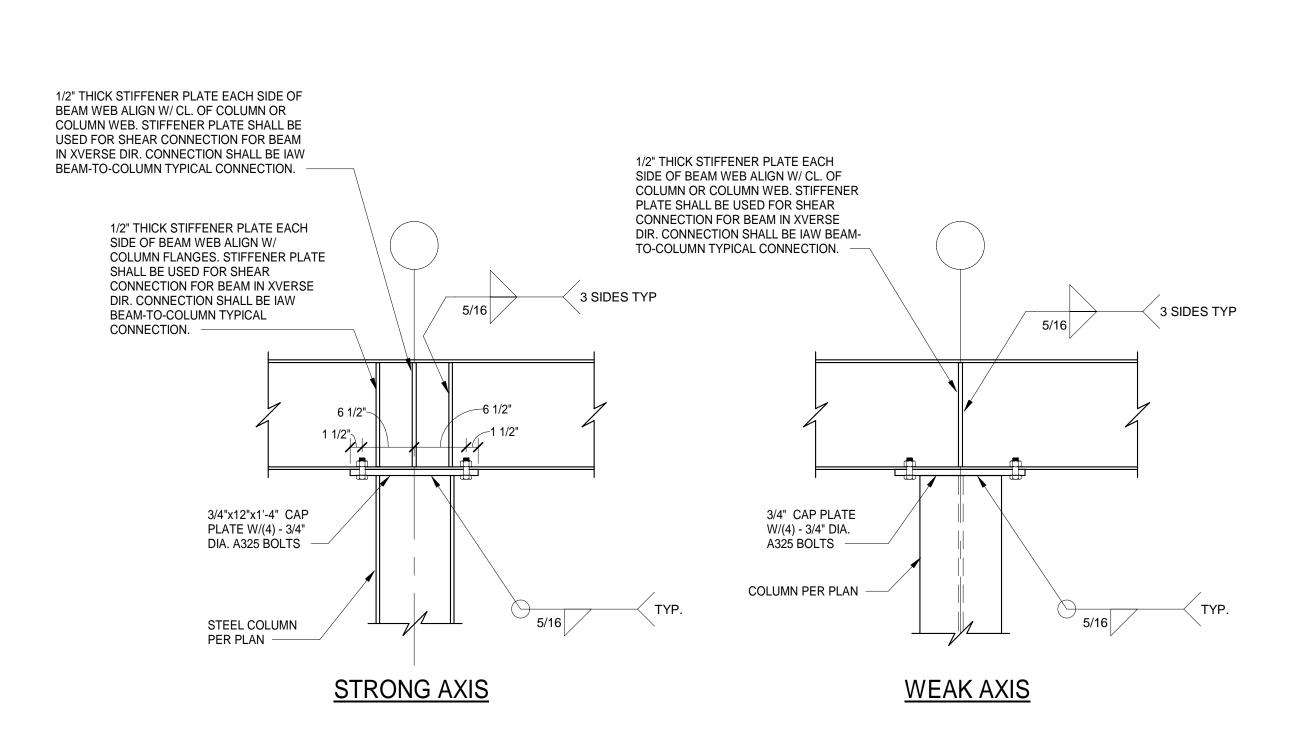


3 TYPICAL BEAM OVER COLUMN DETAIL
S007 1" = 1'-0"

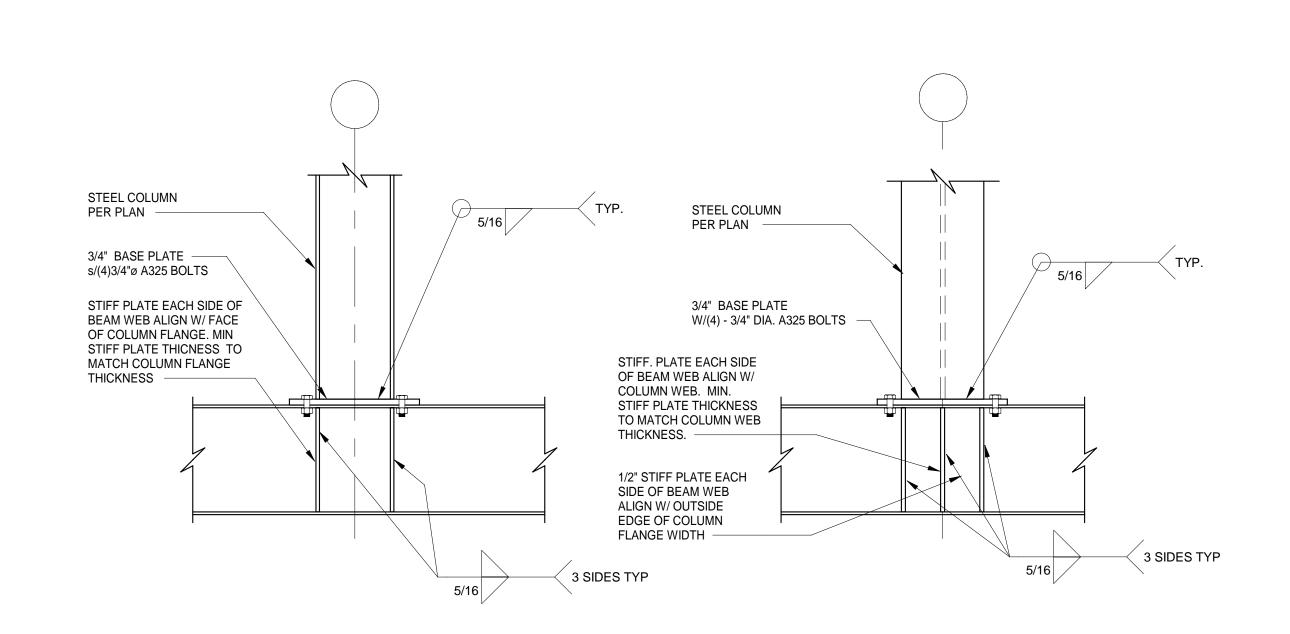



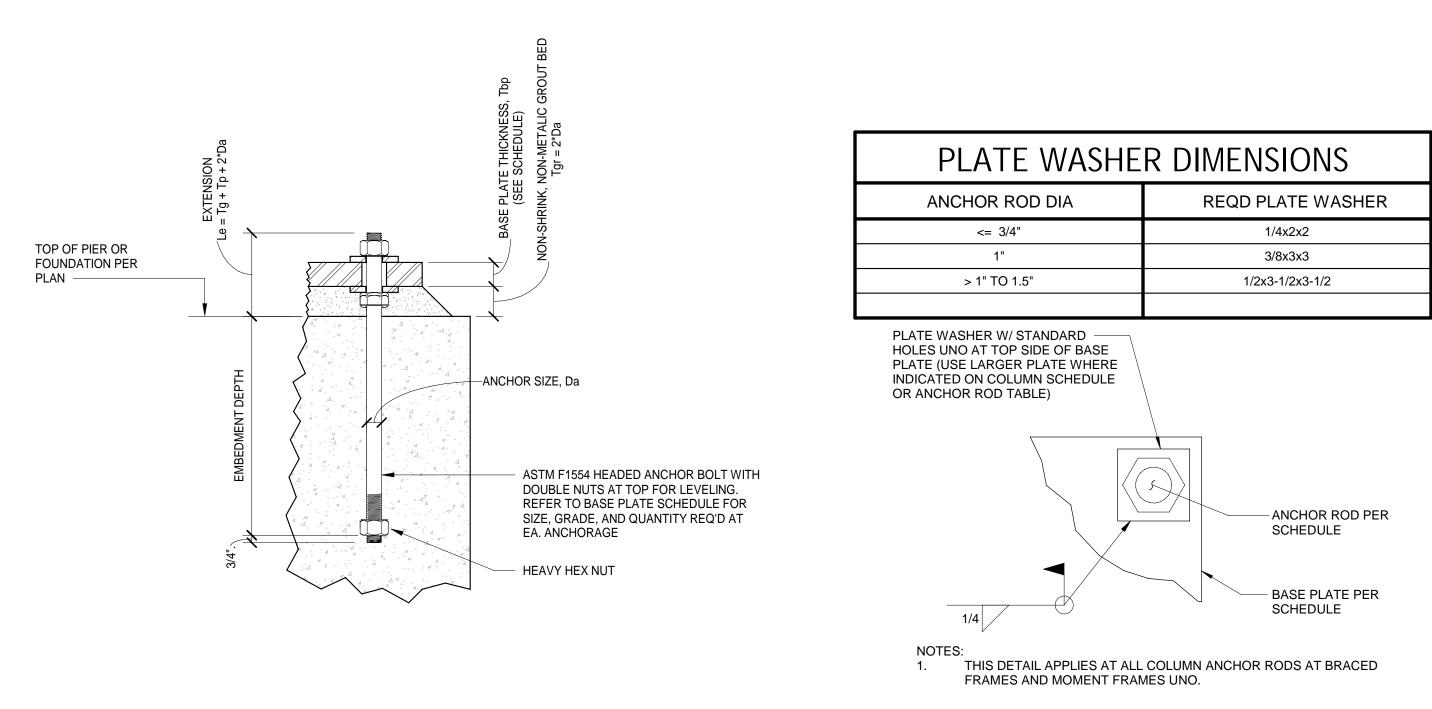


4 TYPICAL CAST IN ANCHOR DETAIL S007 1 1/2" = 1'-0"

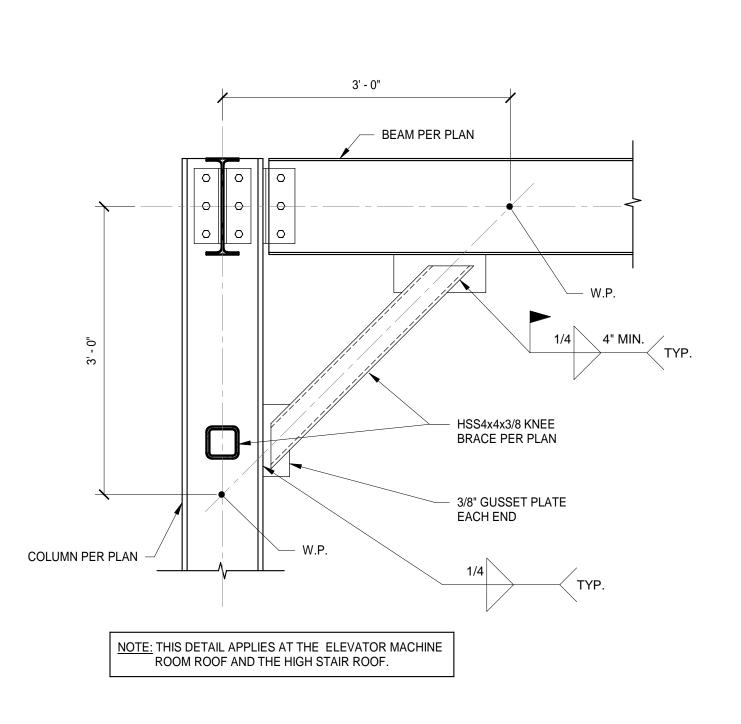


5 TYPICAL KNEE BRACE DETAIL S007 1" = 1'-0"

ISSUED/REVISION SCHEDULE MARK DATE DESCRIPTION 2 10/21/2025 ADDENDUM 2 1 09/29/2025 BP1-CD: SITE AND FOUNDATION PACKAGE						
2 10/21/2025 ADDENDUM 2 1 09/29/2025 BP1-CD: SITE AND FOUNDATION	ISSUED/REVISION SCHEDULE					
1 09/29/2025 BP1-CD: SITE AND FOUNDATION	MARK	DATE	DESCRIPTION			
. 0/2//2020	2	10/21/2025	ADDENDUM 2			
	1	09/29/2025				

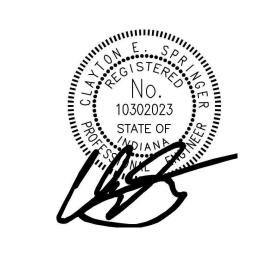

TYPICAL STEEL COLUMN DETAILS

DATE REF: SHEET INDEX BSA PROJECT NO.

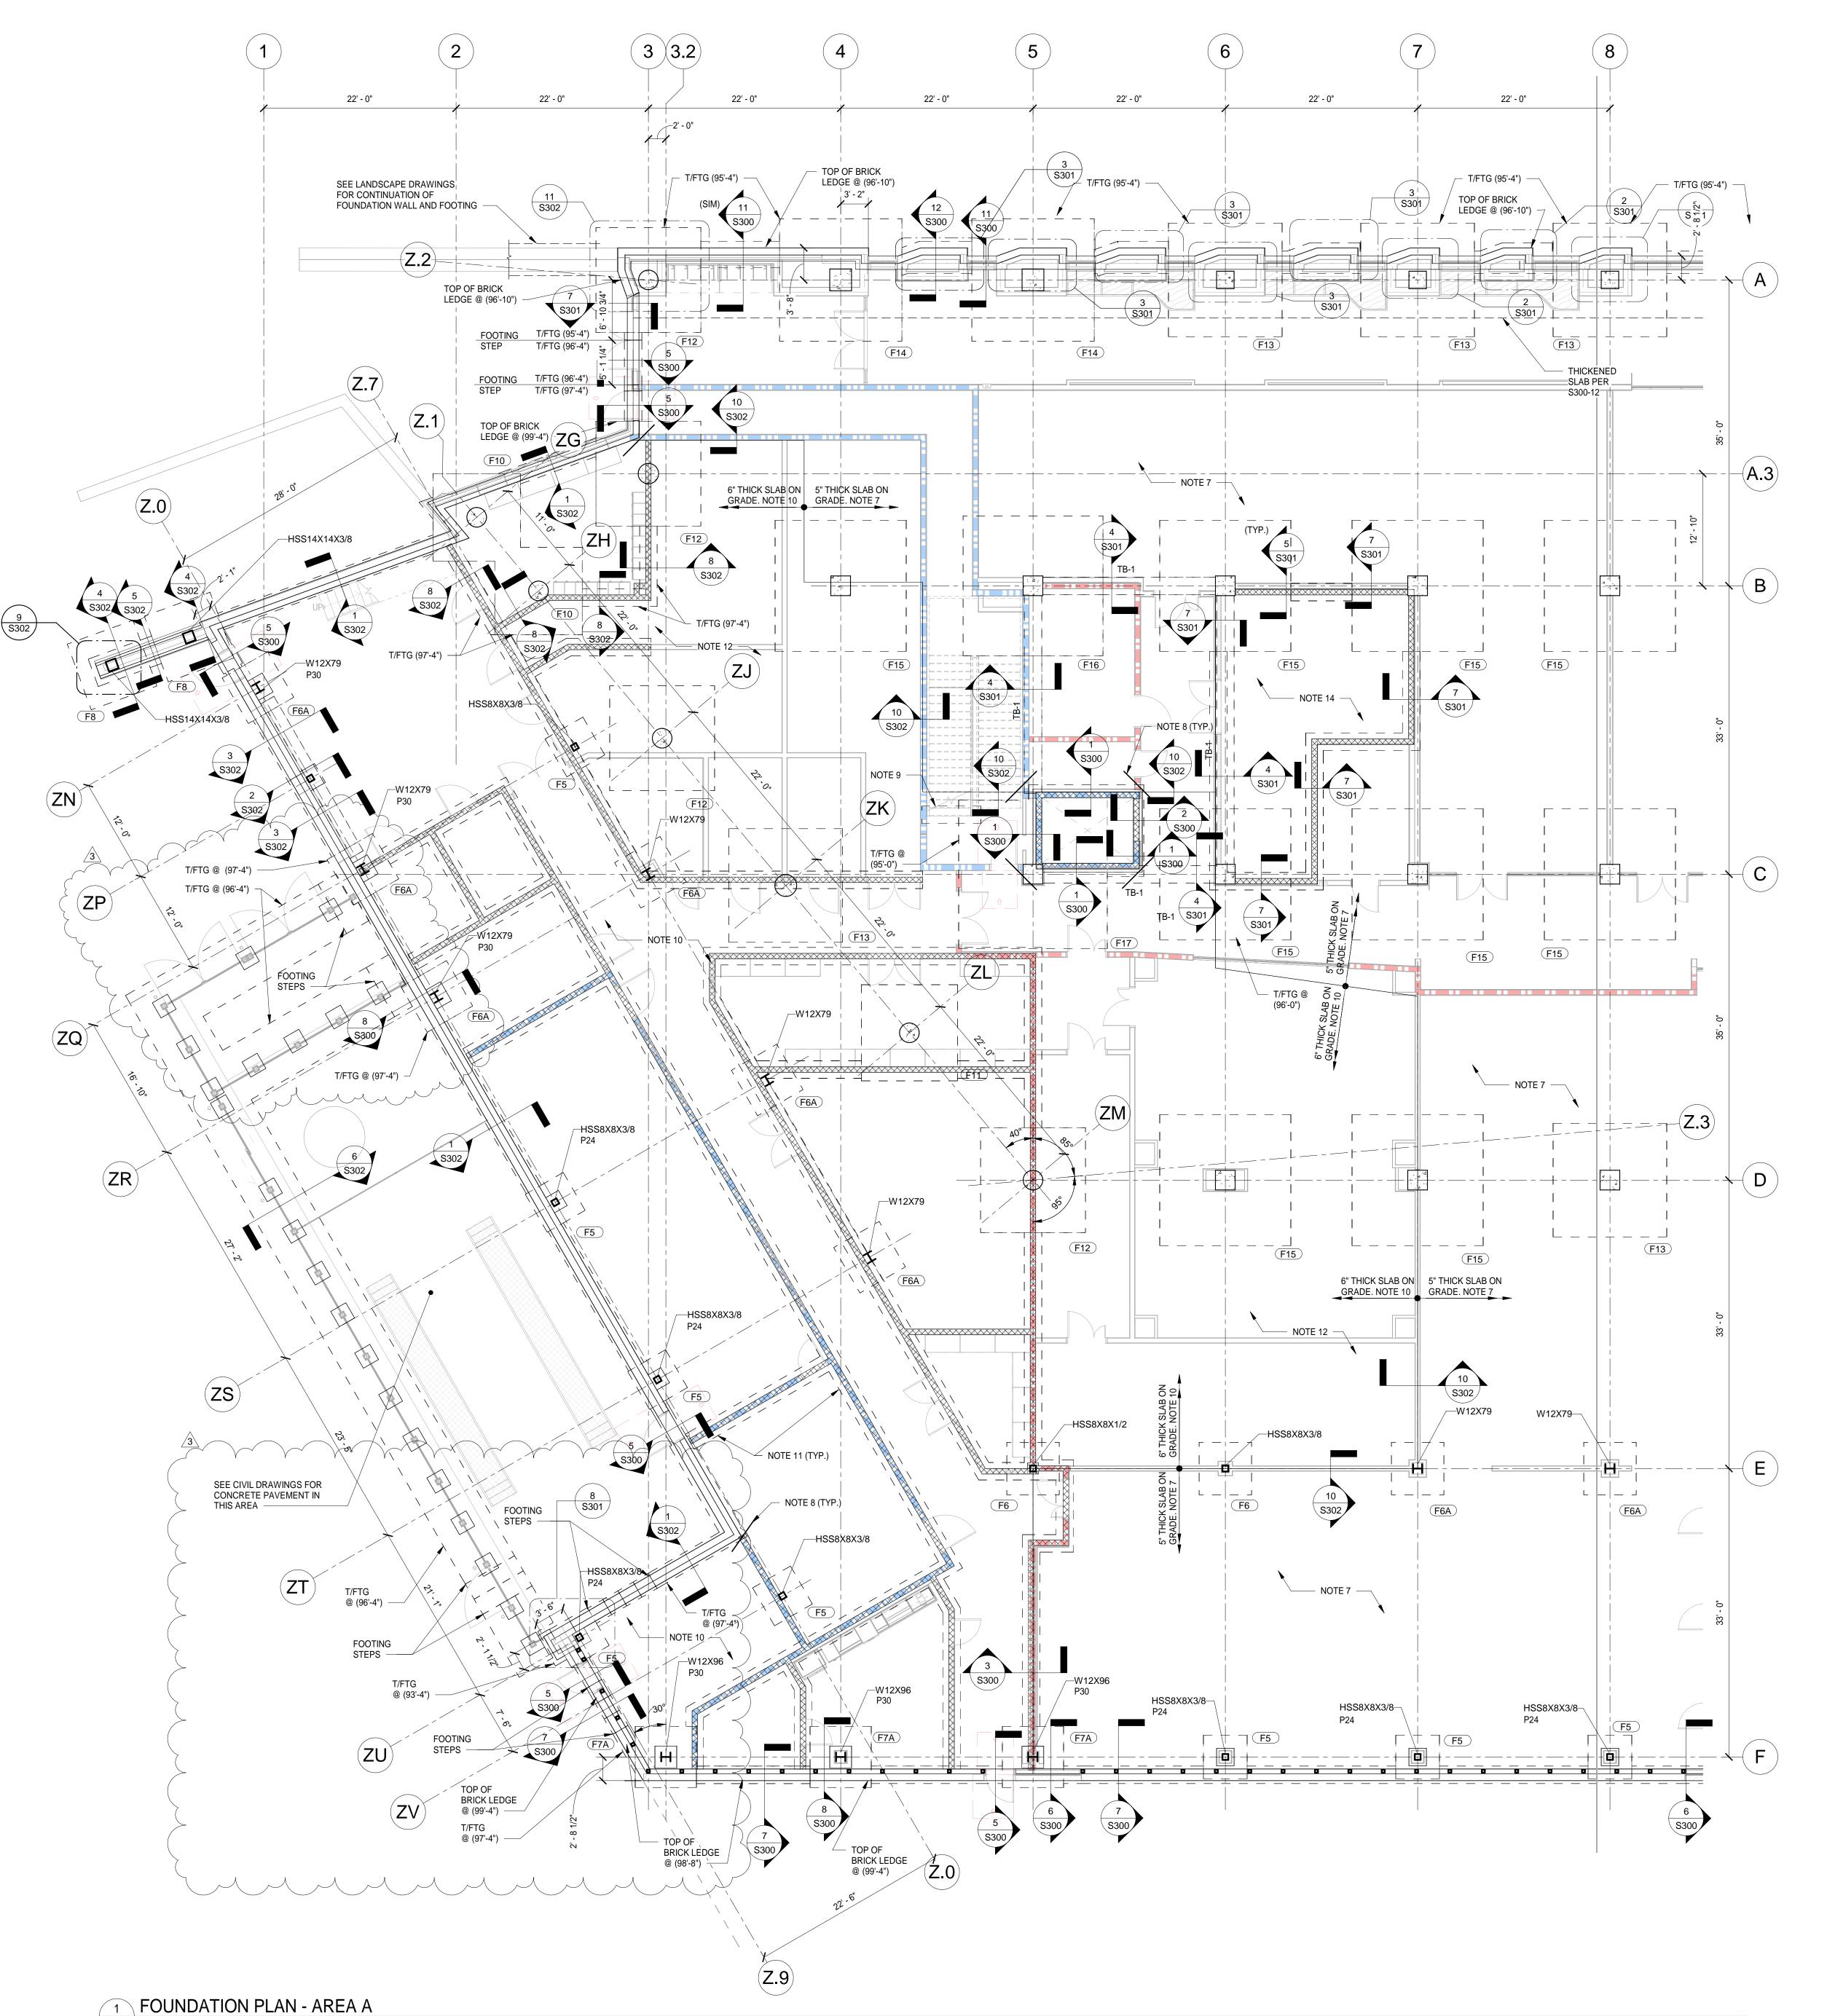

STEEL BASE PLATE SCHEDULE						
		GEO	METRY			COL TO BP
COLUMN SIZE	LENGTH, N	WIDTH, B	THICKNESS, Tp	TYPE	ANCHORAGE	WELD SIZE
HSS8x8	14	14	1	1	4 - 1" DIA. x 15" EMBED GR R1554-55	5/16
HSS10x10	16	16	1	2	6 - 1" DIA. x 15" EMBED GR R1554-55	5/16
\HSS12x12	24	24	1 1/2	3	8 - 1 3/8" DIA. x 18" EMBED GR R1554-55	7/16
HSS24" DIAx0.75"	36 DIA.	The second second	2 1/2	7	12 - 1 1/2" DIA. x 24" EMBED GR 1554-55	9/16
HSS28x28	36	36	2 1/2	4	12 - 1 3/8" DIA. x 18" EMBED GR R1554-55	9/16
HSS30x30	38	38	2 1/2	4	12 - 1 3/8" DIA. x 18" EMBED GR R1554-55	9/16
W12	24	18	1 1/2	5	6 - 1" DIA. x 15" EMBED GR R1554-55	7/16
W14	24	18	1 1/2	5	6 - 1 3/8" DIA. x 18" EMBED GR R1554-55	7/16
W27 CRUCIFORM	36	36	2 1/2	6	12 - 1 3/8" DIA. x 18" EMBED GR R1554-55	9/16

NOT

- 1. REFER TO GENERAL NOTES FOR INFORMATION PERTAINING TO STRUCTURAL STEEL CONSTRUCTION
- 2. REFER TO PLAN FOR COLUMN S
- 3. REFER TO TYPICAL BASE PLATE DETAIL ON SHEET S007 FOR BASE PLATE FABRICATION AND ATTACHMENT REQUIREMENT
- ANCHOR LAYOUT SHALL MATCH BASE PLATE HOLE LAYOUT SHOWN IN TYPICAL BASE PLATE DETAIL AND GIVEN IN THIS
- 5. CONTRACTOR SHALL USE RIGID TEMPLATES TO SET ANCHORS IN CORRECT POSITION AND ELEVATION.

PIER SCHEDULE						
MARK	PIER SIZE	PIER VERT	PIER TIES	REMARKS		
WARK	WxL	REINF	PIER IIES	KEWAKKS		
P24	24" x 24"	(8)-#7	#4	NOTE 4		
P30	30" x 30"	(12)-#7	#4	NOTE 4, NOTE 5		
P48	48" x 48"	(16)-#9	#4	NOTE 4, NOTE 5		

- SPACE TIES AT 4" ON CENTER ALONG THE ANCHOR BOLT LENGTH AND AT 12" ON CENTER THEREAFTER, TYPICAL ALL PIERS.
 TOP OF PIER ELEVATION SHALL BE 99'-4" UNLESS NOTED OTHERWISE. (SEE NOTE 5 IN REMARKS)
 SEE PLAN FOR PIER SIZE AND LOCATION.
- PROVIDE STANDARD HOOKS TOP AND BOTTOM FOR THE VERTICAL BARS. HOOKS CAN GO ANY DIRECTION WITHIN THE PIER. IT IS ACCEPTABLE TO OFFSET THE HOOKS VERTICALLY BY 1" TO AVOID CONGESTION IF NECESSARY.

 WHERE NOTED IN THE REMARKS, THE TOP OF PIER ELEVATION SHALL BE AT (99'-0") UNLESS NOTED OTHERWISE ON
- PLAN.
 ALTERNATE 90° & 135° HOOKS, TYPICAL.

	COLUMN FO	OOTING SCHED	JLE
MARK	FOOTING SIZE (W x L x D)	FOOTING REINFORCEMENT	REMARKS
F5	5'-0" x 5'-0" x 1'-6"	9 - #5 EW BOTTOM	
F6	6'-0" x 6'-0" x 1'-6"	12 - #5 EW BOTTOM	
F6A	6'-0" x 6'-0" x 1'-6"	12 - #5 EW TOP & BOTTOM	
F7	7'-0" x 7'-0" x 1'-6"	7 - #6 EW BOTTOM	
F7A	7'-0" x 7'-0" x 1'-6"	7 - #6 EW TOP & BOTTOM	
F8	8'-0" x 8'-0" x 1'-6"	10 - #6 EW BOTTOM	
F9	9'-0" x 9'-0" x 2'-0"	10 - #7 EW BOTTOM	
F10	10'-0" x 10'-0" x 2'-6"	12 - #7 EW BOTTOM	
F11	11'-0" x 11'-0" x 2'-6"	14 - #7 EW BOTTOM	
F12	12'-0" x 12'-0" x 2'-6"	12 - #8 EW BOTTOM	
F12A	12'-0" x 12'-0" x 2'-6"	12 - #8 EW TOP & BOTTOM	
F13	13'-0" x 13'-0" x 3'-0"	20- #7 EW BOTTOM	
F14	14'-0" x 14'-0" x 3'-0"	17 - #8 EW BOTTOM	
F15	15'-0" x 15'-0" x 3'-0"	20 - #8 EW BOTTOM	
F16	16'-0" x 16'-0" x 3'-0"	23 - #8 EW BOTTOM	
F17	17'-0" x 17'-0" x 3'-6"	24 - #8 EW BOTTOM	

ALLOWABLE SOIL (STRUCTURAL FILL) BEARING PRESSURE = 6000 PSF (UNFACTORED), UNO. IN ORDER TO OBTAIN THIS BEARING PRESSURE, THE GROUND MUST BE IMPROVED BY A

DI ANI NOTEO

- PLAN NOTES:

 1. REFER TO SHEETS S001 S013 FOR GENERAL NOTES AND TYPICAL DETAILS.
- 2. TOP ALL FOOTINGS ALONG PERIMTER OF BUILDING SHALL BE AT ELEVATION (97'-4") AND INTERIOR FOOTINGS SHALL BE @ ELEVATION (98'-6') UNLESS NOTED OTHERWISE.

RAMMED AGGREGATE PIER SYSTEM DESIGNED BY A SPECIALTY ENGINEER.

- 3. THE THE ELEVATOR PIT SHALL BE 2'-0" THICK SLAB WITH #5 @ 12" O.C. EACH WAY AT TOP AND BOTTOM. TOP OF SLAB SHALL BE AT ELEVATION (95'-0"). 2'-0" x 2'-0" x 18" DEEP SUMP PIT SHALL BE LOCATED AS SHOWN ON THE ELEVATOR MANUFACTURERS DRAWINGS. SEAL WATERTIGHT AROUND THE SLEEVE. VERIFY SIZE AND DEPTH OF ELEVATOR PIT WITH THE ELEVATOR SUPPLIER, PRIOR TO FABRICATION OR CONSTRUCTION. ELEVATOR PIT WALLS AND BASE SHALL HAVE XYPEX WATERPROOFING ADMIXTURE IN
- 4. TB-1 INDICATES A 24"x24" TIE BEAM WITH (4)-#8 CONT. AND #4 TIES AT 12" ON CENTER..
- 5. FOR COLUMN SCHEDULE AND DETAILS REFER TO SHEET S200.
- 6. FOR COLUMN FOOTING SCHEDULE REFER TO SHEET S110A.
- 7. THE SLAB ON GRADE SHALL BE 5" SLAB WITH 6x6-W2.1xW2.1 W.W.F. ON VAPOR BARRIER OVER 6" COMPACTED DRAINAGE FILL OVER PROOF ROLLED SUBGRADE. TOP OF SLAB SHALL BE AT ELEVATION (100'-0") UNLESS NOTED OTHERWISE.
- 8. AT CORNER OF ALL COLUMNS WITHOUT DIAMOND SHAPED CONTROL JOINT AND ALL CORNERS OF WALLS SHOWN ON THIS PLAN, PROVIDE (1)-#4 x 5'-0" DIAGONAL IN CENTER OF SLAB AT EVERY CORNER. TYPICAL AT COLUMNS AND WALL CORNERS.
- 9. THICKEN THE SLAB AT THE BASE OF ALL STAIR STRINGERS TO AN 8" SLAB WITH #4@12" ON CENTER EACH WAY MIDDLE. THE FOOTPRINT OF THE THICKENED SLAB SHALL BE 12" LARGER THAN THE FOOTPRINT OF THE BASE OF THE STAIR STRINGERS.
- 10. THE SLAB ON GRADE SHALL BE A 6" SLAB WITH 6x6 W2.9xW2.9 W.W.F. ON VAPOR BARRIER OVER 6" COMPACTED DRAINAGE FILL OVER PROOF ROLLED SUBGRADE. THE TOP OF SLAB SHALL BE AT
- ELEVATION (100'-0") UNLESS NOTED OTHERWISE.


 11. PROVIDE THICKENED SLABS BELOW ALL CMU WALLS. SEE TYPICAL DETAILS FOR ADDITIONAL
- 12. BRICK LEDGE ELEVATION SHALL BE AT (99'-4") UNLESS NOTED OTHERWISE.
- 13. ALL INTERIOR CMU WALLS SHALL HAVE #4@48" ON CENTER IN GROUTED CELLS WITH MATCHING DOWELS UNLESS NOTED OTHERWISE. SEE TYPICAL DETAILS FOR BRACING REQUIREMENTS AT THE TOPS OF CMU WALLS. CMU WALLS AROUND ELEVATOR SHAFTS SHALL HAVE #5@24" ON CENTER IN GROUTED CELLS WITH MATCHING DOWELS.
- 14. PROVIDE 8" SLAB ON GRADE WITH #4@12" ON CENTER EACH WAY MIDDLE OVER VAPOR BARRIER OVER 6" COMPACTED GRANULAR FILL OVER PROOF ROLLED SUBGRADE. THIS SLAB SHALL BE ISOLATED FROM THE SURROUNDING SLAB. SEE DETAILS.



BSA LifeStructures 175 S. Rangeline Rd, Suite 200 Carmel, IN 46032 ph 317.819.7878 fx 317.819.7288

SMITHGROUP

500 GRISWOLD SUITE 1700 DETROIT, MI 48226 313.983.3600 smithgroup.com

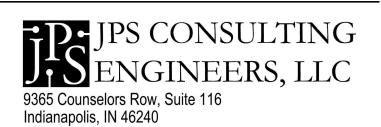

ph 317.617.4270 www.jpsconsultingengineers.com




LAUNCH ACCELERATOR FOR BIOSCIENCES

INDIANAPOLIS, INDIANA

CLIENT PROJECT NO. - 20250072

CUMULATIVE DOCUMENTS

BP1-CD: SITE AND FOUNDATION PACKAGE

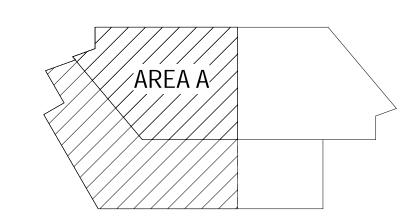




ISSUED/REVISION SCHEDULE						
MARK	DATE	DESCRIPTION				
3	10/21/2025	ADDENDUM 2				
2	10/15/2025	BP1 Addendum 01				
1	09/29/2025	BP1-CD: SITE AND FOUNDATION PACKAGE				



FOUNDATION PLAN - AREA

DATE REF: SHEET INDEX
BSA PROJECT NO. 00360481

S110A

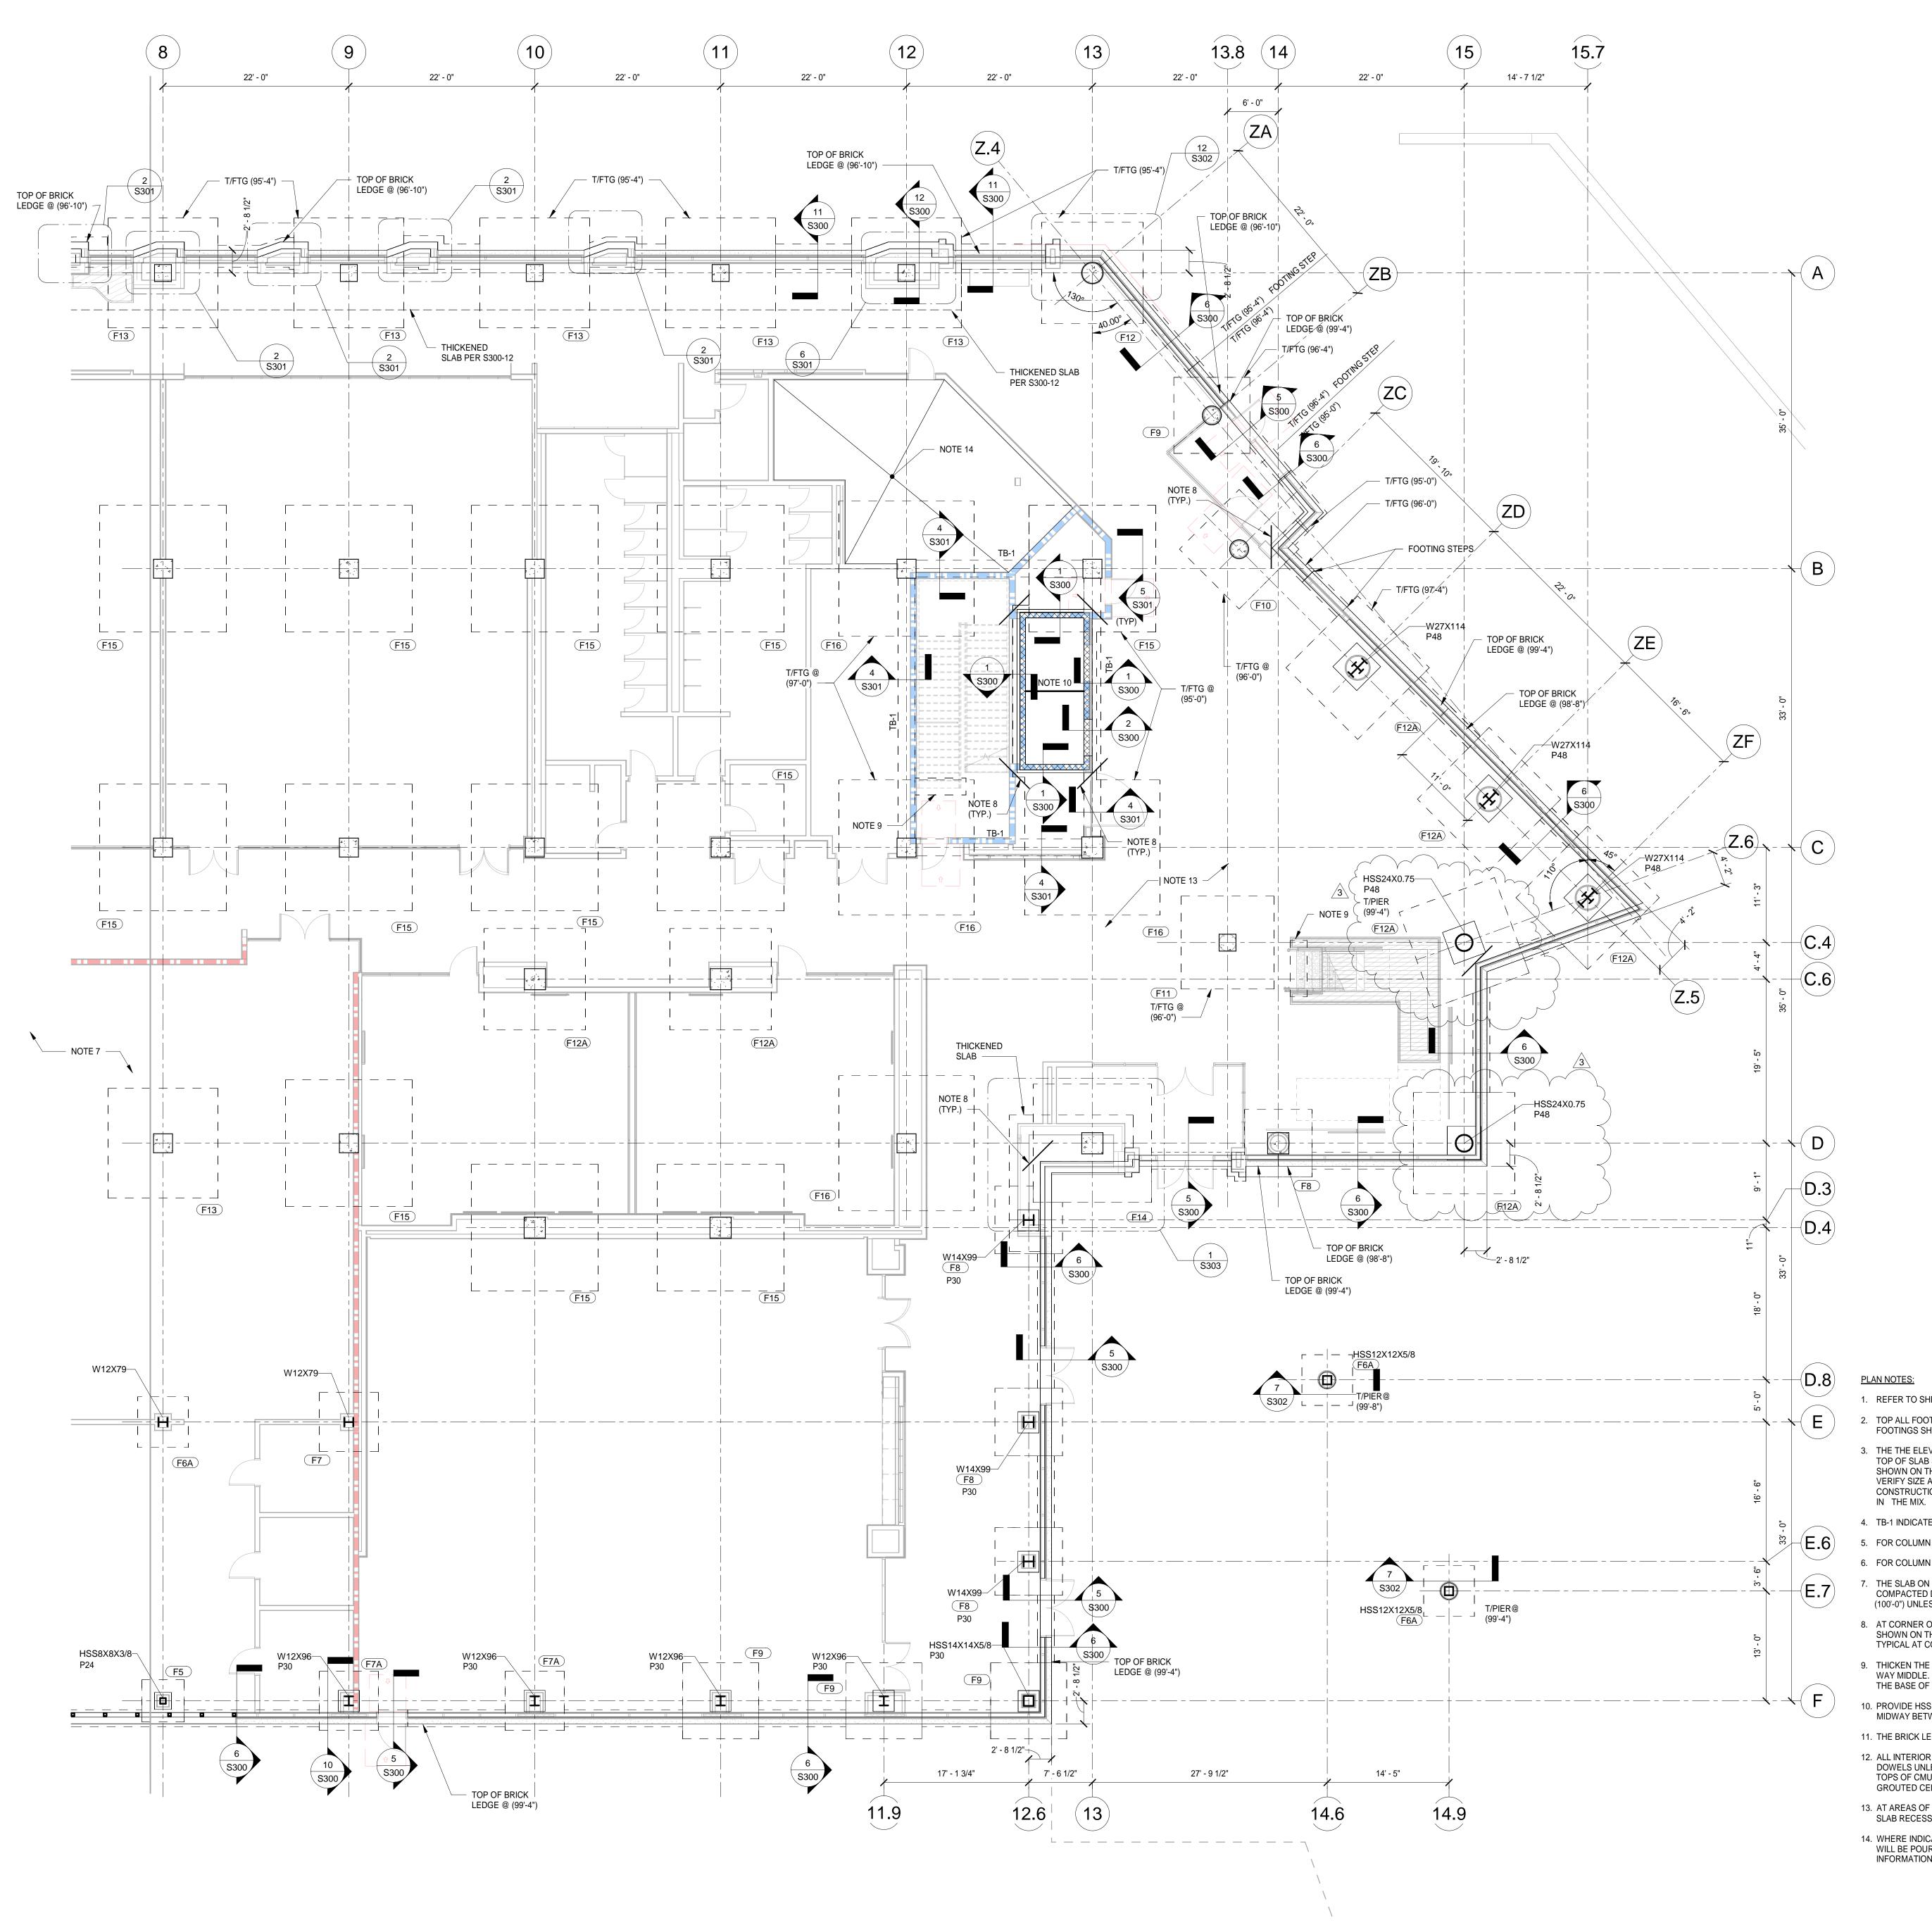



BSA LifeStructures 175 S. Rangeline Rd, Suite 200 Carmel, IN 46032 ph 317.819.7878 fx 317.819.7288

SMITHGROUP

500 GRISWOLD SUITE 1700 DETROIT, MI 48226 313.983.3600 smithgroup.com

JPS CONSULTING ENGINEERS, LLC 9365 Counselors Row, Suite 116 Indianapolis, IN 46240

> ph 317.617.4270 www.jpsconsultingengineers.com




LAUNCH **ACCELERATOR FOR BIOSCIENCES**

INDIANAPOLIS, INDIANA


CLIENT PROJECT NO. - 20250072

CUMULATIVE DOCUMENTS BP1-CD: SITE AND FOUNDATION PACKAGE

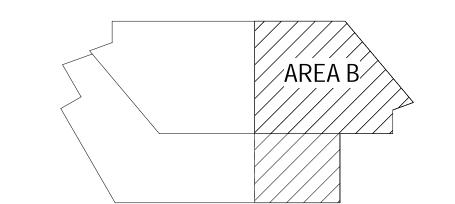



ISSUED/REVISION SCHEDULE					
MARK	DATE	DESCRIPTION			
3	10/21/2025	ADDENDUM 2			
2	10/15/2025	BP1 Addendum 01			
1	09/29/2025	BP1-CD: SITE AND FOUNDATION PACKAGE			

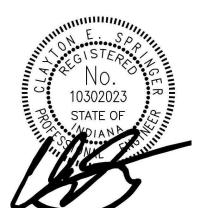

FOUNDATION PLAN - AREA

DATE REF: SHEET INDEX BSA PROJECT NO.

- 1. REFER TO SHEETS S001 S013 FOR GENERAL NOTES AND TYPICAL DETAILS.
- 2. TOP ALL FOOTINGS ALONG PERIMTER OF BUILDING SHALL BE AT ELEVATION (97'-4") AND INTERIOR FOOTINGS SHALL BE @ ELEVATION (98'-6') UNLESS NOTED OTHERWISE.
- 3. THE THE ELEVATOR PIT SHALL BE 2'-0" THICK SLAB WITH #5 @ 12" O.C. EACH WAY AT TOP AND BOTTOM. TOP OF SLAB SHALL BE AT ELEVATION (95'-0"). 2'-0" x 2'-0" x 18" DEEP SUMP PIT SHALL BE LOCATED AS SHOWN ON THE ELEVATOR MANUFACTURER'S DRAWINGS. SEAL WATERTIGHT AROUND THE SLEEVE. VERIFY SIZE AND DEPTH OF ELEVATOR PIT WITH THE ELEVATOR SUPPLIER PRIOR TO FABRICATION OR CONSTRUCTION. ELEVATOR PIT WALLS AND BASE SHALL HAVE XYPEX WATERPROOFING ADMIXTURE
- 4. TB-1 INDICATES A 24"x24" TIE BEAM WITH (4)-#8 CONT. AND #4 TIES AT 12" ON CENTER.
- 5. FOR COLUMN SCHEDULE AND DETAILS REFER TO SHEET S200.
- 6. FOR COLUMN FOOTING SCHEDULE REFER TO SHEET S110A.
- THE SLAB ON GRADE SHALL BE 5" SLAB WITH 6x6-W2.1xW2.1 W.W.F. ON VAPOR RETARDER OVER 6" COMPACTED DRAINAGE FILL OVER PROOF ROLLED SUBGRADE. TOP OF SLAB SHALL BE AT ELEVATION (100'-0") UNLESS NOTED OTHERWISE.
- 8. AT CORNER OF ALL COLUMNS WITHOUT DIAMOND SHAPED CONTROL JOINT AND ALL CORNERS OF WALLS SHOWN ON THIS PLAN, PROVIDE (1)-#4 x 5'-0" DIAGONAL IN CENTER OF SLAB AT EVERY CORNER. TYPICAL AT COLUMNS AND WALL CORNERS.
- WAY MIDDLE. THE FOOTPRINT OF THE THICKENED SLAB SHALL BE 12" LARGER THAN THE FOOTPRINT OF THE BASE OF THE STAIR STRINGERS.
- 10. PROVIDE HSS12x6x1/4 DIVIDER BEAM BETWEEN ELEVATORS AT EACH FLOOR LINE AND MIDWAY BETWEEN FLOORS.
- 11. THE BRICK LEDGE SHALL BE AT ELEVATION (99'-4") UNLESS NOTED OTHERWISE.
- 12. ALL INTERIOR CMU WALLS SHALL HAVE #4@48" ON CENTER IN GROUTED CELLS WITH MATCHING DOWELS UNLESS NOTED OTHERWISE. SEE TYPICAL DETAILS FOR BRACING REQUIREMENTS AT THE TOPS OF CMU WALLS. CMU WALLS AROUND ELEVATOR SHAFTS SHALL HAVE #5@24" ON CENTER IN GROUTED CELLS WITH MATCHING DOWELS.
- 13. AT AREAS OF TERRAZZO FLOOR, PROVIDE A 3/8" RECESSED SLAB. COORDINATE DIMENSIONS OF THE SLAB RECESS AND CONTROL JOINT LAYOUT WITH FUTURE INTERIOR PACKAGES.
- 14. WHERE INDICATED ON PLAN, DO NOT POUR THE SLAB ON GRADE IN THIS ROOM AT THIS TIME. THIS SLAB WILL BE POURED AS PART OF A FUTURE PROJECT ONCE THE LAYOUT OF THE ROOM AND THE UNDERSLAB INFORMATION IS KNOWN.

2025007	20250072 - IU LAB - BP1 Bidder RFI's							
RFI#	Bid Package	Discipline	Sheet/Spec Section	Question	Answer	Response By	Addendum	
1	BE1-03A	Structural	5203, 5226, 3 & 4/5202	Structural Sheets S203 to S226 show gravity and lateral beam schedules with reinforcement details, including top and bottom continuous bar lengths and arrangements for all levels from Level 02 to the Penthouse. However, the typical concrete beam details on Sheets 3 and 4/S202 show conditions for gravity and lateral beams that completely differ from those in the schedules. So, Shall we follow the top and bottom longitudinal reinforcement bar arrangements and lengths as per the beam schedule sheets (\$203 to \$226) and disregard the typical detail sheets? Please confirm. See attached drawing for reference.	This is not a BP-1 question. This will be clarified as the design evolves and will be included in future bid packages	JPS		
2	BE1-31B	Civil	31 60 00	In the spec it says we have to be an approved vendor to submit a bid. It says we have to be approved by the geotech and I believe the structural engineer. Do you know how we do that?	If you have a history of completing projects of this size and scope, you would be approved for this project.	JPS	N/A	
3	BE1-31B	Civil	31 60 00	The specs state that the psf is 5000 and the drawings say 6000 psf, please advise to which is the correct psf.	Please use 6000 PSF for the bearing capacity over rammed aggregate piers.	JPS	N/A	
4	BE1-03A	Structural	03 10 00	Can the specific areas that will require the formed surfaces to be Class C be clarified or defined?	This is not a BP-1 question. This will be clarified as the design evolves and will be included in future bid packages.	JPS		
5	BE1-03A	Structural	03 30 00	Plan Note on 8 on sheets \$106A & \$106B references a 2* topping slab in the penthouse area, and references the architectural drawings to for the extents of said topping slab. There is no reference to a topping slab in the architectural drawings. Please clarify.	This is not a BP-1 question. This will be clarified as the design evolves and will be included in future bid packages.	JPS	N/A	
6	BE1-32B	Landscape	C500/LA100	Looking at sheet C500 – Site Improvement Plan, the concrete walk along the north and east side of the building is Noted as Note 18. Note 18 on Sheet C500 calls for "Acid Etch / Integral Concrete Walk and Base. Refer to Landscape Plan." When I look at the Landscape Plan, Sheet LA100, it appears there are depictions of 2 types of concrete finishes in these areas, "Integral Concrete Walk and Base Type 1" and "Integral Concrete Walk and Base Type 2". Can we get more clarification to what is designed or wanted?	Addressed in Addendum			
7	BE1-32B	Landscape	C500/LA100	There is a drive entrance at the North/West Corner of the building off of Indiana Ave. On Sheet C500 the driveway is noted as Note 9 "6" Concrete Pavement" but on Sheet L4100 this area is depicted as "Integral Concrete Walk and Base Type 1". Please Clarify.	Addressed in Addendum			
8	BE1-32B	Landscape	C500/LA100	To the West of the drive entrance off of Indiana Ave, on Sheet LA100 there is sidewalk depicted as "Intregral Concrete Walk Type 1" but on Sheet CS00 in this same area, there is no note of there being any work in this area. Please advise if there is to be concrete work in this area and if so, what time.	Follow Sheet LA100 - include required demolition to acceptabe connection to existing sidewalk.			
9	BE1-32B	Civil	C500	On the West side of the building on Sheet C500, there is a fenced in area. A Dumpster area that has Note 35 "8" Concrete Pavement" and Note 11 "Waste Container Pad and Enclosure" Please Clarify is this area just 8" Concrete? Also in this area, there is a larger fenced in area that appears to have a piece of equipment setting in it. There is Note 35 "8" Concrete Pavement but there is also a Note 35 pointing to what appears could be an Equipment Pad for the equipment. Please clarify this area.	The enirte MEP yard should be 8" Concrete Pavement. Refer to concrete pavement detail 16 on sheet C510.	JPS	N/A	
10	BE1-32B	Civil		BE1-32B – Site Concrete bid package scope of work says we are responsible for the Integral Retaining Wall for Monument Sign. Can you confirm this bid package is only responsible for the concrete portion and the Stone Cladding and Wall Cap is by others?	Yes, Correct. Bid Package BE1-32B is only responsible for the concrete portion, the stone cladding and wall cap is by others.	FAW	N/A	
11	BE1-32B	Civil	C511	On Sheet C511 for details, there are INDOT Details referenced for the ADA Ramp Detectable Warning Elements. Specifically using brick pawers for the detectable warning areas. All of the ADA Ramps appear to be in the City Right of Way. I don't believe The City of Indianapolis will allow brick pawers warning elements and requires the use of the Cast Iron ADA Warning Plates. Please advise to what we are to use.	Use Cast Iron ADA Detectable Warning Surface at ramps in the City Right of Way.	JPS		
12	BE1-32B	Civil		Please confirm the tree grates are to be furnished by others and not by Bid Package BE1-32B-Site Concrete bidders.	Yes, Correct. Bid Package BE1-32C will furnish the tree grates.	FAW	N/A	
13		Civil		Soil Management Plan requires 'Site Worker adherence to the contractor's Health and Safety Plan (HASP)'. Please provide HASP for review.	See FAW's HASP			
14	BE1-31B	Civil		2.Please identify all foundation types requiring RAP Improvements (column footings, wall footings, mat foundations, tie beams, slabs on grade, thickened slabs, etc.) and please delineate bearing pressures required for each foundation type. For Reference: *Spec. Section 31.60.00 / 3.1 / B: calls for 5,000 PSF for footings supported by RAP's *S001 / Earthwork Foundation Note 3: calls for 6,000 PSF for Column & Strip Footings *\$101.04 / Column Footing Schedule: calls for 6,000 PSF (for Column & Strip Footings) *\$110.04 / Column Footing Schedule: calls for 6,000 PSF (for Column & Strip Footings) 1. **Subsect Foundation Footing Schedule: calls for 6,000 PSF (for Column Footing) 2. **Subsect Foundation Footing Schedule: calls for 6,000 PSF (for Column Footing) 3. **Subsect Foundation Footing Schedule: calls for 6,000 PSF (for Column Footings) 3. **Subsect Foundation Footing Schedule: calls for 6,000 PSF (for Column Footings) 3. **Subsect Foundation Footing Schedule: calls for 6,000 PSF (for Column Footings) 4. **Subsect Foundation Footing Schedule: calls for 6,000 PSF (for Column Footings) 5. **Subsect Foundation Footing Schedule: calls for 6,000 PSF (for Column Footings) **Subsect Footings Foo	All footings on this project are required to bear on soil which has been approved by rammed aggregate piers. The rammed aggregate piers shall provide a net allowable bearing capacity of 6000 PSF. This applies to column footings, strip footings, elevator pils. It does not apply to tie beams or slabs on grade, nor does it apply to thickneed slabs.	JPS	N/A	

				31 60 00 / 1.3 requires Installer pre-approval.			
				1.3 APPROVED DSSTALLES. A. The Runnied Ageogate For Installer (the Installer) shall be approved by the Project Gootechnical and Structural Engineer (Owner's Engineer) prior to bid opening. Without exception, no alternate installer will be accepted suless approved by the Owner's Engineer at least rot of Needs port or bid opening.			
15	BE1-31B	Civil	31 60 00	B. Installers of Rammed Aggregate Fee foundation systems shall have a minimum of 5 years of local experience with the installation of Rammed Aggregate Fee systems and shall have completed at least 50 regional specific projects.		JPS	
					If they meet the qualifications of bullet point B, there is no reason they would not be accepted by the design team.		N/A
				PER SCOPE OF WORK - Where new landscape is shown, subcontractor shall excavate MIN. 30" and add new planting soil.			
16	BE1-32C	Landscape		Is the landscape contractor to mobilize and excavate along side the earthwork contactor at the beginning of the project? How are areas that are to receive 18° of soil to be excavated? Are we excavation down to 30° or 18°? Does this include all Turf areas (Seed and Sod)	Discuss with timing of work with FAW. Review specifications for topsoil depth	Terra	
					requirements.		
17	BE1-32C	Landscape	Tree Grates	Please provide specs for the 4 x 10 Tree Grates	Refer to site furnishing specifications See future bid package for precise	Terra	
18	BE1-32C	Landscape	Irrigation	Please provide EXACT point of connection for the irritation system tie in.	location. We recommend redundant	Terra	
19	BE1-03A	Architectural	Waterproofing	Confirm both types of waterproofing are required.	waterproofing to resolve design issues identified from the geotechnical report and structural continuity.	BSA	N/A
20	BE1-03A	Architectural	07 13 26	Please confirm IU wants a "No Dollar Limit" warranty listed in Section 071326.	NDL warranty is correct to protect IU due to soil and groundwater conditions identified from the geotechnical report and phase 2 environmental investigation.	BSA	N/A
21	BE1-32C	Landscape		Landscape plans indicate Type 1 and Type 2 Decorative Walks - however specifications only referenced ONE color. Is that going to be type 1? or type 2? and what is the other one?	Contractor shall refer to Landscape Architecture sheets for limits of integral color concrete. All associated typical concrete profile details occur on civil sheets	Terra	N/A
22	BE1-32A	Landscape		Are the retaining walls be in the structural concrete package?	No, they are to be included in the BE1- 32B Site Concrete package as listed in the detailed scope breakdown.	FAW	N/A
23	BE1-32A	Civil		The scope states that detectable warning 'brick' is to be used at handicap ramps. I don't think the City of Indy allows brick anymore; it needs to be steel or plastic.	Please include cast iron dtectable warning surfaces at all ADA ramps	JPS	N/A
24				Are the flagpoles (and foundations) being installed by others?	Flagpoles and foundations to be included in BE4-32A Bid package. Site metal railings will be included in BE4-	FAW	N/A
25				Are the handrails at the stairs installed by others? Can Integral Curb be placed adjacent to concrete pavements in lieu of the	32D Bid Package.	FAW	N/A
26	BE1-31B	Civil		"Straight" Concrete Curb specified?	Yes, integral curb is acceptable.	JPS	
27	BE1-31B	Civil		Some site details indicate concrete is to have fiber, other details do not. Is fiber required in all concrete? Or none of the concrete?	Fiber mesh reinforcing should be included on all site concrte at a rate of 1.5 lbs / cubic yard of concrete per site concrete specification section 321300.	JPS	N/A
28	BE1-31B	Civil		Are D-1 joints required at the contraction joints in the concrete? Joint details 16 on sheet C510 does not have a detail for contraction joints, all of them shown are construction joints.	Control joints can be tooled or was cut. Refer to site concrete specification 321300 for additional information on control and construction joint requirements.	JPS	N/A
29	BE1-31B	Civil		The plans note that the chairback curb is to be transitioned to Roll Curb (note 33 on C500), I don't see any roll curb on the job, please advise.	Flush curb should be used at the areas where roll curb is edentified on the landscape plan.	JPS	N/A
30	BE1-31B	Civil		Shouldn't the Stoops in the 6" and 8" concrete pavement areas be the same thickness? or just 4" per the detail or are they even needed at the concrete pavement areas?	Yes, stoops should be the same thickness as the surrounding concrete. Refer to structural plans for the stoop detail.	JPS	N/A
31	BE1-32B	Civil		For the IU Launch Accelerator Building, can you please confirm if the civil datum is: 100-0° is equal to the Finished Floor Elevation (F.F.E.) 694.80.	Confirmed FFE 624.8' - 100'-0"	JPS	N/A
32	BE1-32A	Civil		Can you please confirm that the Asphalt Paving contractor is responsible for furnishing and installing the stone base for the asphalt pavement? I understand contractor is responsible for fine grading.	Asphalt paving contractor is NOT responsible for furnishing and installing the stone base for the asphalt pavement, it is included in BE1-31A bid package as detailed in line item 16.	FAW	N/A
33					actanea (I IIIIe Itelli 10.		N/A